


SIDEWALK LEGEND

150 REINFORCED	
125 REINFORCED	
75 REINFORCED	
100 UNREINFORCED	
TYPE B1 BOLLARD	
TYPE B2 BOLLARD	

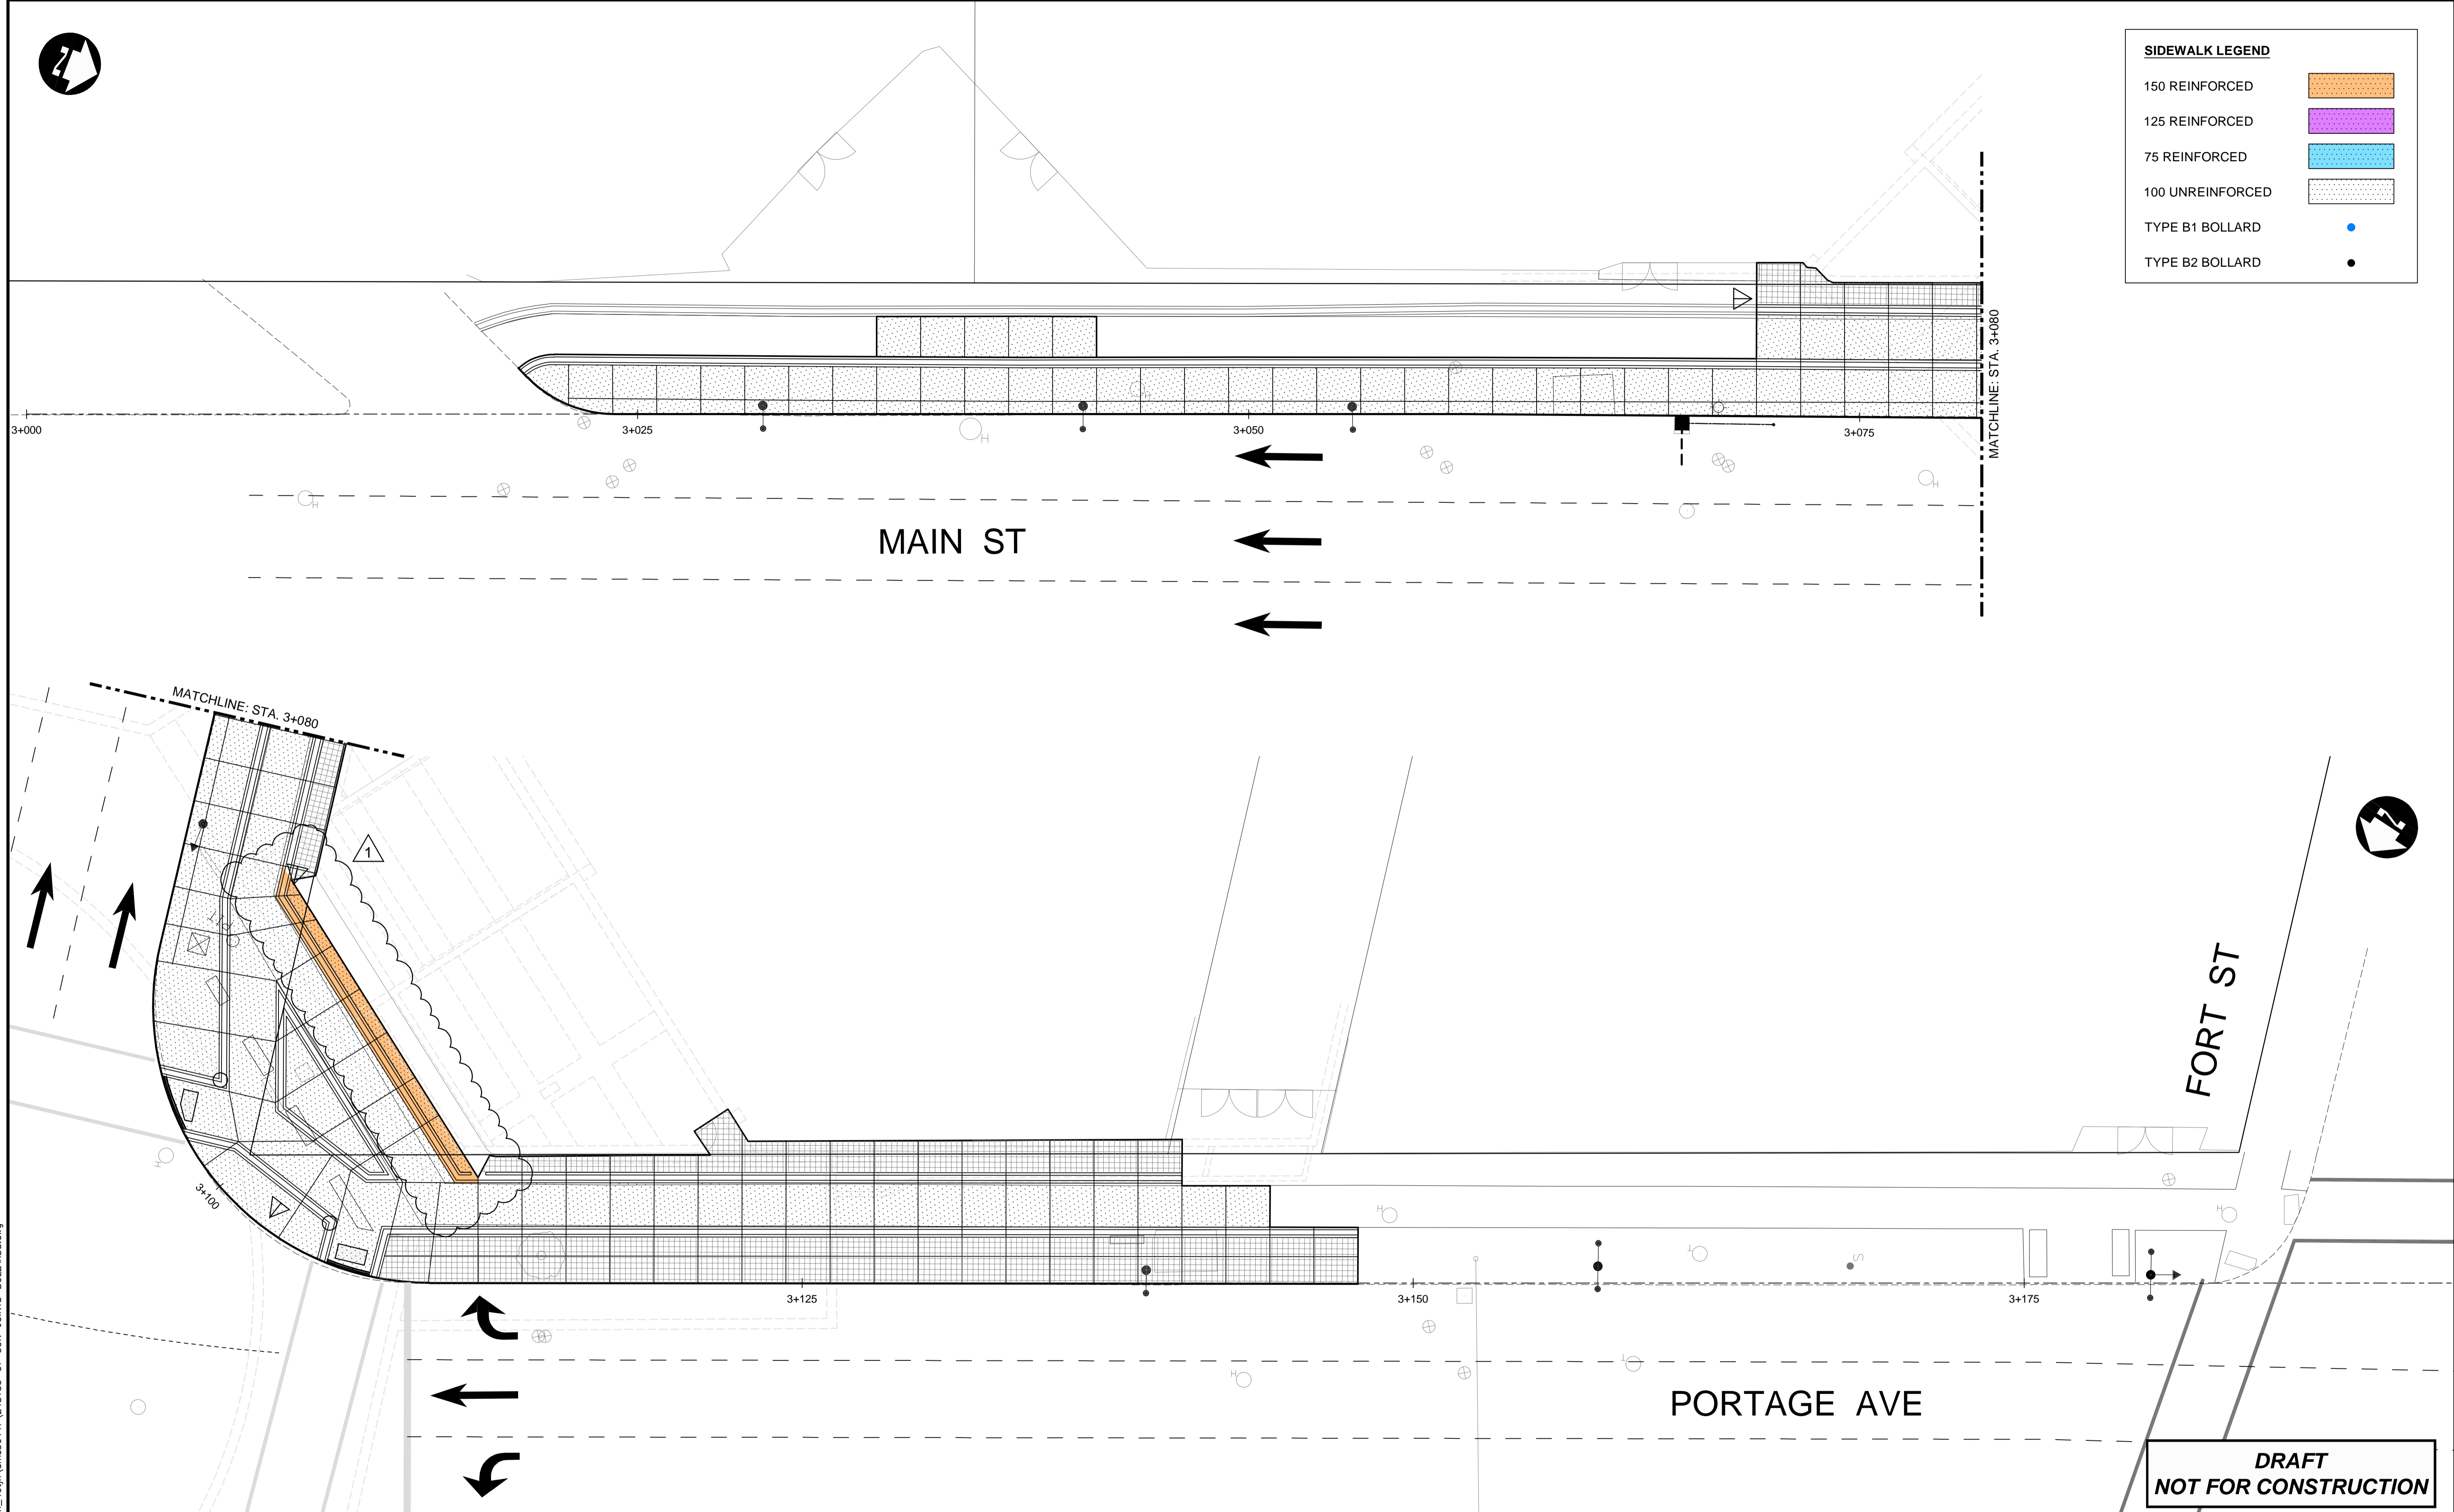

**DRAFT
NOT FOR CONSTRUCTION**

C:\pwworking\directory\projects\2024\dillon_400\h\dms\6444\7\2481133-CT-CON-JOINTS-BOLLARDS.dwg

150 WM	WATERMAIN	150 WM	CONCRETE ROAD		PROFILE
300 LDS	LAND DRAINAGE SEWER	300 LDS	ASPHALT ROAD		NORTH/WEST GUTTER
250 WWS	WASTE WATER SEWER	250 WWS	CONC ROAD W/ASP OVERLAY		SOUTH/EAST GUTTER
HYDRO	HYDRO	HYDRO	CONCRETE SIDEWALK		NORTH/WEST MED. GUTTER
BELLMTS	BELLMTS	BELLMTS	ASPHALT PATH		SOUTH/EAST MED. GUTTER
100 GAS	GAS	100 GAS	LANDSCAPING FEATURE		NORTH/WEST DITCH
T.S.	TRAFFIC SIGNALS	T.S.	GRASS/SOD		SOUTH/EAST DITCH
S.L.	STREET LIGHTS	S.L.	ELEVATION		NORTH/WEST SIDEWALK
MANHOLE	MANHOLE	MANHOLE	PROPERTY LINE		SOUTH/EAST SIDEWALK
CATCH BASIN	CATCH BASIN	CATCH BASIN	CURB RAMP		
CATCH PIT	CATCH PIT	CATCH PIT	DETECTABLE TILE		
EXISTING	LEGEND-PLAN	PROPOSED	EXISTING	LEGEND-PLAN	PROPOSED

UNDERGROUND STRUCTURES	
SUPPLY	DATE

LOCATION OF UNDERGROUND STRUCTURES AS SHOWN ARE BASED ON THE BEST INFORMATION AVAILABLE, BUT NO GUARANTEE IS GIVEN THAT ALL EXISTING UTILITIES ARE SHOWN OR THAT THE GIVEN LOCATIONS ARE EXACT. CONFIRMATION OF EXISTENCE AND EXACT LOCATION OF ALL SERVICES MUST BE OBTAINED FROM THE INDIVIDUAL UTILITIES BEFORE PROCEEDING WITH CONSTRUCTION.

B.M. ELEV.			

DESIGNED BY	TJH/MRD
DRAWN BY	TJH
CHECKED BY	MRD
APPROVED BY	DBW
HOR. SCALE	1:300
VERTICAL	-

DILLON CONSULTING

ENGINEER'S SEAL	
RELEASED FOR CONSTRUCTION	
DATE	

THE CITY OF WINNIPEG
PUBLIC WORKS DEPARTMENT

Winnipeg

PORTAGE & MAIN PEDESTRIAN OPENING

SIDEWALK JOINTS - SOUTHWEST

CITY DRAWING NUMBER: CT-09 21

CONSULTANT DRAWING NUMBER: 24-8133

CONSULTANT PROJECT NUMBER: 24-8133