
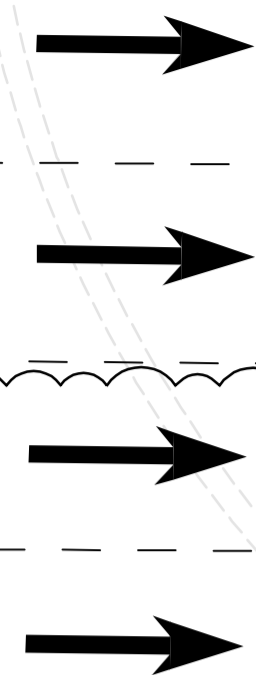


MAIN ST

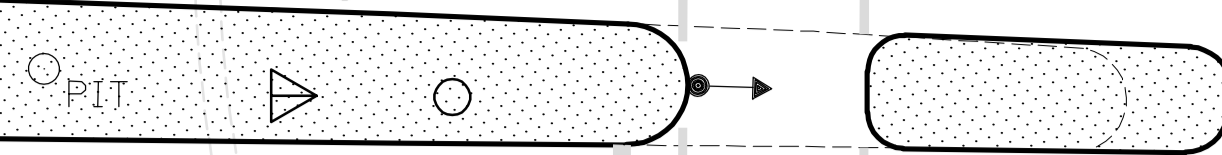

JOINING PLAN TBD

SAWCUT (TYP)

CONSTRUCTION JOINT (TYP AT LIMITS)

CONTROL JOINT (TYP)

S214

4+150

1

4+175

PORTAGE AVE

2+400

2+025

SIDEWALK LEGEND

- 150 REINFORCED
- 125 REINFORCED
- 75 REINFORCED
- 100 UNREINFORCED
- TYPE B1 BOLLARD
- TYPE B2 BOLLARD

**DRAFT
NOT FOR CONSTRUCTION**

C:\pwworking\directory\projects\2024\dillon_400jh\mms\64447\248133-CT-CON-JOINTS-BOLLARDS.dwg

150 WM	WATERMAIN	150 WM	CONCRETE ROAD	PROFILE	NORTH/WEST GUTTER	UNDERGROUND STRUCTURES	B.M. ELEV.	DESIGNED BY	TJH/MRD	ENGINEER'S SEAL	THE CITY OF WINNIPEG PUBLIC WORKS DEPARTMENT	CITY DRAWING NUMBER
300 LDS	LAND DRAINAGE SEWER	300 LDS	ASPHALT ROAD	NORTH/WEST GUTTER	SUPV. U/G STRUCTURES	DATE	DRAWN BY	TJH	DILLON CONSULTING	CONSULTANT PROJECT NUMBER		SHEET OF
250 WWS	WASTE WATER SEWER	250 WWS	CONC ROAD W/ASP OVERLAY	SOUTH/EAST GUTTER	LOCATION OF UNDERGROUND STRUCTURES AS SHOWN ARE BASED ON THE BEST INFORMATION AVAILABLE, BUT NO GUARANTEE IS GIVEN THAT ALL EXISTING UTILITIES ARE SHOWN OR THAT THE GIVEN LOCATIONS ARE EXACT. CONFIRMATION OF EXISTENCE AND EXACT LOCATION OF ALL SERVICES MUST BE OBTAINED FROM THE INDIVIDUAL UTILITIES BEFORE PROCEEDING WITH CONSTRUCTION.	1 ISSUED FOR ADDENDUM 01	24/09/27	DBW		RELEASED FOR CONSTRUCTION	24-8133	CT-10
HYDRO	HYDRO	HYDRO	CONCRETE SIDEWALK	NORTH/WEST MED. GUTTER		0 ISSUED FOR TENDER	24/09/09	DBW	DATE		21	
BELLMTS	BELLMTS	BELLMTS	ASPHALT PATH	SOUTH/EAST MED. GUTTER					DATE			
100 GAS	GAS	100 GAS	LANDSCAPING FEATURE	NORTH/WEST DITCH								
T.S.	TRAFFIC SIGNALS	T.S.	GRASS/SOD	SOUTH/EAST DITCH								
S.L.	STREET LIGHTS	S.L.	ELEVATION	NORTH/WEST SIDEWALK								
	MANHOLE		PROPERTY LINE	SOUTH/EAST SIDEWALK								
	CATCH BASIN		CURB RAMP									
	CATCH PIT		DETECTABLE TILE									
EXISTING	LEGEND-PLAN	PROPOSED	EXISTING	LEGEND-PROFILE	PROPOSED	EXISTING	LEGEND-PROFILE	PROPOSED				

THE CITY OF WINNIPEG PUBLIC WORKS DEPARTMENT		CITY DRAWING NUMBER
PORTAGE & MAIN PEDESTRIAN OPENING		SHEET OF
SIDEWALK JOINTS - SOUTHEAST		CT-10 21
CONSULTANT PROJECT NUMBER 24-8133		CONSULTANT DRAWING NUMBER