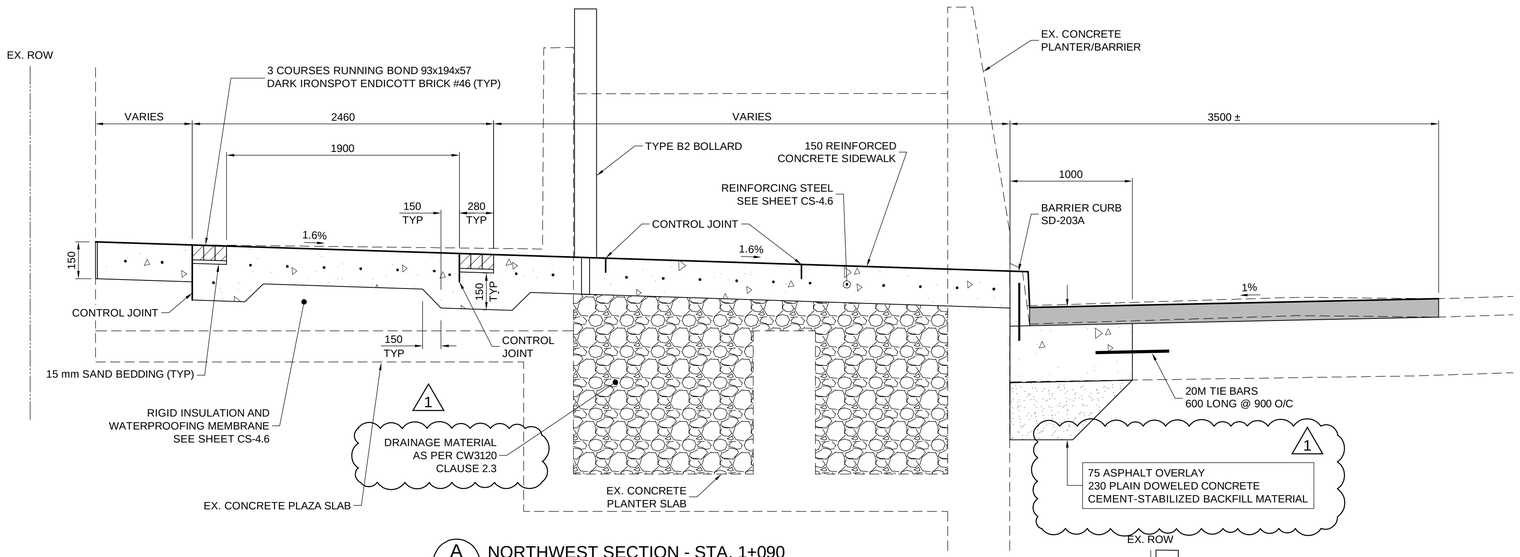

A CT-01 CT-11 NORTHWEST SECTION - STA. 1+090

SCALE: H=1:25, V=1:12.5

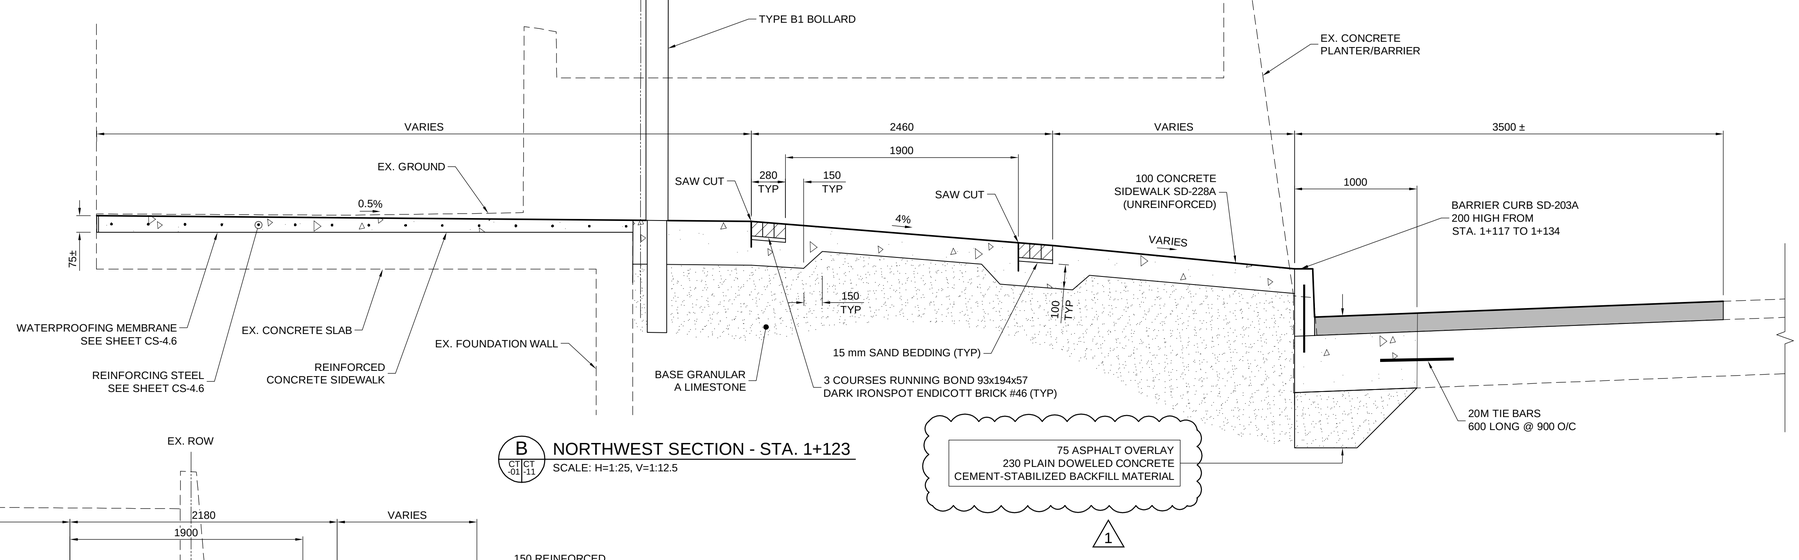

B CT-01 CT-11 NORTHWEST SECTION - STA. 1+123

SCALE: H=1:25, V=1:12.5

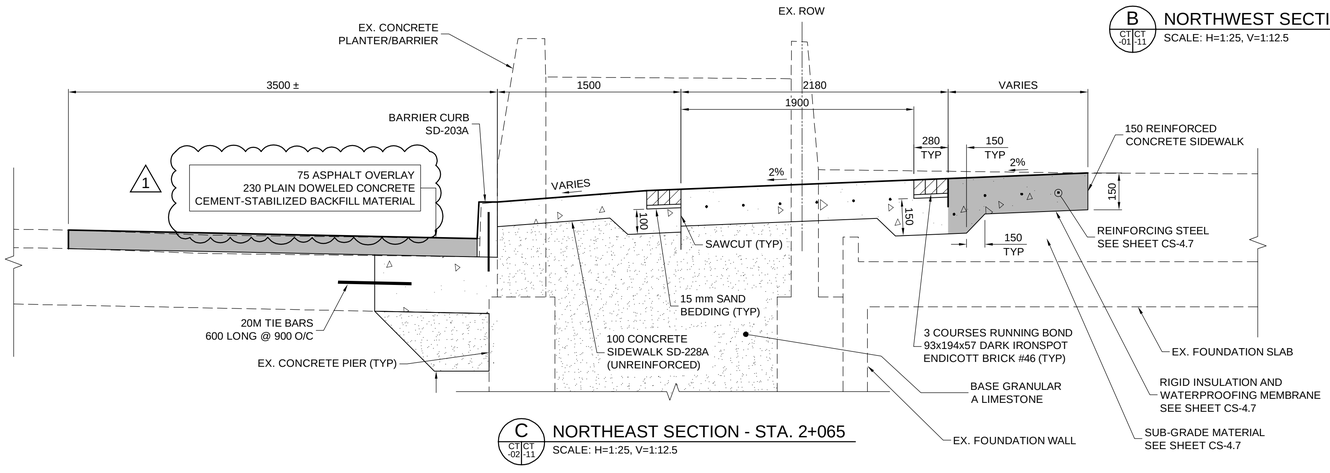

C CT-02 CT-11 NORTHEAST SECTION - STA. 2+065

SCALE: H=1:25, V=1:12.5

DRAFT
NOT FOR CONSTRUCTION

150 WM	WATERMAIN	150 WM		CONCRETE ROAD			℄ PROFILE	
300 LDS	LAND DRAINAGE SEWER	300 LDS		ASPHALT ROAD			NORTH/WEST GUTTER	
250 WWS	WASTE WATER SEWER	250 WWS		CONC ROAD W/ASP OVERLAY			SOUTH/EAST GUTTER	
HYDRO	HYDRO	HYDRO		CONCRETE SIDEWALK			NORTH/WEST MED. GUTTER	
BELLMTS	BELLMTS	BELLMTS		ASPHALT PATH			SOUTH/EAST MED. GUTTER	
100 GAS	GAS	100 GAS		LANDSCAPING FEATURE			NORTH/WEST DITCH	
T.S.	TRAFFIC SIGNALS	T.S.		GRASS/SOD			SOUTH/EAST DITCH	
S.L.	STREET LIGHTS	S.L.	232.000	ELEVATION	232.000		NORTH/WEST SIDEWALK	
○	MANHOLE	●		PROPERTY LINE			SOUTH/EAST SIDEWALK	
□	CATCH BASIN	■		CURB RAMP				
▽	CATCH PIT	▼		DETECTABLE TILE				
EXISTING	LEGEND—PLAN	PROPOSED	EXISTING	LEGEND—PLAN	PROPOSED	EXISTING	LEGEND—PROFILE	PROPOSED

UNDERGROUND STRUCTURES

SUPV. U/G STRUCTURES DATE

LOCATION OF UNDERGROUND STRUCTURES AS SHOWN ARE BASED ON THE BEST INFORMATION AVAILABLE, BUT NO GUARANTEE IS GIVEN THAT ALL EXISTING UTILITIES ARE SHOWN OR THAT THE GIVEN LOCATIONS ARE EXACT. CONFIRMATION OF EXISTENCE AND EXACT LOCATION OF ALL SERVICES MUST BE OBTAINED FROM THE INDIVIDUAL UTILITIES BEFORE PROCEEDING WITH CONSTRUCTION.

B.M.
ELEV.

NO.	REVISIONS	DATE	BY
1	ISSUED FOR ADDENDUM 01	24/09/27	DBW
0	ISSUED FOR TENDER	24/09/09	DBW

DESIGNED BY TJH/MRD
DRAWN BY TJH
CHECKED BY MRD
APPROVED BY DBW
HOR. SCALE AS NOTED
VERTICAL —
DATE

DILLON CONSULTING

RELEASED FOR CONSTRUCTION

DATE

ENGINEER'S SEAL

CONSULTANT PROJECT NUMBER
24-8133

Winnipeg

THE CITY OF WINNIPEG
PUBLIC WORKS DEPARTMENT

PORTAGE & MAIN PEDESTRIAN OPENING

CITY DRAWING NUMBER

SHEET CT-11 OF 21

SECTIONS (1 OF 2)

CONSULTANT DRAWING NUMBER

C:\pw working directory\projects 2024\dillon_40\jh\dms36447\248133-CT-CON-DETAILS.dwg