

PHASE 3 - STAGE 1:

SUGGESTED SCHEDULE:

- 1 MONTH
- JUNE 2025

MAJOR CONSTRUCTION ACTIVITIES:

1. LANE AT A TIME PERMANENT ROAD RESTORATION FROM TRAFFIC SIGNALS CONDUIT INSTALLATION
2. PIECEMEAL SIDEWALKS TO MAINTAIN ACCESS TO DOORWAYS/STAIRWAYS (NOT ALL SUB-STAGES SHOWN)
3. CONCRETE MEDIAN REPAIRS
4. ASPHALT MILL AND FILL OF CURB LANES
5. ASPHALT MILL AND FILL OF MEDIAN LANES
6. TEMPORARY EB PORTAGE MEDIAN LANE WIDENING INTO MEDIAN
7. MMA DELINEATION AROUND STAIRWAY BUILDING IN NE CORNER

TRAFFIC CONTROL:


- CURB LANES CLOSED IN ALL DIRECTIONS
- TRAFFIC SERVICES TO CHANGE EB OVERHEAD SIGN STRUCTURE TO MATCH LANE ARRANGEMENT
- MEDIAN LANES CLOSED AS SHOWN WHEN CONCRETE WORK BEING PERFORMED (OR WHEN LANE IS NOT PASSABLE) ONLY
- ADDITIONAL LANE CLOSURES (NOT SHOWN) FOR TRAFFIC SIGNAL CONDUIT ROAD RESTORATION
- CLOSURE OF EB PORTAGE AND PAVING OF ALL CURB LANES TO OCCUR ON A WEEKEND(S) BETWEEN FRIDAY AT 1800 TO MONDAY 0600

PEDESTRIAN CONTROL:

- SE CORNER PEDESTRIANS**
- MAINTAIN ACCESS TO 333 MAIN, 191 PIONEER
 - NO ACCESS ACROSS CORNER, DETOUR VIA PIONEER-WESTBROOK
 - NO ACCESS TO STAIRCASE
- SW CORNER PEDESTRIANS**
- MAINTAIN ACCESS TO 200 MAIN (SCOTIA BANK), 360 MAIN AND 210 PORTAGE (CONCOURSE)
 - MAINTAIN ACCESS ACROSS CORNER
 - MAINTAIN ACCESS TO STAIRCASE (210 PORTAGE)
- NW CORNER PEDESTRIANS**
- MAINTAIN ACCESS TO 201 PORTAGE PLAZA DOORS

1

1

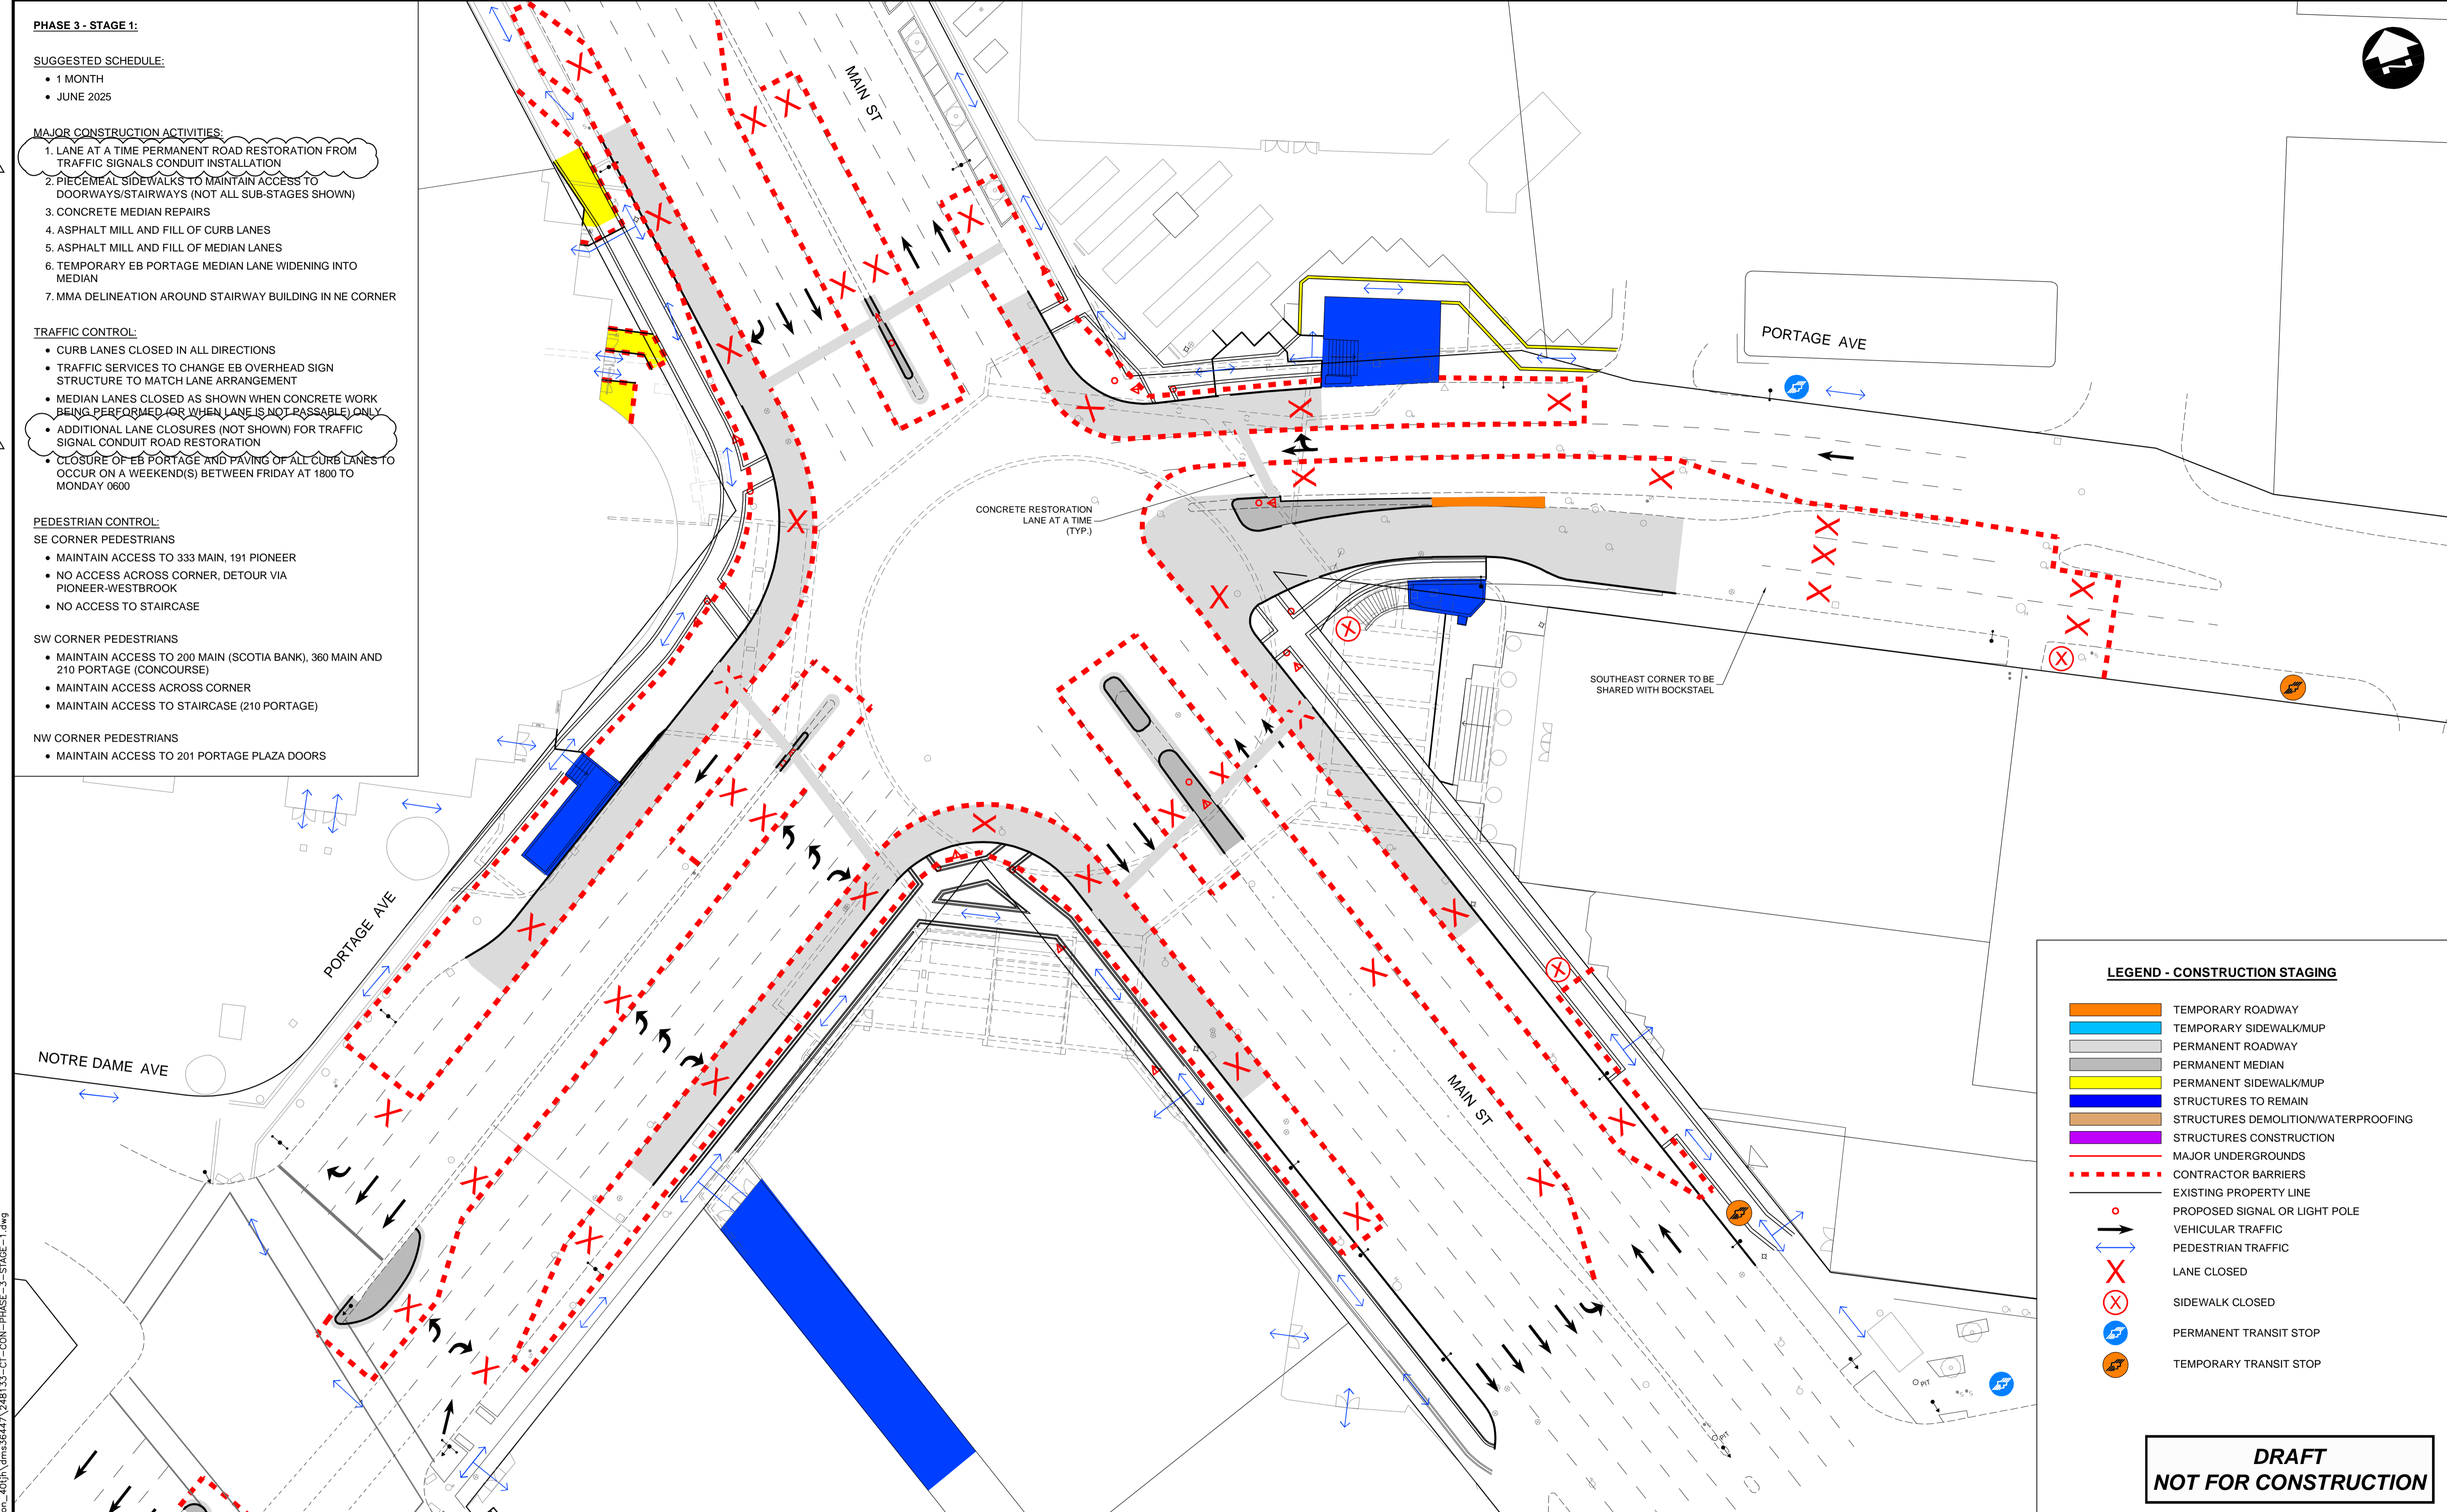

LEGEND - CONSTRUCTION STAGING

- TEMPORARY ROADWAY
- TEMPORARY SIDEWALK/MUP
- PERMANENT ROADWAY
- PERMANENT MEDIAN
- PERMANENT SIDEWALK/MUP
- STRUCTURES TO REMAIN
- STRUCTURES DEMOLITION/WATERPROOFING
- STRUCTURES CONSTRUCTION
- MAJOR UNDERGROUNDS
- CONTRACTOR BARRIERS
- EXISTING PROPERTY LINE
- PROPOSED SIGNAL OR LIGHT POLE
- VEHICULAR TRAFFIC
- PEDESTRIAN TRAFFIC
- LANE CLOSED
- SIDEWALK CLOSED
- PERMANENT TRANSIT STOP
- TEMPORARY TRANSIT STOP

**DRAFT
NOT FOR CONSTRUCTION**

C:\pwworking\directory\projects_2024\dillon_400\h\dms\64447\2481133-CT-CON-PHASE-3-STAGE-1.dwg

UNDERGROUND STRUCTURES SUPV. U/G STRUCTURES DATE		B.M. ELEV.	DESIGNED BY: TJH/MRD DRAWN BY: TJH CHECKED BY: MRD APPROVED BY: DBW		ENGINEER'S SEAL	THE CITY OF WINNIPEG PUBLIC WORKS DEPARTMENT	CITY DRAWING NUMBER
LOCATION OF UNDERGROUND STRUCTURES AS SHOWN ARE BASED ON THE BEST INFORMATION AVAILABLE, BUT NO GUARANTEE IS GIVEN THAT ALL EXISTING UTILITIES ARE SHOWN OR THAT THE GIVEN LOCATIONS ARE EXACT. CONFIRMATION OF EXISTENCE AND EXACT LOCATION OF ALL SERVICES MUST BE OBTAINED FROM THE INDIVIDUAL UTILITIES BEFORE PROCEEDING WITH CONSTRUCTION.		1 ISSUED FOR ADDENDUM 01 24/09/27 DBW 0 ISSUED FOR TENDER 24/09/09 DBW NO. REVISIONS DATE BY DATE	HOR. SCALE: AS NOTED VERTICAL: -		RELEASED FOR CONSTRUCTION		CONSULTANT PROJECT NUMBER 24-8133