

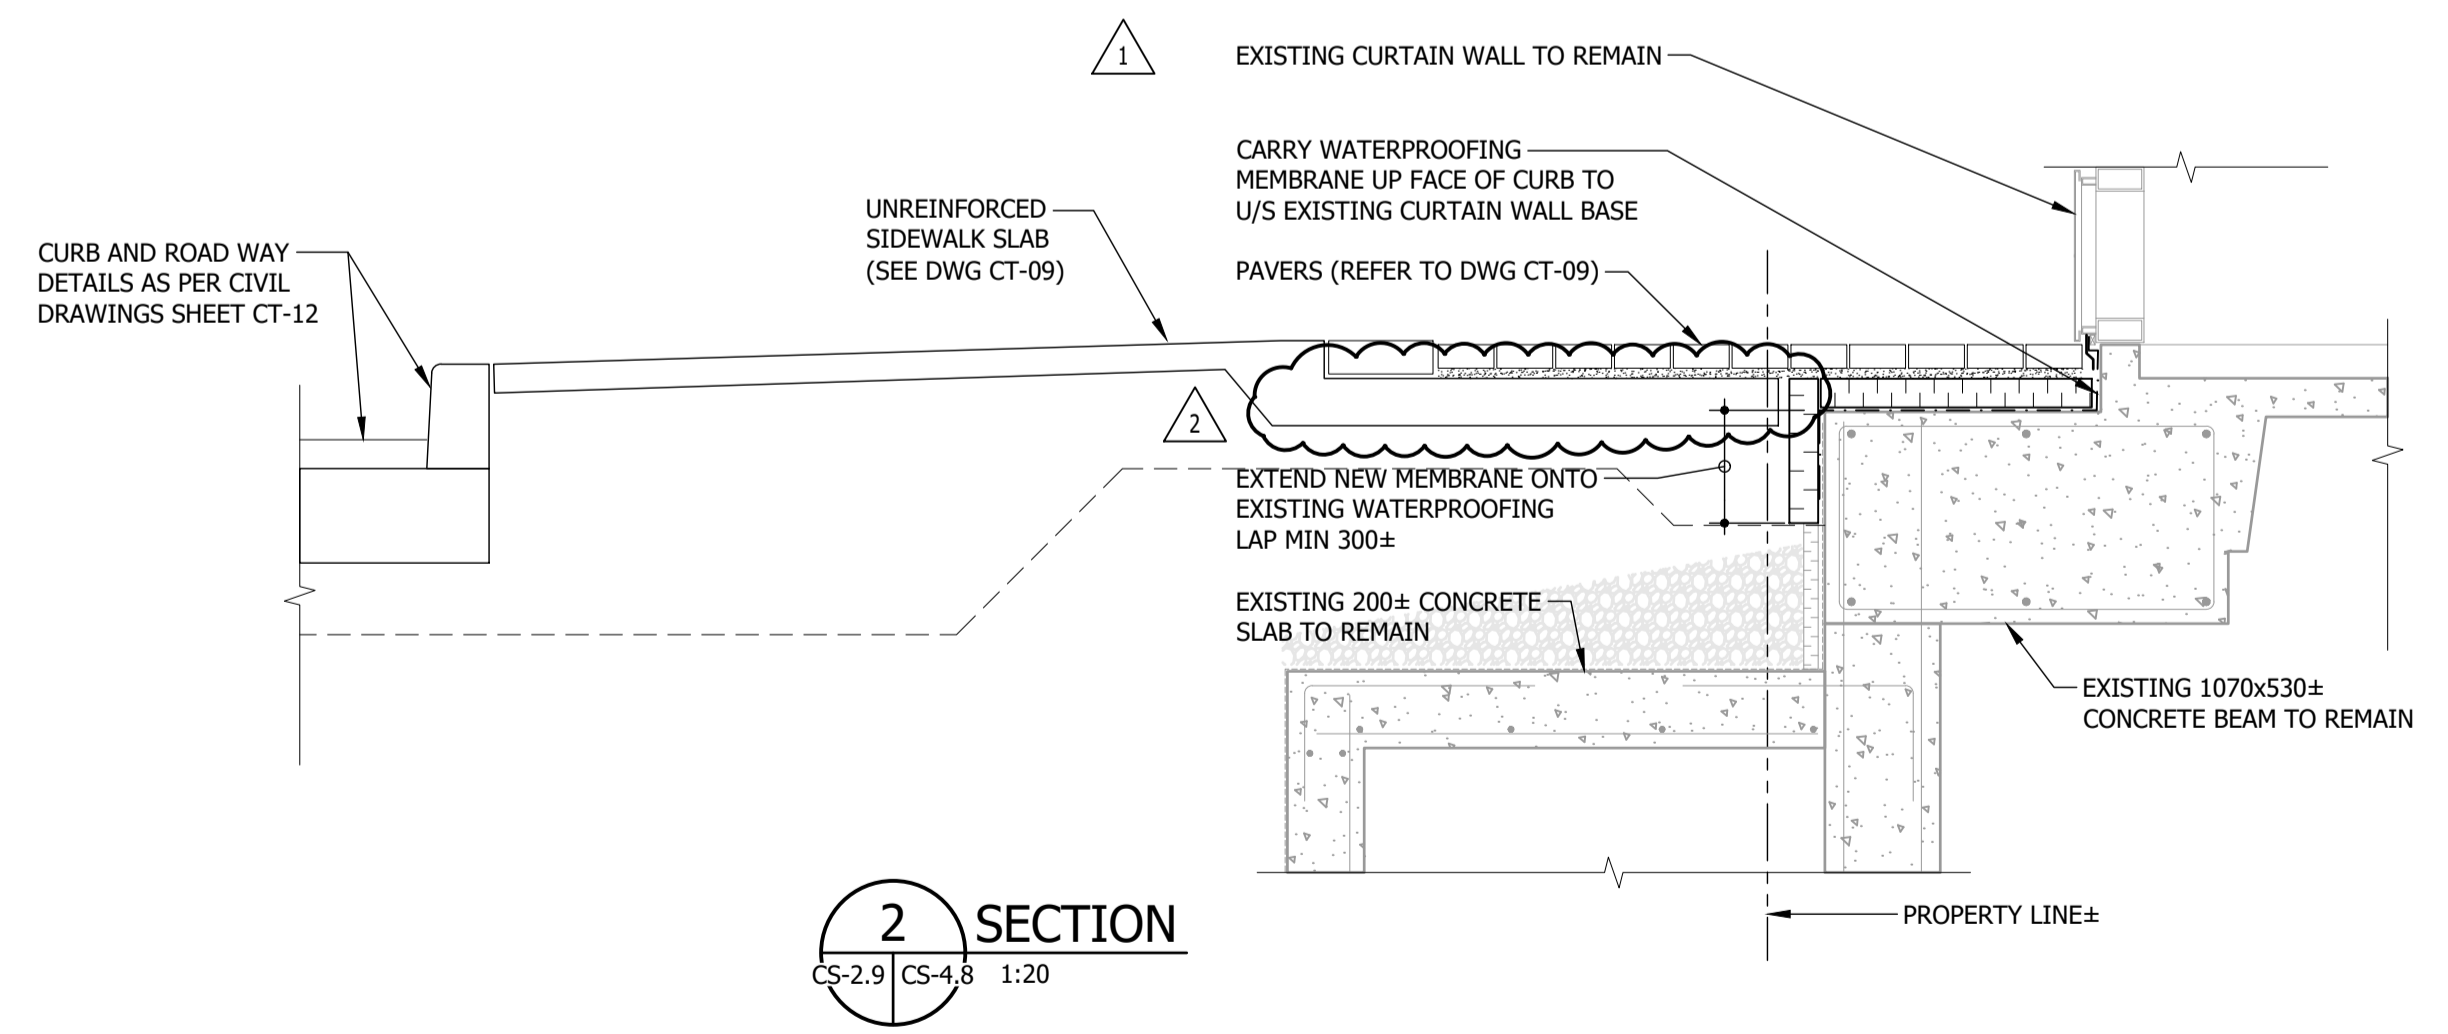


C:\Users\jess\OneDrive - Crosier Kilgour\General - 2024-0410 - Portage & Main Pedestrian Reopening\06 Drawings\2024-0410_PORTAGE-MAIN.dwg

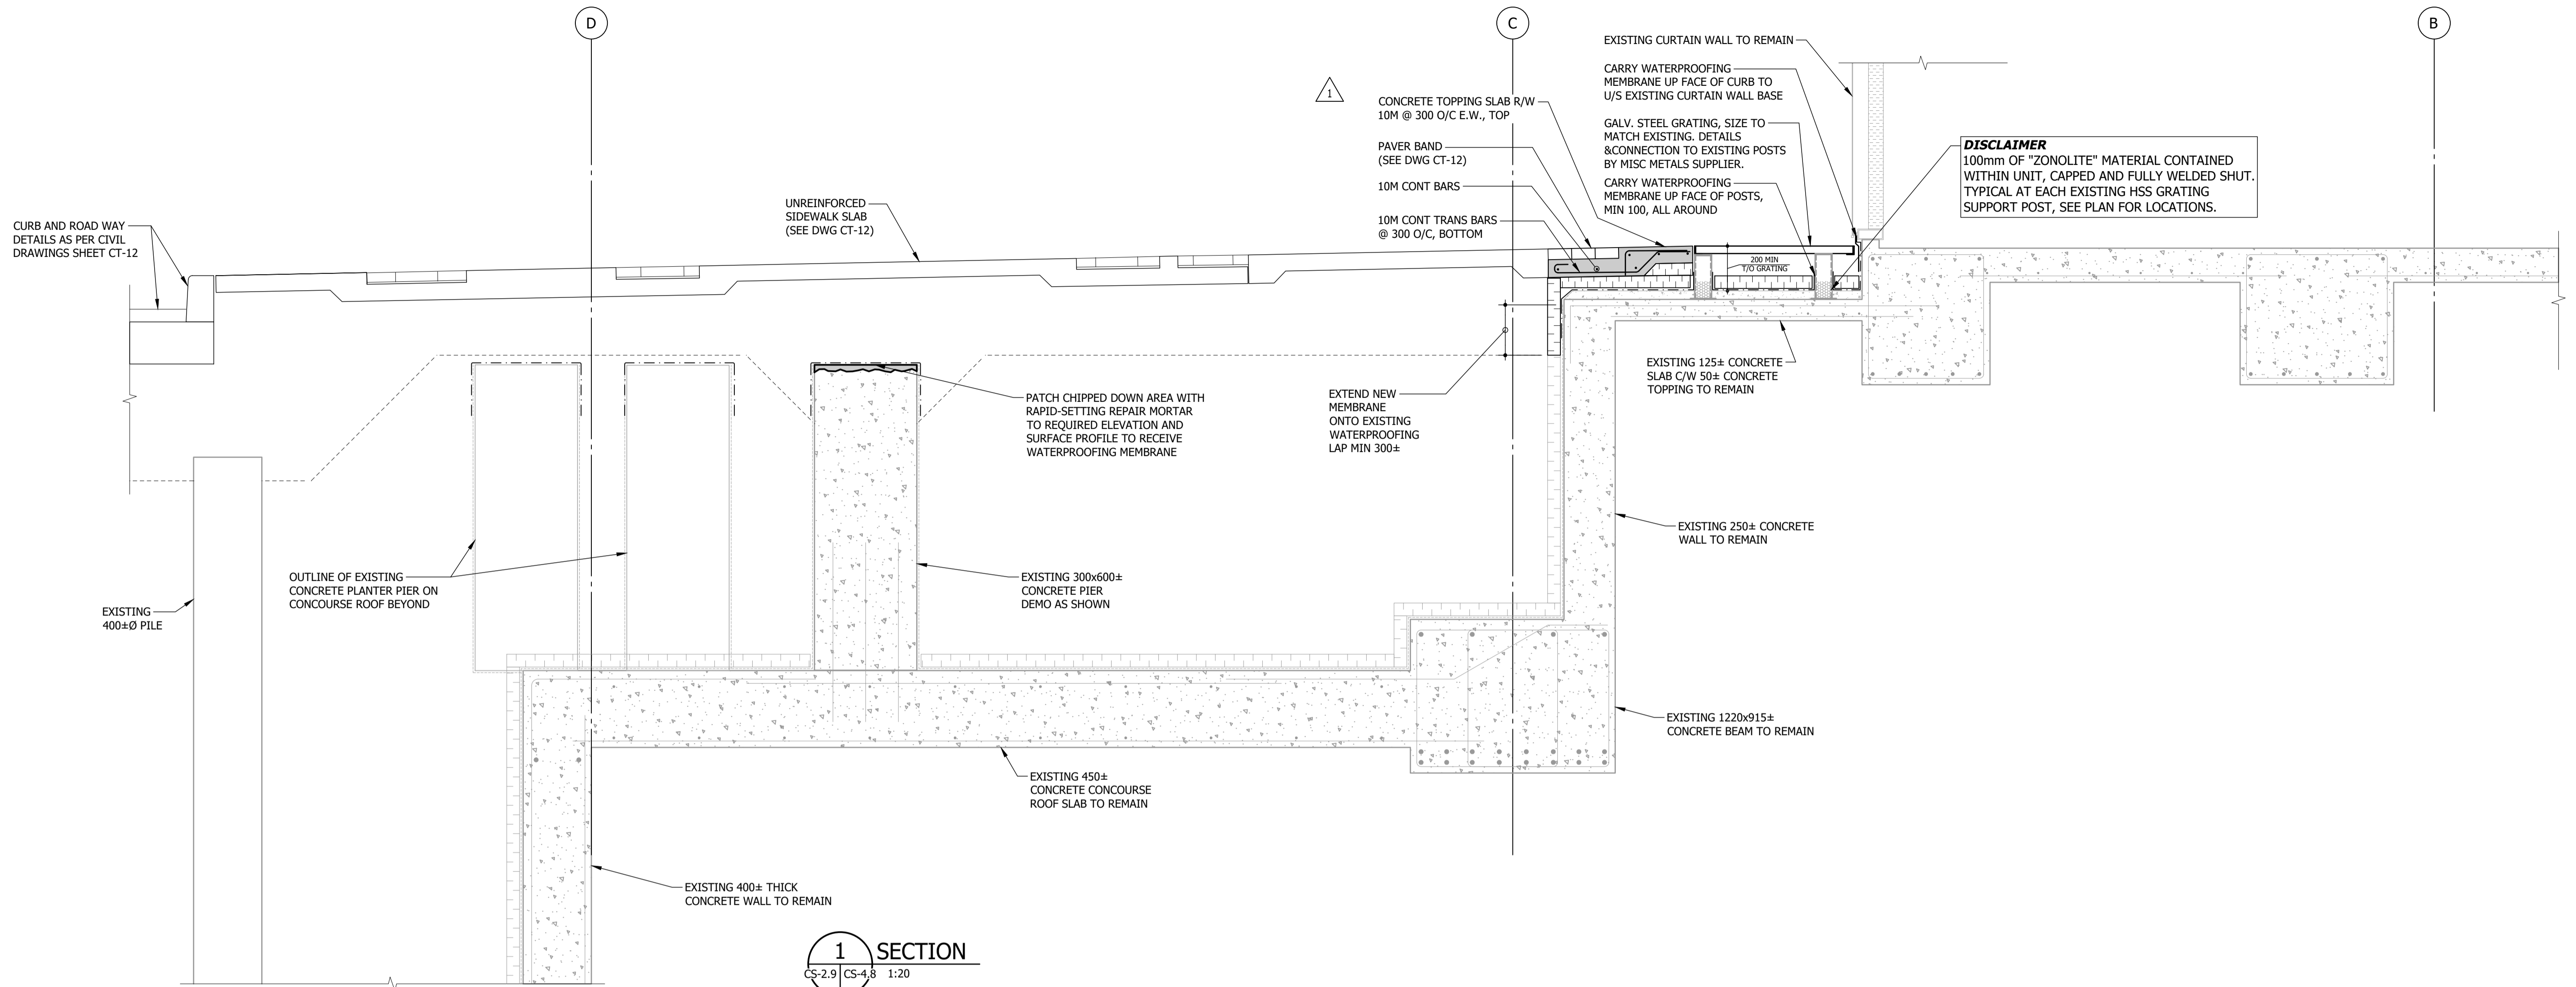

B.M. ELEV.	DESIGNED BY	SMC/DJM			
	DRAWN BY	MS/SAS			
	CHECKED BY	SMC			
	APPROVED BY	DJM			
2	ADDENDUM 02	24-10-08 SMC			
1	ADDENDUM 01	24-09-27 SMC			
0	ISSUED FOR TENDER	24-09-09 SMC			
NO.	REVISIONS	DATE	BY	DATE	DATE
		2024-10-08			

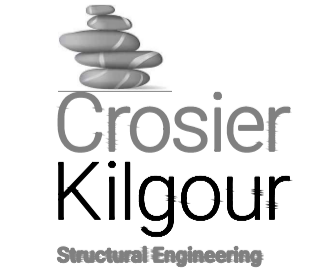

 Structural Engineering & Building Performance


DESIGNED BY: SMC/DJM
 DRAWN BY: MS/SAS
 CHECKED BY: SMC
 APPROVED BY: DJM

HOR. SCALE: AS NOTED
 VERTICAL: AS NOTED

RELEASED FOR CONSTRUCTION
 DATE: 2024-10-08

ENGINEER'S SEAL

CONSULTANT PROJECT NUMBER: 2024-0410



THE CITY OF WINNIPEG
 PUBLIC WORKS DEPARTMENT

PORTAGE & MAIN PEDESTRIAN OPENING
 SECTIONS & DETAILS
 SOUTHWEST CORNER

CITY DRAWING NUMBER: CS-19
 SHEET OF: 25
 CONSULTANT DRAWING NUMBER: CS-4.8