




EX. ROW

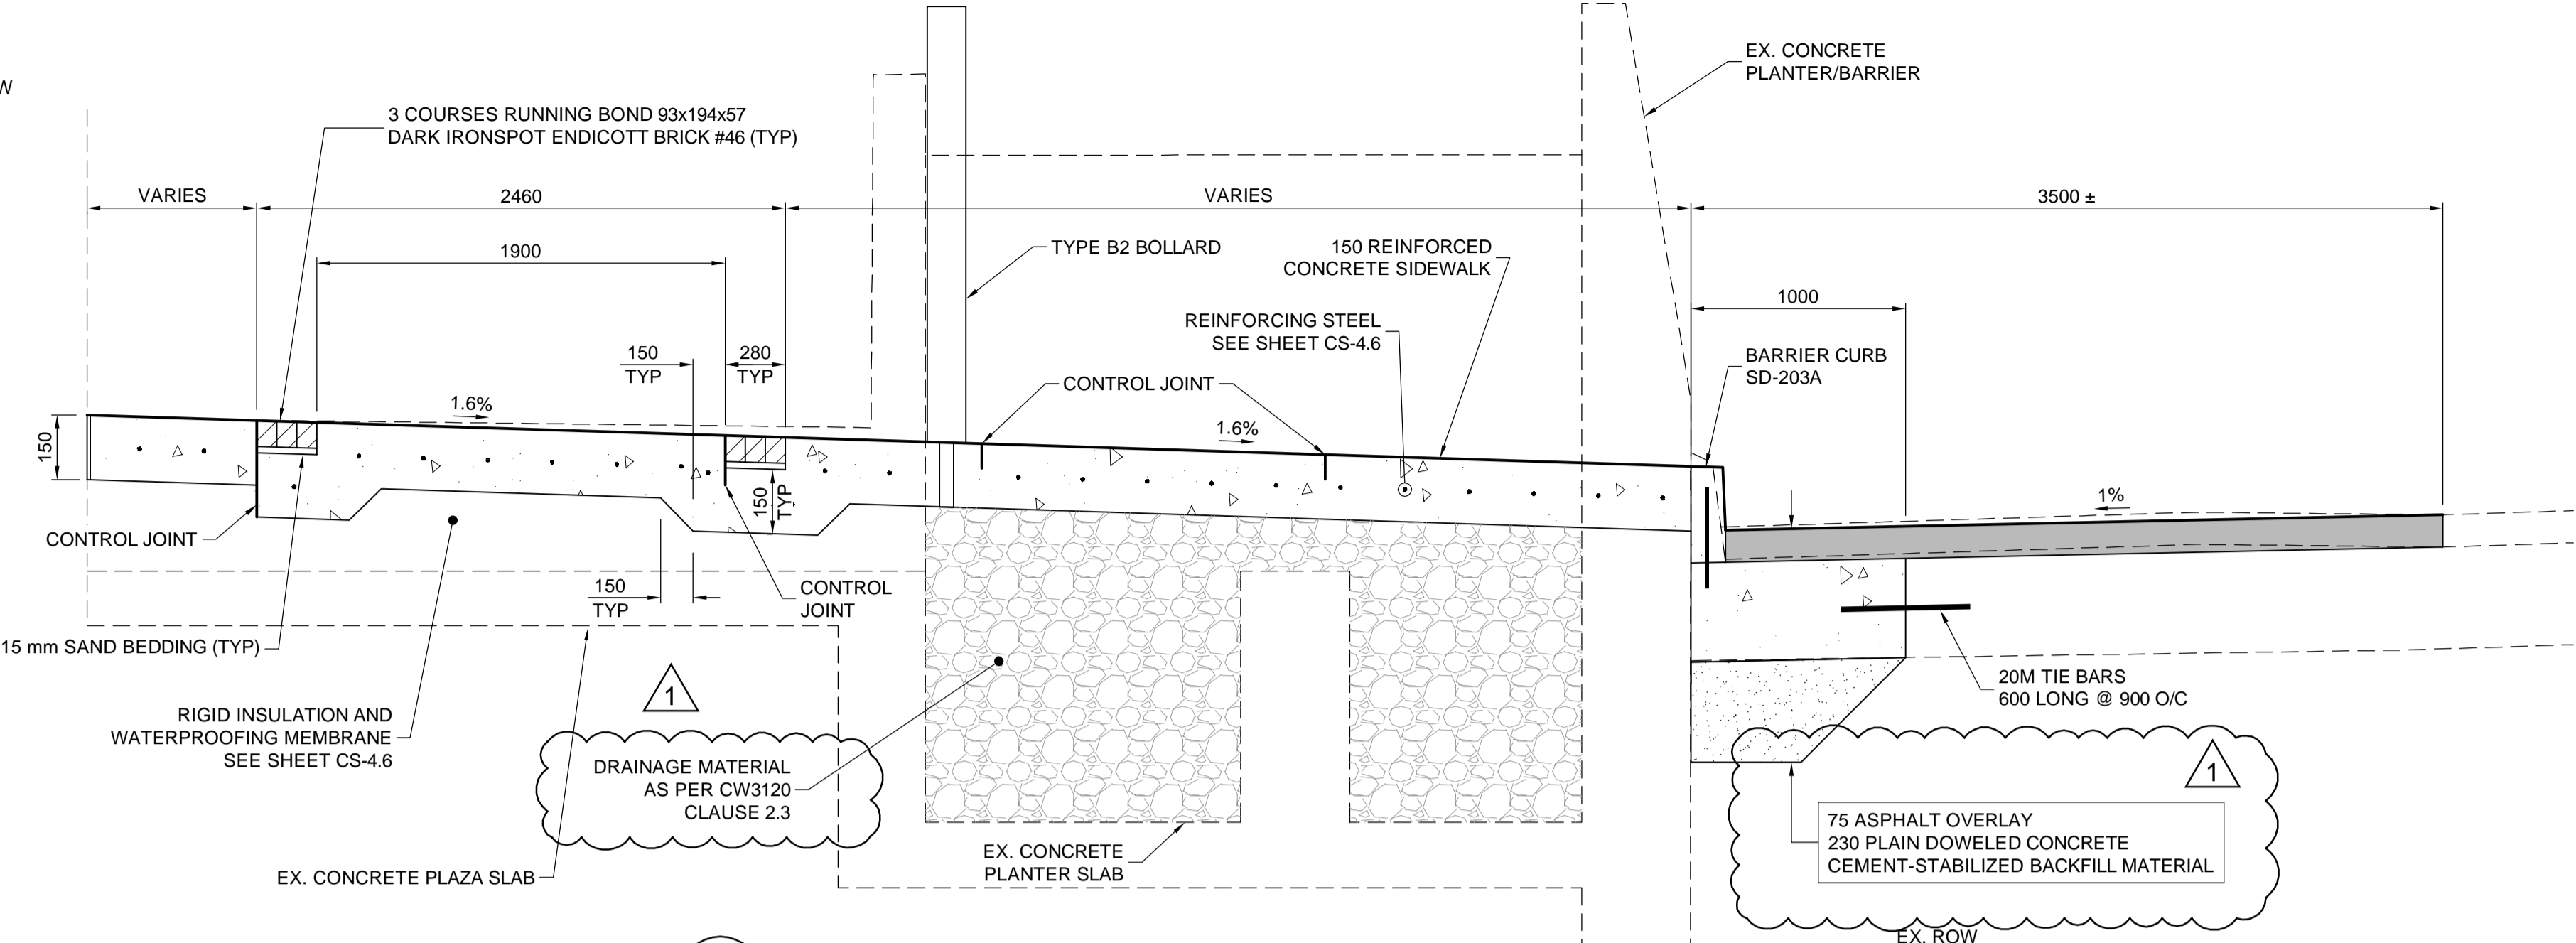

A NORTHWEST SECTION - STA. 1+090
 SCALE: H=1:25, V=1:12.5

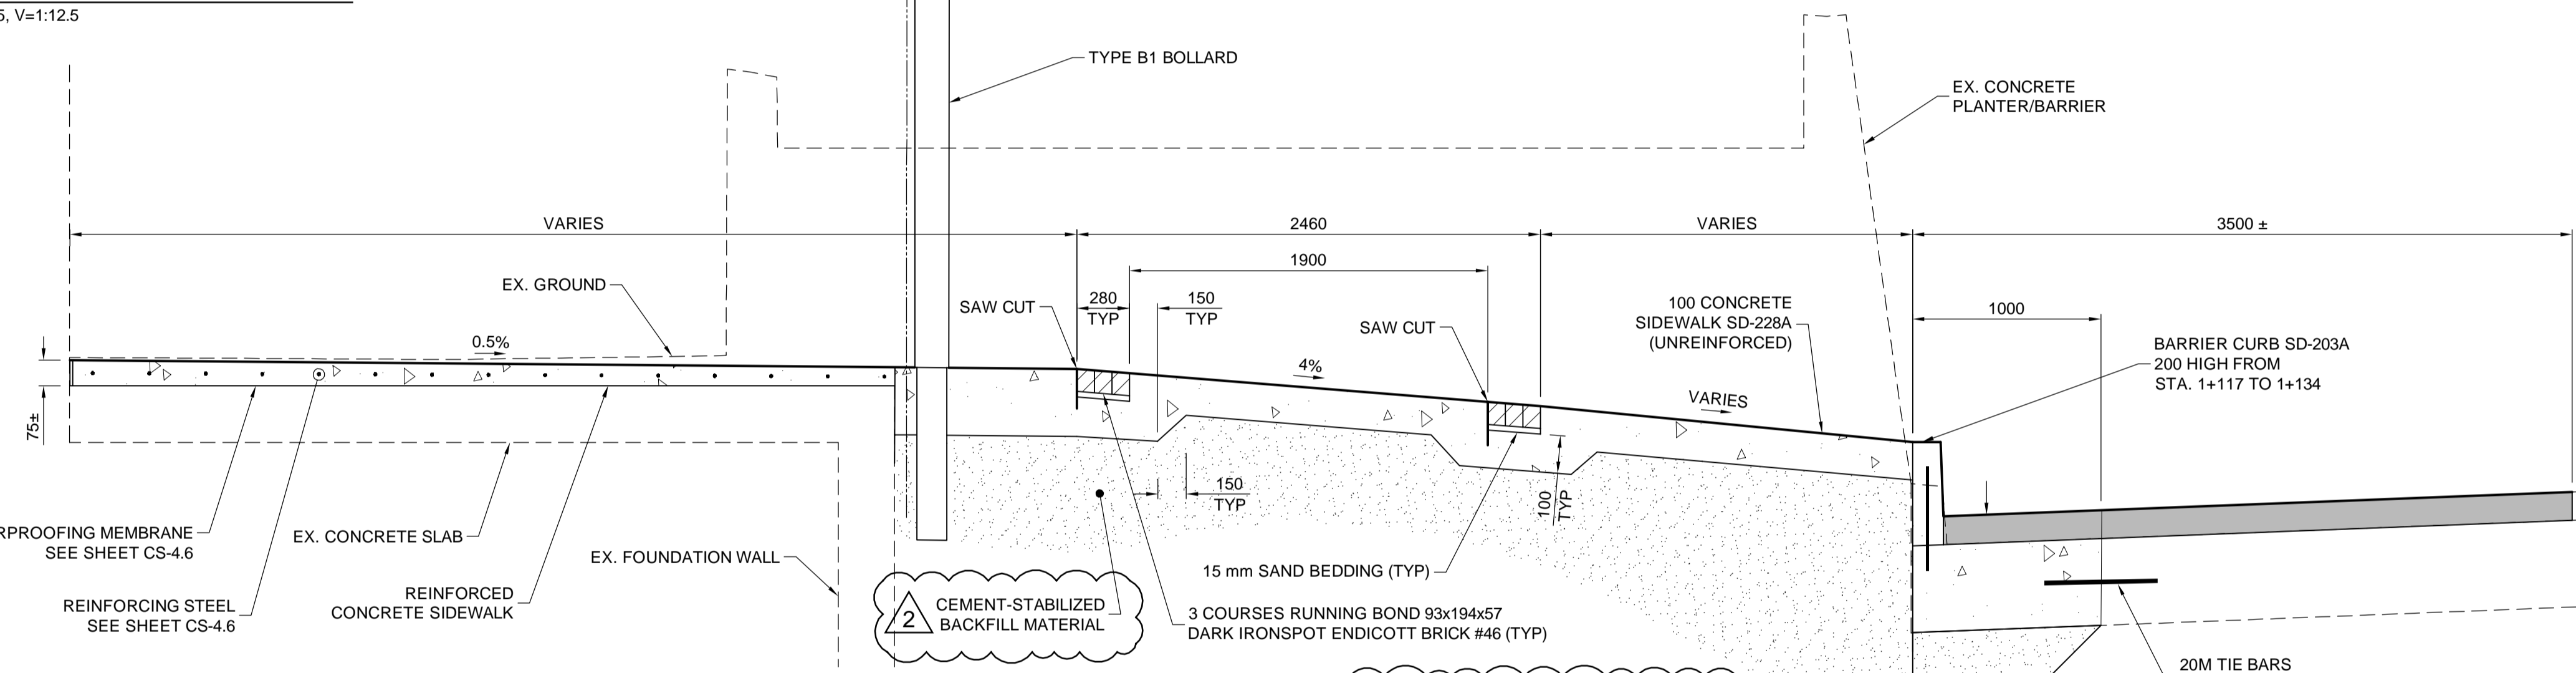

B NORTHWEST SECTION - STA. 1+123
 SCALE: H=1:25, V=1:12.5

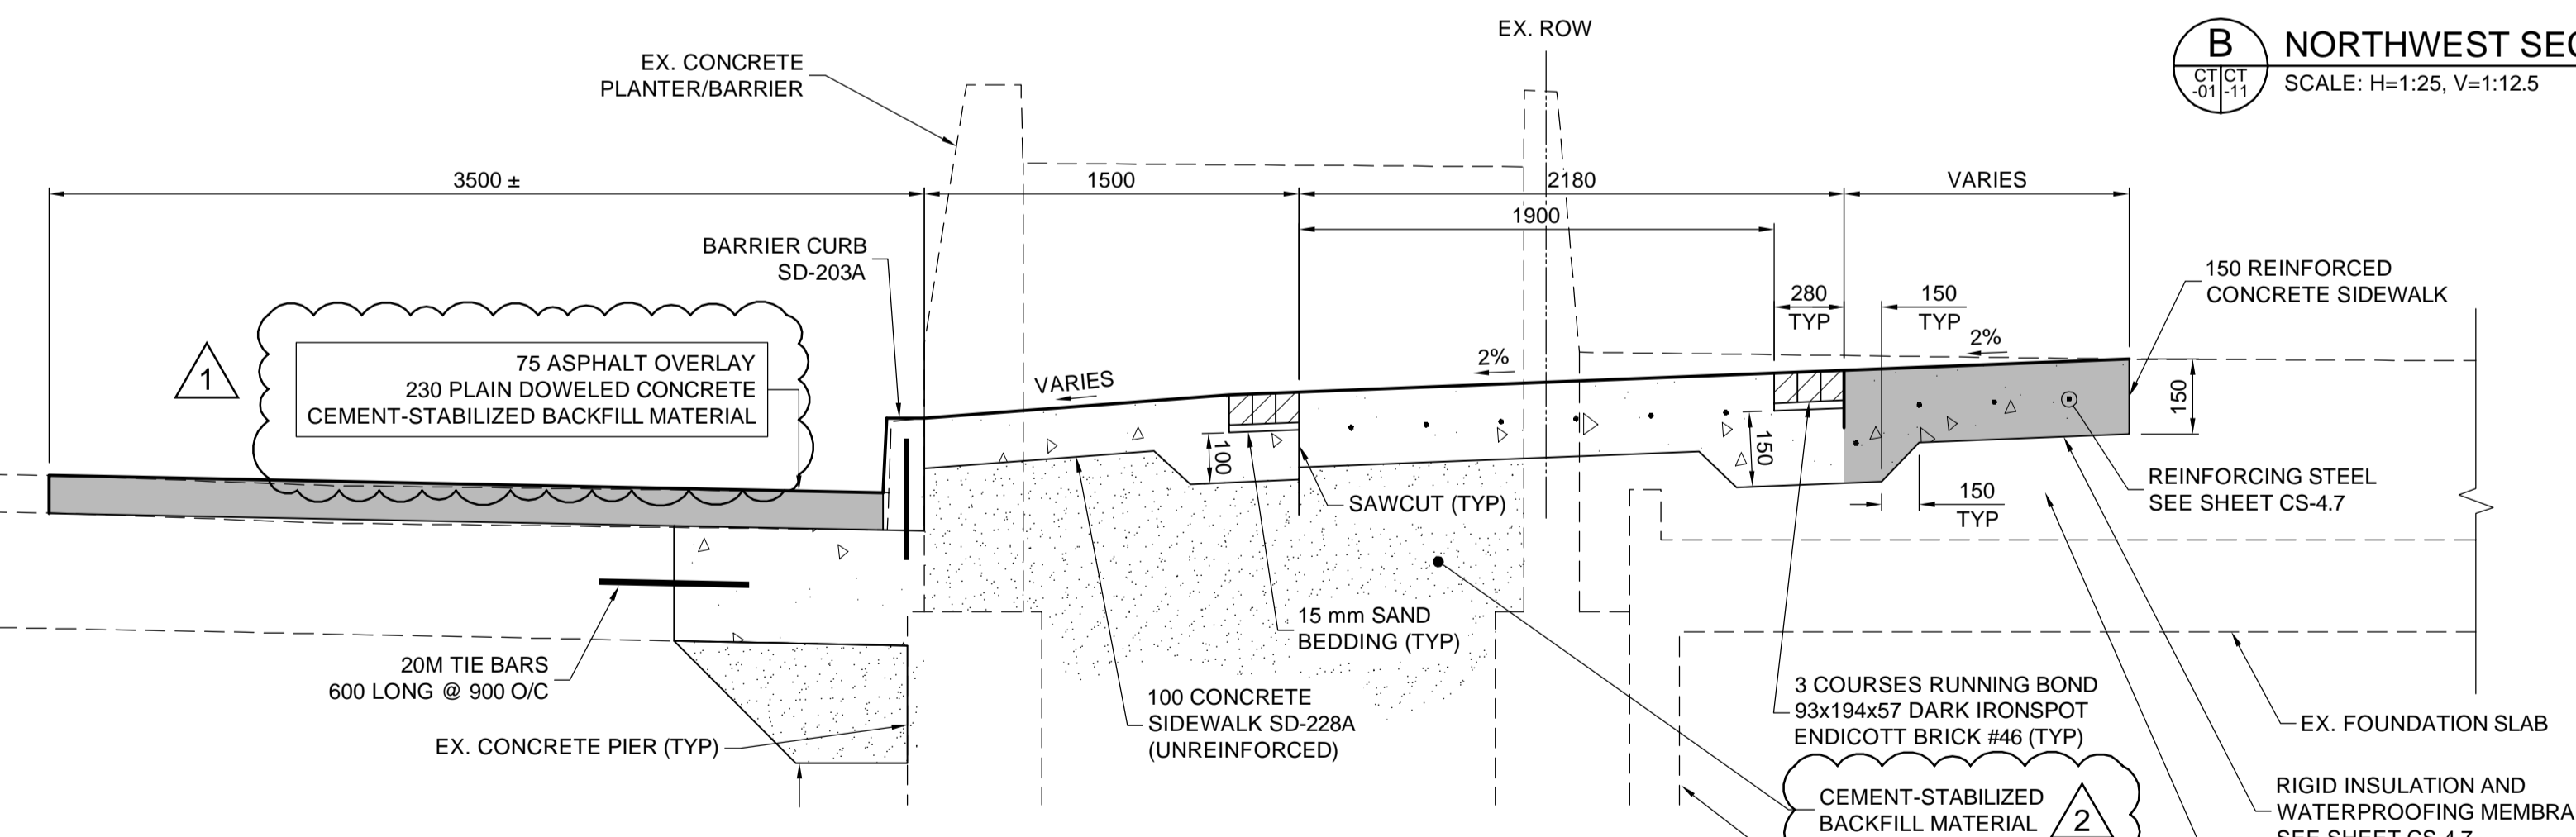

C NORTHEAST SECTION - STA. 2+065
 SCALE: H=1:25, V=1:12.5

DRAFT
NOT FOR CONSTRUCTION

C:\pwworking\directory\projects\2024\dillon_400\h\dms36444\2481133-CT-CON-DETAILS.dwg

150 WM	WATERMAIN	150 WM	CONCRETE ROAD	PROFILE	UNDERGROUND STRUCTURES	B.M. ELEV.	DESIGNED BY	ENGINEER'S SEAL		CITY DRAWING NUMBER SHEET OF CT-11 OF 21 CONSULTANT DRAWING NUMBER
300 LDS	LAND DRAINAGE SEWER	300 LDS	ASPHALT ROAD	NORTH/WEST GUTTER	SUPV. U/G STRUCTURES	DATE	TJH/MRD			
250 WWS	WASTE WATER SEWER	250 WWS	CONC ROAD W/ASP OVERLAY	SOUTH/EAST GUTTER			TJH		PORTAGE & MAIN PEDESTRIAN OPENING SECTIONS (1 OF 2)	
HYDRO	HYDRO	HYDRO	CONCRETE SIDEWALK	NORTH/WEST MED. GUTTER			MRD			
BELLMTS	BELLMTS	BELLMTS	ASPHALT PATH	SOUTH/EAST MED. GUTTER			DBW			
100 GAS	GAS	100 GAS	LANDSCAPING FEATURE	NORTH/WEST DITCH			AS NOTED			
T.S.	TRAFFIC SIGNALS	T.S.	GRASS/SOD	SOUTH/EAST DITCH			VERTICAL			
S.L.	STREET LIGHTS	S.L.	ELEVATION	NORTH/WEST SIDEWALK						
	MANHOLE		PROPERTY LINE	SOUTH/EAST SIDEWALK						
	CATCH BASIN		CURB RAMP							
	CATCH PIT		DETECTABLE TILE							
EXISTING	LEGEND-PLAN	PROPOSED	EXISTING	LEGEND-PLAN	PROPOSED	EXISTING	LEGEND-PROFILE	PROPOSED		CONSULTANT PROJECT NUMBER 24-8133