

PHASE 2 - STAGE 2:

SUGGESTED SCHEDULE:

- 2 MONTHS
- APRIL - MAY 2025

MAJOR CONSTRUCTION ACTIVITIES:


1. CONCRETE ROAD REPAIR
2. PERMANENT AND TEMPORARY SIDEWALKS
3. PIECEMEAL WATERPROOFING AND SIDEWALKS TO MAINTAIN ACCESS TO DOORWAYS/STAIRWAYS (NOT ALL SUB-STAGES SHOWN)

TRAFFIC CONTROL:

- CURB LANES CLOSED IN ALL DIRECTIONS

PEDESTRIAN CONTROL:

- SE CORNER PEDESTRIANS**
- MAINTAIN ACCESS TO 333 MAIN, 191 PIONEER
 - NO ACCESS ACROSS CORNER, DETOUR VIA PIONEER-WESTBROOK
 - NO ACCESS TO STAIRCASE
- SW CORNER PEDESTRIANS**
- MAINTAIN ACCESS TO 200 MAIN (SCOTIA BANK), 360 MAIN AND 210 PORTAGE (CONCOURSE)
 - MAINTAIN ACCESS ACROSS CORNER
 - MAINTAIN ACCESS TO STAIRCASE (210 PORTAGE)
- NW CORNER PEDESTRIANS**
- MAINTAIN ACCESS TO 201 PORTAGE PLAZA DOORS
 - SHORT TERM CLOSURES OF OTHER DOORS TO FACILITATE WATERPROOFING/SIDEWALK CONSTRUCTION
 - MAINTAIN ACCESS ACROSS CORNER VIA DETOUR ALONG PORTAGE AVE CURB LANE
 - SHORT TERM CLOSURE OF STAIRCASE TO FACILITATE WATERPROOFING/SIDEWALK CONSTRUCTION
- NE CORNER PEDESTRIANS**
- MAINTAIN ACCESS TO 1 LOMBARD PLACE (RICHARDSON BLDG)
 - ACCESS ACROSS CORNER THROUGH 1 LOMBARD PLACE PLAZA
 - MAINTAIN ACCESS TO STAIRCASE

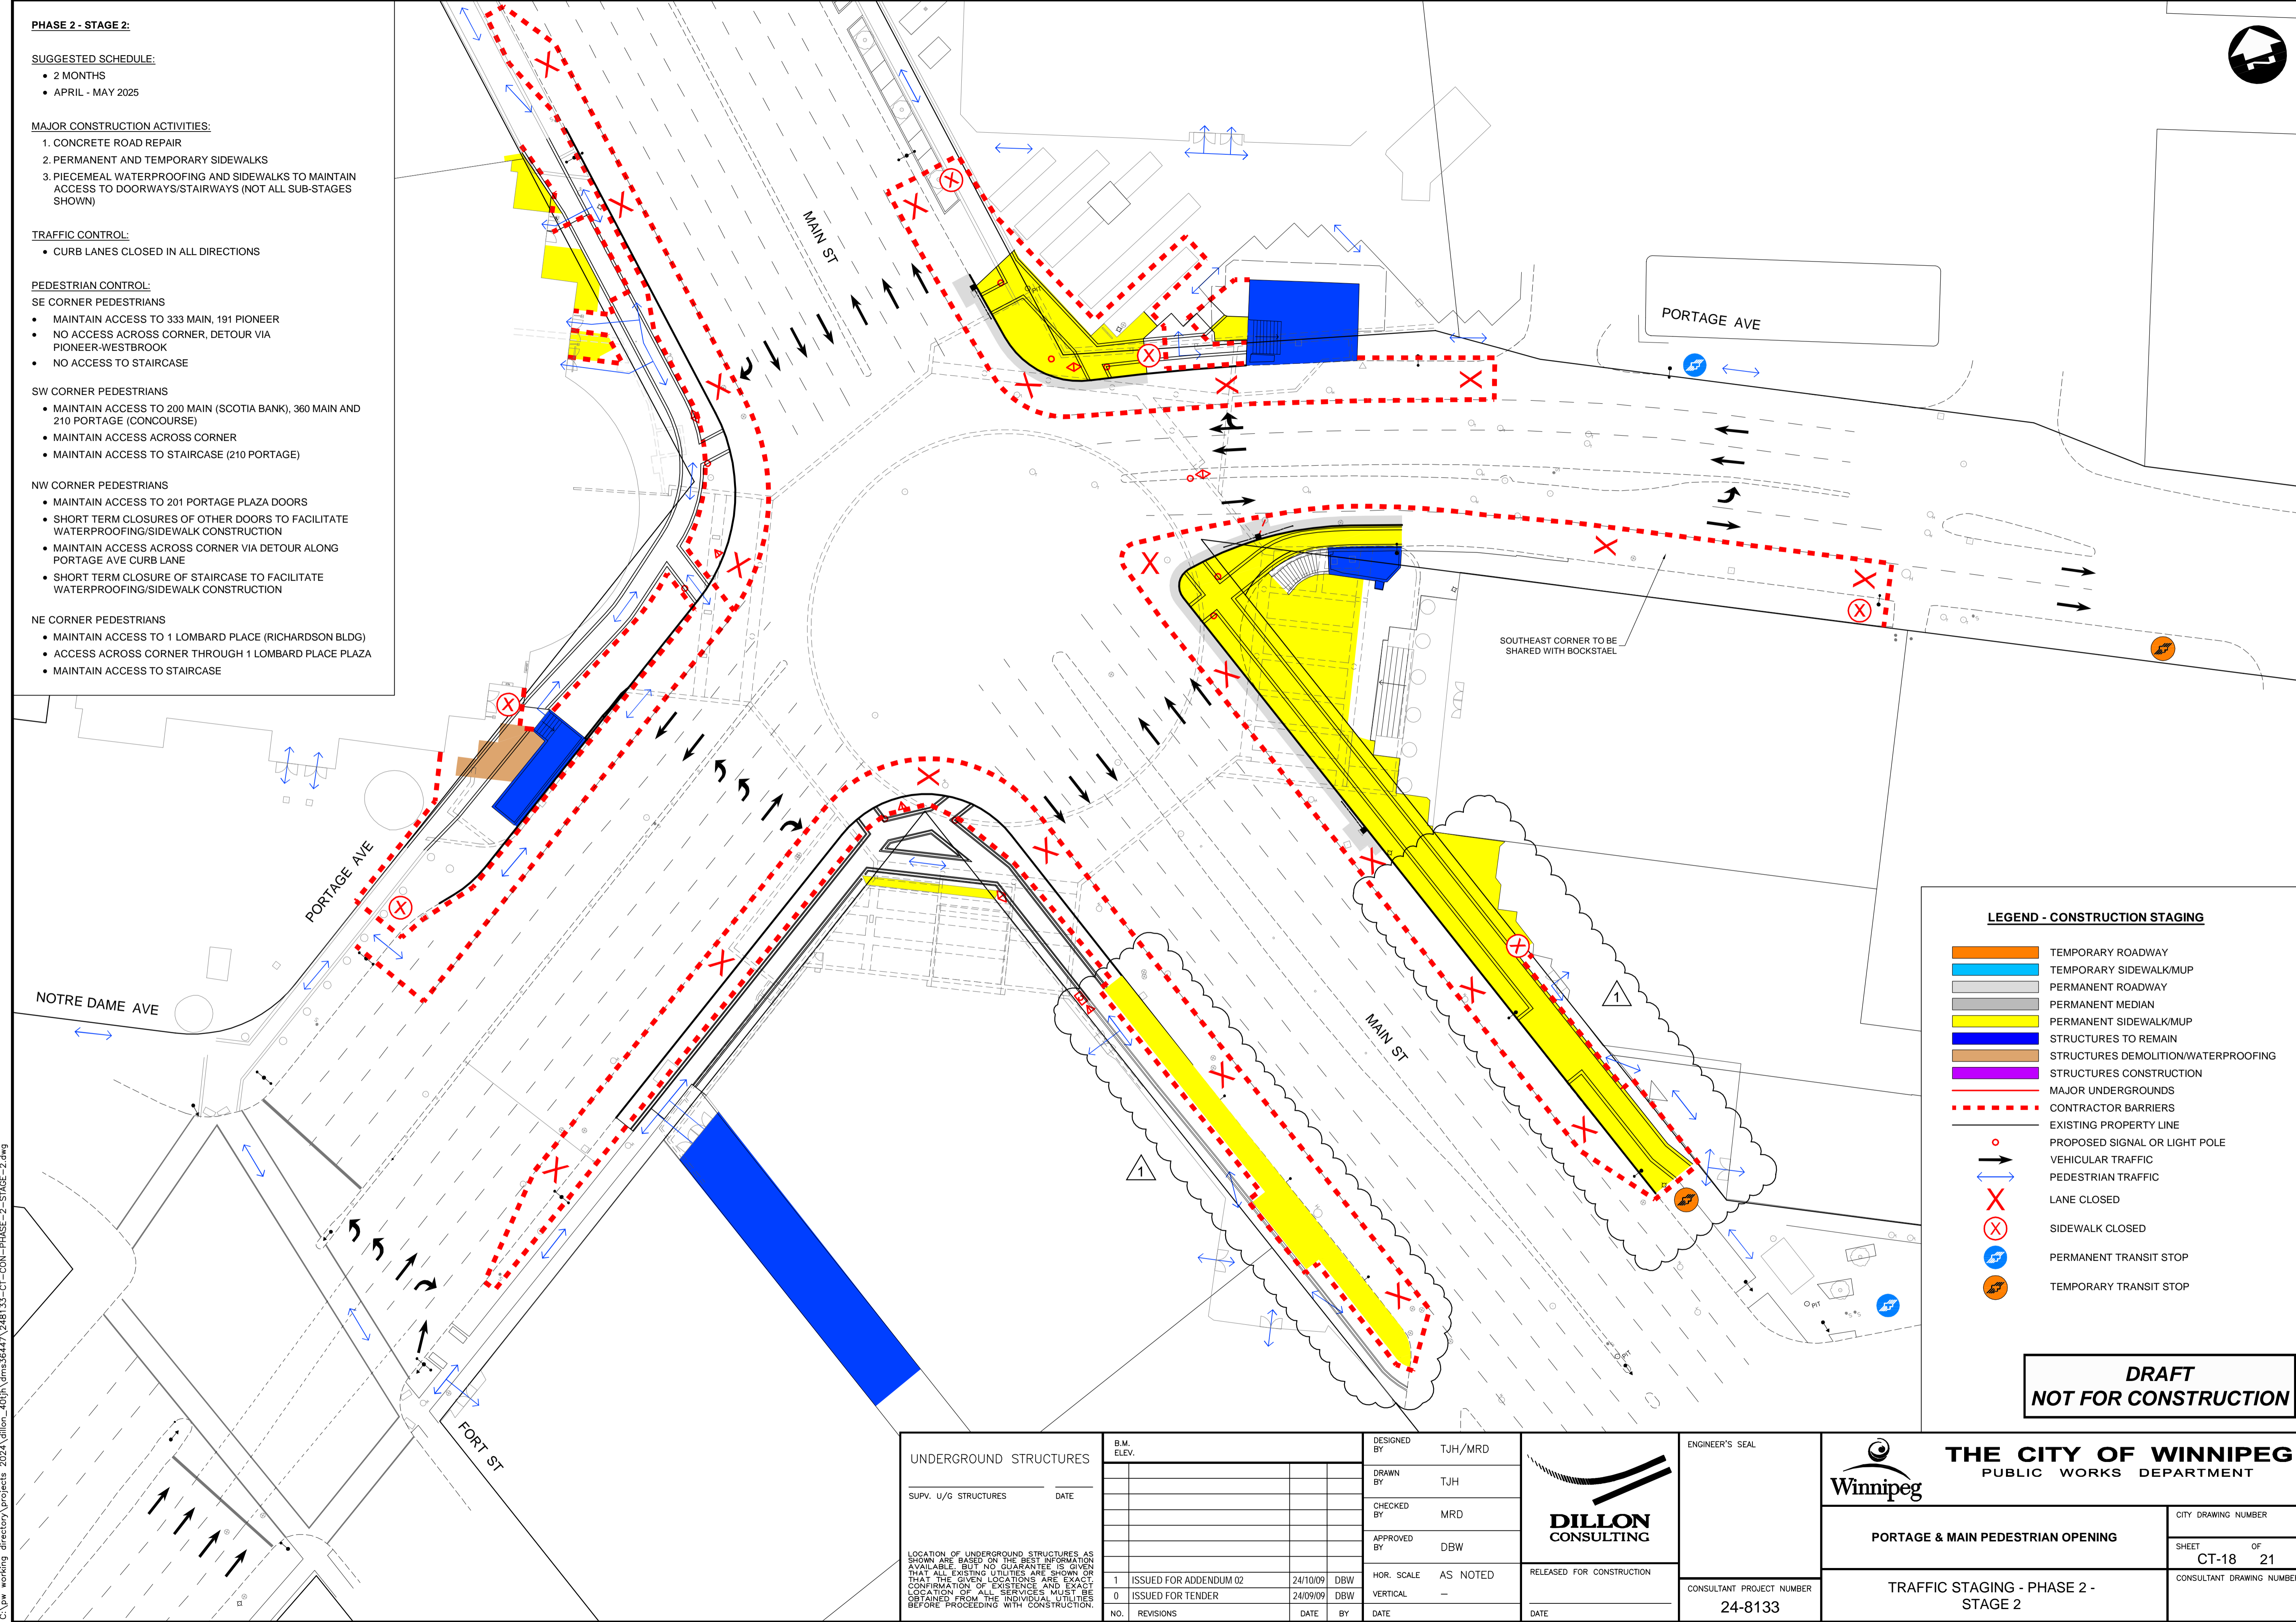

LEGEND - CONSTRUCTION STAGING

- TEMPORARY ROADWAY
- TEMPORARY SIDEWALK/MUP
- PERMANENT ROADWAY
- PERMANENT MEDIAN
- PERMANENT SIDEWALK/MUP
- STRUCTURES TO REMAIN
- STRUCTURES DEMOLITION/WATERPROOFING
- STRUCTURES CONSTRUCTION
- MAJOR UNDERGROUNDS
- CONTRACTOR BARRIERS
- EXISTING PROPERTY LINE
- PROPOSED SIGNAL OR LIGHT POLE
- VEHICULAR TRAFFIC
- PEDESTRIAN TRAFFIC
- X LANE CLOSED
- X SIDEWALK CLOSED
- PERMANENT TRANSIT STOP
- TEMPORARY TRANSIT STOP

**DRAFT
NOT FOR CONSTRUCTION**

UNDERGROUND STRUCTURES	
SUPV. U/G STRUCTURES	DATE

B.M. ELEV.			

DESIGNED BY	TJH/MRD
DRAWN BY	TJH
CHECKED BY	MRD
APPROVED BY	DBW
HOR. SCALE	AS NOTED
VERTICAL	-

DILLON CONSULTING

RELEASED FOR CONSTRUCTION

ENGINEER'S SEAL	
CONSULTANT PROJECT NUMBER	24-8133

**THE CITY OF WINNIPEG
PUBLIC WORKS DEPARTMENT**

PORTAGE & MAIN PEDESTRIAN OPENING

TRAFFIC STAGING - PHASE 2 - STAGE 2

CITY DRAWING NUMBER	
SHEET OF	CT-18 21
CONSULTANT DRAWING NUMBER	

C:\pwworking\directory\projects_2024\dillon_400\h\dms36447\248133-CT-CON-PHASE-2-STAGE-2.dwg