


## **APPENDIX 'B'**

# **WAYFINDING AND INTERSECTION IDENTIFICATION PLAQUES**

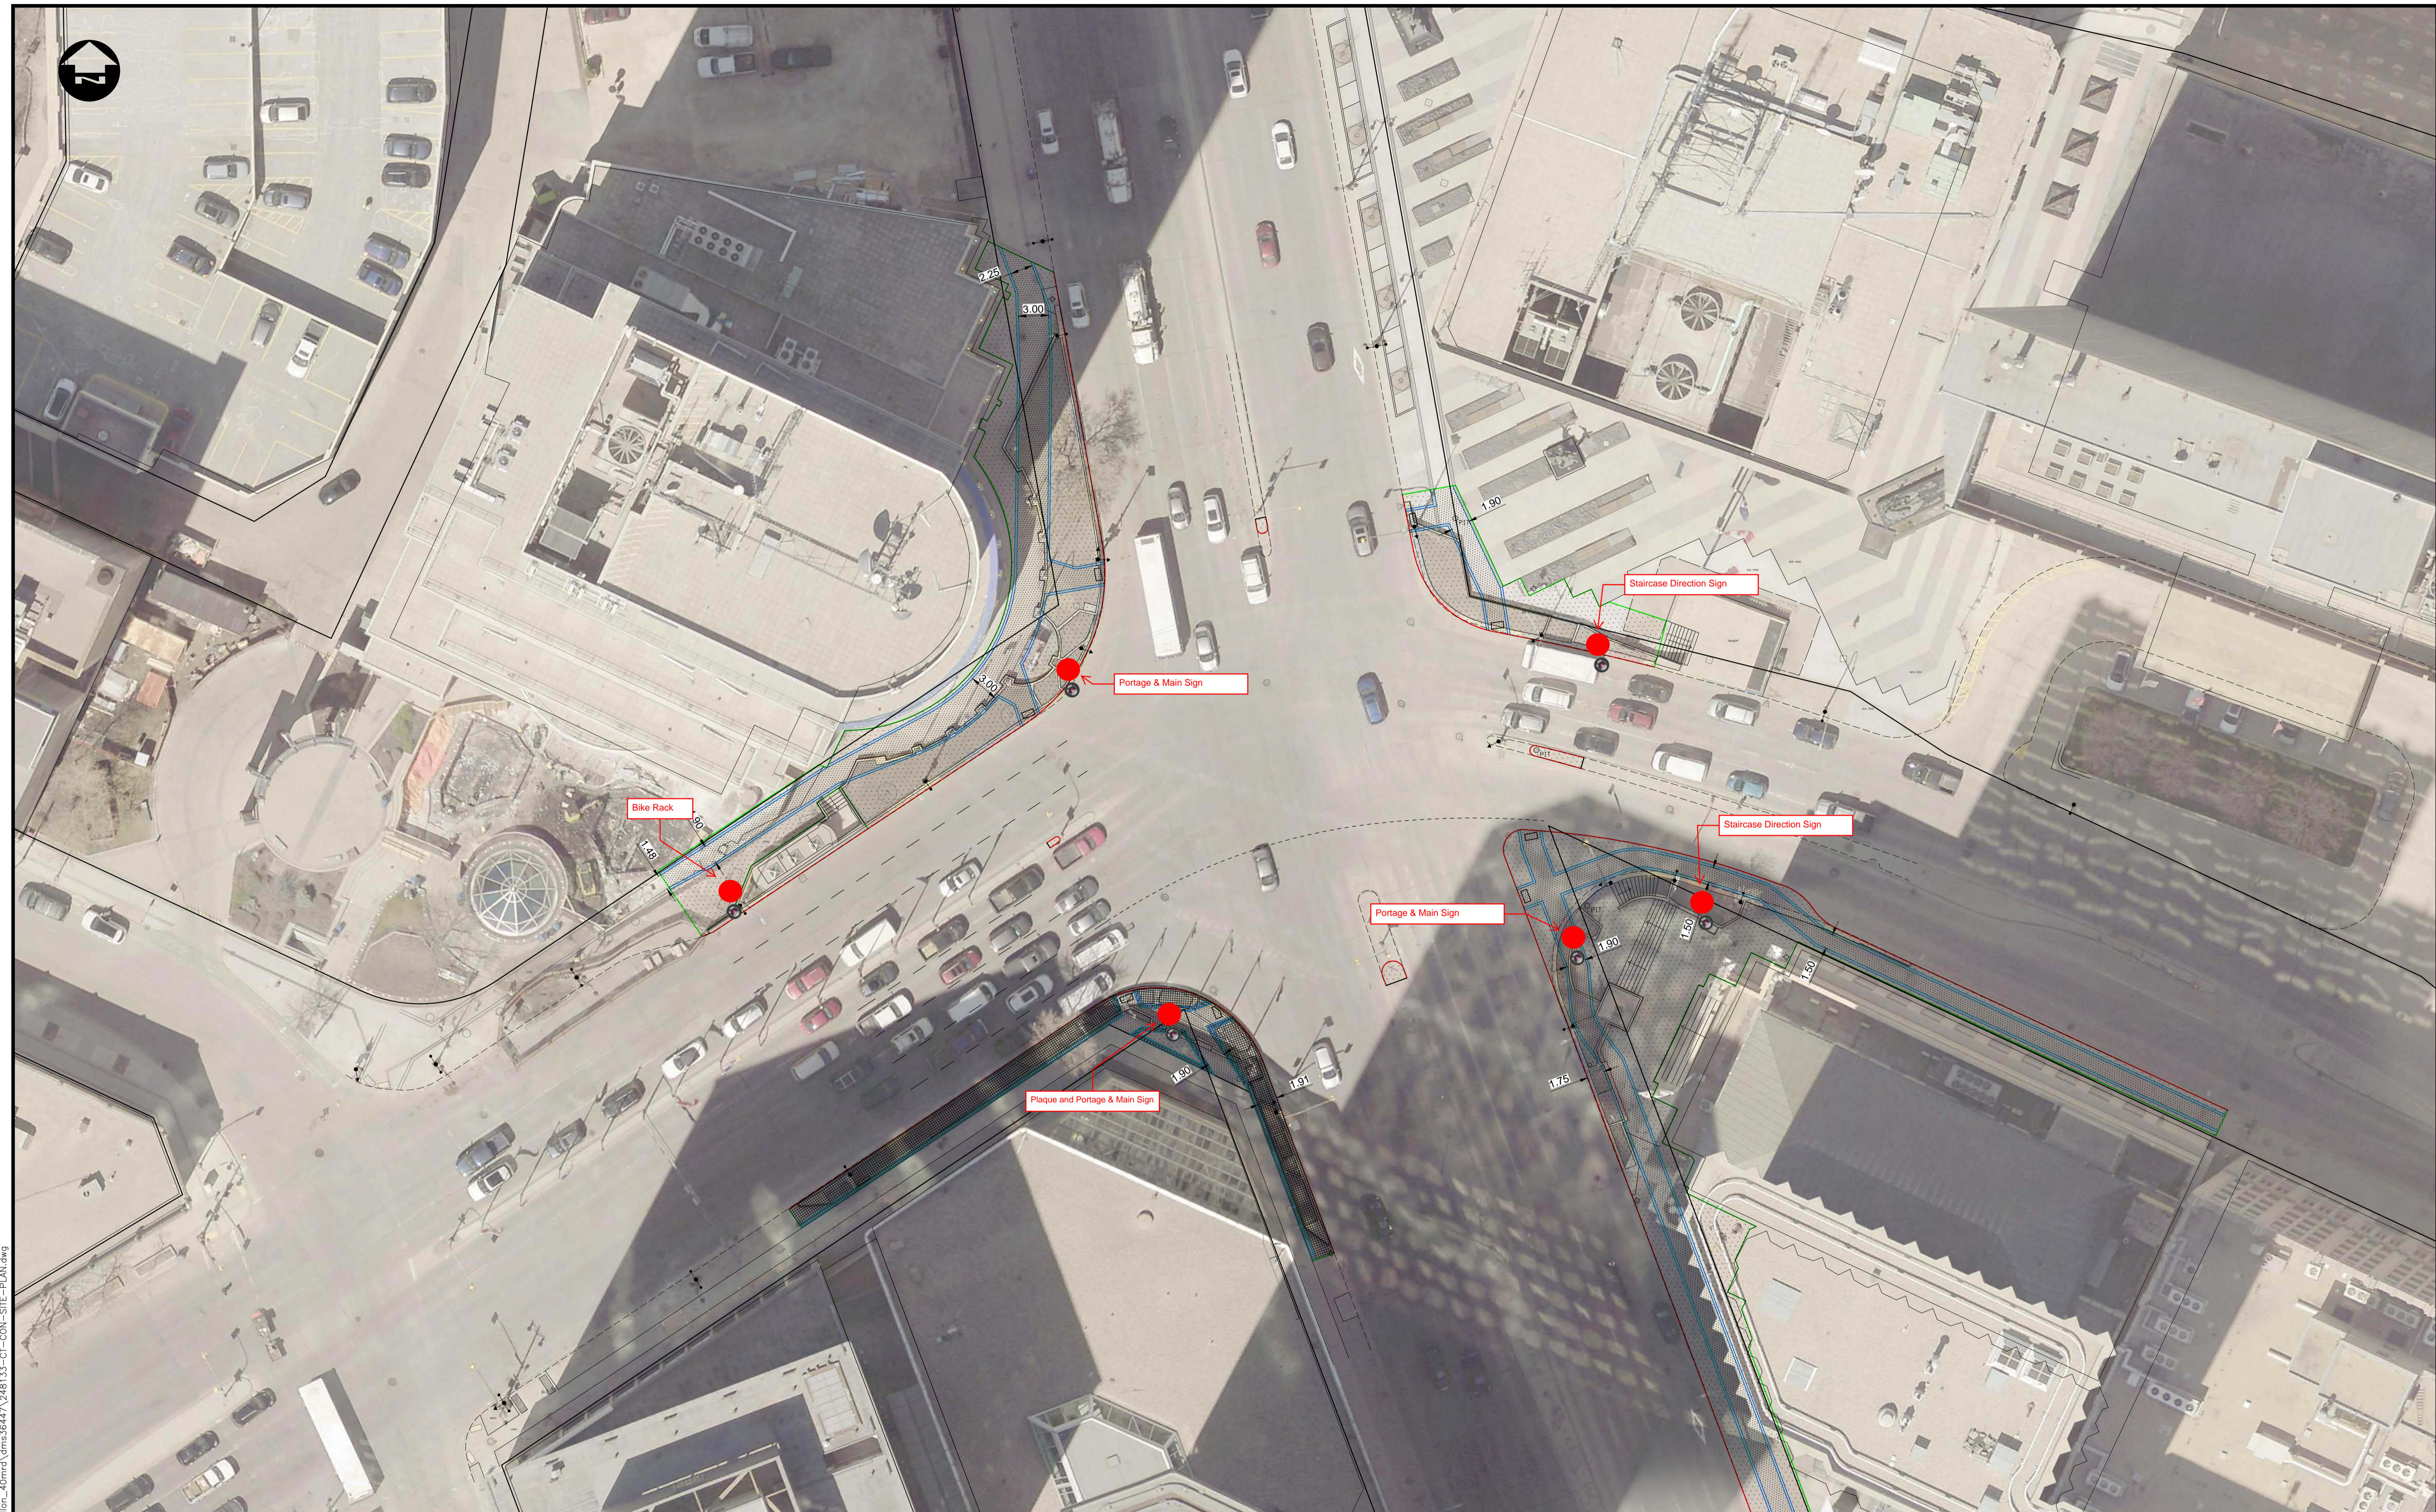


C:\w\working\_directory\projects\_2024\dillon\_40mrd\dms36447\248133-CT-CON-SITE-PLAN.dwg

150 WM	WATERMAIN	150 WM	CONCRETE ROAD	PROFILE	UNDERGROUND STRUCTURES	B.M. ELEV.	DESIGNED BY		ENGINEER'S SEAL		<b>PORTAGE &amp; MAIN PEDESTRIAN OPENING</b> PRELIMINARY DESIGN	CITY DRAWING NUMBER		
300 LDS	LAND DRAINAGE SEWER	300 LDS	ASPHALT ROAD	NORTH/WEST GUTTER	SUPV. U/G STRUCTURES	DATE	BY		DATE			CONSULTANT PROJECT NUMBER	SHEET	OF
250 WWS	WASTE WATER SEWER	250 WWS	CONC ROAD W/ASP OVERLAY	SOUTH/EAST GUTTER			TJH/MRD					24-8133	01	XX
HYDRO	HYDRO	BELLMTS	CONCRETE SIDEWALK	NORTH/WEST MED. GUTTER			TJH		RELEASED FOR CONSTRUCTION					
BELLMTS	BELLMTS	100 GAS	ASPHALT PATH	SOUTH/EAST MED. GUTTER			MRD							
100 GAS	GAS	T.S.	LANDSCAPING FEATURE	NORTH/WEST DITCH			DBW							
S.L.	STREET LIGHTS	S.L.	GRASS/SOD	SOUTH/EAST DITCH			1:300							
	MANHOLE		ELEVATION	NORTH/WEST SIDEWALK			VERTICAL							
	CATCH BASIN		PROPERTY LINE	SOUTH/EAST SIDEWALK										
	CATCH PIT		CURB RAMP											
EXISTING	LEGEND-PLAN	PROPOSED	DETECTABLE TILE	LEGEND-PROFILE	PROPOSED									

LOCATION OF UNDERGROUND STRUCTURES AS SHOWN ARE BASED ON THE BEST INFORMATION AVAILABLE BUT NO GUARANTEE IS GIVEN THAT ALL EXISTING UTILITIES ARE SHOWN OR THAT THE GIVEN LOCATIONS ARE EXACT. CONFIRMATION OF EXISTENCE AND EXACT LOCATION OF ALL SERVICES MUST BE OBTAINED FROM THE INDIVIDUAL UTILITIES BEFORE PROCEEDING WITH CONSTRUCTION.

# Capture Media Summary

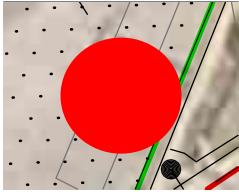


**Subject:** Site Photo's  
**Date:** 6/4/2024 1:36:14 PM  
**Author:** 40TBN  
**Page:** [1] OVERALL SITE PLAN  
**Space:**  
**Status:**

**Comments:**

Bike Rack NW Corner



Site Photo's - 2 (1 of 1)

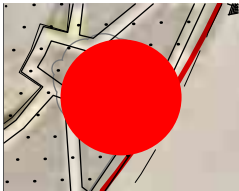


**Subject:** Site Photo's  
**Date:** 6/4/2024 1:31:42 PM  
**Author:** 40TBN  
**Page:** [1] OVERALL SITE PLAN  
**Space:**  
**Status:**

**Comments:**

Portage & Main Sign NW Corner




Site Photo's - 4 (1 of 1)

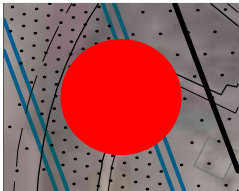

**Subject:** Site Photo's  
**Date:** 6/4/2024 1:30:56 PM  
**Author:** 40TBN  
**Page:** [1] OVERALL SITE PLAN  
**Space:**  
**Status:**


**Comments:**

Portage & Main Sign SE Corner

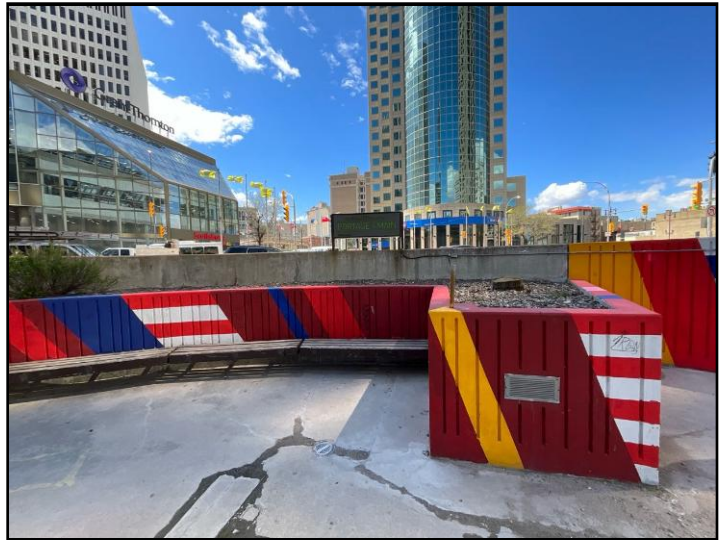

Site Photo's - 1 (1 of 1)

# Capture Media Summary

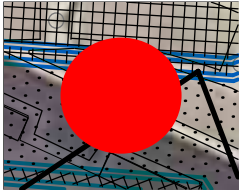


**Subject:** Site Photo's  
**Date:** 6/4/2024 1:32:02 PM  
**Author:** 40TBN  
**Page:** [1] OVERALL SITE PLAN  
**Space:**  
**Status:**




**Comments:**

Portage & Main Sign SE Corner  
Portage Avenue Plaque in Sidewalk

Site Photo's - 5 (1 of 1)

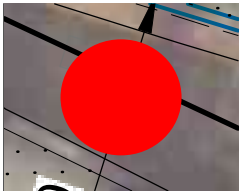


**Subject:** Site Photo's  
**Date:** 6/4/2024 1:31:26 PM  
**Author:** 40TBN  
**Page:** [1] OVERALL SITE PLAN  
**Space:**  
**Status:**

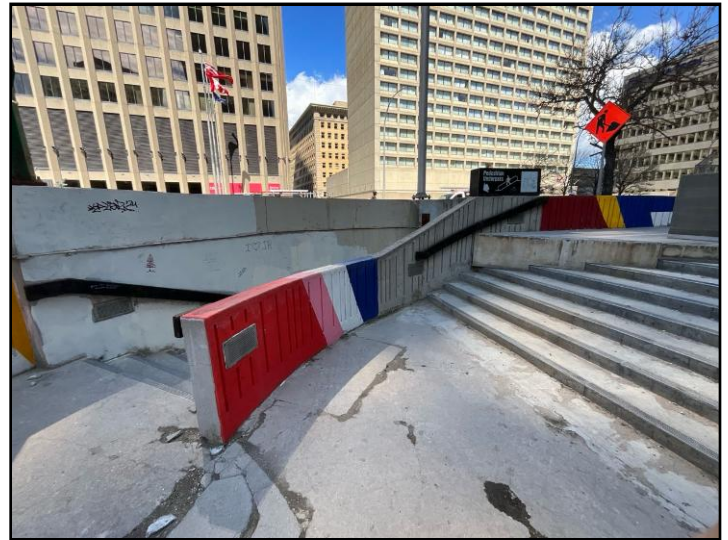


**Comments:**

Staircase Direction Sign SE Corner

Site Photo's - 2 (1 of 1)

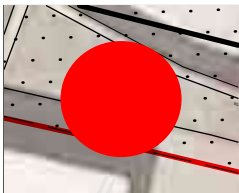

**Subject:** Site Photo's  
**Date:** 6/4/2024 1:34:02 PM  
**Author:** 40TBN  
**Page:** [1] OVERALL SITE PLAN  
**Space:**  
**Status:**

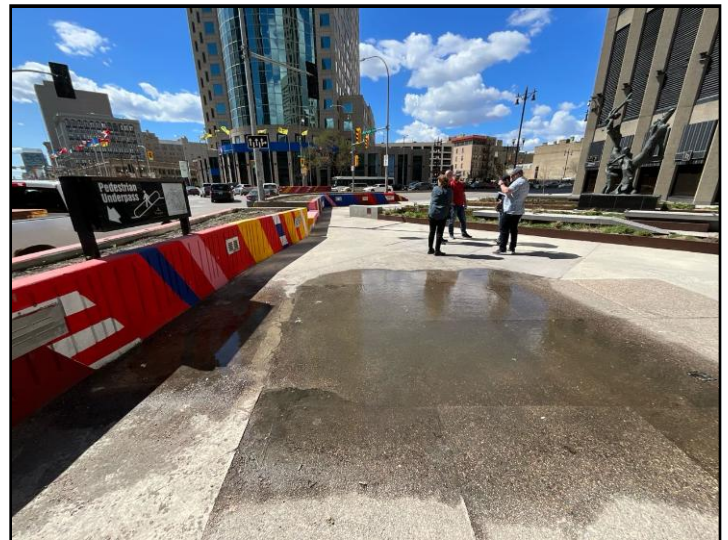

**Comments:**

Staircase Direction Sign SE Corner

Site Photo's - 1 (1 of 1)