


LAST SAVE: 2025/04/07 8:44 AM
PATH: C:\Users\mhe\MyDocuments\AutoCAD Plant 3D Collaboration\Coach820 SPD_NEW\PC2021 PID DWG01 - Primary Clarifier Upgrade\PP3-M501.dwg

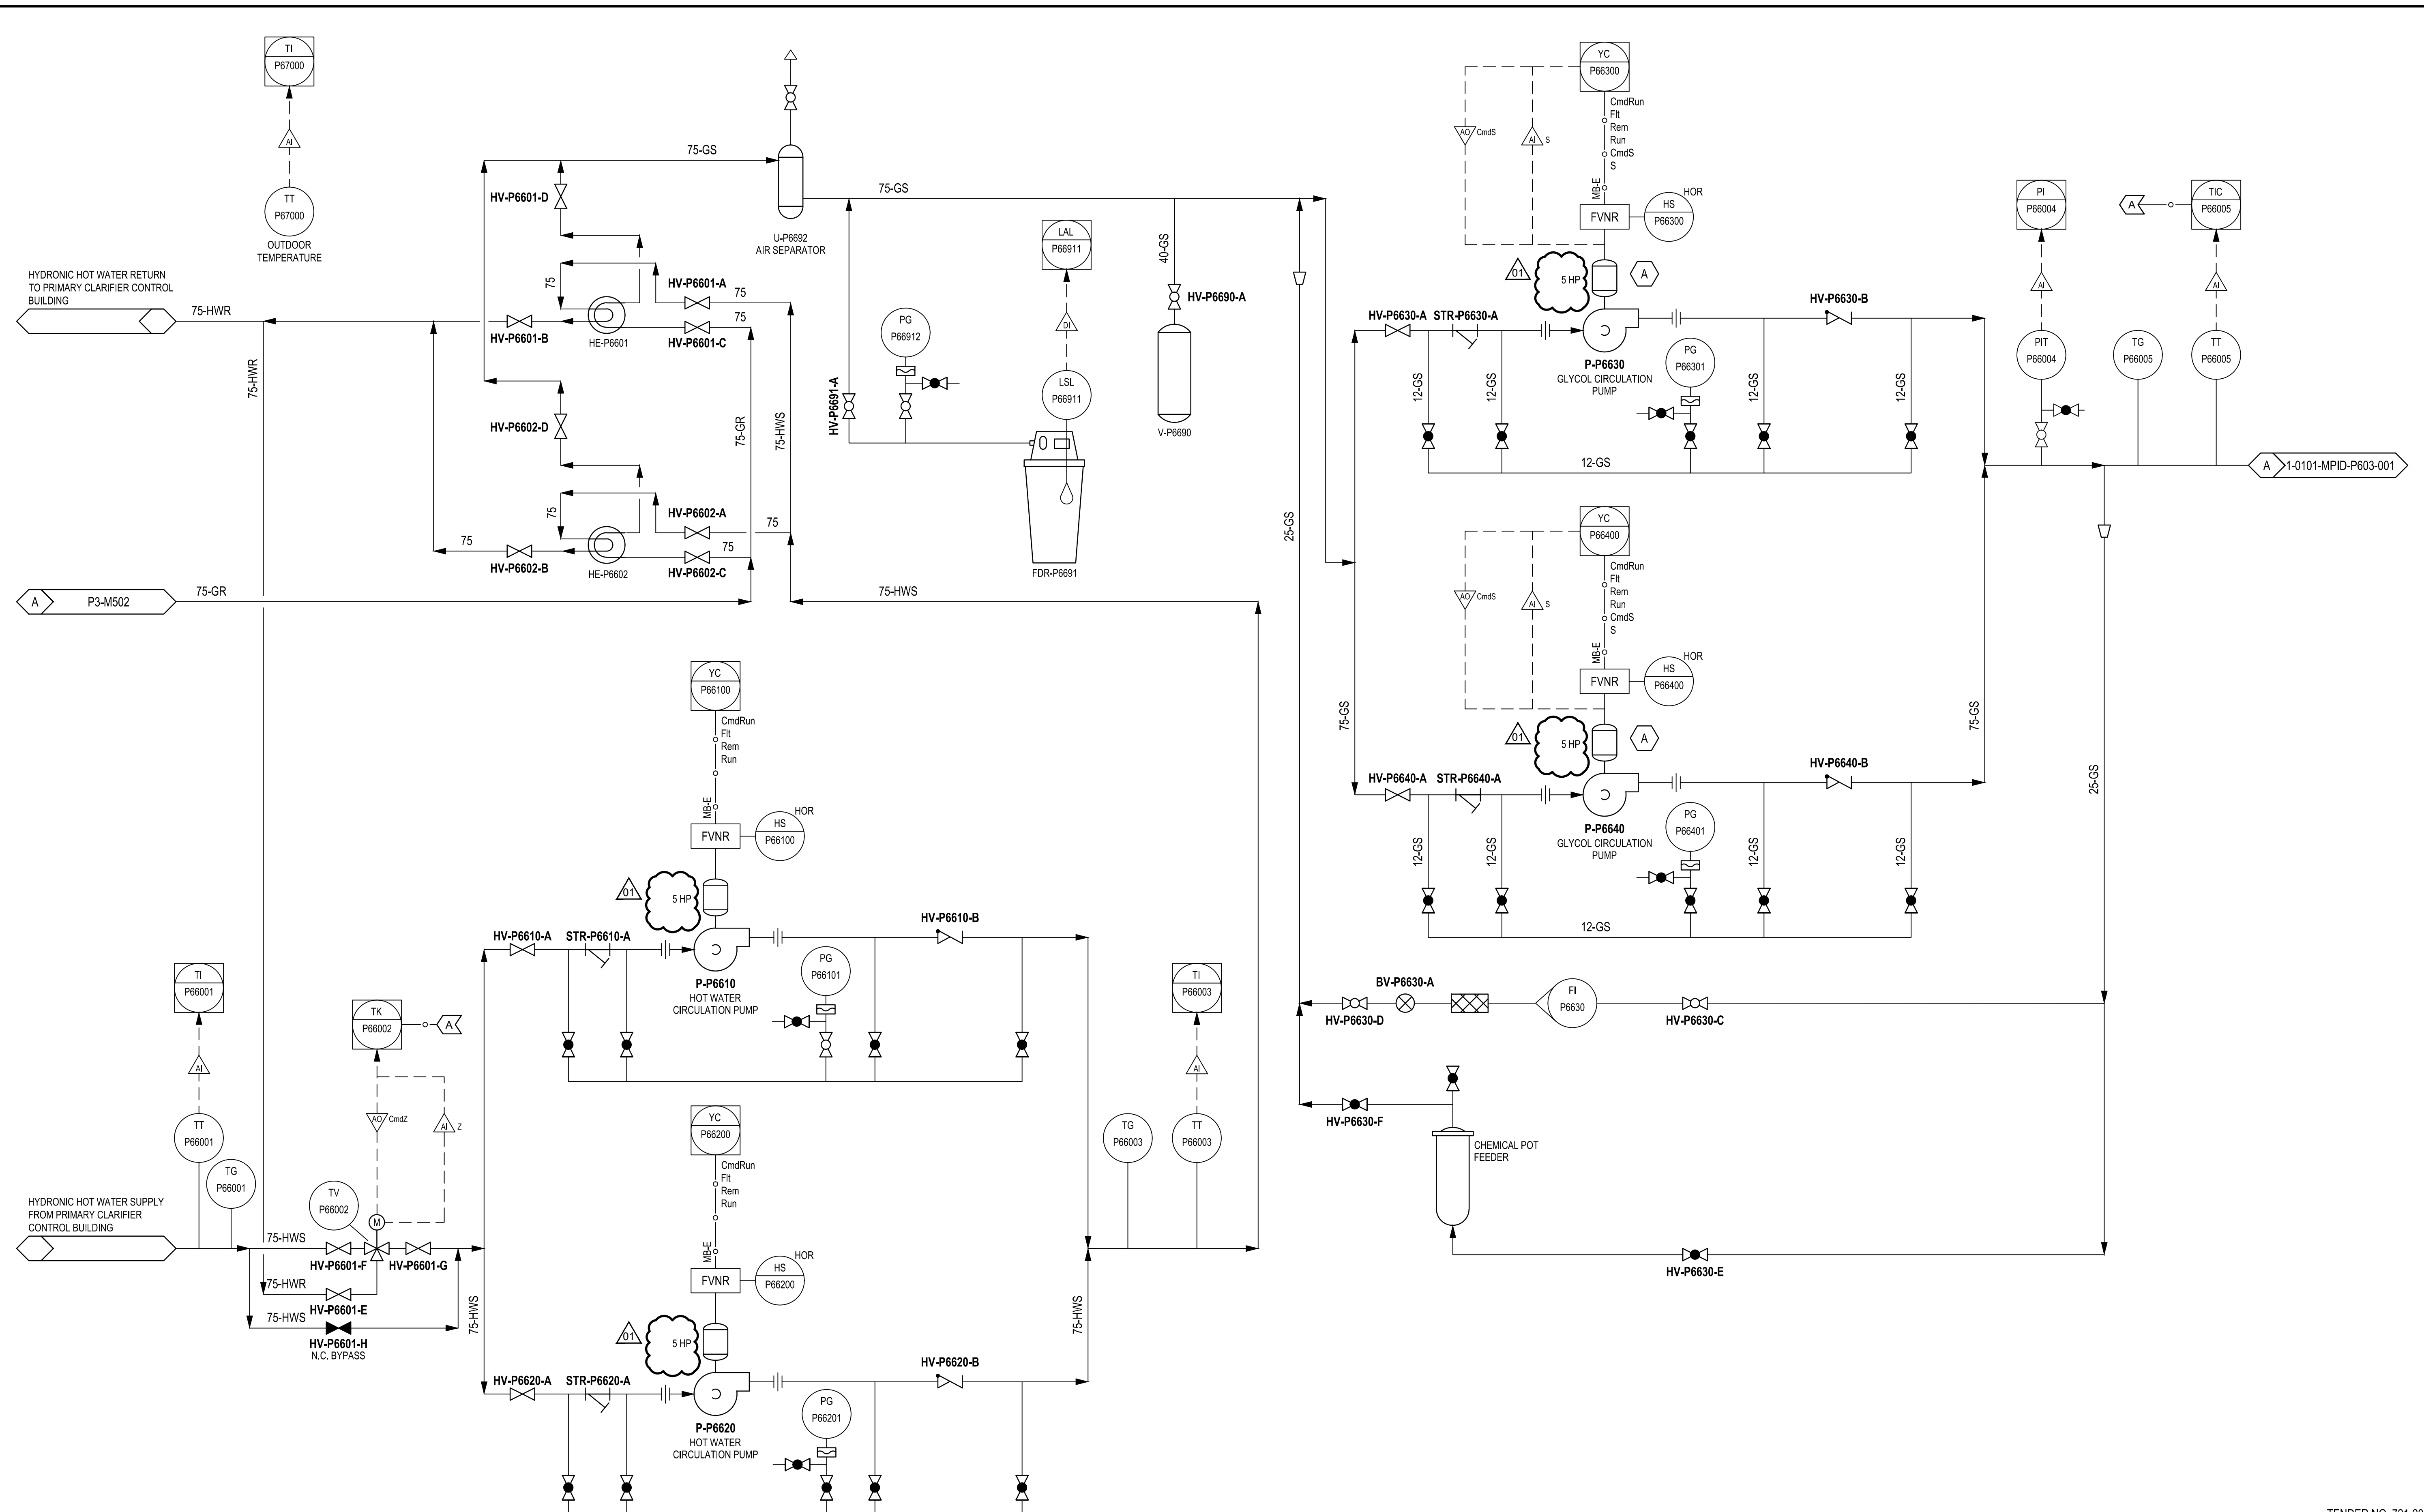

KEYNOTES:
A. PUMP PROVIDED WITH SENSORLESS LOAD DEMAND BASED CONTROL.

ENGINEERS
SCIENTISTS
MANITOBA
Certificate of Authorization
AECOM Canada ULC
No. 4671

				DESIGNED BY: CF		CHECKED BY: CC/PB	
				DRAWN BY: ES		APPROVED BY: NW	
				SCALE: NONE		RELEASED FOR CONSTRUCTION BY:	
				DATE: 2020-12-09		DATE:	
CONSULTANT NO.: P3-M501				CITY DRAWING NUMBER: 1-0101-MPID-P601			
NO. REVISIONS				DATE		DESIGN CHECK	
01 ISSUED FOR ADDENDUM 11				2025-04-07		CF CC/PB	
00 ISSUED FOR TENDER				2025-01-31		CF CC/PB	

ENGINEER'S SEAL		
THE CITY OF WINNIPEG WATER AND WASTE DEPARTMENT		
NORTH END SEWAGE TREATMENT PLANT PRIMARY CLARIFICATION PROJECT PROCESS & INSTRUMENTATION DIAGRAM SCUM BUILDING - BASEMENT HYDRONIC SYSTEM		
SHEET	REV.	SIZE
001	01	A1

TENDER NO. 721-2024