



LAST SAVE: 2025/01/19 2:28 AM
PATH: C:\Users\mhe\AppData\Local\Autodesk\AutoCAD Plant 3D\Collaboration\cshd\SPD_NEW\PPCC 2021 PPD DWG\01_Primary Clarifier Upgrade\PPS-X602.dwg

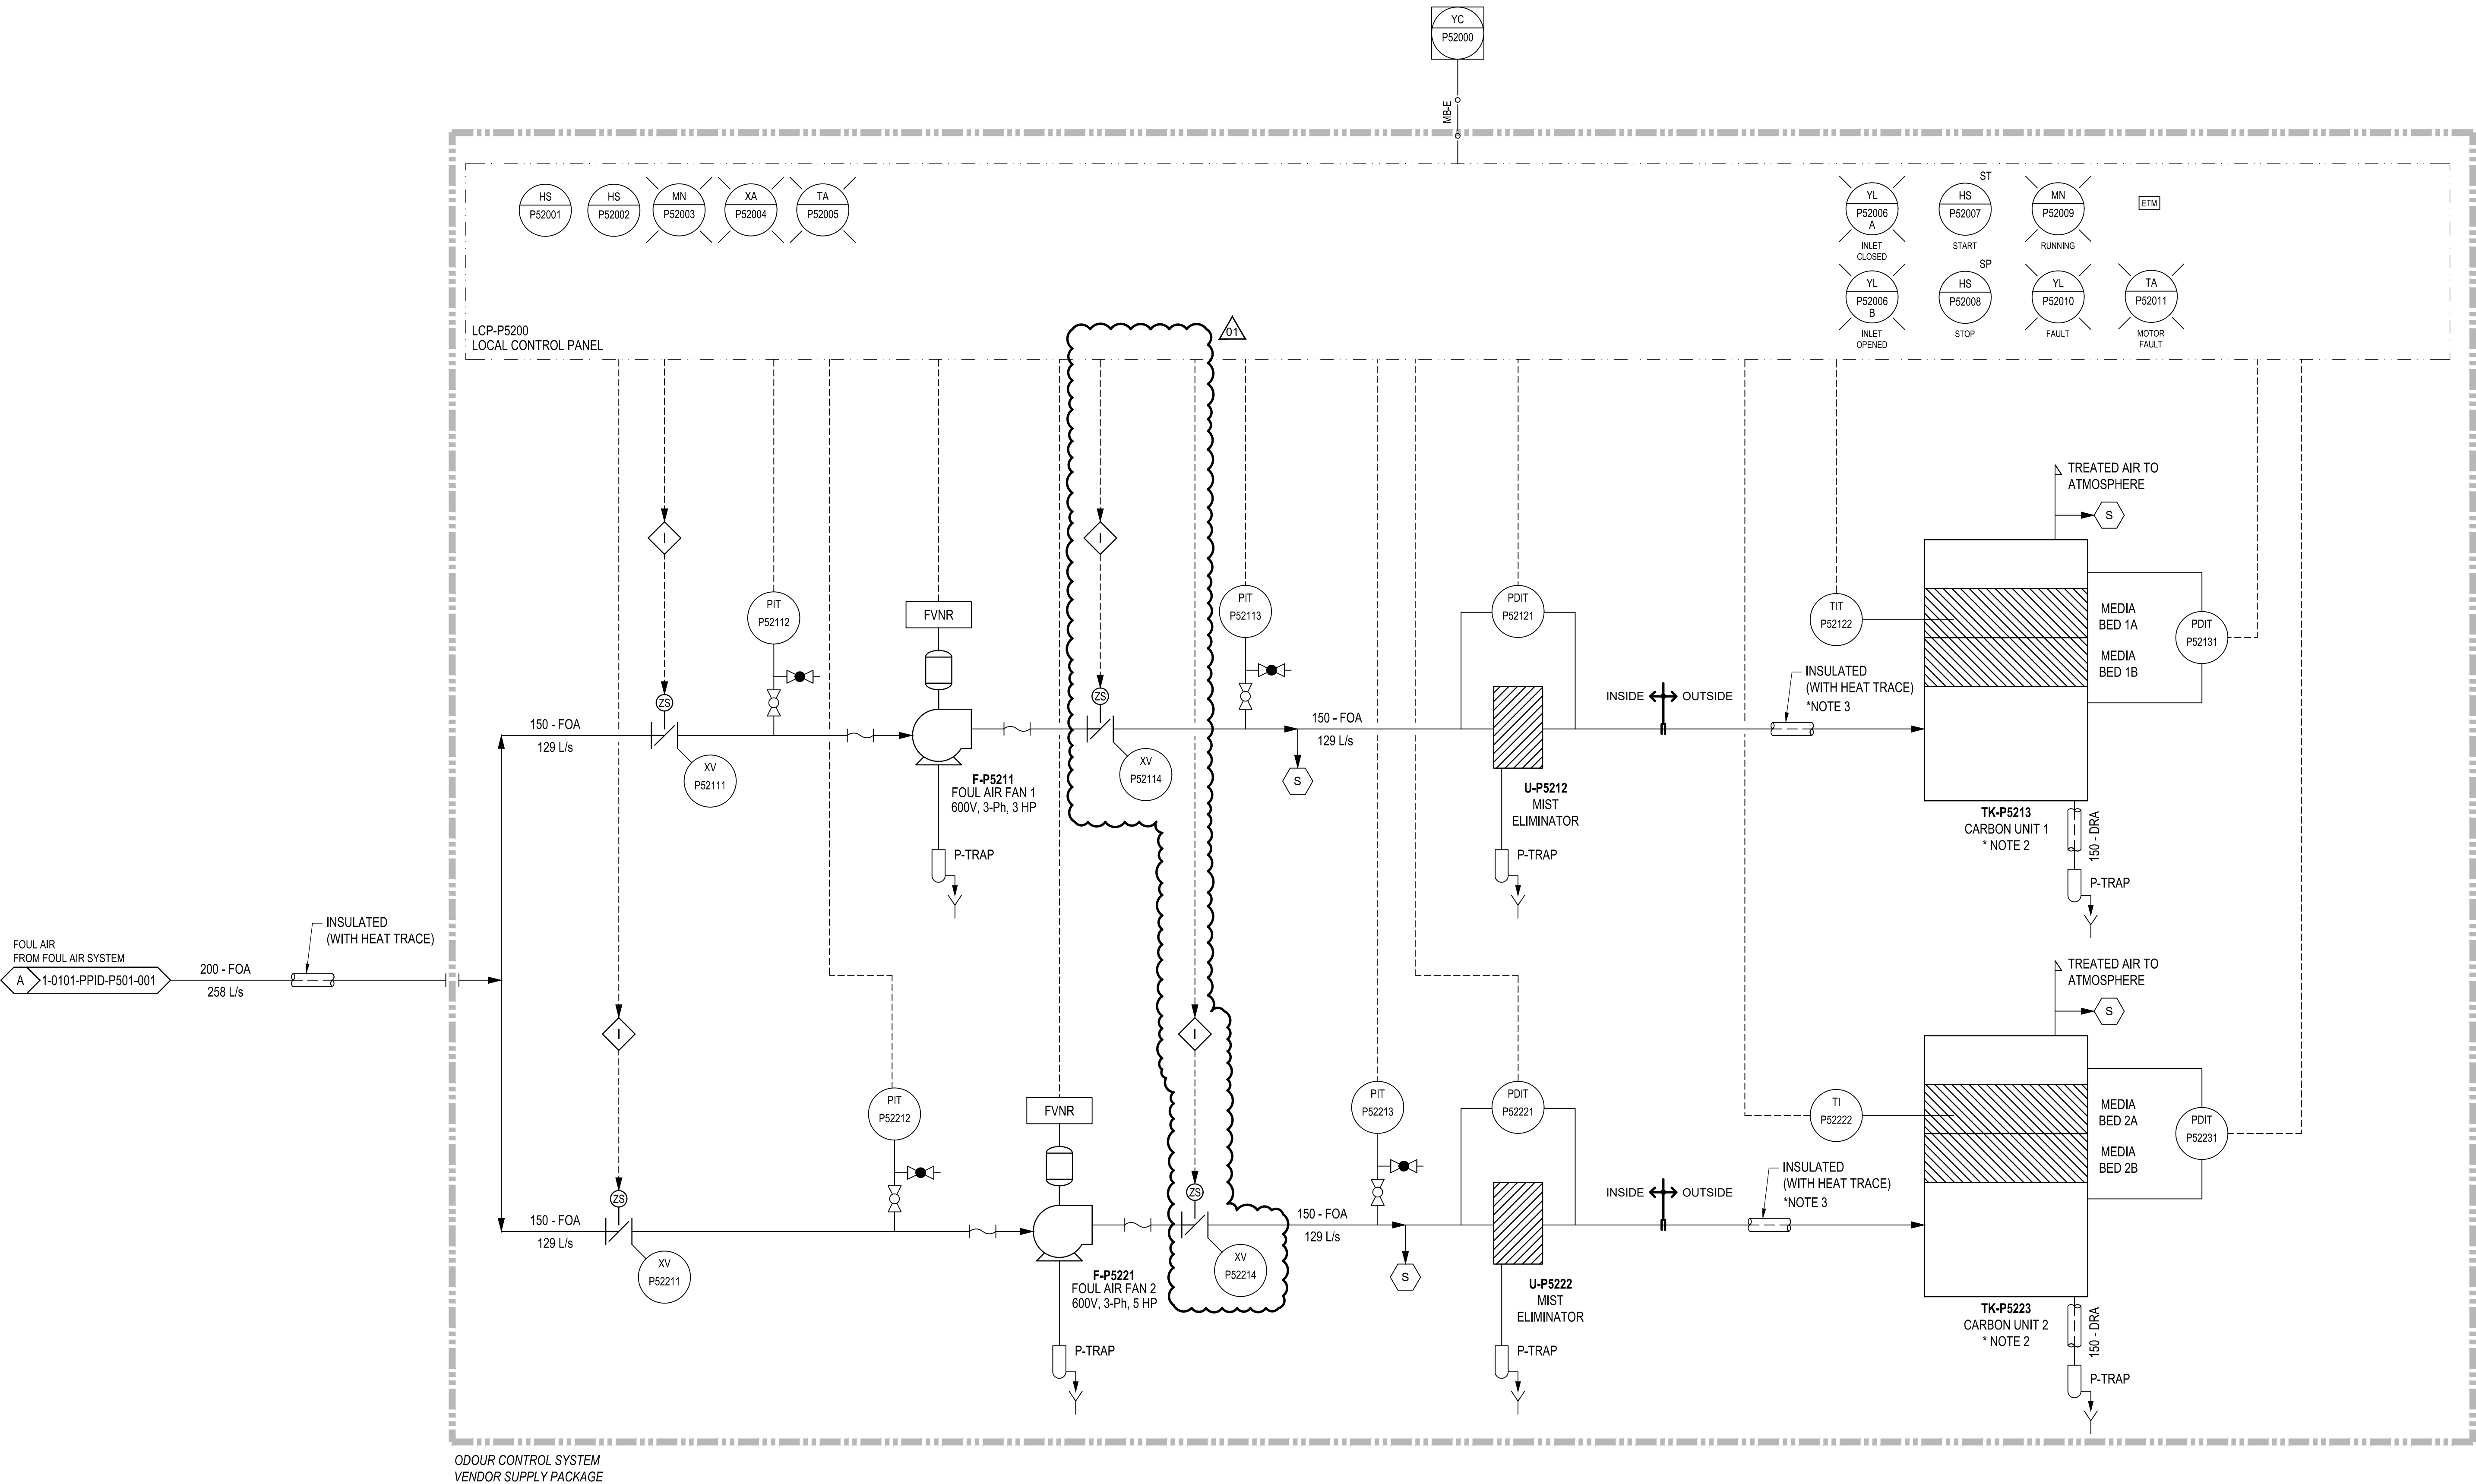

- GENERAL NOTES:
1. SEE MANUFACTURER'S DRAWINGS FOR COMPREHENSIVE LIST OF FEATURES & I/O.
 2. MANUFACTURER TO WINTERIZE CARBON UNITS AND ALL OTHER RELATED EQUIPMENT WITH INSULATION AND HEAT TRACING. AS REQUIRED FOR WINNIPEG WEATHER IN CITY STANDARDS.
 3. INSULATE AND HEAT TRACE OUTDOOR ODOUR CONTROL PIPING AND DRAINS



					AECOM		ENGINEER'S SEAL		<div>THE CITY OF WINNIPEG WATER AND WASTE DEPARTMENT</div>				
					DESIGNED BY: MK	CHECKED BY: PB	<div>NORTH END SEWAGE TREATMENT PLANT PRIMARY CLARIFICATION PROJECT PROCESS & INSTRUMENTATION DIAGRAM PRIMARY CLARIFIER ODOR CONTROL SYSTEM LCP-P5200</div> <div>CITY DRAWING NUMBER 1-0101-PPID-P502</div> <div>SHEET 001</div> <div>REV. 01</div> <div>SIZE A1</div>						
					DRAWN BY: ES	APPROVED BY: NW							
					SCALE: NONE	RELEASED FOR CONSTRUCTION BY:							
					DATE: 2020-12-09	DATE:							
					CONSULTANT NO.: P5-X602								
01	ISSUED FOR ADDENDUM 11		2025-04-04	MK	PB								
00	ISSUED FOR TENDER		2025-01-31	MK	PB								
NO.	REVISIONS		DATE	DESIGN	CHECK								

TENDER NO. 721-2024