



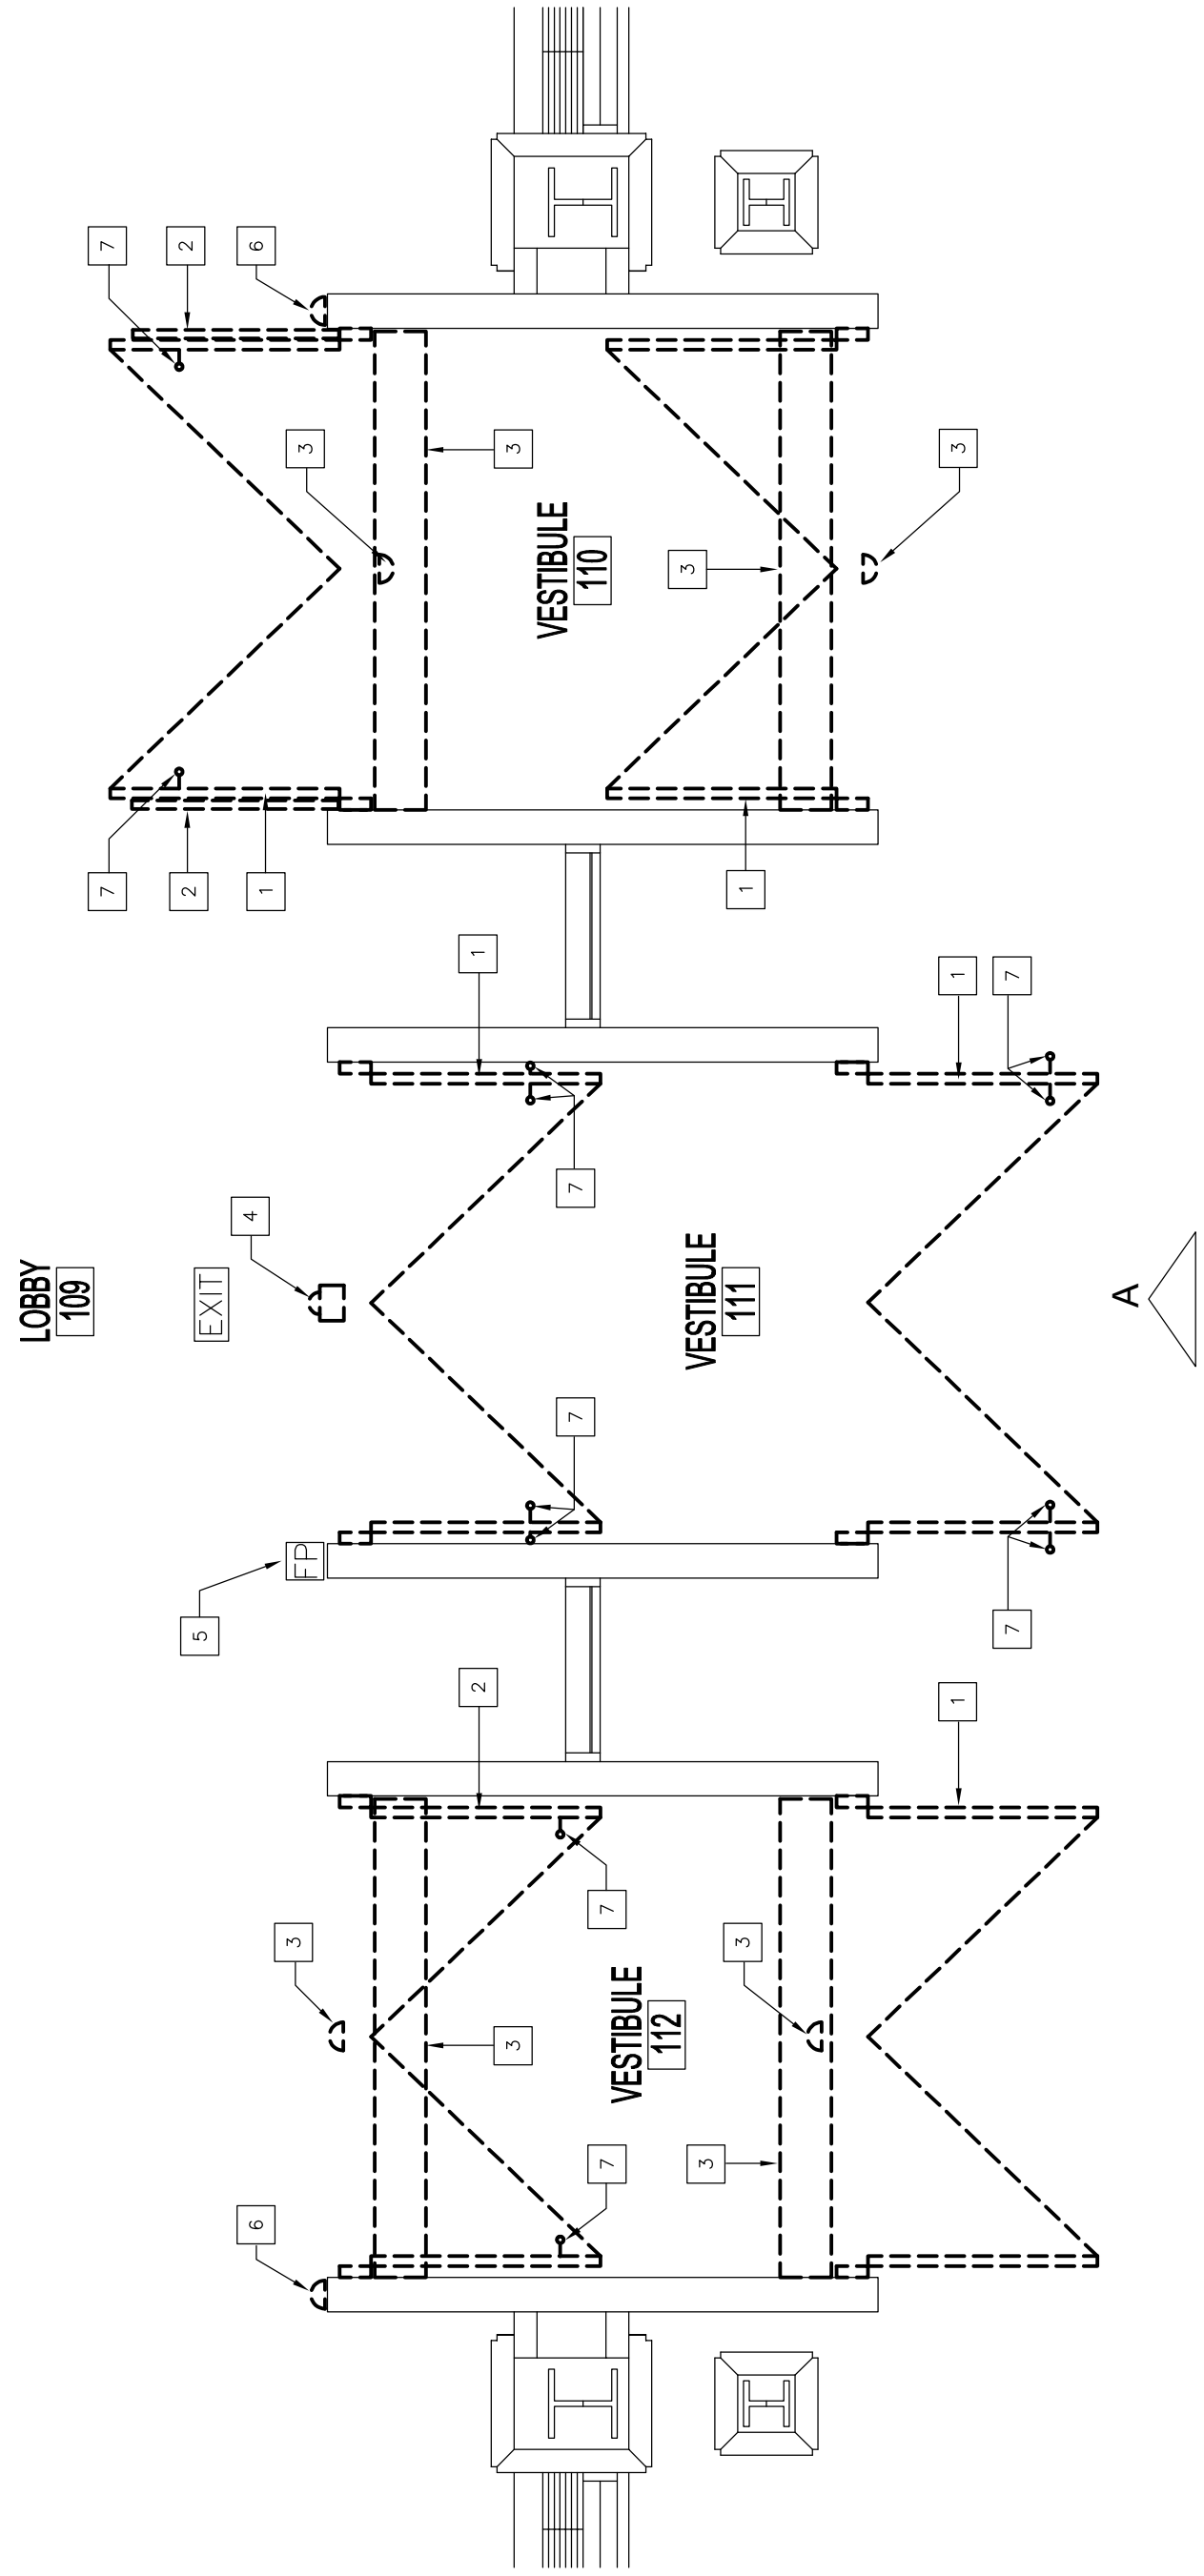

1 DEMOLITION PLAN - ADMINISTRATION BUILDING
SCALE: 3/8" = 1'-0"

DEMOLITION KEYNOTES

- 1 REMOVE EXISTING DOORS, FRAMES, THRESHOLDS HARDWARE AND WINDOWS.
- 2 REMOVE AND SALVAGE EXISTING RAILING FOR REINSTALLATION.
- 3 REMOVE AND SALVAGE EXISTING DOOR OPERATOR, ASSOCIATIVE HARDWARE AND SENSORS. REFER TO ELECTRICAL.
- 4 REMOVE AND SALVAGE EXISTING SECURITY CAMERA FOR REINSTALLATION.
- 5 EXISTING FIRE ALARM PULL STATION TO REMAIN.
- 6 DISCONNECT EXISTING DOOR SENSOR.
- 7 REMOVE AND SALVAGE ALL EXISTING DOOR PULLS FOR REINSTALLATION.

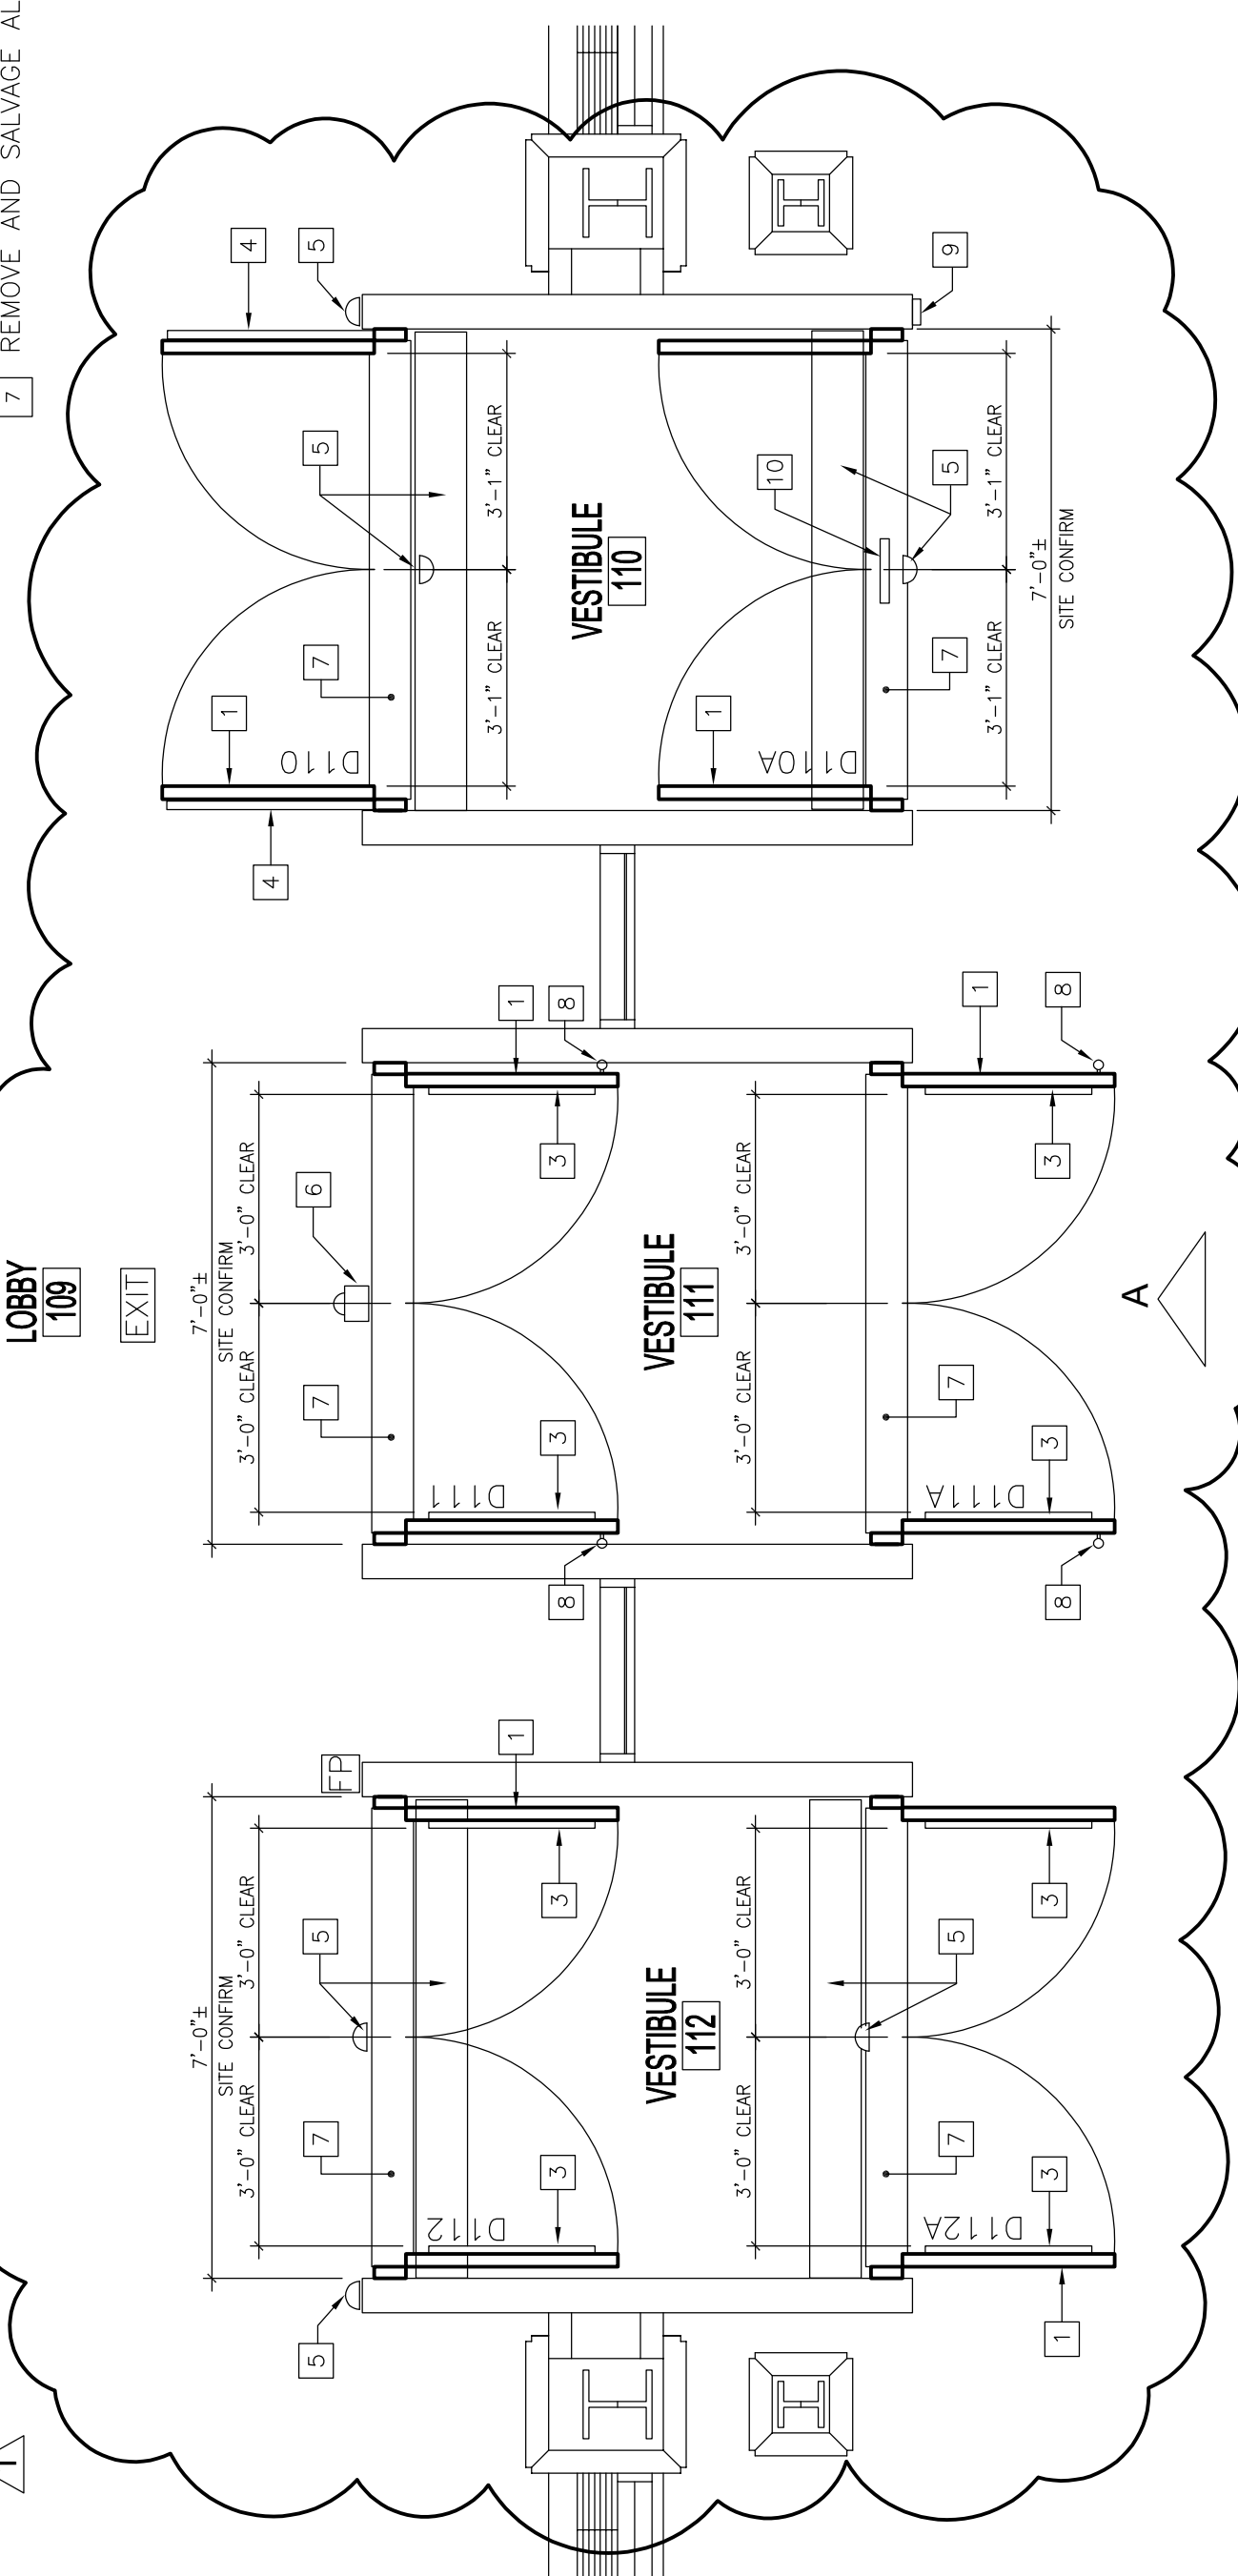


2 NEW CONSTRUCTION PLAN - ADMINISTRATION BUILDING
SCALE: 3/8" = 1'-0"


NEW CONSTRUCTION KEYNOTES

- 1 NEW ALUMINUM EXTERIOR DOORS. REFER TO SPECIFICATIONS & DOOR SCHEDULE.
- 2 NEW ALUMINUM STOREFRONT FRAMING. REFER TO SPECIFICATIONS.
- 3 NEW PANIC HARDWARE. REFER TO SPECIFICATIONS.
- 4 REINSTALL EXISTING SALVAGED RAILING.
- 5 REINSTALL / RECONNECT EXISTING SALVAGED DOOR OPERATOR, SENSOR AND ASSOCIATIVE HARDWARE.

- 6 REINSTALL EXISTING SECURITY CAMERA. REFER TO ELECTRICAL.
- 7 NEW ALUMINUM THRESHOLD. REFER TO SPECIFICATION.
- 8 REINSTALL EXISTING SALVAGED DOOR PULL IN LOCATIONS INDICATED.
- 9 NEW CARD READER TIED INTO EXISTING REINSTALLED DOOR OPERATOR AND NEW ELECTRIC STRIKES. REFER TO ELECTRICAL FOR SPECIFIED READER AND EXACT MOUNTING LOCATION.
- 10 NEW ELECTRIC STRIKES AT TOP OF DOOR FRAME. MODIFY FRAME TO SUIT. REFER TO SPECIFICATIONS. INSTALL TOP LATCHING SYSTEM TO NEW DOORS (D110A).

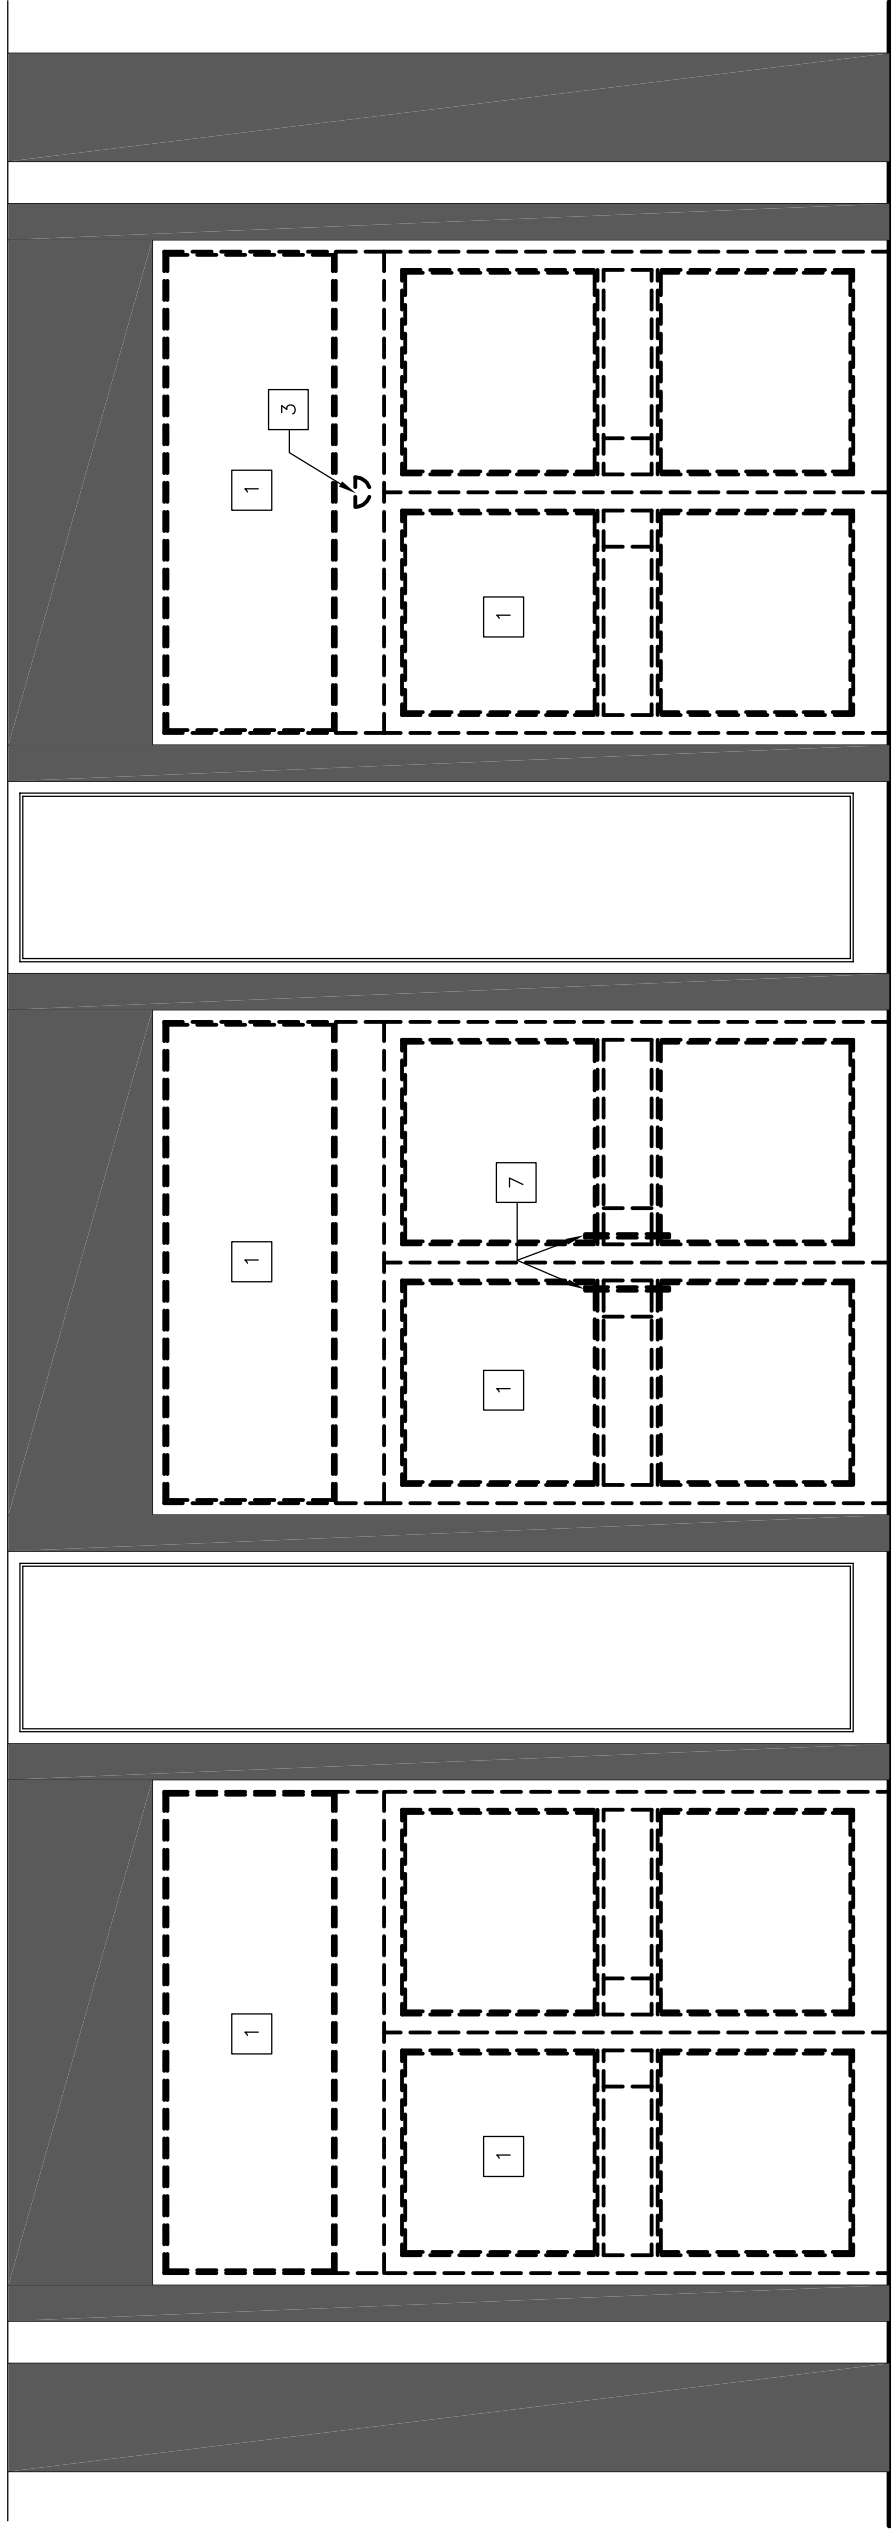

A EXTERIOR DEMOLITION ELEVATION - ADMINISTRATION BUILDING
SCALE: 3/8" = 1'-0"

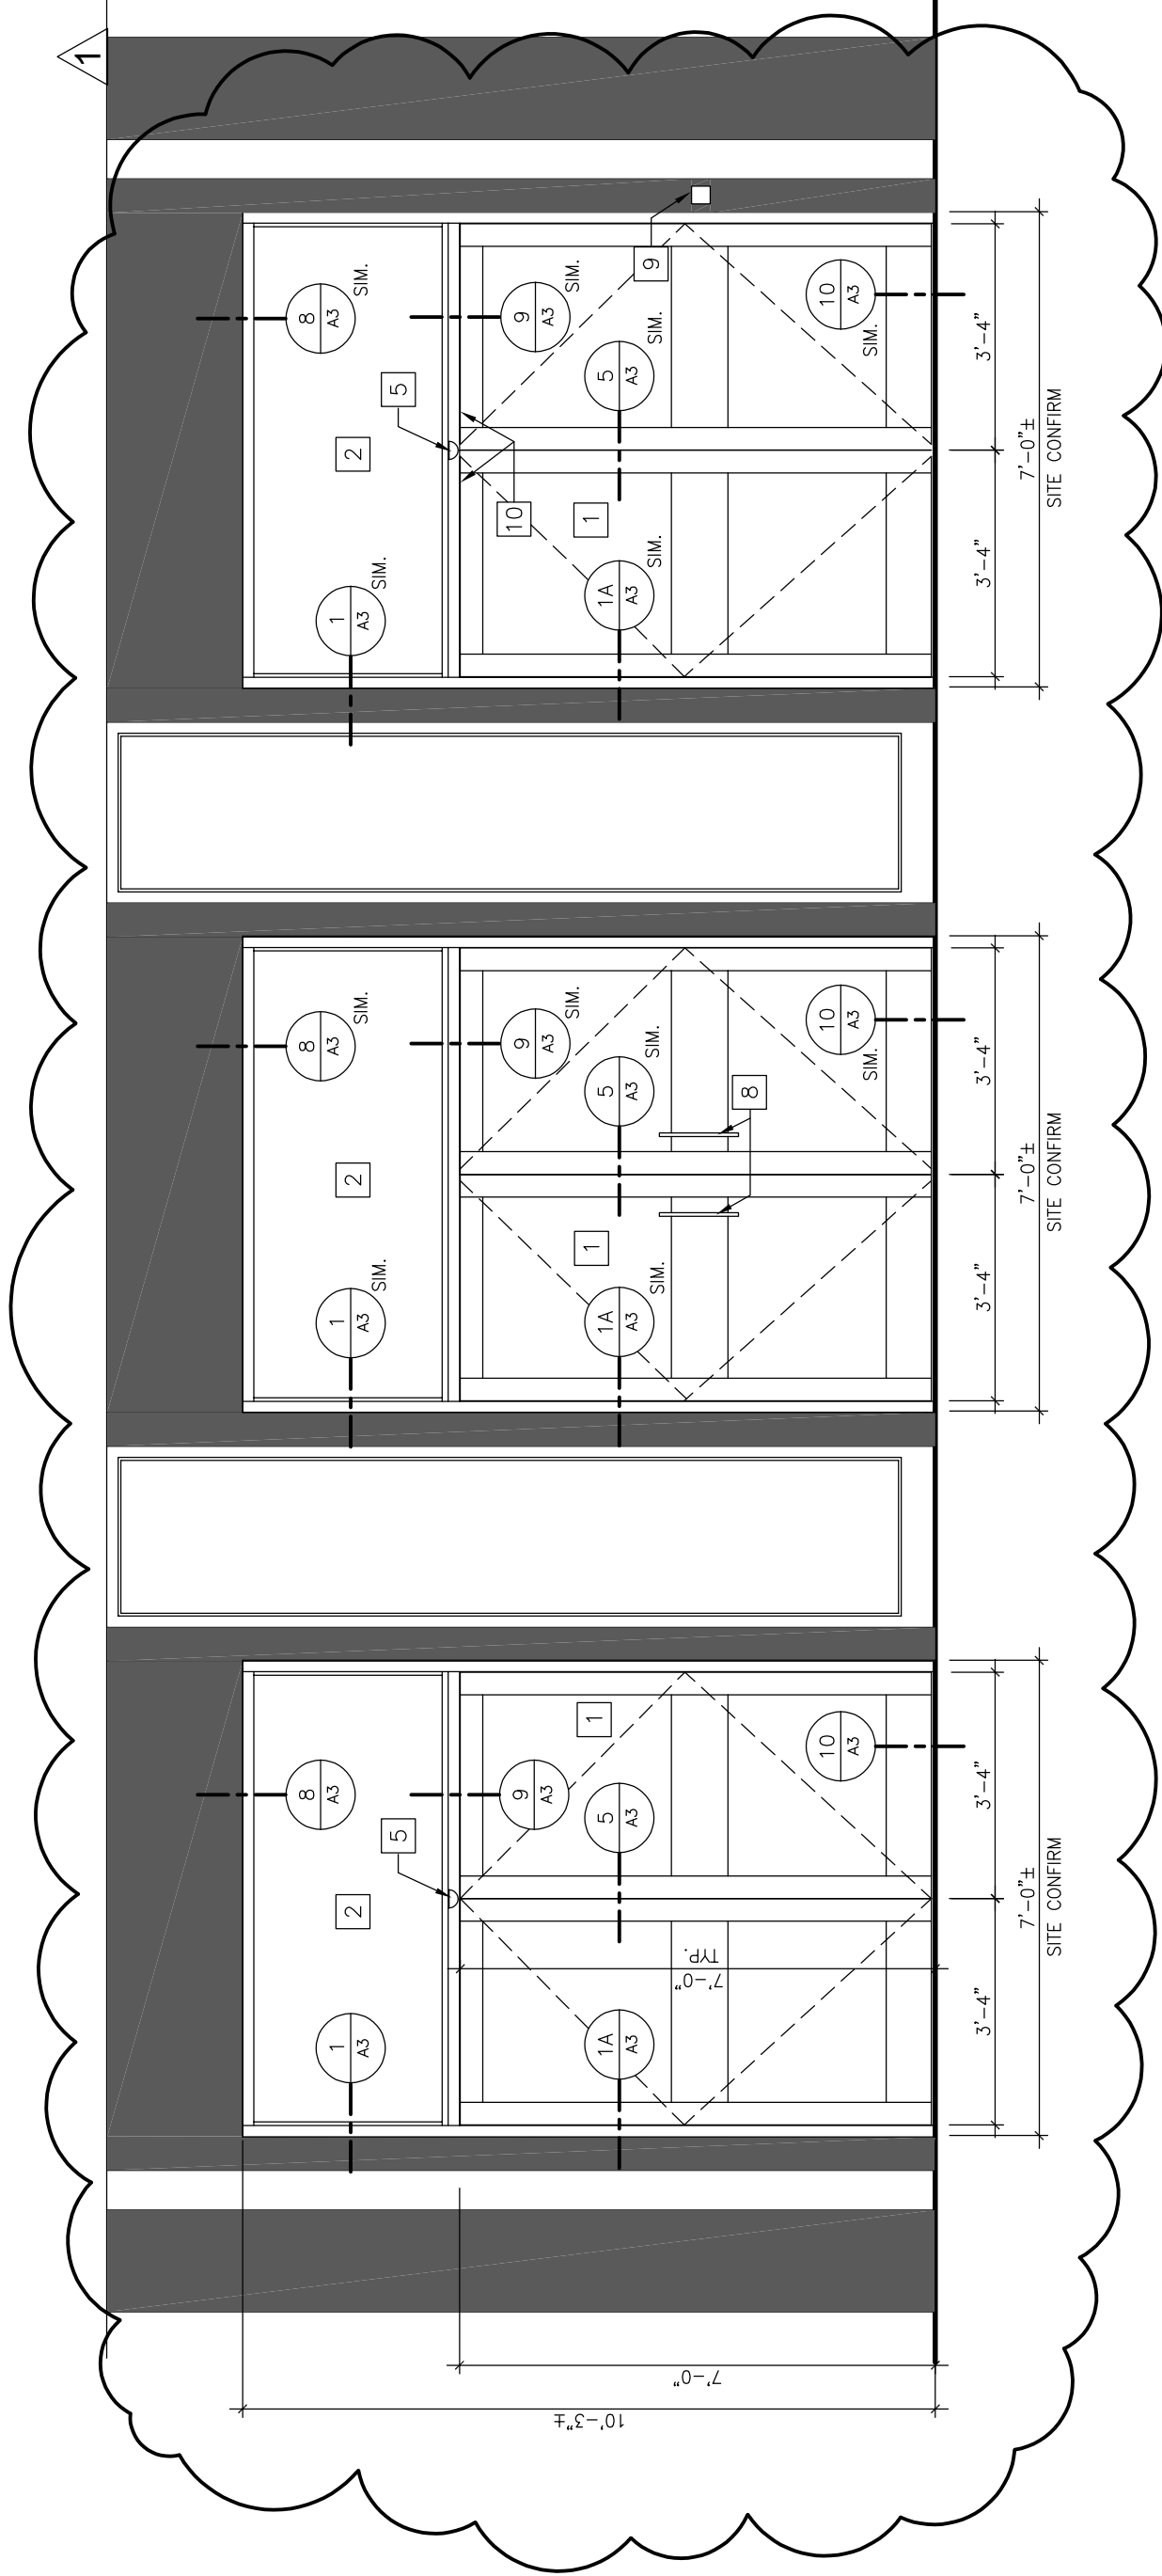

A EXTERIOR ELEVATION - ADMINISTRATION BUILDING
SCALE: 3/8" = 1'-0"

CONSTRUCTION NOTES

1. REFER TO ELECTRICAL FOR NEW ELECTRIC STRIKE SPECIFICATION AND LOCATION.
2. REFER TO ELECTRICAL FOR EMERGENCY DOOR LOCK DOWN.
3. ENSURE ALL ALUMINUM DOOR WITH REINSTALLED PULLS HAVE ADEQUATE INTERNAL FRAME REINFORCING AT PULL LOCATIONS.

A

ASBESTOS

ASBESTOS MAYBE PRESENT BEHIND WALLS, CEILING SPACES & FLOORS. IF ASBESTOS OR ANY HAZARDOUS MATERIAL IS FOUND, STOP WORK IMMEDIATELY AND CONTACT CITY OF WINNIPEG CENTRAL CONTROLS @ 204-986-2351.

No.	REVISION/DESCRIPTION	BY	DATE
1	RE-ISSUED (ADDENDUM No.1)	PS	FEB 27 2023
0	ISSUED FOR CONSTRUCTION	PS	JUL 19 2024
No.	REVISION/DESCRIPTION	BY	DATE

SEAL

ORIGINALLY SEALED 2024-10-03

2023.11.07 DATE	BP DESIGNED	PS DRAWN	BP CHECKED	APPROVED
--------------------	----------------	-------------	---------------	----------



THE CITY OF WINNIPEG
ASSETS & PROJECT MANAGEMENT
DEPARTMENT
MUNICIPAL ACCOMMODATIONS DIVISION
346 GARRY STREET, 3RD FLOOR

PROJECT

CITY HALL - COUNCIL AND ADMIN. BUILDINGS
MAIN ENTRANCES - DOOR / WINDOW REPLACEMENT

510 MAIN STREET

SHEET TITLE

ADMINISTRATION BUILDING
DEMOLITION & NEW CONSTRUCTION PLANS
EXTERIOR ELEVATIONS

SCALE	PROJECT No.	SHEET No.
AS SHOWN	2021-111	A2R1

DRAWING SHEET SIZE: D (24" x 36") PLOT: 1:1