

APPENDIX

E

ASBESTOS INVENTORY CONTROL



Planning, Property and Development Department
Municipal Accommodations Division
4th Floor - 185 King Street • Winnipeg, MB • R3B 1J1

Building Name:	Building A, Maintenance Shop	Inspection Date:	September 2024
Building Code:	TR01	Inspected By:	Winnipeg Air Testing
Building Address:	421 Osborne Street	Construction Date:	

Material Location	Material Description		Drawing Label	Material Condition	Testing Status	Date M/Y	Test %	Est. %
	Stucco Column Cladding Throughout Building Should Be Tested Before Any Work Is Performed							
	Various Areas Have Been Tested See Inventory for Details							
Basement								
Cafeteria Storage	12x12 Ceiling Tile	NON ASBESTOS		Good	Tested	May'09	0	
Cafeteria	Mastic - Pipe - Above Ceiling		MA	Good	Tested	May'10	25-50	
	Pipe Fitting Insulation - Above Ceiling		PF	Good	Tested	May'10	0.1-1	
Furnace Room	Pipe Fitting Insulation		PF	Removed				
Kitchen Hallway	Mastic - Pipe - Above Ceiling		MA	Good	Tested	May'10	25-50	
	Pipe Fitting Insulation - Above Ceiling		PF	Good	Tested	May'10	0.1-1	
Kitchen	wall plaster	NON ASBESTOS			Tested	July 16	00	
	brown/grey floor cement	NON ASBESTOS			Tested	July 16	00	
	pipe insulation	NON ASBESTOS			Tested	July 16	00	
	tile mortar	NON ASBESTOS			Tested	July 16	00	
Dispatch Area	Pipe Insulation - Above Ceiling		PI	Removed	Tested	Sept 15	1-5	
	Pipe Fitting Insulation - Above Ceiling		PF	Removed				25-50
Dispatch Supervisor Office	Pipe Insulation - Above Ceiling		PI	Removed				25-50
	Pipe Fitting Insulation - Above Ceiling		PF	Removed				25-50
Tunnel	Pipe Insulation - Above Ceiling		PI	Good				25-50
	Pipe Fitting Insulation - Above Ceiling		PF	Good				25-50
Boiler Room	Pipe Fitting Insulation		PF	Removed				
	Asbestos Fabric - Isolation Gasket			good	Tested	Nov 16		60
Stairwells	Stucco - Walls	NON ASBESTOS			Tested	May'09	0	
	HVAC isolation gaskets, each floor in ceiling space			Removed	Tested	Dec 21		
Stairwell by women's washroom	Pipe Insulation - tar paper			good	tested	Jul 20	1-10	
	pipe insulation - white canvas	NON ASBESTOS		good	tested	Jul 20	0	
Sign Up Room	Pipe Insulation			Good				
Admin Area- Main Floor								
Foyer (Inside Heater)	Mastic - Pipe		MA	not accessible				10
Foyer	Stucco - Ceiling		#N/A	Good				0
	Mastic - Pipe - Above Ceiling		MA	not accessible				10
	Pipe Fitting Insulation - Above Ceiling		PF	not accessible				5-10
Front Reception	Stucco - Ceiling	NON ASBESTOS			Tested	Apr/'11	0	
	Mastic - Pipe - Above Ceiling		MA	not accessible				10
	Pipe Fitting Insulation - Above Ceiling		PF	not accessible				5-10

Material Location	Material Description		Drawing Label	Material Condition	Testing Status	Date M/Y	Test %	Est. %
North Offices (Inside Heater Cabinets)	Pipe Fitting Insulation - North Offices		#N/A	not accessible				5-10
	Mastic - Pipe		MA	Good				10
South Corridor	Pipe Fitting Insulation		#N/A	Good				
SW Corridor, Main Floor Conference Room	Pipe Fitting Insulation - Above Ceiling		#NA	Good, partially removed				
South Offices (Inside Heaters)	Mastic - Pipe		MA	not accessible				10
South Offices	Pipe Fitting Insulation - Above Ceiling		PF	Removed 2019	Tested	Feb/ 11	5-10	
	Mastic - Pipe - Above Ceiling		MA	Good	Tested		10	
Control Office (Inside Heater)	Mastic - Pipe		MA	not accessible				10
Control Office	Mastic - Pipe - Above Ceiling		MA	not accessible				10
	Pipe Fitting Insulation - Above Ceiling		PF	not accessible				5-10
	Stucco - Walls	NON ASBESTOS			Tested	Nov/ 12	0	
East Offices (Inside Heaters)	Mastic - Pipe		MA	not accessible				10
3 NE East Offices	Pipe Fitting Insulation - Above Ceiling		PF	not accessible				5-10
	Mastic - Pipe - Above Ceiling		MA	not accessible				10
West Offices (Inside Heaters)	Mastic - Pipe		MA	not accessible				10
West Offices	Pipe Fitting Insulation		PF	Good				5-10
	Mastic - Pipe		MA	Good				10
West Corridor	Pipe Fitting Insulation - Above Ceiling		PF	Good				5-10
	Mastic - Pipe - Above Ceiling		MA	Good				10
Men's Washroom	Pipe Fitting Insulation		PF	Good				5-10
	Mastic - Pipe		MA	Good				10
	12x12 Floor Tile		F12	Removed				
Women's Washroom	Pipe Fitting Insulation - Above Ceiling		PF	damage - repair				5-10
	Mastic - Pipe - Above Ceiling		MA	Good				10
	12x12 Floor Tile		F12	Removed				
Janitor's Room	Mastic - Pipe		MA	Good				10
	12x12 Floor Tile - removed and replaced with new tile		F12	Removed 2022				
Photocopy Room	Pipe Fitting Insulation		PF	Good				5-10
	Mastic - Pipe		MA	Good				10
	12x12 Floor Tile		F12	Good				
Hallway By Bathrooms	Pipe Fitting Insulation - Above Ceiling		PF	Good				5-10
	Mastic - Pipe - Above Ceiling		MA	Good				10
	12x12 Floor Tile		#NA	good				
Admin Area- 2nd Floor								
Offices (All Heaters and Heater Cabinets)	Pipe Fitting Insulation - South Office		PF	not accessible	Tested	Sept 15	10-20	
	- Bjorn's Office		PF	damage - repair				
	Mastic - Pipe		MA	Good				10
	Drywall joint compound			good	Tested	May 17		1-5
3 NE Offices (inside cabinets) (Site:Confirm offices)	Pipe Fitting Insulation		PF	Removed 2013				5-10
	Mastic - Pipe		MA	Removed				10
Scheduler's Office (SW Corner office)	Drywall joint compound in walls			Removed				
	Drwall joint compound above ceiling NW corner			good				


Material Location	Material Description		Drawing Label	Material Condition	Testing Status	Date M/Y	Test %	Est. %
	pipe fitting insulation			Removed				
Men's Washroom	12x12 Floor Tile - removed and replaced with new tile		F12	Good				
	wall tile			Removed	tested	Aug 20	0	
	tile grout/mortar	NON ASBESTOS		good	tested	Aug 20	0	
	wall plaster	NON ASBESTOS		good	tested	Aug 20	0	
Women's Washroom	Pipe Fitting Insulation - Above Ceiling		PF	not accessible				5-10
	Mastic - Pipe - Above Ceiling		MA	Good				10
	Duct Insulation - Above Ceiling		DI	Good	Tested	Nov/ 10	10	
	12x12 Floor Tile		F12	Good				
Janitor's Room	Roof Drain		RD	Good				
	12x12 Floor Tile - removed and replaced with new tile		F12	Removed	Tested	Nov/ 10	3	
Photocopy Room	Roof Drain		RD	Good				
	12x12 Floor Tile		F12	Good				
Hallway By Bathrooms	Pipe Fitting Insulation - Above Ceiling		PF	not accessible				5-10
	Mastic - Pipe - Above Ceiling		MA	not accessible				10
	Roof Drain		RD	Good				
	12x12 Floor Tile		#NA	Good				
<u>Stores Area (102)</u>								
Stores Area (102)	Pipe Fitting Insulation		PF	Good				
	Pipe Insulation	NON ASBESTOS	PI	Good	Tested	Oct 22	0	
	Plaster - Columns			good	tested	May 17	1-5	
	Roof Drain		RD	Good				
Uniform Stores Mezzanine	12x12 Floor Tile	NON ASBESTOS			Tested	Nov/ 10	0	
Break Room / (Tire Storage)	Pipe Fitting Insulation		PF	Removed 2017				
	Pipe Insulation above ceiling		PI	Removed				
	Spray On Insulation - Steel Beam			Removed 2017	Tested	May 17	99	
	Fibrous insulation between ibeam & deck & wall - covered			not accessible				
	ceiling drywall joint compound			Removed 2017	Tested	Mar 17	2	
	Plaster - Columns			Removed 2017	Tested	Mar 17	2	
Receiving Bay	Spray On Insulation - Steel Beam		SO	Removed 2019	Tested		40-60	
	Pipe Insulation		PI	Good				
	plaster column (SE corner)	NON ASBESTOS			Tested	Mar 17	0	
	Pipe Fitting Insulation		PF	Good				
Northwest Corner	Tank Insulation		TI	Removed	Tested		POS	
	Pipe Fitting Insulation		PF	Removed	Tested		POS	
	Pipe Insulation			Partially Removed				
	MUA duct insulation			Removed 2019				
	Asbestos Fabric - Isolation Gasket		AF	Partially Removed	Tested	Sept 15	50	
Above Washroom	Pipe Fitting Insulation		PF	Removed 2011	Tested	Jan/ 12	5	
	Pipe Insulation		PI	Removed 2011				
Offices Beside Washroom	12x12 Floor Tile	NON ASBESTOS	F12	Removed'13	Tested	Nov/ 10	3	
	Sheet Flooring		SF	Removed'13				

Material Location	Material Description		Drawing Label	Material Condition	Testing Status	Date M/Y	Test %	Est. %
Electrical & Engine Repair Area (103)								
Electrical & Engine Repair Area (103)	Pipe Fitting Insulation		PF	Good				
	Pipe Insulation - Straight	NON ASBESTOS	PI	Fair	Tested	Oct/22	0	
	Pipe Insulation - Elbow		PI	Good	Tested	Oct/22	25	
Meeting Room	Drywall joint compound in walls	NON ASBESTOS		good	Tested	Apr 18	0	
	Drywall joint compound in ceiling	NON ASBESTOS		good	Tested	Apr 18	0	
Washroom	24x48 Ceiling Tile		C48	Removed	Tested	May/09	0	
	Pipe Fitting Insulation - Above Ceiling		PF	Good				
Battery Room	Pipe Fitting Insulation		PF	Good				
	Pipe Insulation		PI	Good				
	Duct insulation	NON ASBESTOS	DI	good	Tested	Oct/22	0	
Unit Rebuild Area (104)								
Unit Rebuild Area (104)	Pipe Fitting Insulation		PF	not accessible				
	Pipe Insulation		PI	not accessible				
	Duct Insulation	NON ASBESTOS		good	Tested	Oct/22	0	
Treasury Room	Insulation in ceiling above block wall	NON ASBESTOS			Tested	Sept 15	0	
North Area	Pipe Fitting Insulation		PF	Good				
	Pipe Insulation		PI	damage - repair				
	roof drain			Removed				
	Duct Insulation	NON ASBESTOS			Tested	Nov/ 10	0	
Money Meter Room	Pipe Fitting Insulation		PF	Good				
	Pipe Insulation		PI	Good				
	Duct Insulation			Good				
Engine Room	Pipe Fitting Insulation		PF	Good				
	Pipe Insulation		PI	Good				
Inspection Area (105)								
Inspection Area (105)	Wall Plaster- Top of Wall		PL	Good				1-2
	Plaster - On Ledge		ST	not accessible	Tested		1-2	
	Pipe Fitting Insulation		PF	Good				POS
	Pipe Insulation		PI	Good				NEG
	Drywall Compound - Top Of Wall		DC	Good				
	Roof Drain		RD	Removed 2022				
Oil Room Mezzanine	Plaster - On Ledge			Removed 2021	tested	Jan/17	1-5	
	Wall Plaster			good	tested	Jan/17	1-5	
Sprinkler Room	Pipe Fitting Insulation		PF	Removed'14				
	Pipe Insulation		PI	Removed'14				
Sprinkler Room Mezzanine	Pipe Fitting Insulation		PF	Partially Removed	Tested	Jul/ 10	60	
	Pipe Insulation	NON ASBESTOS			Tested	Jul/ 11	0	
	Asbestos Fabric - Isolation Gasket		AF	Good				
Body Repair Area (106)								
Body Repair Area (106)	Pipe Fitting Insulation		PF	Good				
	Pipe Insulation		PI	damage - repair				

Material Location	Material Description		Drawing Label	Material Condition	Testing Status	Date M/Y	Test %	Est. %
	wall plaster - top of wall		PL	good				
	Plaster - Columns	NON ASBESTOS	PL		Tested	May/09	0	
	Roof Drain		RD	Removed	Tested	Aug/11	85	
Foreman's Office	Sheet Flooring	NON ASBESTOS			Tested	Jan/12	0	
Body Repair Area (106A)								
Body Repair Area (106A Welding Shop)	Wall Plaster- Top of Wall		PL	Good	Tested		1-2	
	Roof Drain		RD	Good				
Exhaust Fan - EF	Duct Gasket Coupler (EF 1 - WAT Report 6771-A)			Removed 2023	Tested	Jun/23	65%	
Aisleway East of Paint Booth #4	Spray On Insulation - Steel Beam		SO	Removed 2011	Tested		1-2	
	Plaster - Columns	NON ASBESTOS			Tested	Sep/12	0	
	Plaster - Columns		PL	Good	Tested	Sep/14	<1	
Locker Area & Washroom	24x48 Ceiling Tile	NON ASBESTOS			Tested		0	
	Pipe Fitting Insulation - Above Ceiling		PF	Good				
	Pipe Insulation - Above Ceiling		PI	Good				
	pipe insulation below sinks			not accessible	tested	july 20	1-10	
	12x12 Floor Tile		F12	Removed 2011	Tested	Nov/10	2	
Carpenter Shop	Pipe Fitting Insulation		PF	Good				
	Duct Insulation	NON ASBESTOS	DI	Damaged	Tested	Oct/22	0	
	Asbestos Fabric - Isolation Gasket		AF	good	Tested	Sep/'14	60	
Paint Shop- Main Area	Pipe Fitting Insulation		PF	Good	Tested		15	
	Pipe Insulation	NON ASBESTOS			Tested	Aug/10	0	
	roof drain		RD	Good				
	Spray On Insulation - Steel Beam			Removed 2001	Tested	Sep/12	0	
Paint Booth #1	Drywall Compound - Ceiling		DC	Removed 2018				3
	Duct Insulation		DI	Removed 2018	Tested	Sept 15	15-20	75
	Duct Insulation - Above Ceiling		DI	Removed 2018				75
	Plaster - Columns		PL	Removed 2018	Tested	Sep/12	1	
	Spray On Insulation - Steel Beam - Above Ceiling		SO	Removed 2018				0
	Pipe Insulation - Water Line & Elbows			Removed 2024				
Paint Booth #2	Drywall Compound - Ceiling		DC	Removed 2024	tested	Apr 22	3	
	Duct Insulation		DI	Removed 2024	Tested	Sept 15	15-20	75
	Duct Insulation - Above Ceiling		DI	Good				75
	Plaster - Columns	NON ASBESTOS	PL	Good	tested	Aug 18	0	
	Spray On Insulation - Steel Beam - Above Ceiling		SO	Removed 2001				0
	Pipe Insulation - Water Line & Elbows			Removed 2024				
Paint Booth #3	Drywall Compound - Ceiling		DC	damage				3
	Duct Insulation		DI	Removed 2021	Tested	Sept 15	15-20	75
	Duct Insulation - Above Ceiling		DI	Good				75
	Plaster - Columns	NON ASBESTOS	PL		tested	Aug 18	0	
	Spray On Insulation - Steel Beam - Above Ceiling		SO	Removed 2001				0
	Pipe Insulation			Good				
Paint Booth #4	Drywall Compound - Ceiling		DC	Removed 2012	Tested	Oct/11	3	

Material Location	Material Description		Drawing Label	Material Condition	Testing Status	Date M/Y	Test %	Est. %
	Spray On Insulation - Steel Beam - Above Ceiling		SO	Removed 2012				
	Duct Insulation		DI	Removed 2012	Tested	Jul/12	75	
	Duct Insulation - Above Ceiling		DI	Removed 2012				75
	Plaster - Columns		PL	Removed 2012	Tested	Sep/12	2	
Paint Booth Fan Room	Duct Insulation	NON ASBESTOS		good	Tested	May/09	0	
	duct insulation debris	NON ASBESTOS			tested	Aug 18	0	
	NE Duct insulation MUAG 9			good	tested	Apr 22	80	
	NE duct expansion gasket MUAG 9			good	tested	Apr 22	60	
	NW, SE, SW duct insulation	NON ASBESTOS		good	tested	Apr 22	0	
	Spray On Insulation - Steel Beam - Above Ceiling		SO	Good				85
Brake Shop Area (107)								
Brake Shop Area (107)	Wall Plaster- Top of Wall		PL	Good				1-2
	Roof Drain		RD	Minor Damage				
	Stucco - On Ledge		ST	not accessible				1-2
	Pipe Fitting Insulation		PF	Good				
	MUAG 03 wallboard	NON ASBESTOS			tested	Feb 17	0	
	MUAG 03 main unit insulation	NON ASBESTOS			tested	Feb 17	0	
General Repair Area (108)								
General Repair Area (108)	Wall Plaster- Top of Wall		PL	Good	Tested	Mar/11	1-2	
	Stucco - On Ledge		ST	not accessible				1-2
	Pipe Fitting Insulation		PF	Good	Tested		POS	
	Pipe Insulation	NON ASBESTOS			Tested	Oct/22	0	
	Roof Drain		RD	Good				
Oil Room	drywall	NON ASBESTOS		good	tested	Dec/18	0	
Sprinkler Room	Pipe Fitting Insulation		PF	Removed'14				
	Pipe Insulation		PI	Removed'14				
Sprinkler Room Mezzanine	Pipe Fitting Insulation		PF	Good	Tested		60	
	Pipe Insulation	NON ASBESTOS			Tested		0	
	Asbestos Fabric - Isolation Gasket		AF	Good				
Washroom	Plaster - Walls	NON ASBESTOS			Tested	May/14	0	
Instruction Area (9)								
Hallway	12x12 Floor Tile		F12	Removed 2018	Tested	2018	0	
	Mastic - Floor Tile		MA	Removed 2018	Tested	2018	0	
	wall plaster	NON ASBESTOS		good	Tested	Aug 18	0	
Instruction area North East Offices	drywall joint compound	NON ASBESTOS		good	tested	Jan 18	0	
	ceiling tile	NON ASBESTOS		good	tested	Jan 18	0	
	floor tile	NON ASBESTOS		good	tested	Jan 18	0	
Instruction area South East Offices	drywall joint compound	NON ASBESTOS		good	tested	Jan 18	0	
	plaster	NON ASBESTOS		good	tested	Jan 18	0	
	ceiling tile	NON ASBESTOS		good	tested	Jan 18	0	
Instruction area North West Staff Room R102 - S	drywall joint compound	NON ASBESTOS		good	tested	Dec 18	0	
	ceiling tiles	NON ASBESTOS		good	tested	Dec 18	0	

Material Location	Material Description		Drawing Label	Material Condition	Testing Status	Date M/Y	Test %	Est. %
	floor tile - grey			Removed	tested	Dec 18	3	
Instruction area North West Locker Room R102 - N	drywall joint compound	NON ASBESTOS		good	tested	Dec18	0	
	ceiling tiles	NON ASBESTOS		good	tested	Dec 18	0	
	floor tile - grey	NON ASBESTOS		good	tested	Dec 18	0	
Pipe Chase by Women's washroom	Floor Tile			Removed	Tested	June 17	1-5	
Traffic Services Area (112)								
Traffic Services Area (112)	Drywall Compound - Top of North Wall		DC	Good				1-2
	Pipe Insulation		PI	Removed				0
	Pipe Fitting Insulation		PF	Removed				15
	Roof Drain		RD	Removed	Tested	Aug/11	60	
Sign Shop/Silk Screen Room	Drywall Compound - Top of North Wall		DC	Good				1-2
	Drywall Compound - Ceiling		DC	Removed 2018	Tested	Mar/11	2-3	
	Pipe Insulation			Removed	Tested		0	
	Pipe Fitting Insulation		PF	Removed 2018	Tested		15	
	Roof Drain		RD	Removed				
	Asbestos Fabric - Lined Safe		AF	Removed				
	Spray On Insulation - Behind Steel Beam		SO	Removed 2018	Tested		5-30	
Offices	12x12 Floor Tile - Under Carpet		F12	Removed 2014				1-2
Parking Meter Repair Room	12x12 green Floor Tile		F12	Removed 2018	Tested	Sept 15	4	1-2
	Sheet Flooring on Workbench		FS	Removed 2011	Tested	Nov/ 10	0	
	Asbestos Fabric - Lined Safe		AF	Removed				
	Sheet Flooring on Workdesk		FS	Removed 2011	Tested	Feb/11	4-15	
	mastic on walls	NON ASBESTOS			tested	2018	0	
	Asbestos Fabric - Fireproof Cabinet		AF	Removed				
	wall plaster	NON ASBESTOS		Removed	tested	2018	0	
Communications Area (113)								
Garage Area	Pipe Fitting Insulation		PF	Good				
	Pipe Insulation		PI	Good				
Mezzanine	Roof Drain		RD	Removed 2019				
	I beam matt insulation	NON ASBESTOS			tested	Nov/19	0	
Office Hallway	12x12 Floor Tile		F12	Removed 2014	Tested	Nov/10	2	
Storage Area	Pipe Insulation		PI	Good				
	Pipe Fitting Insulation		PF	good				
	Pipe Insulation above door - Back Flow Valve			Removed 2019				
	Pipe Fitting Insulation above door - Back Flow Valve			Removed 2019				
	drywall joint compound at top of wall			good				
New Paint Booth #1	electrical fabric	NON ASBESTOS			Tested	Jan 21	0	

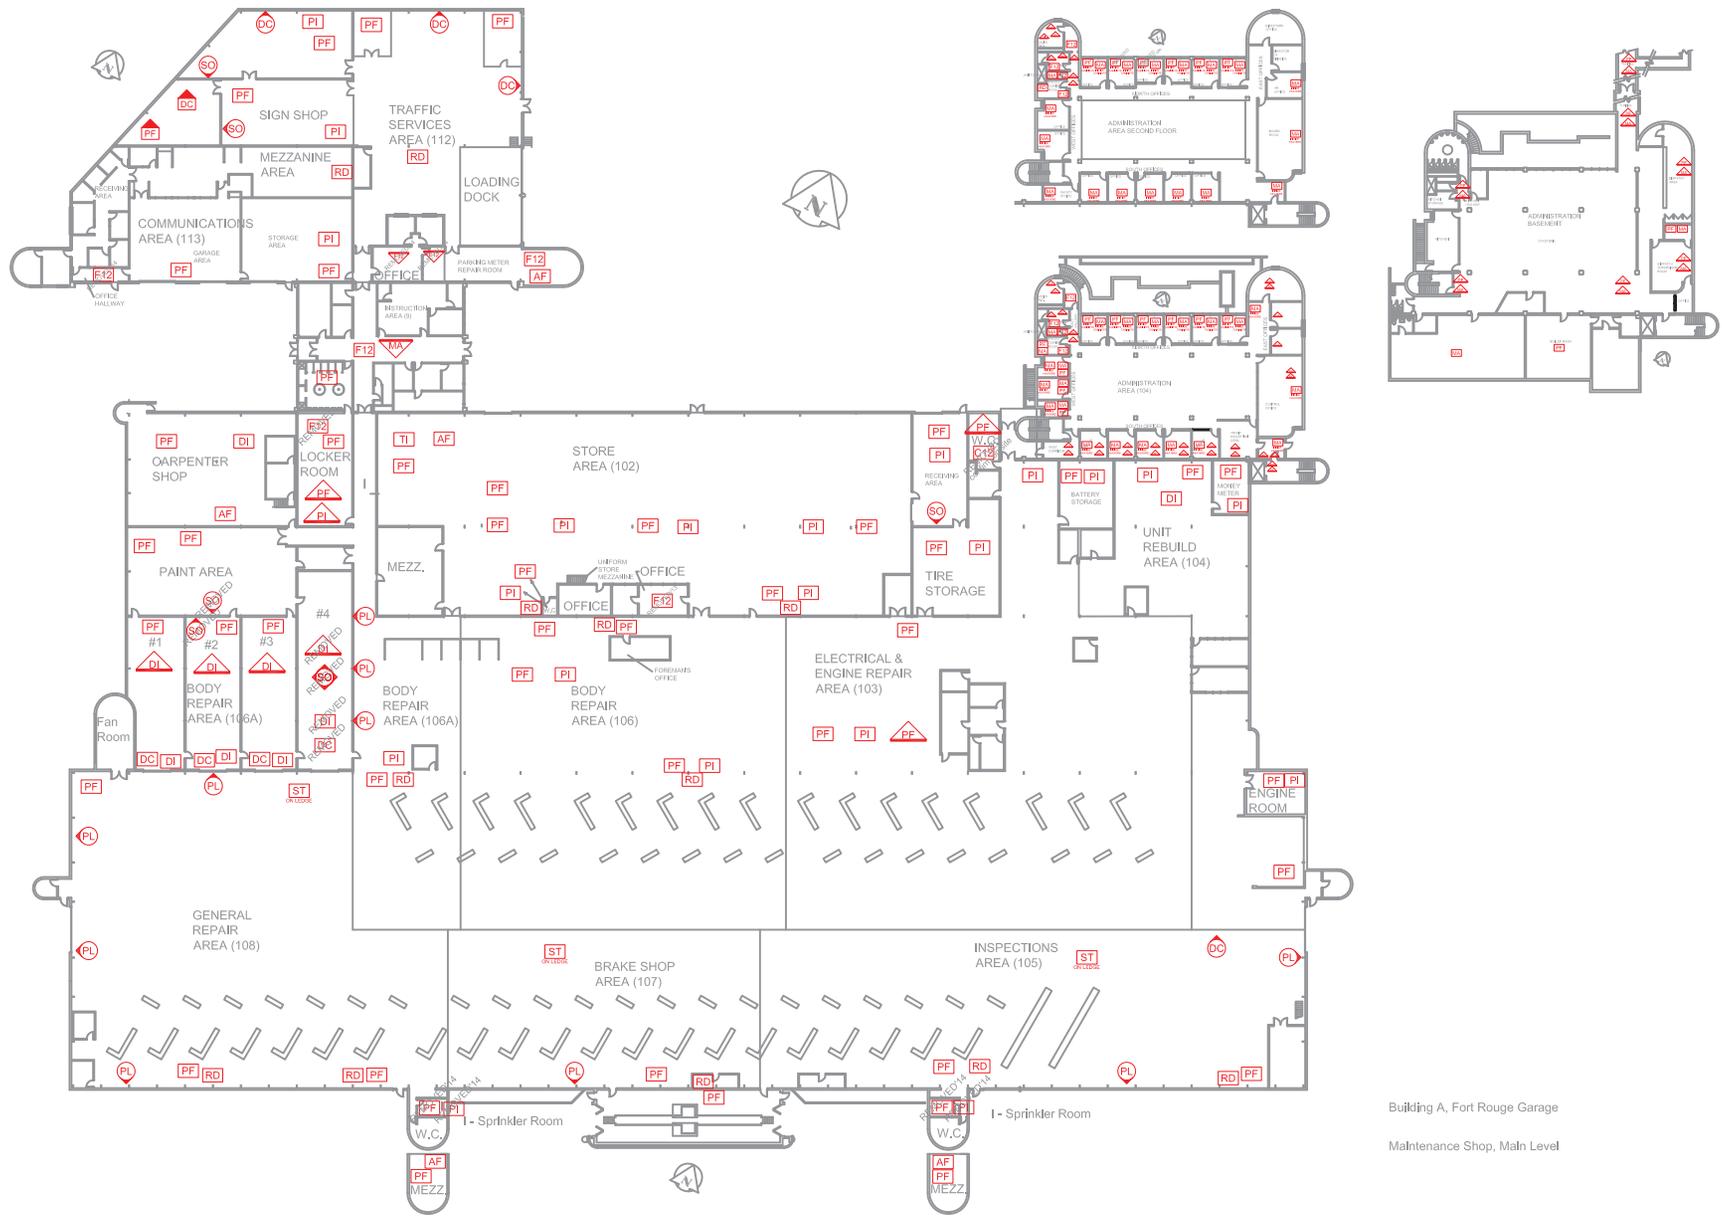

Building A, Fort Rouge Garage
Maintenance Shop, Malt Level

LEGEND

GENERAL LABELS	ABOVE CEILING	UNDER FLOORING	WALL DETAIL
??	??	??	??
AF: ASBESTOS FABRIC	F9: 9X9 FLOOR TILE	SO: SPRAY ON	
BR: BOILER REFRACTORY	F12: 12X12 FLOOR TILE	ST: STUCCO	
CA: CAULKING	HB: HARDBOARD	TI: TANK INSULATION	
C12: 12X12 CEILING TILE	MA: MASTIC	TP: TRANSITE PIPE	
C24: 24X24 CEILING TILE	PF: PIPE FITTING INSULATION	VE: VERMICULITE	
C48: 24X48 CEILING TILE	PI: PIPE INSULATION		
DC: DRYWALL COMPOUND	PL: PLASTER		
DI: DUCT INSULATION	RD: ROOF DRAIN		
FS: SHEET FLOORING	SC: STIPPLE CEILING		


NOTES:

1. THERE MAY BE ASBESTOS CONTAINING MATERIALS PRESENT THAT WERE NOT LOCATED DURING BUILDING INSPECTIONS
2. REFER TO THE ASBESTOS INVENTORY SURVEY SHEET FOR MORE INFORMATION
3. DO NOT DISTURB ASBESTOS. FOR HANDLING PROCEDURES CALL CENTRAL CONTROL AT 986-2382

ASBESTOS LOCATIONS

BUILDING:	TRANSIT BUILDING A 421 OSBORNE STREET WINNIPEG, MANITOBA		
REVISED BY:	DATE:	SCALE:	SHEET #:
REM	July 9, 2014	N.T.S.	1/6

CITY OF WINNIPEG
PLANNING, PROPERTY & DEVELOPMENT DEPARTMENT
MUNICIPAL ACCOMMODATIONS DIVISION
4th FLOOR - 185 KING STREET
WINNIPEG, MANITOBA R3B 1J1
PHONE: (204) 986-7266
FAX: (204) 986-7311

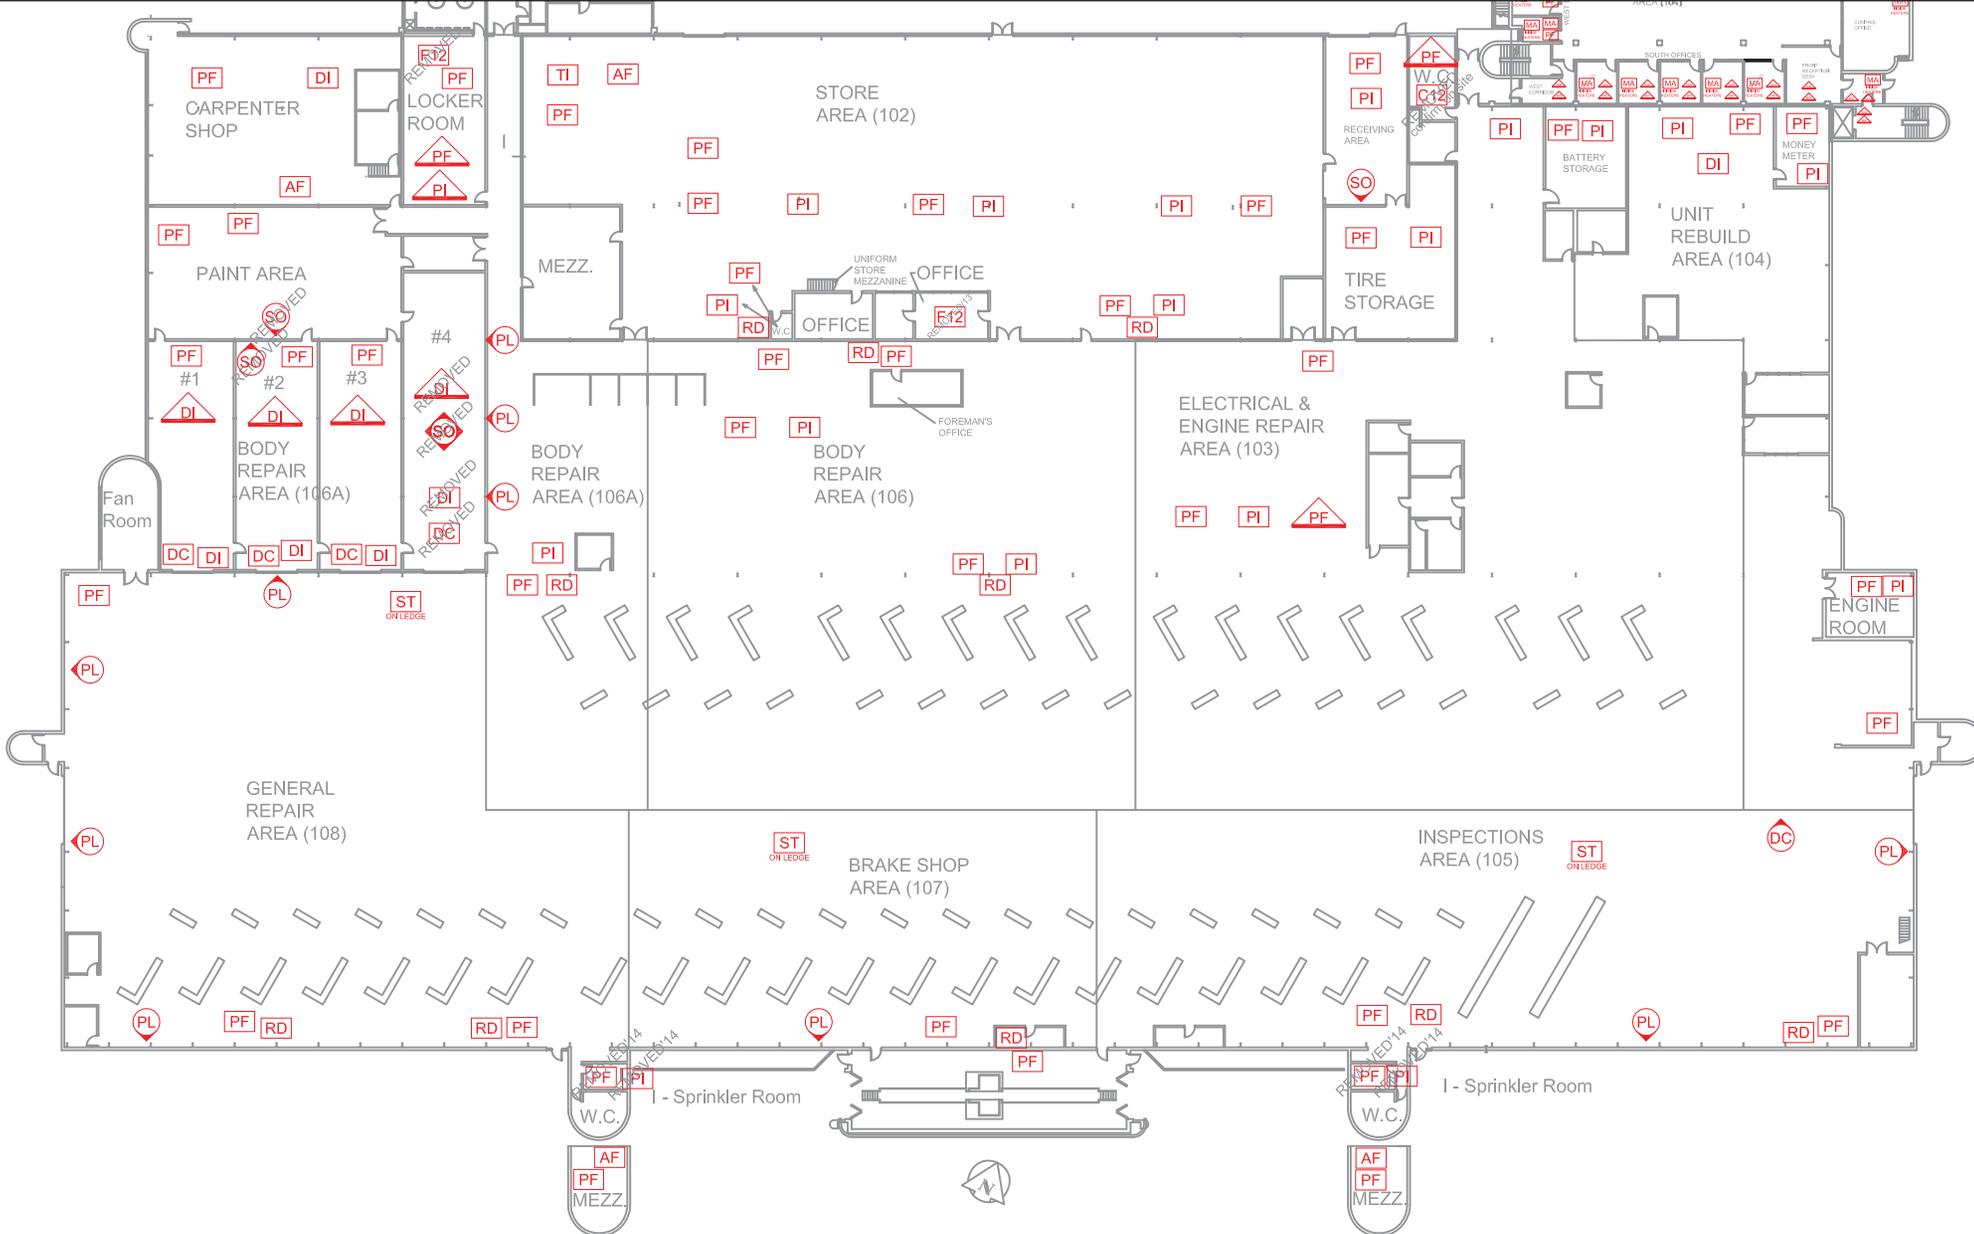


LEGEND		GENERAL LABELS	ABOVE CEILING	UNDER FLOORING	WALL DETAIL
?? =		??	??	??	??
AF: ASBESTOS FABRIC	F9: 9X9 FLOOR TILE	SO: SPRAY ON			
BR: BOILER REFRACTORY	F12: 12X12 FLOOR TILE	ST: STUCCO			
CA: CAULKING	HB: HARDBOARD	TI: TANK INSULATION			
C12: 12X12 CEILING TILE	MA: MASTIC	TP: TRANSITE PIPE			
C24: 24X24 CEILING TILE	PF: PIPE FITTING INSULATION	VE: VERMICULITE			
C48: 24X48 CEILING TILE	PI: PIPE INSULATION				
DC: DRYWALL COMPOUND	PL: PLASTER				
DI: DUCT INSULATION	RD: ROOF DRAIN				
FS: SHEET FLOORING	SC: STIPPLE CEILING				

NOTES:
 1. THERE MAY BE ASBESTOS CONTAINING MATERIALS PRESENT THAT WERE NOT LOCATED DURING BUILDING INSPECTIONS
 2. REFER TO THE ASBESTOS INVENTORY SURVEY SHEET FOR MORE INFORMATION
 3. DO NOT DISTURB ASBESTOS. FOR HANDLING PROCEDURES CALL CENTRAL CONTROL AT 986-2382

ASBESTOS LOCATIONS			
BUILDING:		TRANSIT BUILDING A 421 OSBORNE STREET WINNIPEG, MANITOBA	
REVISED BY:	DATE:	SCALE:	SHEET #:
REM	July 9, 2014	N.T.S.	2/6

CITY OF WINNIPEG
 PLANNING, PROPERTY & DEVELOPMENT DEPARTMENT
 MUNICIPAL ACCOMMODATIONS DIVISION
 4th FLOOR - 185 KING STREET
 WINNIPEG, MANITOBA R3B 1J1
 PHONE: (204) 986-7266
 FAX: (204) 986-7311

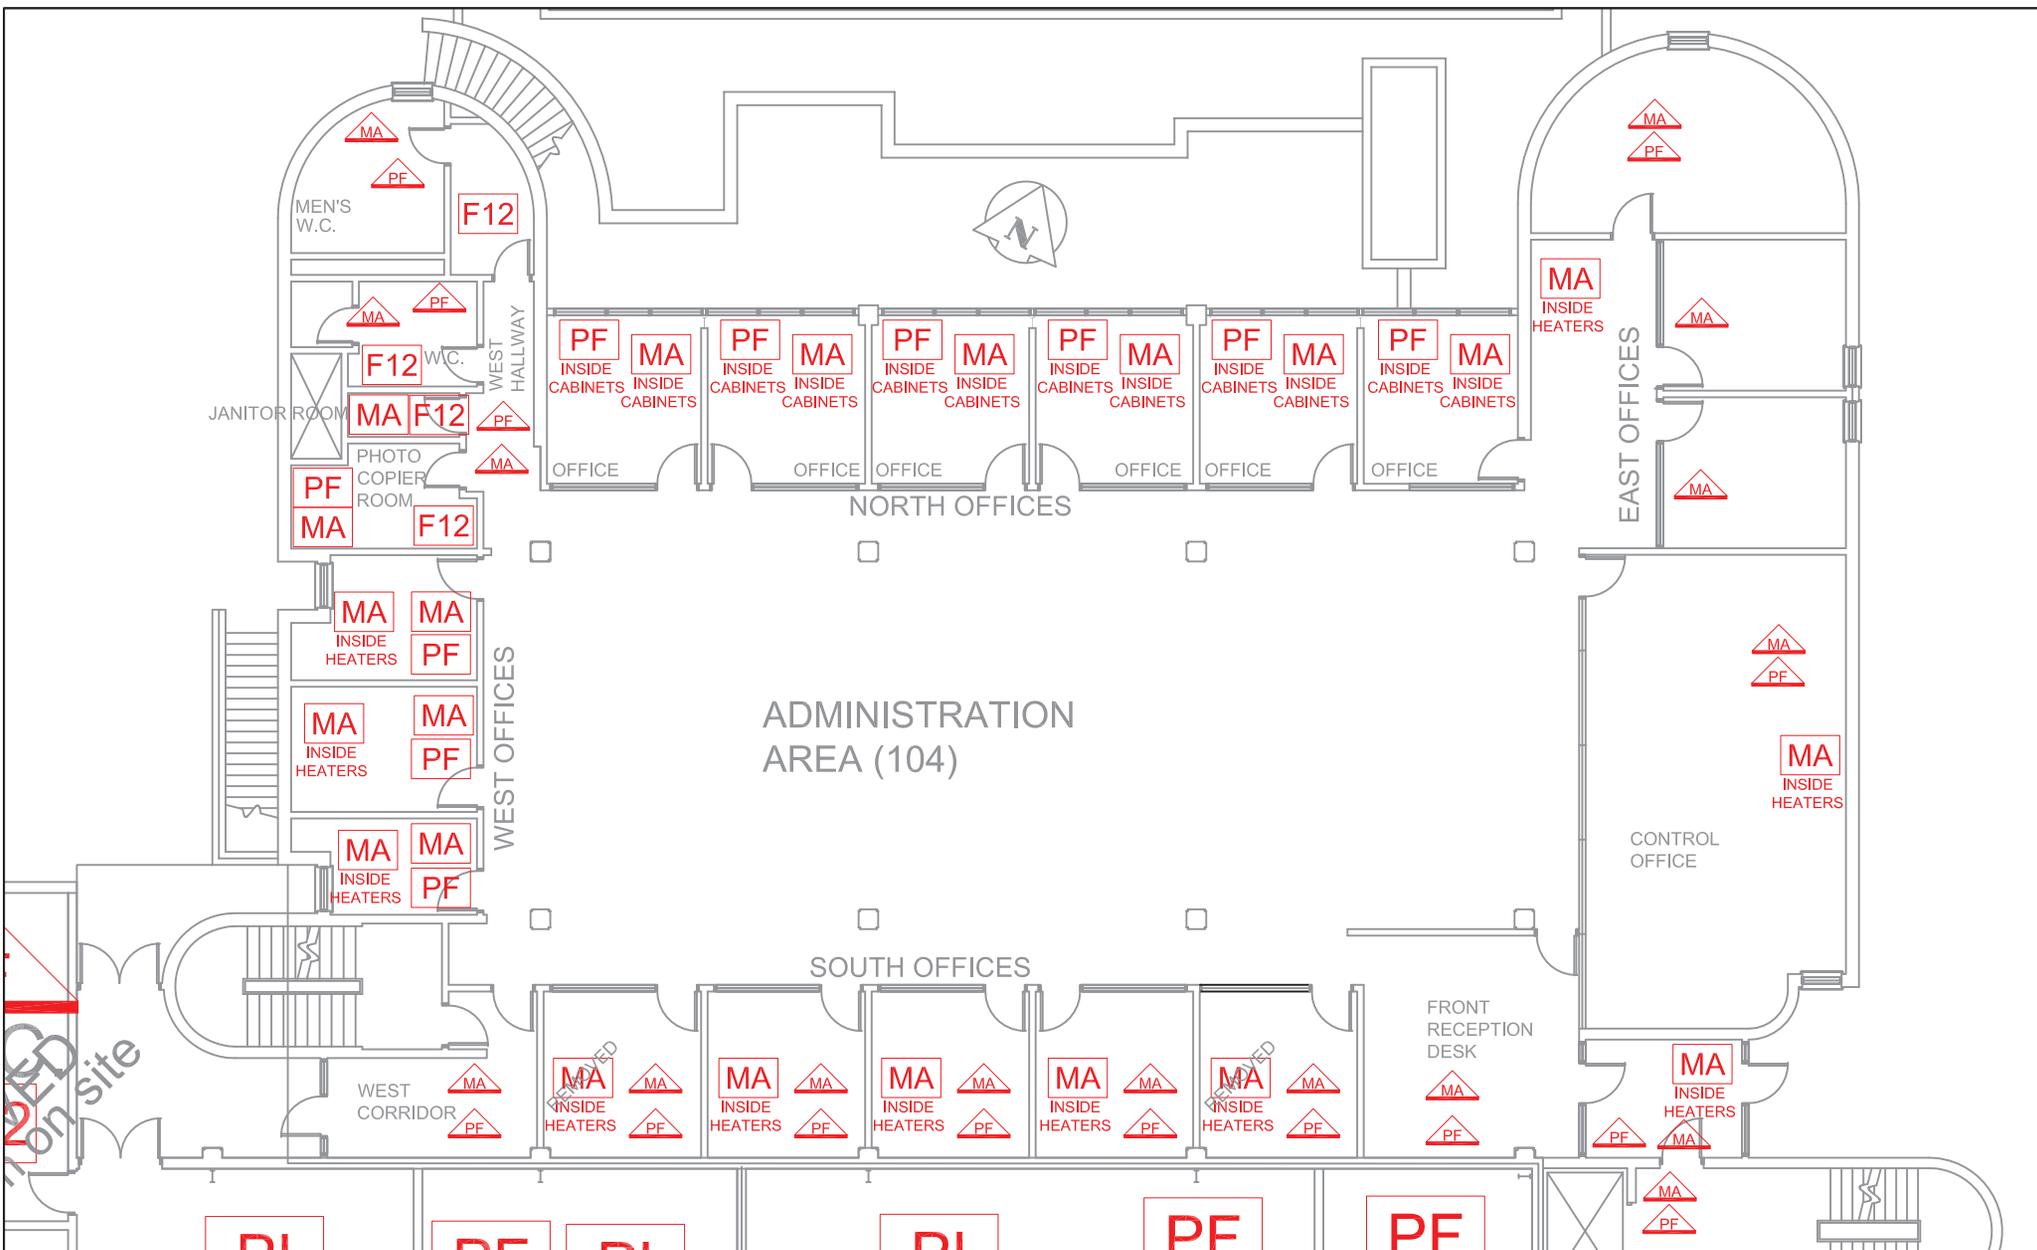


LEGEND		GENERAL LABELS	ABOVE CEILING	UNDER FLOORING	WALL DETAIL
?? =		??	??	??	??
AF: ASBESTOS FABRIC	F9: 9X9 FLOOR TILE	SO: SPRAY ON			
BR: BOILER REFRACTORY	F12: 12X12 FLOOR TILE	ST: STUCCO			
CA: CAULKING	HB: HARDBOARD	TI: TANK INSULATION			
C12: 12X12 CEILING TILE	MA: MASTIC	TP: TRANSITE PIPE			
C24: 24X24 CEILING TILE	PF: PIPE FITTING INSULATION	VE: VERMICULITE			
C48: 24X48 CEILING TILE	PI: PIPE INSULATION				
DC: DRYWALL COMPOUND	PL: PLASTER				
DI: DUCT INSULATION	RD: ROOF DRAIN				
FS: SHEET FLOORING	SC: STIPPLE CEILING				

NOTES:
 1. THERE MAY BE ASBESTOS CONTAINING MATERIALS PRESENT THAT WERE NOT LOCATED DURING BUILDING INSPECTIONS
 2. REFER TO THE ASBESTOS INVENTORY SURVEY SHEET FOR MORE INFORMATION
 3. DO NOT DISTURB ASBESTOS. FOR HANDLING PROCEDURES CALL CENTRAL CONTROL AT 986-2382

ASBESTOS LOCATIONS			
BUILDING:		TRANSIT BUILDING A 421 OSBORNE STREET WINNIPEG, MANITOBA	
REVISED BY:	DATE:	SCALE:	SHEET #:
REM	July 9, 2014	N.T.S.	3/6

CITY OF WINNIPEG
 PLANNING, PROPERTY & DEVELOPMENT DEPARTMENT
 MUNICIPAL ACCOMMODATIONS DIVISION
 4th FLOOR - 185 KING STREET
 WINNIPEG, MANITOBA R3B 1J1
 PHONE: (204) 986-7266
 FAX: (204) 986-7311

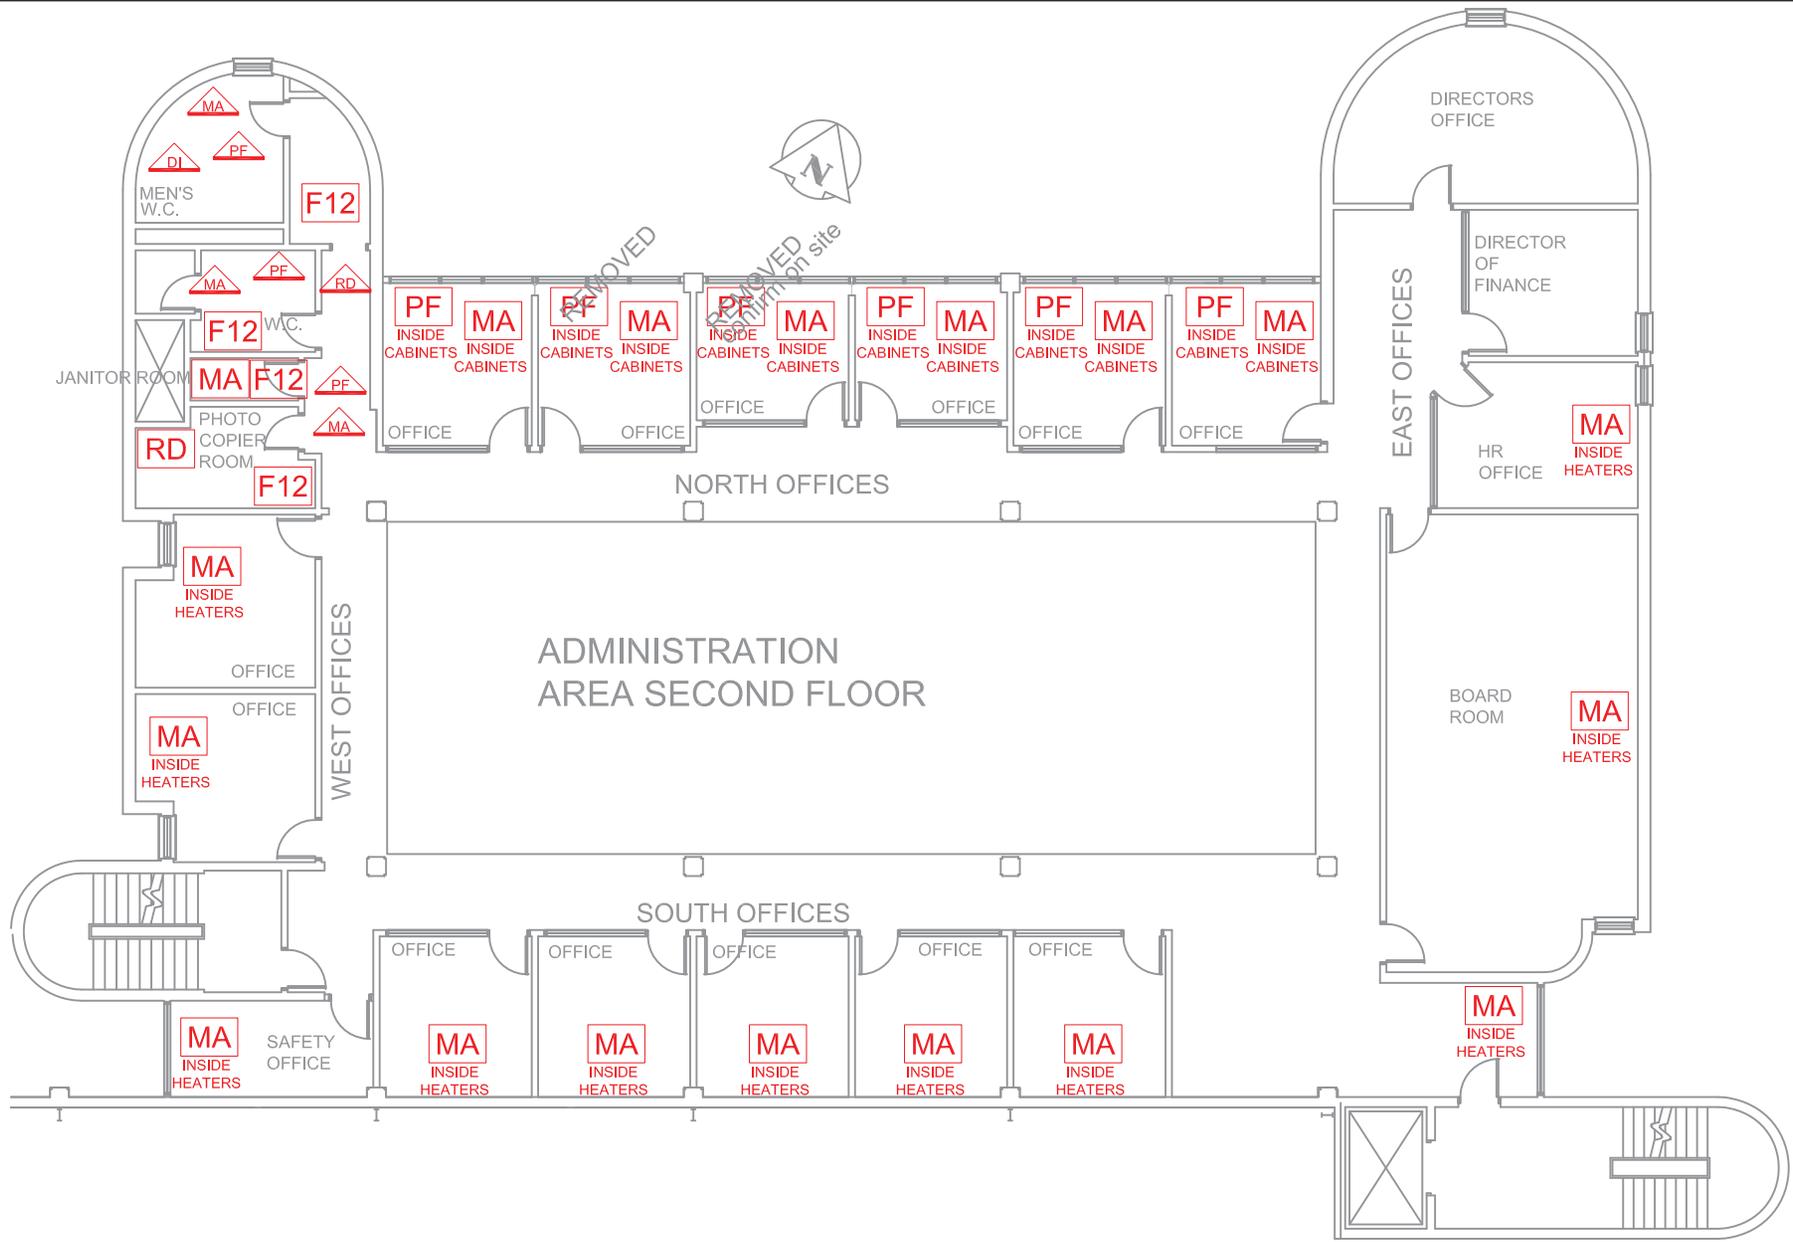


LEGEND	GENERAL LABELS	ABOVE CEILING	UNDER FLOORING	WALL DETAIL
?? =	??	??	??	??
AF: ASBESTOS FABRIC	F9: 9X9 FLOOR TILE	SO: SPRAY ON		
BR: BOILER REFRACTORY	F12: 12X12 FLOOR TILE	ST: STUCCO		
CA: CAULKING	HB: HARDBOARD	TI: TANK INSULATION		
C12: 12X12 CEILING TILE	MA: MASTIC	TP: TRANSITE PIPE		
C24: 24X24 CEILING TILE	PF: PIPE FITTING INSULATION	VE: VERMICULITE		
C48: 24X48 CEILING TILE	PI: PIPE INSULATION			
DC: DRYWALL COMPOUND	PL: PLASTER			
DI: DUCT INSULATION	RD: ROOF DRAIN			
FS: SHEET FLOORING	SC: STIPPLE CEILING			

NOTES:
 1. THERE MAY BE ASBESTOS CONTAINING MATERIALS PRESENT THAT WERE NOT LOCATED DURING BUILDING INSPECTIONS
 2. REFER TO THE ASBESTOS INVENTORY SURVEY SHEET FOR MORE INFORMATION
 3. DO NOT DISTURB ASBESTOS. FOR HANDLING PROCEDURES CALL CENTRAL CONTROL AT 986-2382

ASBESTOS LOCATIONS			
BUILDING:	TRANSIT BUILDING A 421 OSBORNE STREET WINNIPEG, MANITOBA		
REVISED BY:	DATE:	SCALE:	SHEET #:
REM	July 9, 2014	N.T.S.	4/6

CITY OF WINNIPEG
 PLANNING, PROPERTY & DEVELOPMENT DEPARTMENT
 MUNICIPAL ACCOMMODATIONS DIVISION
 4th FLOOR - 185 KING STREET
 WINNIPEG, MANITOBA R3B 1J1
 PHONE: (204) 986-7266
 FAX: (204) 986-7311

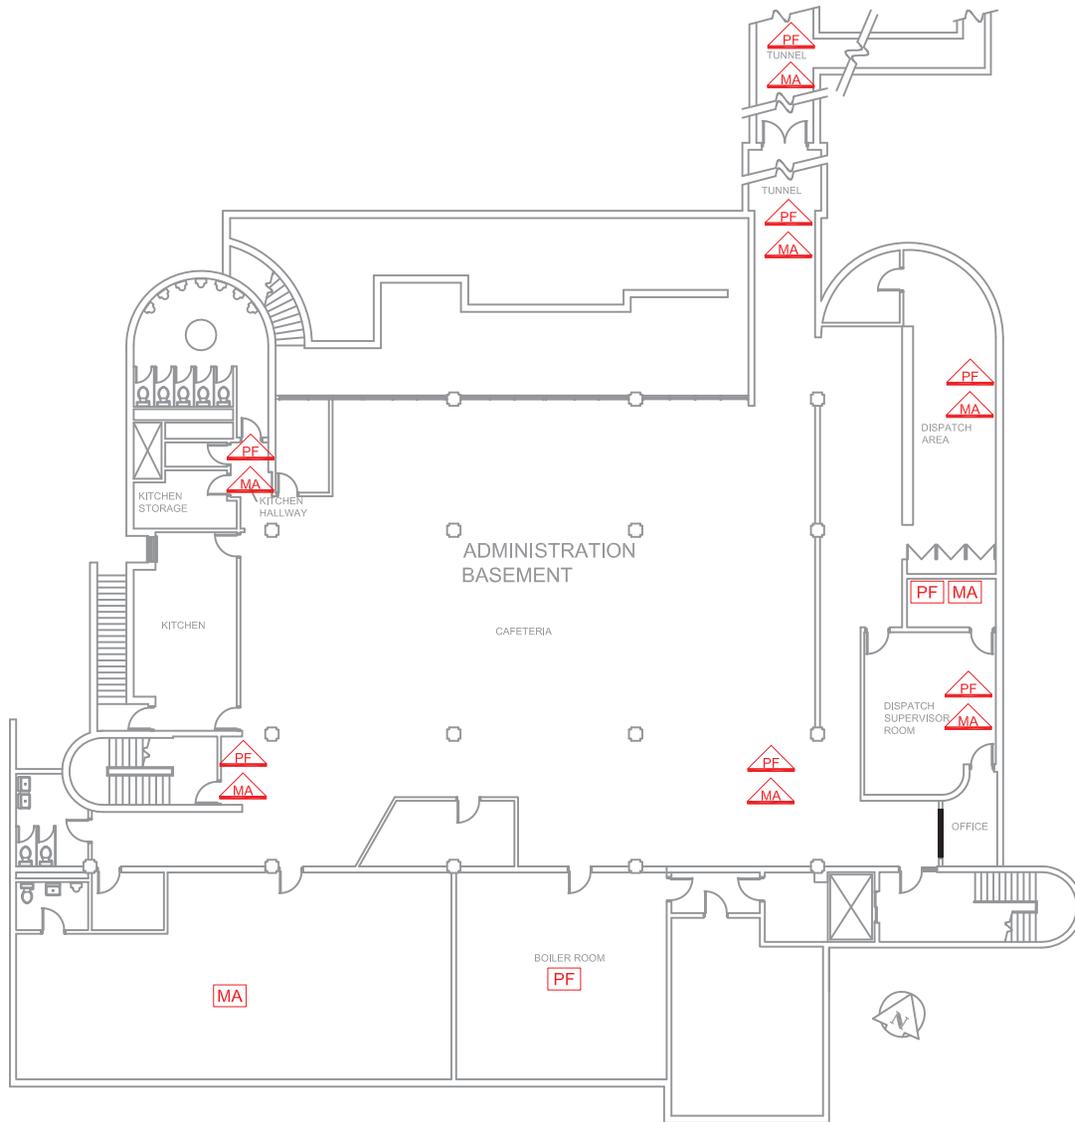

LEGEND

GENERAL LABELS



ABOVE CEILING



UNDER FLOORING



WALL DETAIL



?? =

AF: ASBESTOS FABRIC
BR: BOILER REFRACTORY
CA: CAULKING
C12: 12X12 CEILING TILE
C24: 24X24 CEILING TILE
C48: 24X48 CEILING TILE
DC: DRYWALL COMPOUND
DI: DUCT INSULATION
FS: SHEET FLOORING

F9: 9X9 FLOOR TILE
F12: 12X12 FLOOR TILE
HB: HARDBOARD
MA: MASTIC
PF: PIPE FITTING INSULATION
PI: PIPE INSULATION
PL: PLASTER
RD: ROOF DRAIN
SC: STIPPLE CEILING

SO: SPRAY ON
ST: STUCCO
TI: TANK INSULATION
TP: TRANSITE PIPE
VE: VERMICULITE

NOTES:

1. THERE MAY BE ASBESTOS CONTAINING MATERIALS PRESENT THAT WERE NOT LOCATED DURING BUILDING INSPECTIONS
2. REFER TO THE ASBESTOS INVENTORY SURVEY SHEET FOR MORE INFORMATION
3. DO NOT DISTURB ASBESTOS. FOR HANDLING PROCEDURES CALL CENTRAL CONTROL AT 986-2382

ASBESTOS LOCATIONS

BUILDING:

TRANSIT
BUILDING A - BASEMENT
421 OSBORNE STREET
WINNIPEG, MANITOBA

REVISED BY:
REM

DATE:
July 9, 2014

SCALE:
N.T.S.

SHEET #:
5/6



Embrass the Spirit • Vivez l'esprit

CITY OF WINNIPEG

PLANNING, PROPERTY & DEVELOPMENT
DEPARTMENT
MUNICIPAL ACCOMMODATIONS DIVISION
4th FLOOR - 185 KING STREET
WINNIPEG, MANITOBA R3B 1J1
PHONE: (204) 986-7266
FAX: (204) 986-7311



LEGEND

GENERAL LABELS	ABOVE CEILING	UNDER FLOORING	WALL DETAIL
??	??	??	??

AF: ASBESTOS FABRIC	F9: 9X9 FLOOR TILE	SO: SPRAY ON
BR: BOILER REFRACTORY	F12: 12X12 FLOOR TILE	ST: STUCCO
CA: CAULKING	HB: HARDBOARD	TI: TANK INSULATION
C12: 12X12 CEILING TILE	MA: MASTIC	TP: TRANSITE PIPE
C24: 24X24 CEILING TILE	PF: PIPE FITTING INSULATION	VE: VERMICULITE
C48: 24X48 CEILING TILE	PI: PIPE INSULATION	
DC: DRYWALL COMPOUND	PL: PLASTER	
DI: DUCT INSULATION	RD: ROOF DRAIN	
FS: SHEET FLOORING	SC: STIPPLE CEILING	

NOTES:

1. THERE MAY BE ASBESTOS CONTAINING MATERIALS PRESENT THAT WERE NOT LOCATED DURING BUILDING INSPECTIONS
2. REFER TO THE ASBESTOS INVENTORY SURVEY SHEET FOR MORE INFORMATION
3. DO NOT DISTURB ASBESTOS. FOR HANDLING PROCEDURES CALL CENTRAL CONTROL AT 986-2382

ASBESTOS LOCATIONS

BUILDING: TRANSIT BUILDING A 421 OSBORNE STREET WINNIPEG, MANITOBA	
REVISED BY: REM	DATE: July 9, 2014
SCALE: N.T.S.	SHEET #: 6/6



CITY OF WINNIPEG
 PLANNING, PROPERTY & DEVELOPMENT
 DEPARTMENT
 MUNICIPAL ACCOMMODATIONS DIVISION
 4th FLOOR - 185 KING STREET
 WINNIPEG, MANITOBA R3B 1J1
 PHONE: (204) 986-7266
 FAX: (204) 986-7311

Embrace the Spirit • Vivez l'esprit