

GENERAL NOTES:

- FOR THE KIRK KEY INTERLOCK, SWITCHGEAR SGR-F70 SHALL ONLY RELEASE THE KIRK KEY WHEN THE DISCONNECT SWITCH IS IN THE OPEN POSITION. KIRK KEY IS REQUIRED TO ACCESS TRANSFORMER XFMR-F1 PRIMARY (5KV) COMPARTMENT. SGR-F70 DISCONNECT SWITCH SHALL ONLY BE CAPABLE OF CLOSING WHEN KIRK KEY IS INSERTED INTO KEY LOCK. XFMR-F1 PRIMARY (5KV) COMPARTMENT SHALL ONLY RELEASE THE KIRK KEY ONCE PRIMARY DOOR IS FULLY CLOSED.

MANITOBA HYDRO SCOPE OF WORK:


- SUPPLY SURGE ARRESTORS AND CUTOFF FUSES ON 5KV HYDRO POLE.
- SUPPLY NEW UTILITY CABLE (C-UTIL) FROM 5KV HYDRO POLE TO SGR-F70, FUSED DISCONNECT COMPARTMENT.
- SUPPLY NEW METER ALONG WITH METERING TRANSFORMER IN SGR-F70, METERING COMPARTMENT.

CONSTRUCTION NOTES:

- PROVIDE NEW 5KV SERVICE ENTRANCE RATED FUSIBLE DISCONNECT SWITCH. DISCONNECT SWITCH IS LOAD-BREAK RATED.
- PROVIDE NEW 5KV METERING COMPARTMENT. METER AND METERING TRANSFORMERS WILL BE SUPPLIED AND INSTALLED BY MANITOBA HYDRO.
- PROVIDE NEW 5KV CABLE (133% INSULATION) BELOW GRADE. PROVIDE 5/8KV INDOOR RATED, 3/C MODIFICATION KIT (BREAKOUT BOOT) COMPLETE WITH 1/C TERMINATIONS SUITABLE FOR TERMINATIONS AT SGR-F70 METERING COMPARTMENT. PROVIDE 5/8KV INDOOR RATED, 3/C MODIFICATION KIT (BREAKOUT BOOT) COMPLETE WITH LOAD-BREAK ELBOWS FOR TERMINATIONS AT TRANSFORMER XFMR-F1 PRIMARY COMPARTMENT.
- PROVIDE A NEW NEUTRAL-GROUND LINK AT CUSTOMER SERVICE SWITCHGEAR SGR-F70.
- RETAG EXISTING CABLES.
- REPLACE EXISTING LAMACIODS.
- CONTRACTOR TO PROVIDE KIRK KEY ON EXISTING TRANSFORMER XFMR-F70. MAKE ADJUSTMENTS AS NECESSARY. SUPPLY CITY WITH KEYS.
- CONTRACTOR SHALL REMOVE THE EXISTING METERING CURRENT TRANSFORMERS AND POTENTIAL TRANSFORMERS. CONTRACTOR SHALL PROVIDE NEW BUS BARS TO THE GAP (OR GAPS) WITHIN THE BUS BAR CONDUCTOR SYSTEM AS A RESULT OF THE TRANSFORMER REMOVALS SO THAT THE CONDUCTOR ELEMENTS ARE CONTINUOUS WITHOUT BREAK.

LEGEND:

- NEW WORK
- NEW
- EXISTING

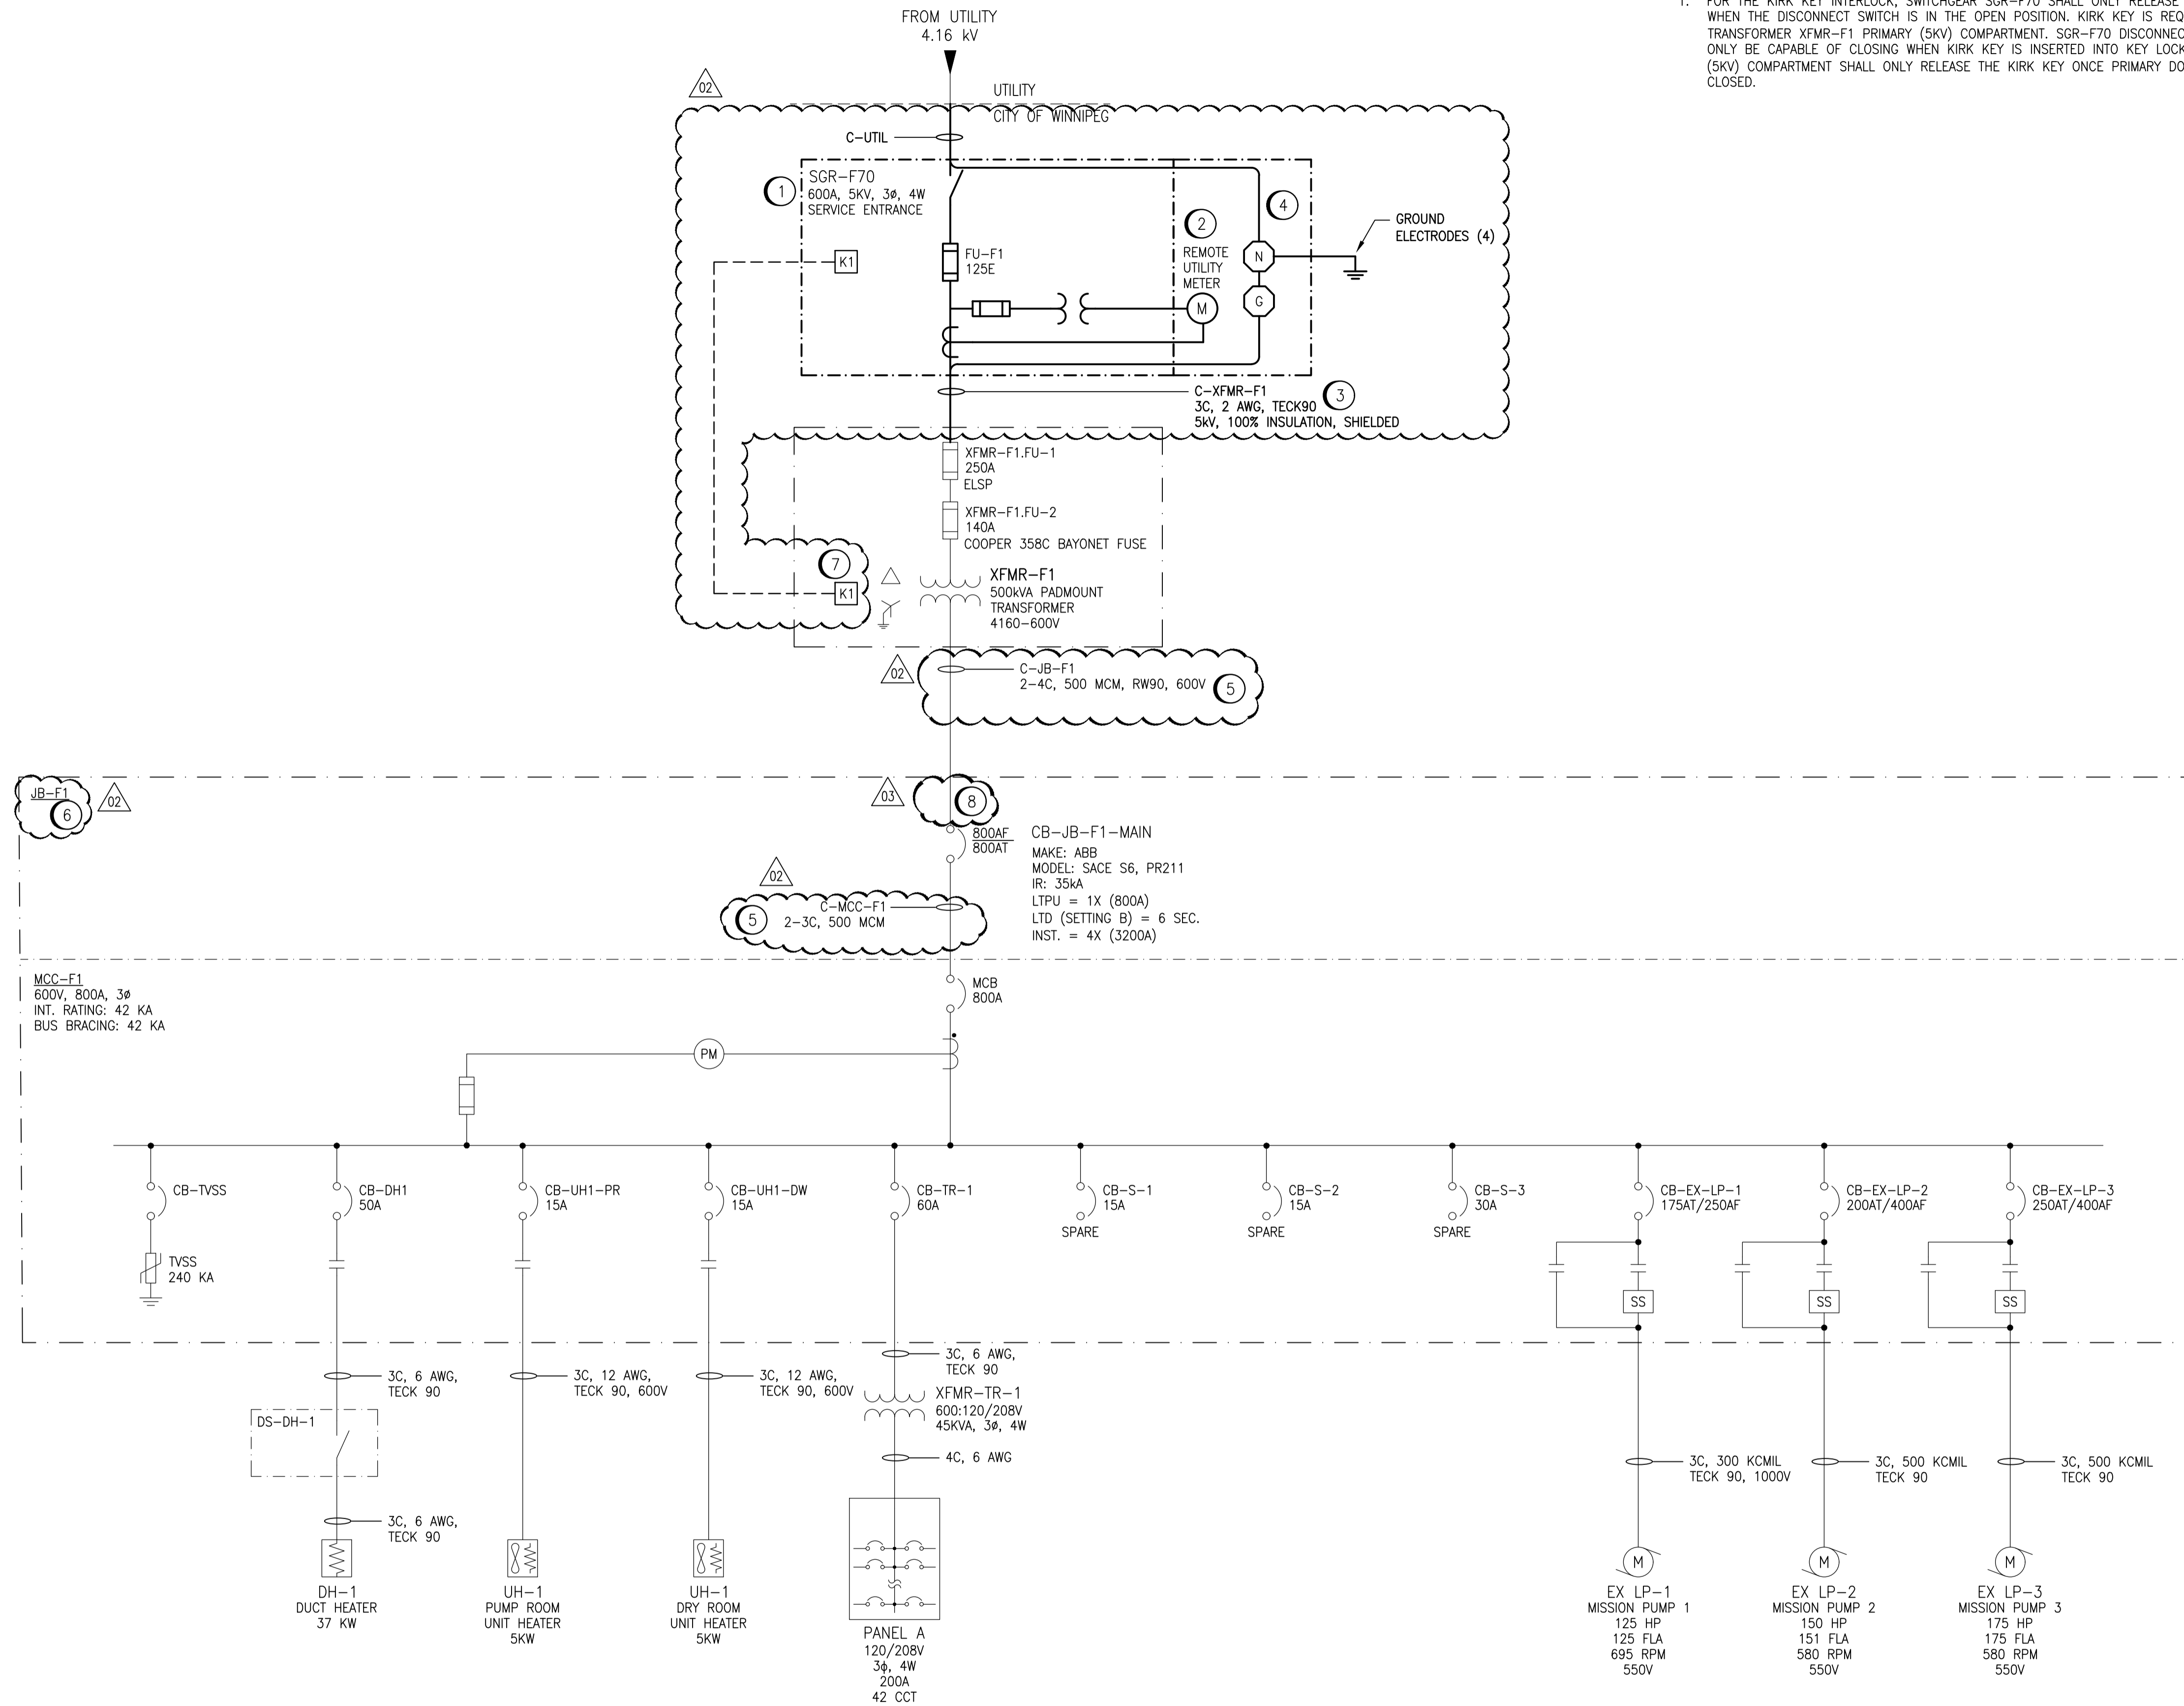

**ENGINEERS
 GEOSCIENTISTS
 MANITOBA**
 Certificate of Authorization
AtkinsRéalis Canada Inc.
 No. 4489

NO.	REVISIONS	DATE	DESIGN	CHECK
03	ISSUED FOR ADDENDUM 02	2025/01/23	PG	VE
02	ISSUED FOR TENDER AND CONSTRUCTION	2024/12/20	PG	VE

AtkinsRéalis
 148 Nature Park Way, Winnipeg, Manitoba
 Canada R3P 0X7 204-786-8080

DESIGNED BY: P. GILL
 CHECKED BY: V. ELIMBAN
 DRAWN BY: K. MOHAMMED
 APPROVED BY: D. BECKER
 SCALE: N.T.S.
 ISSUED FOR CONSTRUCTION BY: B. SOLOWAY
 DATE: 2024/07/18
 DATE: 2024/12/20
 CONSULTANT NO.: 701408

ENGINEER'S SEAL

THE CITY OF WINNIPEG
 WATER AND WASTE DEPARTMENT

MISSION FLOOD PUMPING STATION
 2025 TRANSFORMER REMEDIATION UPGRADES
 SINGLE LINE DIAGRAM

CITY DRAWING NUMBER: 1-0163F-E0001
 SHEET: 001
 REV: 03
 SIZE: A1