




APPENDIX C: PIER CORES

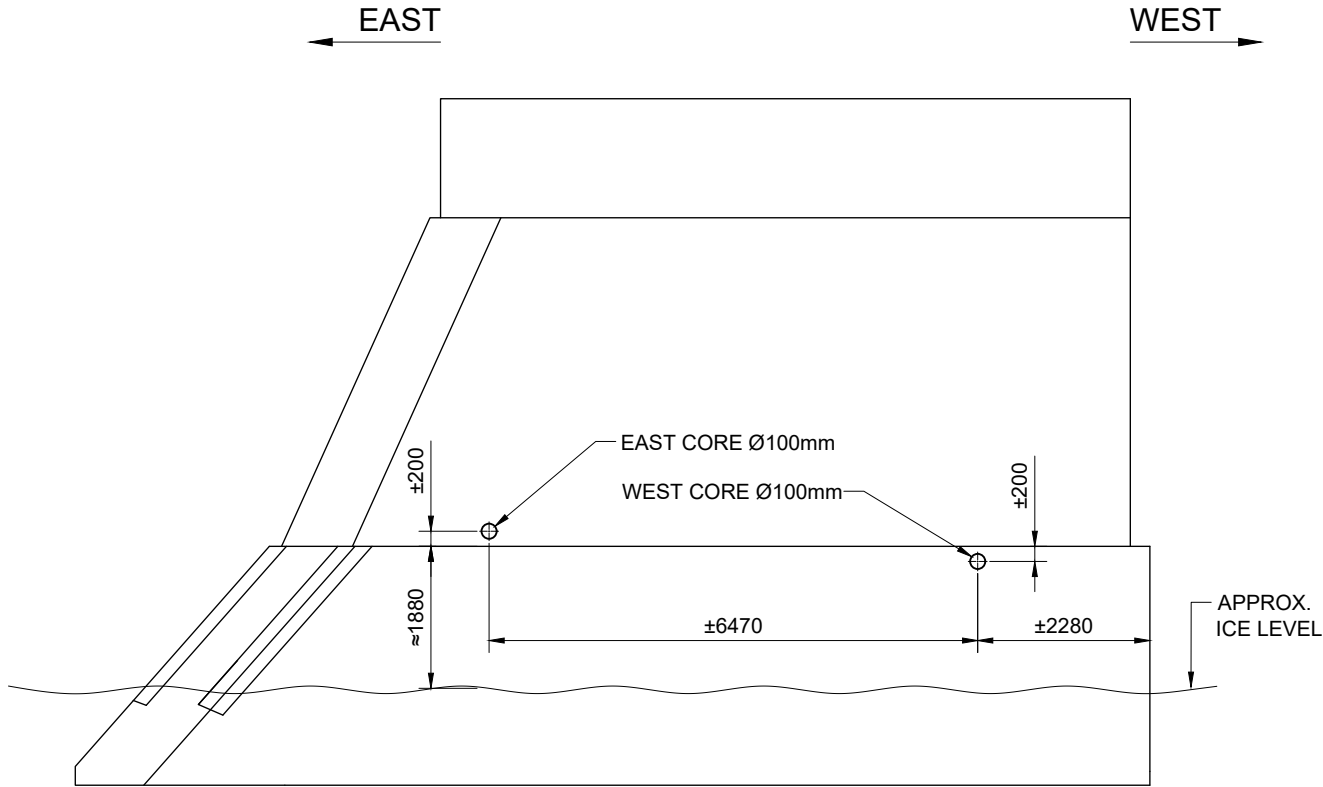


1 PIER (SU.2) NORTH ELEVATION
1 : 100

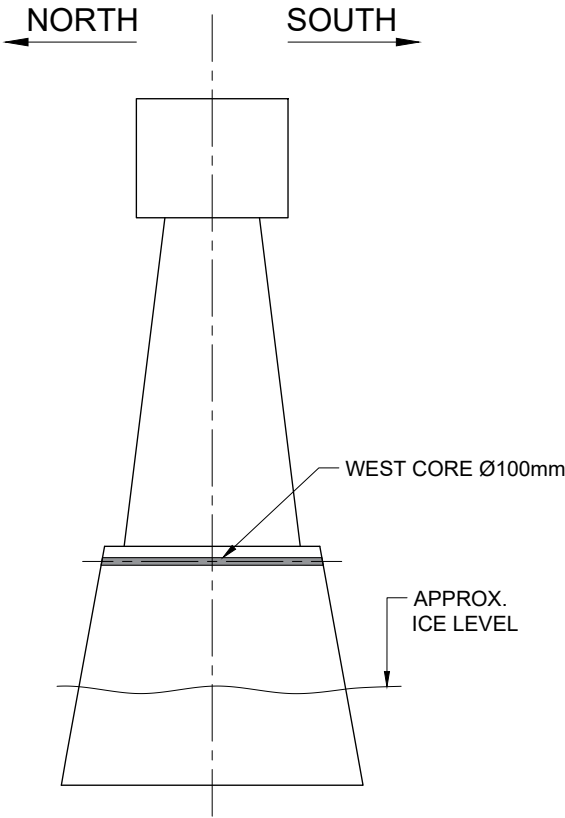


2 WEST ELEVATION
1 : 100

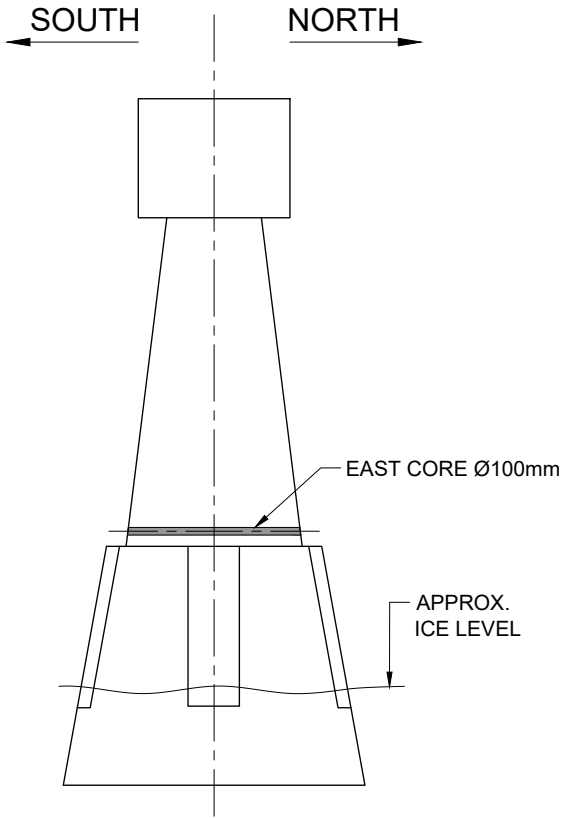

3 EAST ELEVATION
1 : 100

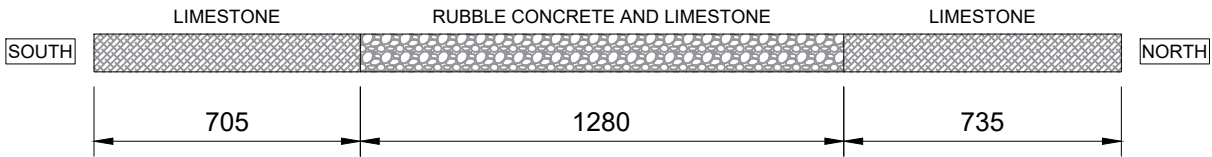

4 SU.2 EAST BOREHOLE STRATA
1 : 20

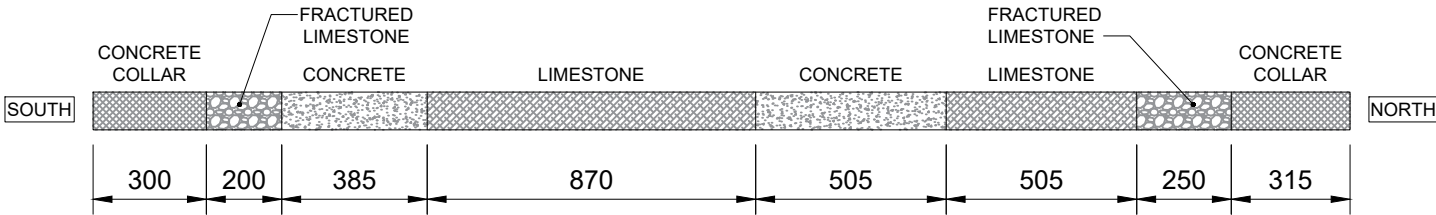

5 SU.2 WEST BOREHOLE STRATA
1 : 20