



LAST SAVE: 2026/03/06 - 3:28pm
 PATH: M:\Data\84\00 City of Winnipeg\1 - Tylehurst Lift Station Upgrades\AutoDesk\ACAD\1-0193L-B0002-002-00.dwg
 A1 SIZE - 594mm x 841mm

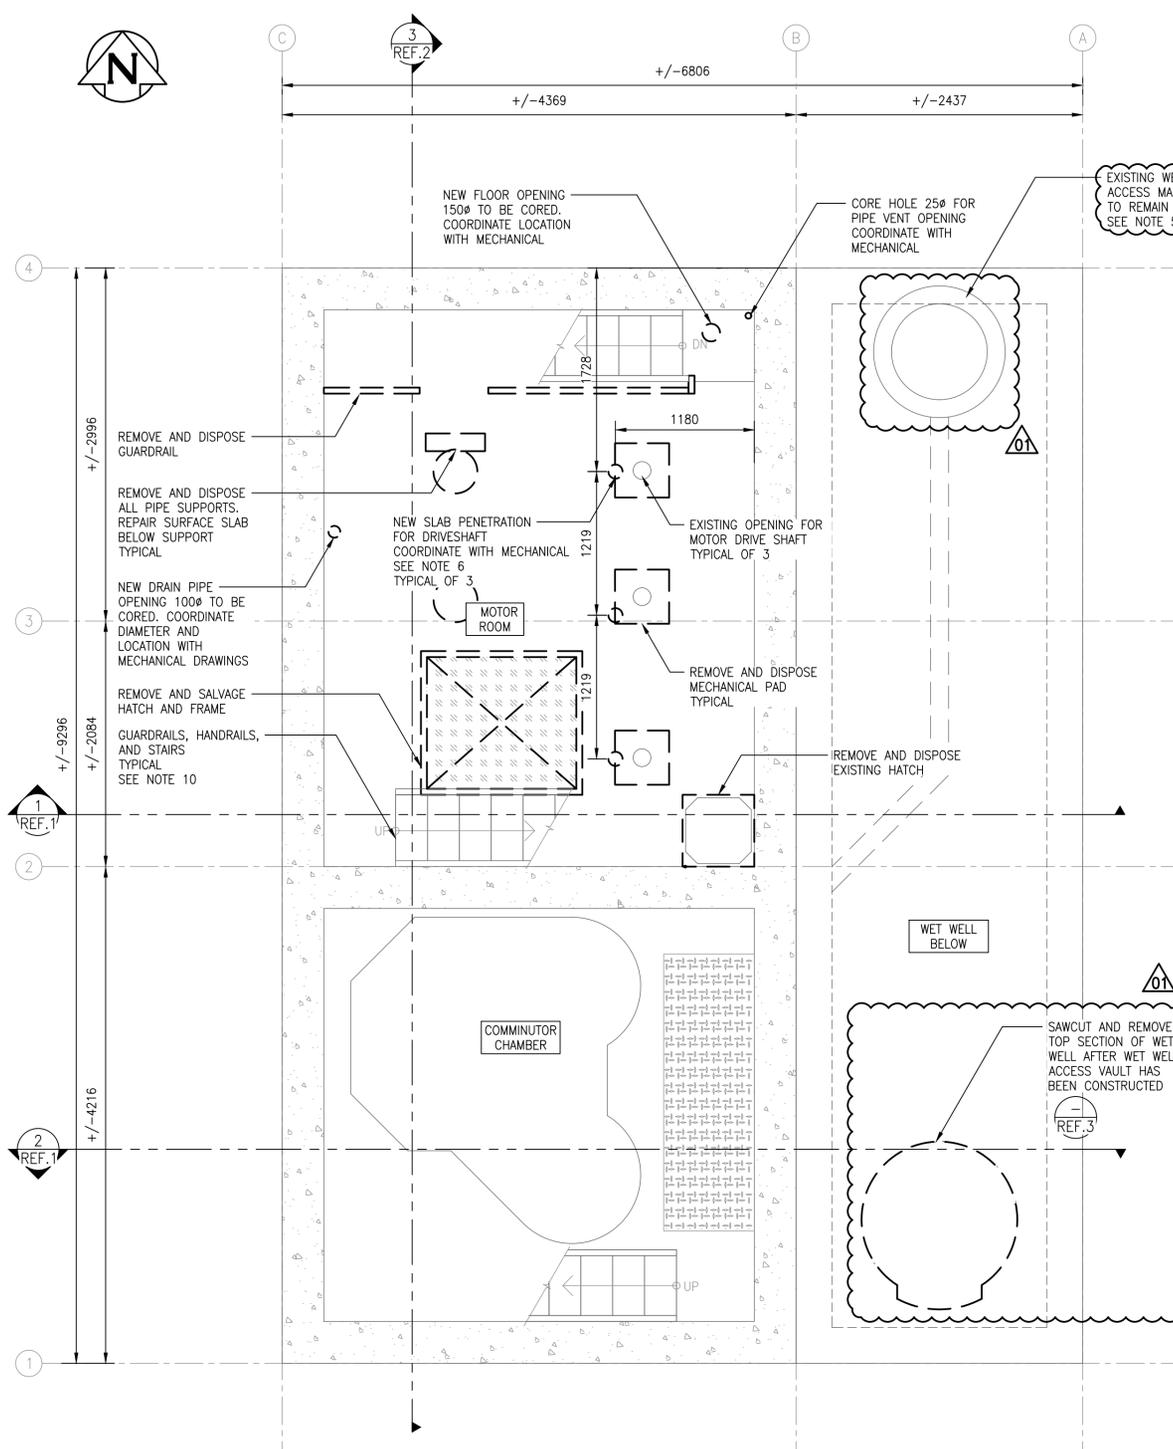


MOTOR ROOM AND COMMUNUTOR CHAMBER - DEMOLITION PLAN (EL. 225.817m)
SCALE: 1:30

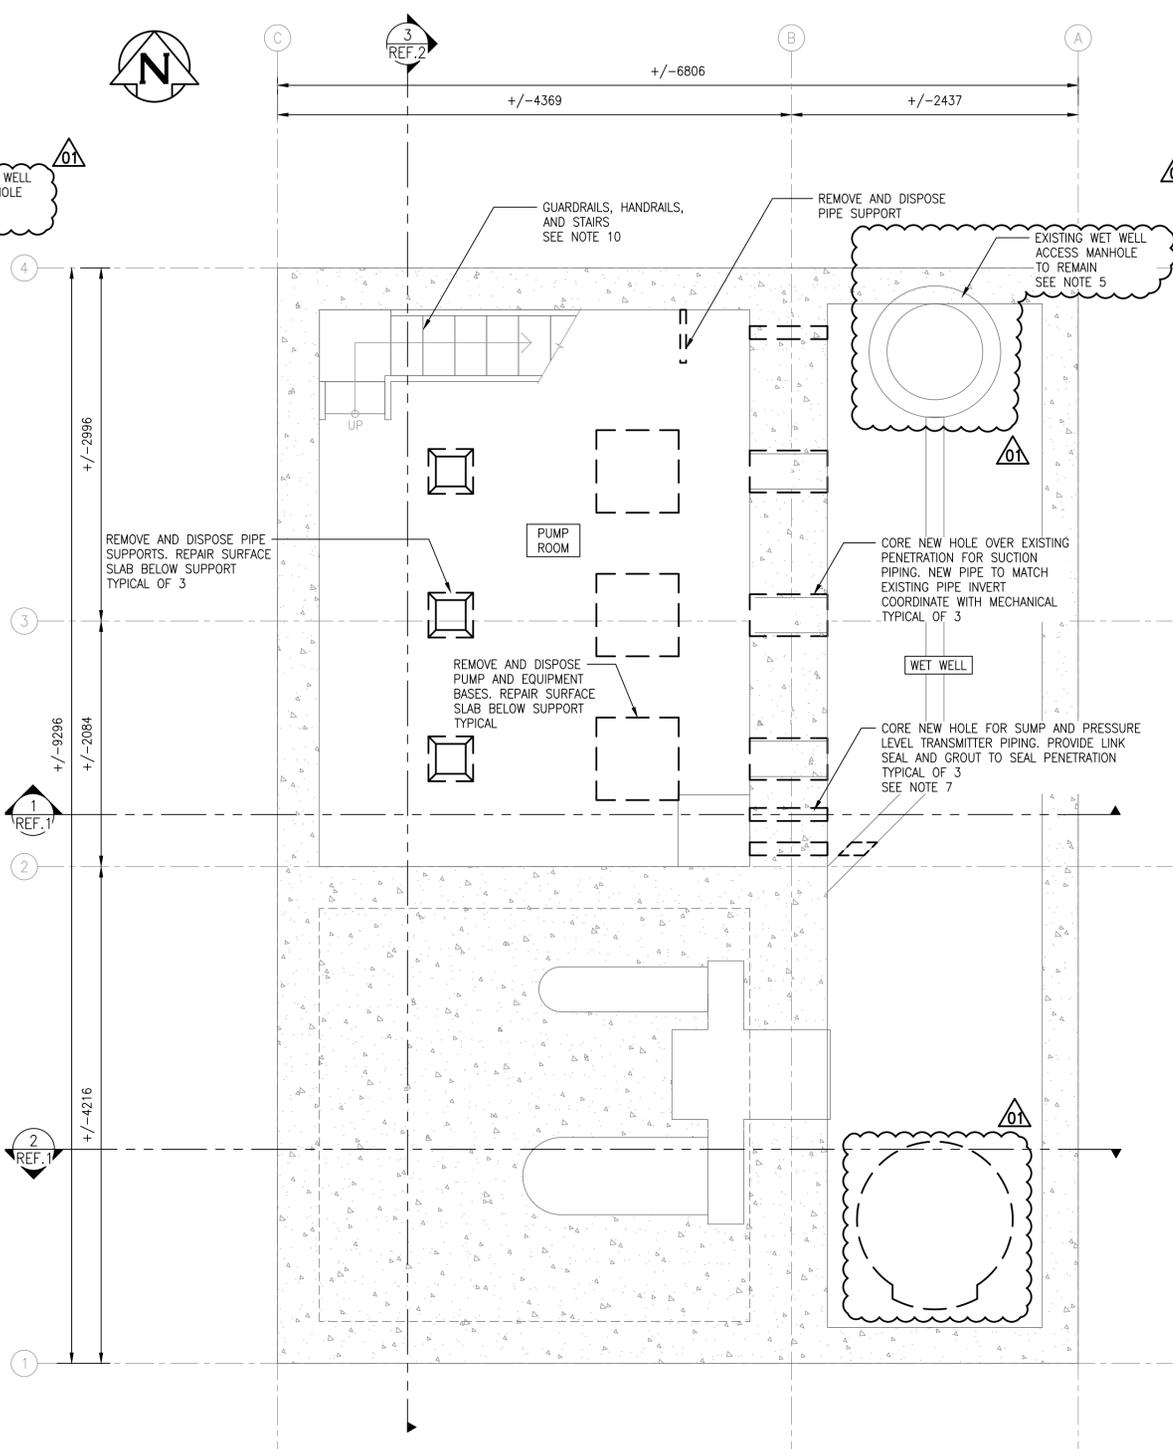

PUMP ROOM AND WET WELL - DEMOLITION PLAN (EL. 222.772m)
SCALE: 1:30

- GENERAL NOTES:**
1. ALL ITEMS SHOWN BOLD DASHED LINES INDICATE ITEMS TO BE DEMOLISHED. SOLID AND GREY LINES INDICATE EXISTING TO REMAIN.
 2. REMOVE AND DISPOSE ALL DEMOLISHED MATERIAL AT APPROVED DISPOSAL SITE.
 3. OVERCUTTING IS NOT PERMITTED.
 4. CUT OFF ALL ANCHOR BOLTS FLUSH WITH FLOOR SURFACE.
 5. CONTRACTOR RESPONSIBLE FOR PROTECTION OF EXISTING ACCESS MANHOLE AND WET WELL STRUCTURE DURING DEMOLITION AND CONSTRUCTION.
 6. NEW MOTOR SHAFT HOLES TO BE CORED. COORDINATE DIAMETER WITH PUMP SUPPLIER.
 7. CORE HOLE FOR PIPE WITH DOUBLE LINK SEAL AND GROUT. CONFIRM LOCATION AND SIZE WITH ENGINEER.
 8. COORDINATE WITH CITY TO IDENTIFY ALL SALVAGEABLE MATERIALS PRIOR TO DEMOLITION.
 9. AFTER EQUIPMENT IS REMOVED, CLEAN ALL FLOORS AND WALLS TO REMOVE LOOSE MATERIALS. PREPARE SURFACES IN ACCORDANCE WITH SECTION 09 01 90.63. ALL CONCRETE FLOORS TO BE RESINOUS EPOXY COATED PER SECTION 09 67 23.
 10. SURFACE PREPARATION (AFTER REMOVAL): CLEAN EXPOSED CONCRETE, MASONRY AND METAL STEEL SURFACES AFTER DEMOLITION, REMOVE LOOSE MATERIAL, RUST AND DEBRIS. PREPARE ALL SURFACES IN ACCORDANCE WITH SECTION 09 01 90.63.

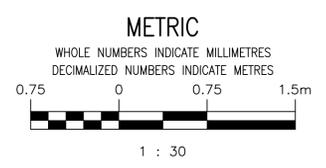

NO.	DRAWING NUMBER	REFERENCE DRAWINGS TITLE
3	1-0193L-S0002-002	STRUCTURAL PLANS MOTOR ROOM, COMMUNUTOR CHAMBER AND PUMP ROOM NEW WORK
2	1-0193L-B0004-002	ARCHITECTURAL SECTIONS BUILDING SECTIONS DEMOLITION
1	1-0193L-B0004-001	ARCHITECTURAL SECTIONS BUILDING SECTIONS DEMOLITION

**ENGINEERS
GEOSCIENTISTS
MANITOBA**
Certificate of Authorization
MPE, a division of Englobe Corp.
No. 4968 Date: MAR 09, 2026

NO.	REVISIONS	DATE	DESIGN	CHECK
01	ISSUED FOR DEMOLITION, B.O. 1042-2025	2026-03-09	MJB	MJB
00	ISSUED FOR DEMOLITION, B.O. 1042-2025	2026-01-09	MJB	MJB


MPE
a division of Englobe

DESIGNED BY: M. BAKER
CHECKED BY: M. BAKER
DRAWN BY: J. BALVERDE
APPROVED BY: M. BAKER

SCALE: AS NOTED
RELEASED FOR CONSTRUCTION

DATE: 2026-01-09
BY: DATE:

CONSULTANT NO.: 8400-011-00

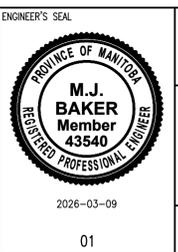

THE CITY OF WINNIPEG
WATER AND WASTE DEPARTMENT

TYLEHURST LIFT STATION
2026 UPGRADES
ARCHITECTURAL PLANS
MOTOR ROOM, COMMUNUTOR CHAMBER AND PUMP ROOM
DEMOLITION

CITY DRAWING NUMBER: 1-0193L-B0002
SHEET: 002
REV: 01
SIZE: A1