



1 SECTION  
 REF.1,2 SCALE: 1:30

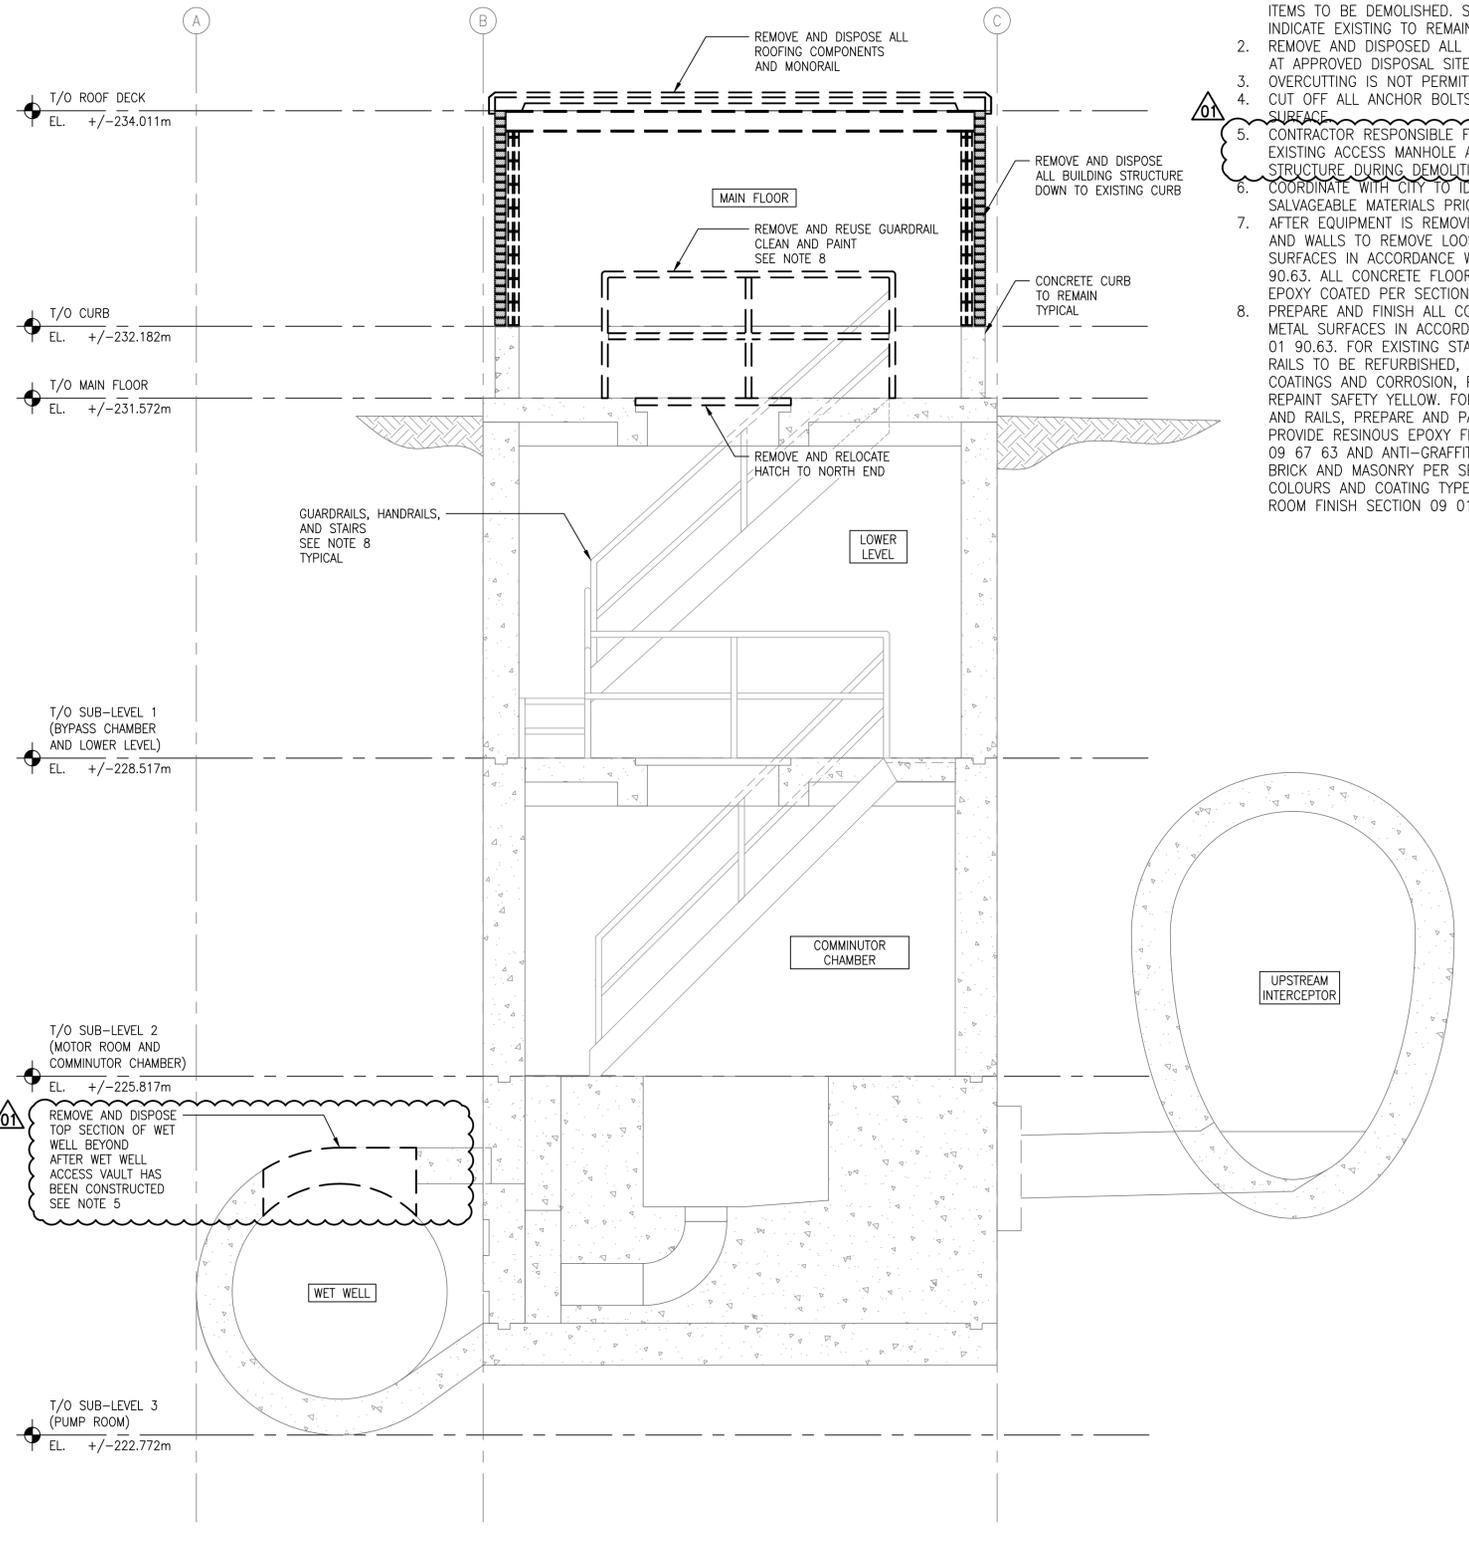

2 SECTION  
 REF.1,2 SCALE: 1:30

- GENERAL NOTES:**
- ALL ITEMS SHOWN BOLD DASHED LINES INDICATE ITEMS TO BE DEMOLISHED. SOLID AND GREY LINES INDICATE EXISTING TO REMAIN.
  - REMOVE AND DISPOSE ALL DEMOLISHED MATERIAL AT APPROVED DISPOSAL SITE.
  - OVERCUTTING IS NOT PERMITTED.
  - CUT OFF ALL ANCHOR BOLTS FLUSH WITH FLOOR SURFACE.
  - CONTRACTOR RESPONSIBLE FOR PROTECTION OF EXISTING ACCESS MANHOLE AND WET WELL STRUCTURE DURING DEMOLITION AND CONSTRUCTION.
  - COORDINATE WITH CITY TO IDENTIFY ALL SALVAGEABLE MATERIALS PRIOR TO DEMOLITION.
  - AFTER EQUIPMENT IS REMOVED, CLEAN ALL FLOORS AND WALLS TO REMOVE LOOSE MATERIALS. PREPARE SURFACES IN ACCORDANCE WITH SECTION 09 01 90.63. ALL CONCRETE FLOORS TO BE RESINOUS EPOXY COATED PER SECTION 09 67 23.
  - PREPARE AND FINISH ALL CONCRETE, MASONRY AND METAL SURFACES IN ACCORDANCE WITH SECTION 09 01 90.63. FOR EXISTING STAIRS, LADDERS AND RAILS TO BE REFURBISHED, REMOVE LOOSE COATINGS AND CORROSION, PREPARE SURFACES AND REPAINT SAFETY YELLOW. FOR NEW STAIRS, LADDERS AND RAILS, PREPARE AND PAINT SAFETY YELLOW. PROVIDE RESINOUS EPOXY FLOORING PER SECTION 09 67 63 AND ANTI-GRAFFITI COATING ON EXTERIOR BRICK AND MASONRY PER SECTION 09 96 50. COLOURS AND COATING TYPE SHALL COMPLY WITH ROOM FINISH SECTION 09 01 90.63.

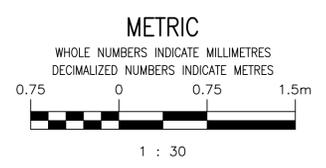

|     |                   |   |
|-----|-------------------|---|
| 9   |                   |   |
| 8   |                   |   |
| 7   |                   |   |
| 6   |                   |   |
| 5   |                   |   |
| 4   |                   |   |
| 3   |                   |   |
| 2   | 1-0193L-B0002-002 | ARCHITECTURAL PLANS MOTOR ROOM, COMMUNOTOR CHAMBER AND PUMP ROOM DEMOLITION |
| 1   | 1-0193L-B0002-001 | ARCHITECTURAL PLANS MAIN FLOOR AND LOWER LEVEL DEMOLITION                   |
| NO. | DRAWING NUMBER    | REFERENCE DRAWINGS TITLE  |

**ENGINEERS  
 GEOSCIENTISTS  
 MANITOBA**  
 Certificate of Authorization  
 MPE, a division of Englobe Corp.  
 No. 4968 Date: MAR 09, 2026

|     |  |            |        |       |
|-----|--|------------|--------|-------|
| NO. | REVISIONS                                | DATE       | DESIGN | CHECK |
| 01  | RE-ISSUED FOR DEMOLITION, B.O. 1042-2025 | 2026-03-09 | MJB    | MJB   |
| 00  | ISSUED FOR DEMOLITION, B.O. 1042-2025    | 2026-01-09 | MJB    | MJB   |

**MPE**  
 a division of Englobe

DESIGNED BY: M. BAKER  
 CHECKED BY: M. BAKER  
 DRAWN BY: J. BALVERDE  
 APPROVED BY: M. BAKER  
 SCALE: AS NOTED  
 DATE: 2026-01-09  
 CONSULTANT NO.: 8400-011-00

ENGINEER'S SEAL  
**M.J. BAKER**  
 Member  
 43540  
 REGISTERED PROFESSIONAL ENGINEER  
 2026-03-09

**THE CITY OF WINNIPEG**  
 WATER AND WASTE DEPARTMENT

TYLEHURST LIFT STATION  
 2026 UPGRADES  
 ARCHITECTURAL SECTIONS  
 BUILDING SECTIONS  
 DEMOLITION

CITY DRAWING NUMBER  
**1-0193L-B0004**

SHEET  
**001**

REV.  
**01**

SIZE  
**A1**