



A1 SIZE - 594mm x 841mm

LAST SAVE: 2026/03/06 - 3:30pm  
 PATH: M:\Data\84\00 City of Winnipeg\11 - Tylehurst Lift Station Upgrades\AutoDesk\ACAD\1-0193L-B0004-001-01.dwg

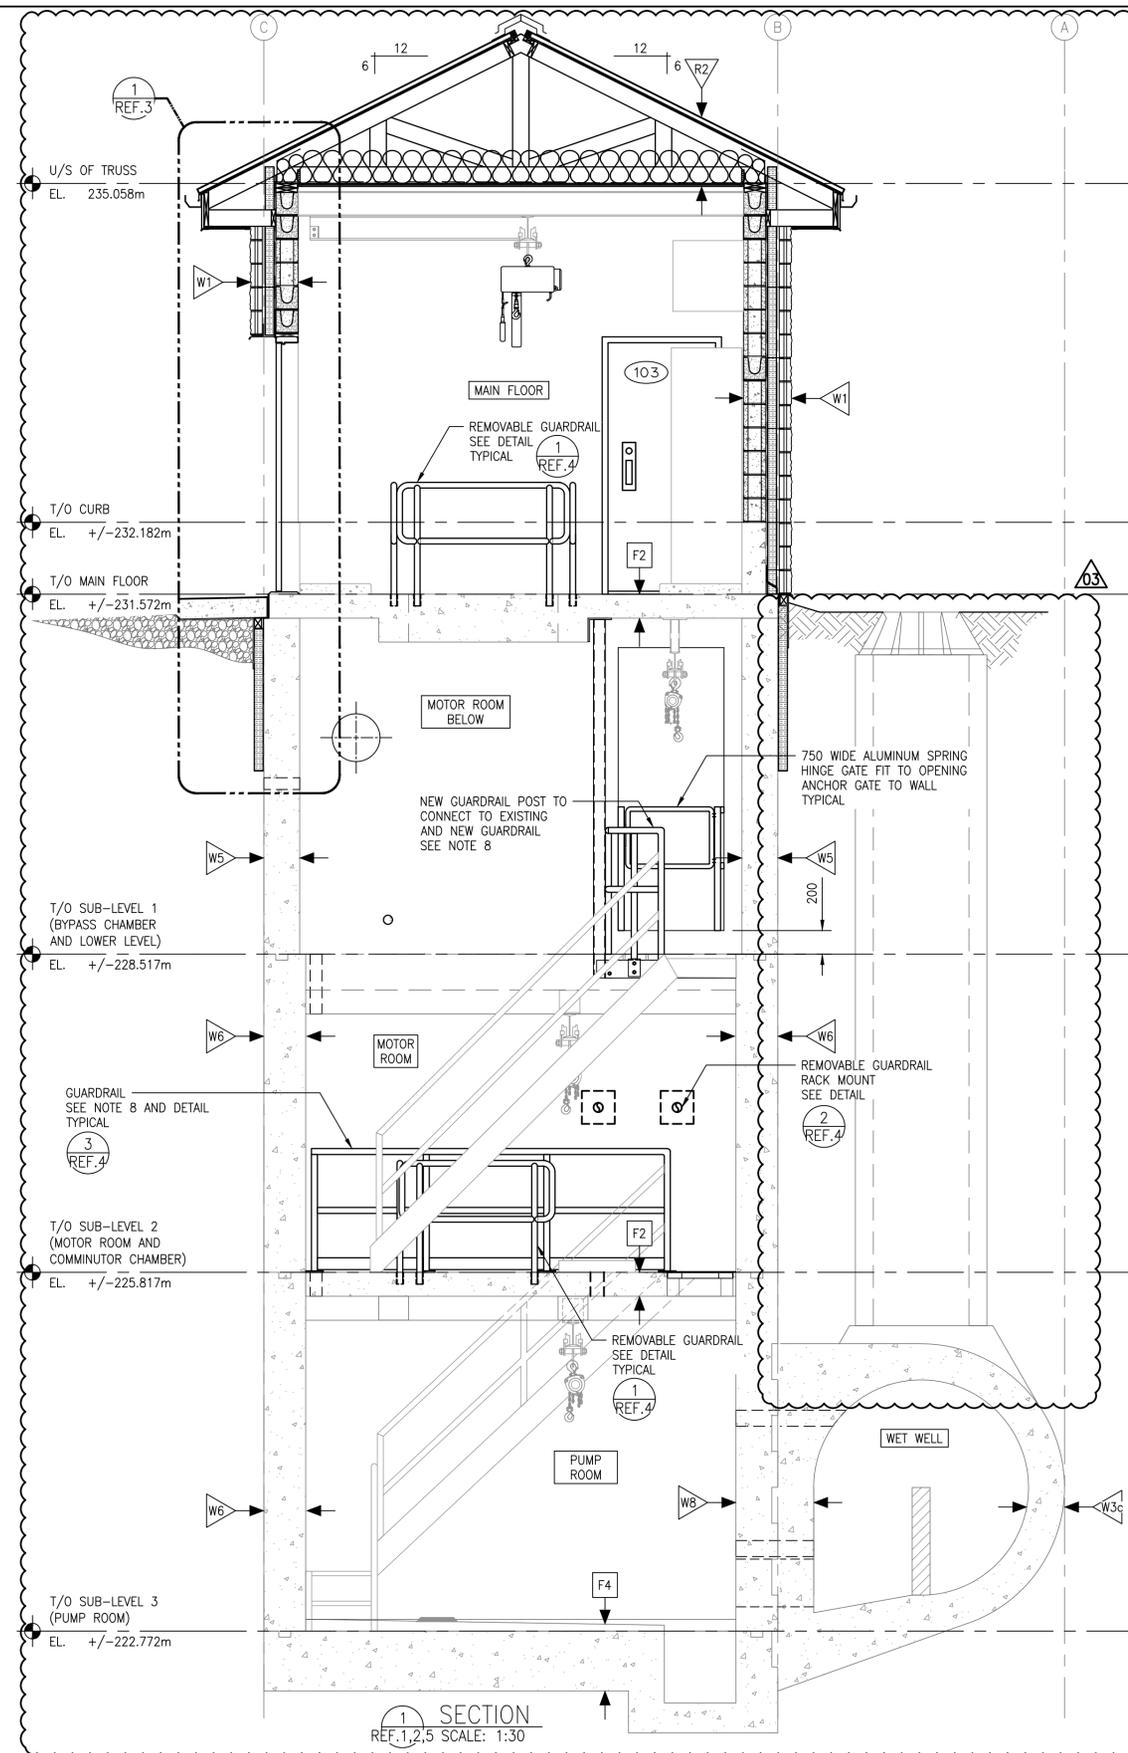


SECTION 1  
 REF.1,2,5 SCALE: 1:30

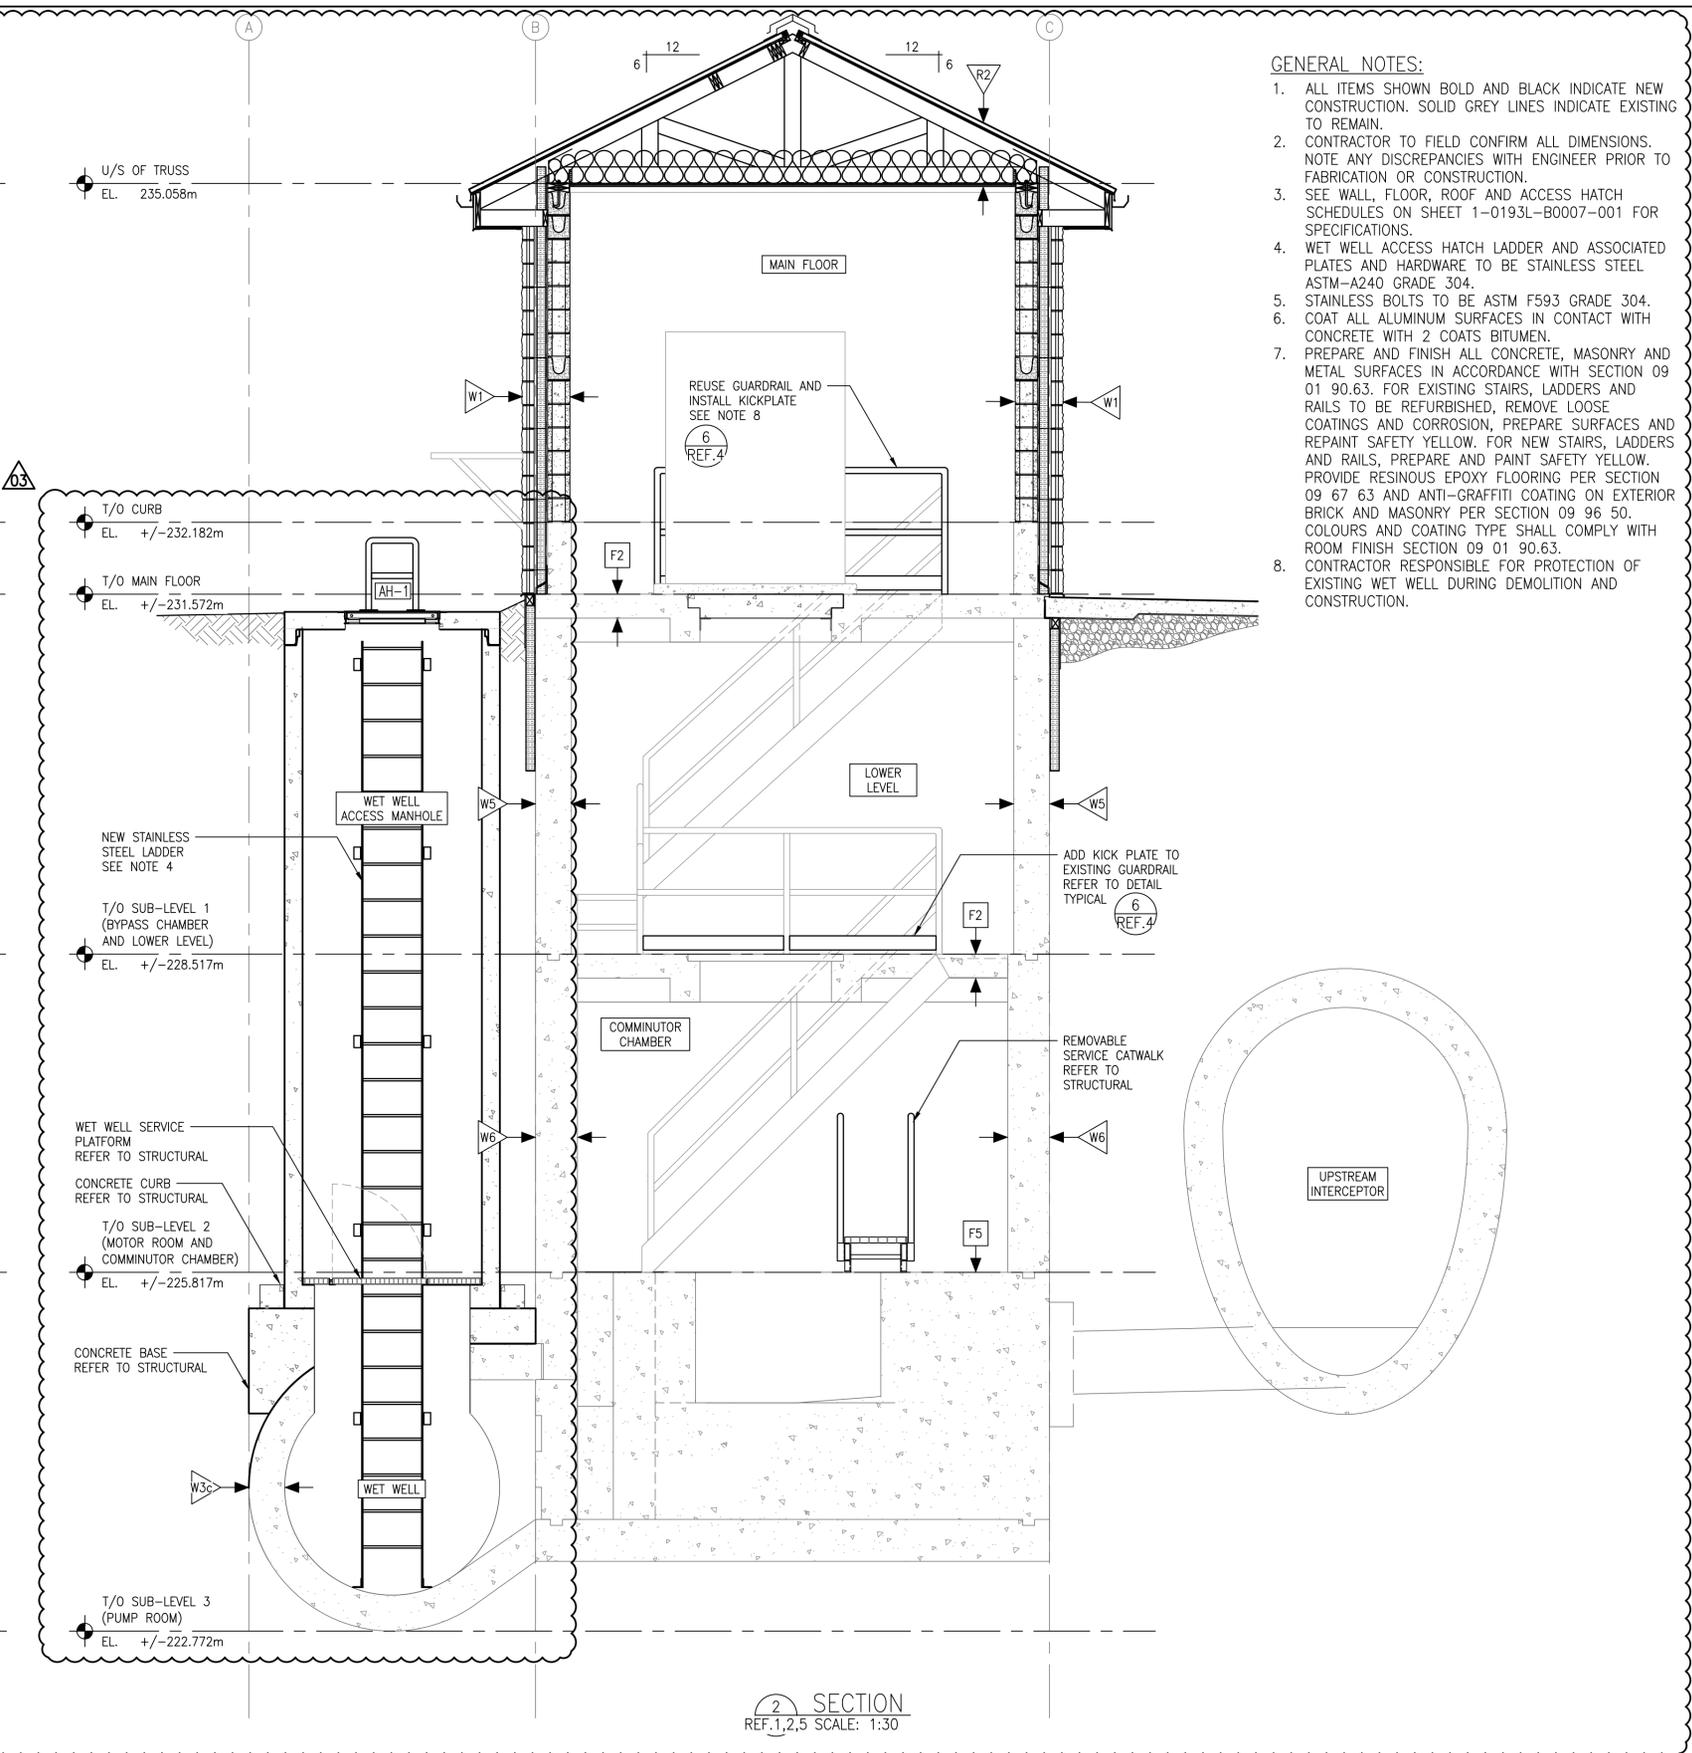

SECTION 2  
 REF.1,2,5 SCALE: 1:30

- GENERAL NOTES:**
- ALL ITEMS SHOWN BOLD AND BLACK INDICATE NEW CONSTRUCTION. SOLID GREY LINES INDICATE EXISTING TO REMAIN.
  - CONTRACTOR TO FIELD CONFIRM ALL DIMENSIONS. NOTE ANY DISCREPANCIES WITH ENGINEER PRIOR TO FABRICATION OR CONSTRUCTION.
  - SEE WALL, FLOOR, ROOF AND ACCESS HATCH SCHEDULES ON SHEET 1-0193L-B0007-001 FOR SPECIFICATIONS.
  - WET WELL ACCESS HATCH LADDER AND ASSOCIATED PLATES AND HARDWARE TO BE STAINLESS STEEL ASTM-A240 GRADE 304.
  - STAINLESS BOLTS TO BE ASTM F593 GRADE 304.
  - COAT ALL ALUMINUM SURFACES IN CONTACT WITH CONCRETE WITH 2 COATS BITUMEN.
  - PREPARE AND FINISH ALL CONCRETE, MASONRY AND METAL SURFACES IN ACCORDANCE WITH SECTION 09 01 90.63. FOR EXISTING STAIRS, LADDERS AND RAILS TO BE REFURBISHED, REMOVE LOOSE COATINGS AND CORROSION, PREPARE SURFACES AND REPAINT SAFETY YELLOW. FOR NEW STAIRS, LADDERS AND RAILS, PREPARE AND PAINT SAFETY YELLOW. PROVIDE RESINOUS EPOXY FLOORING PER SECTION 09 67 63 AND ANTI-GRAFFITI COATING ON EXTERIOR BRICK AND MASONRY PER SECTION 09 96 50. COLOURS AND COATING TYPE SHALL COMPLY WITH ROOM FINISH SECTION 09 01 90.63.
  - CONTRACTOR RESPONSIBLE FOR PROTECTION OF EXISTING WET WELL DURING DEMOLITION AND CONSTRUCTION.

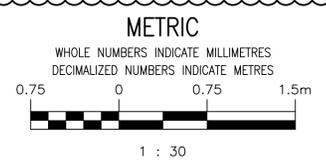

NO.	DRAWING NUMBER	REFERENCE DRAWINGS TITLE
9		
8		
7		
6		
5	1-0193L-B0003-001	ARCHITECTURAL PLAN ROOF PLAN
4	1-0193L-B0007-001	ARCHITECTURAL SCHEDULES AND DETAILS
3	1-0193L-B0006-001	ARCHITECTURAL WALL DETAILS
2	1-0193L-B0002-002	ARCHITECTURAL PLANS MOTOR ROOM, COMMUNOTOR CHAMBER AND PUMP ROOM NEW WORK
1	1-0193L-B0002-001	ARCHITECTURAL PLANS MAIN FLOOR AND LOWER LEVEL NEW WORK

**ENGINEERS  
 GEOSCIENTISTS  
 MANITOBA**

Certificate of Authorization  
 MPE, a division of Englobe Corp.  
 No. 4968 Date: MAR 09, 2026

NO.	REVISIONS	DATE	DESIGN	CHECK
03	RE-ISSUED FOR CONSTRUCTION, B.O. 1042-2025	2026-03-09	MJB	MJB
02	ISSUED FOR CONSTRUCTION, B.O. 1042-2025	2026-01-09	MJB	MJB
01	RE-ISSUED FOR DEMOLITION, B.O. 1042-2025	2026-03-09	MJB	MJB
00	ISSUED FOR DEMOLITION, B.O. 1042-2025	2026-01-09	MJB	MJB

**MPE**  
 a division of Englobe

DESIGNED BY: M. BAKER  
 CHECKED BY: M. BAKER

DRAWN BY: J. BALVERDE  
 APPROVED BY: M. BAKER

SCALE: AS NOTED  
 RELEASED FOR CONSTRUCTION

DATE: 2026-01-09  
 BY:

CONSULTANT NO.: 8400-011-00

ENGINEER'S SEAL

**M.J. BAKER**  
 Member  
 43540  
 REGISTERED PROFESSIONAL ENGINEER

2026-03-09

**THE CITY OF WINNIPEG**  
 WATER AND WASTE DEPARTMENT

TYLEHURST LIFT STATION  
 2026 UPGRADES  
 ARCHITECTURAL SECTIONS  
 BUILDING SECTIONS  
 NEW WORK

CITY DRAWING NUMBER: 1-0193L-B0004  
 SHEET: 001  
 REV: 03  
 SIZE: A1