

GENERAL NOTES


1. ALL WORK TO CONFORM TO CURRENT CITY OF WINNIPEG STANDARD CONSTRUCTION SPECIFICATIONS AND DETAILS UNLESS OTHERWISE NOTED.
2. DIMENSIONS ARE IN MILLIMETERS UNLESS OTHERWISE NOTED.
3. DO NOT SCALE DRAWINGS.
4. NATURAL ELEMENTS SHALL BE INSTALLED TO THE SATISFACTION OF THE CONTRACT ADMINISTRATOR.

CEDAR/OAK LOG NOTES


1. ENSURE LOGS ARE IMMOBILE AFTER INSTALLATION IS COMPLETE.
2. LOGS TO BE SOLID OAK, FREE FROM CHECKS, WARPS, AND CRACKS, DEBARKED, AND SKINNED/TURNED TO REMOVE ALL IRREGULARITIES SUCH AS BRANCH STUBS.

BOULDER NOTES

1. ENSURE BOULDERS ARE IMMOBILE AFTER CONSTRUCTION IS COMPLETE.
2. GRIND DOWN SHARP EDGES AND CORNERS

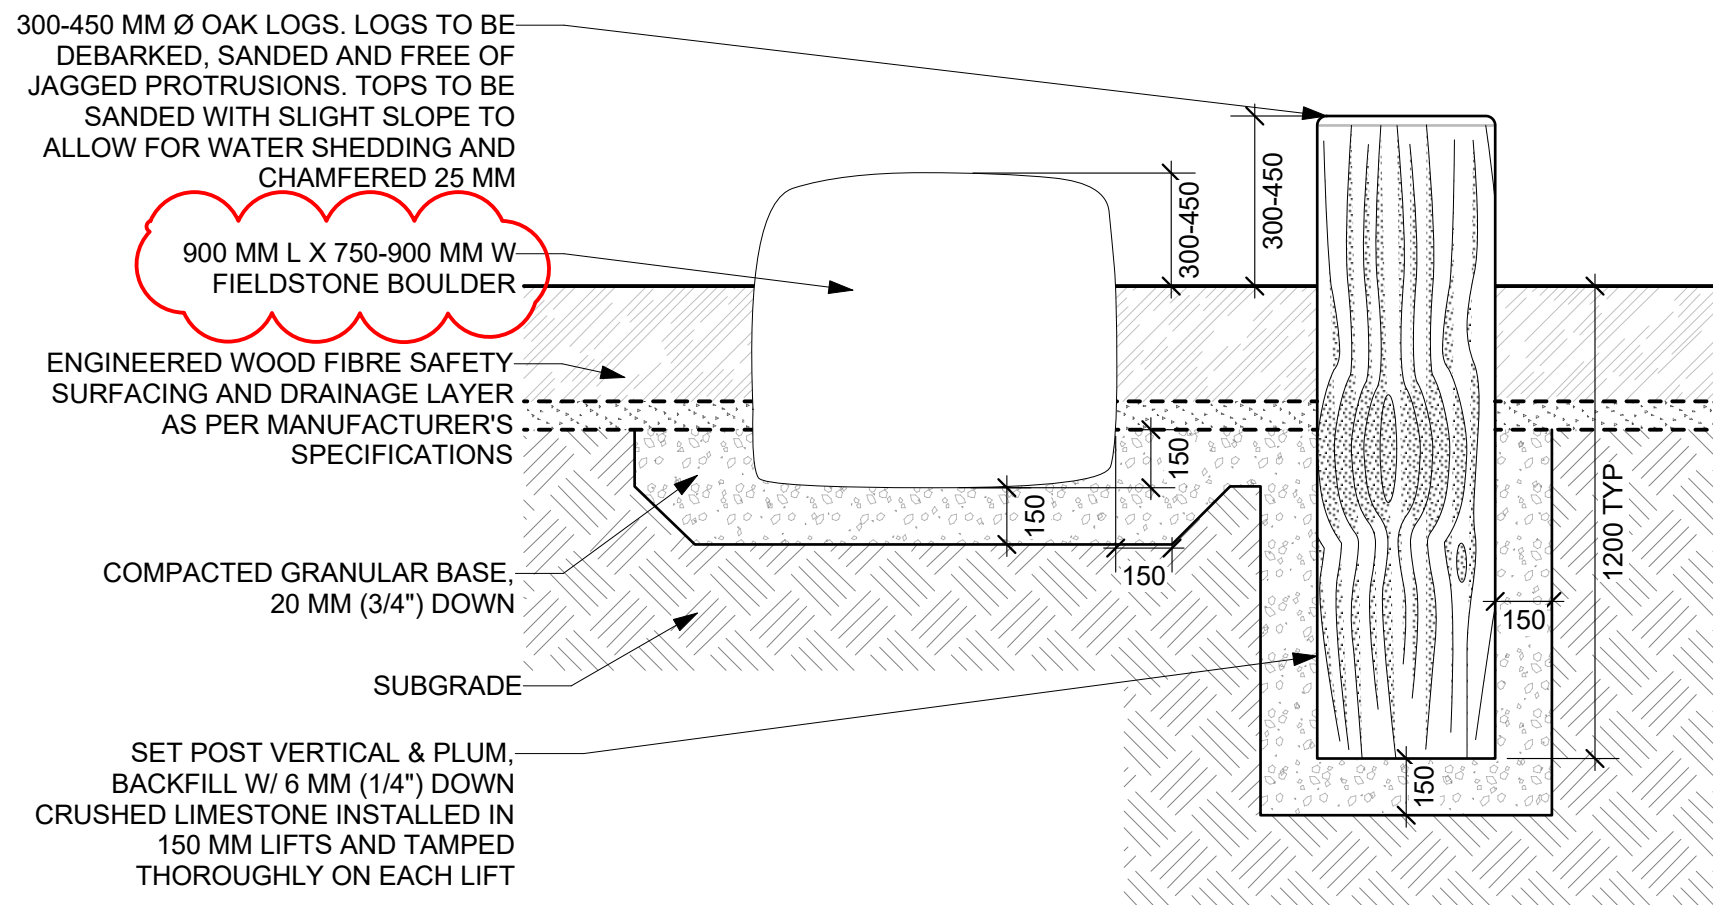

1 **FIELDSTONE BOULDERS & LOG STEPPERS**
Scale: 1:20

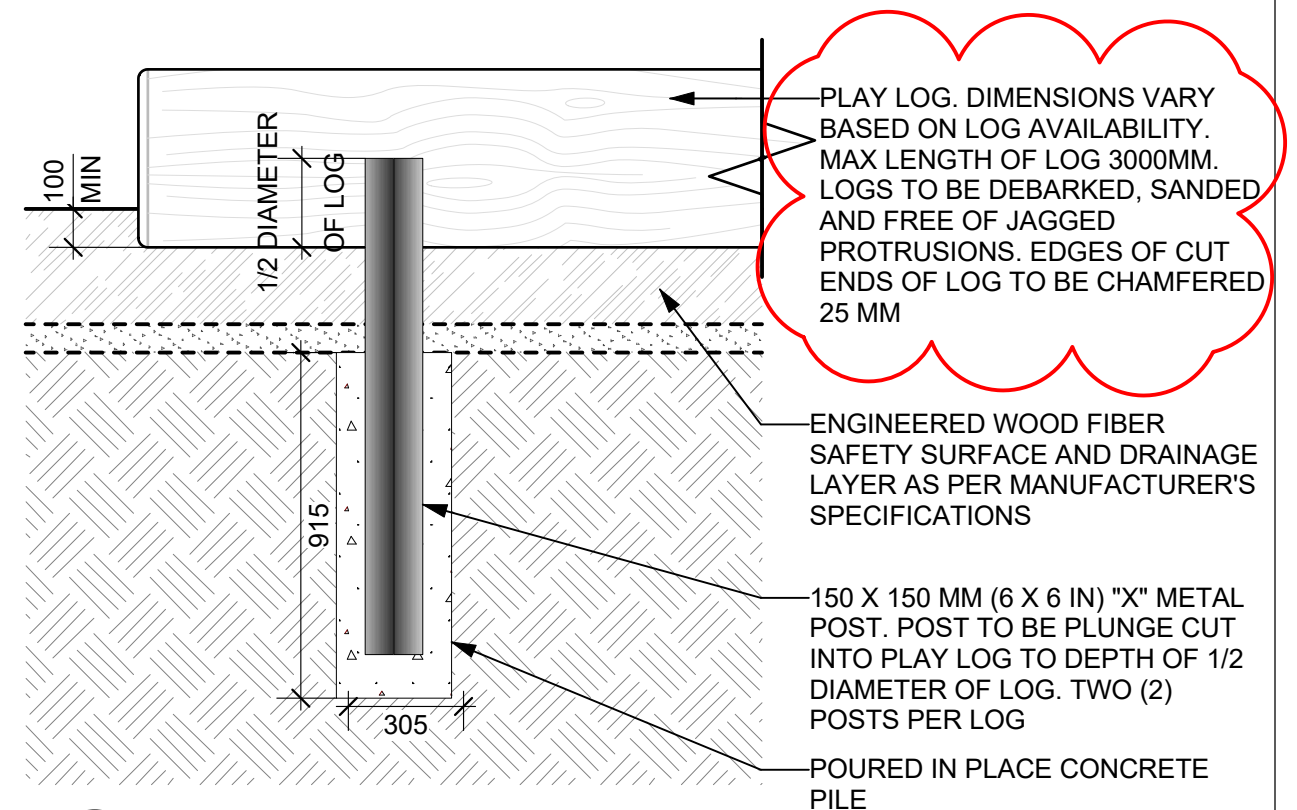

2 **PLAY LOG**
Scale: 1:20

CONTRACTOR TO CONFIRM ALL DIMENSIONS AND REPORT ANY DISCREPANCIES TO CONTRACT ADMINISTRATOR PRIOR TO CONSTRUCTION. LOCATION OF UNDERGROUND STRUCTURES AS SHOWN ARE BASED ON THE BEST INFORMATION AVAILABLE BUT NO GUARANTEE IS GIVEN THAT ALL EXISTING UTILITIES ARE SHOWN OR THAT THE GIVEN LOCATIONS ARE EXACT. CONFIRMATION OF EXISTENCE AND EXACT LOCATION OF ALL SERVICES MUST BE OBTAINED FROM THE INDIVIDUAL UTILITIES BEFORE PROCEEDING WITH CONSTRUCTION.



THE CITY OF WINNIPEG
Planning, Property and Development Department
Planning and Land Use Division
Unit 15 - 30 Fort Street, Winnipeg, MB, (R3C 4X5)

DESIGNED BY	MA	CHECKED BY	DL
DRAWN BY	MA	APPROVED BY	DL
HORIZ. SCALE	As Noted		
VERT. SCALE			
DATE	January 2025		

MANAGER,
PARK AND OPEN SPACES

DATE

MANAGER,
PLANNING AND LAND USE DIVISION

DATE

DRAWING TITLE
**Marshall Crescent Park
Playground Redevelopment
Details**

SITE ADDRESS 165 Marshall Crescent

DRAWING NO.
M.53 - F- R1

BID OPPORTUNITY NO.
113-2025