
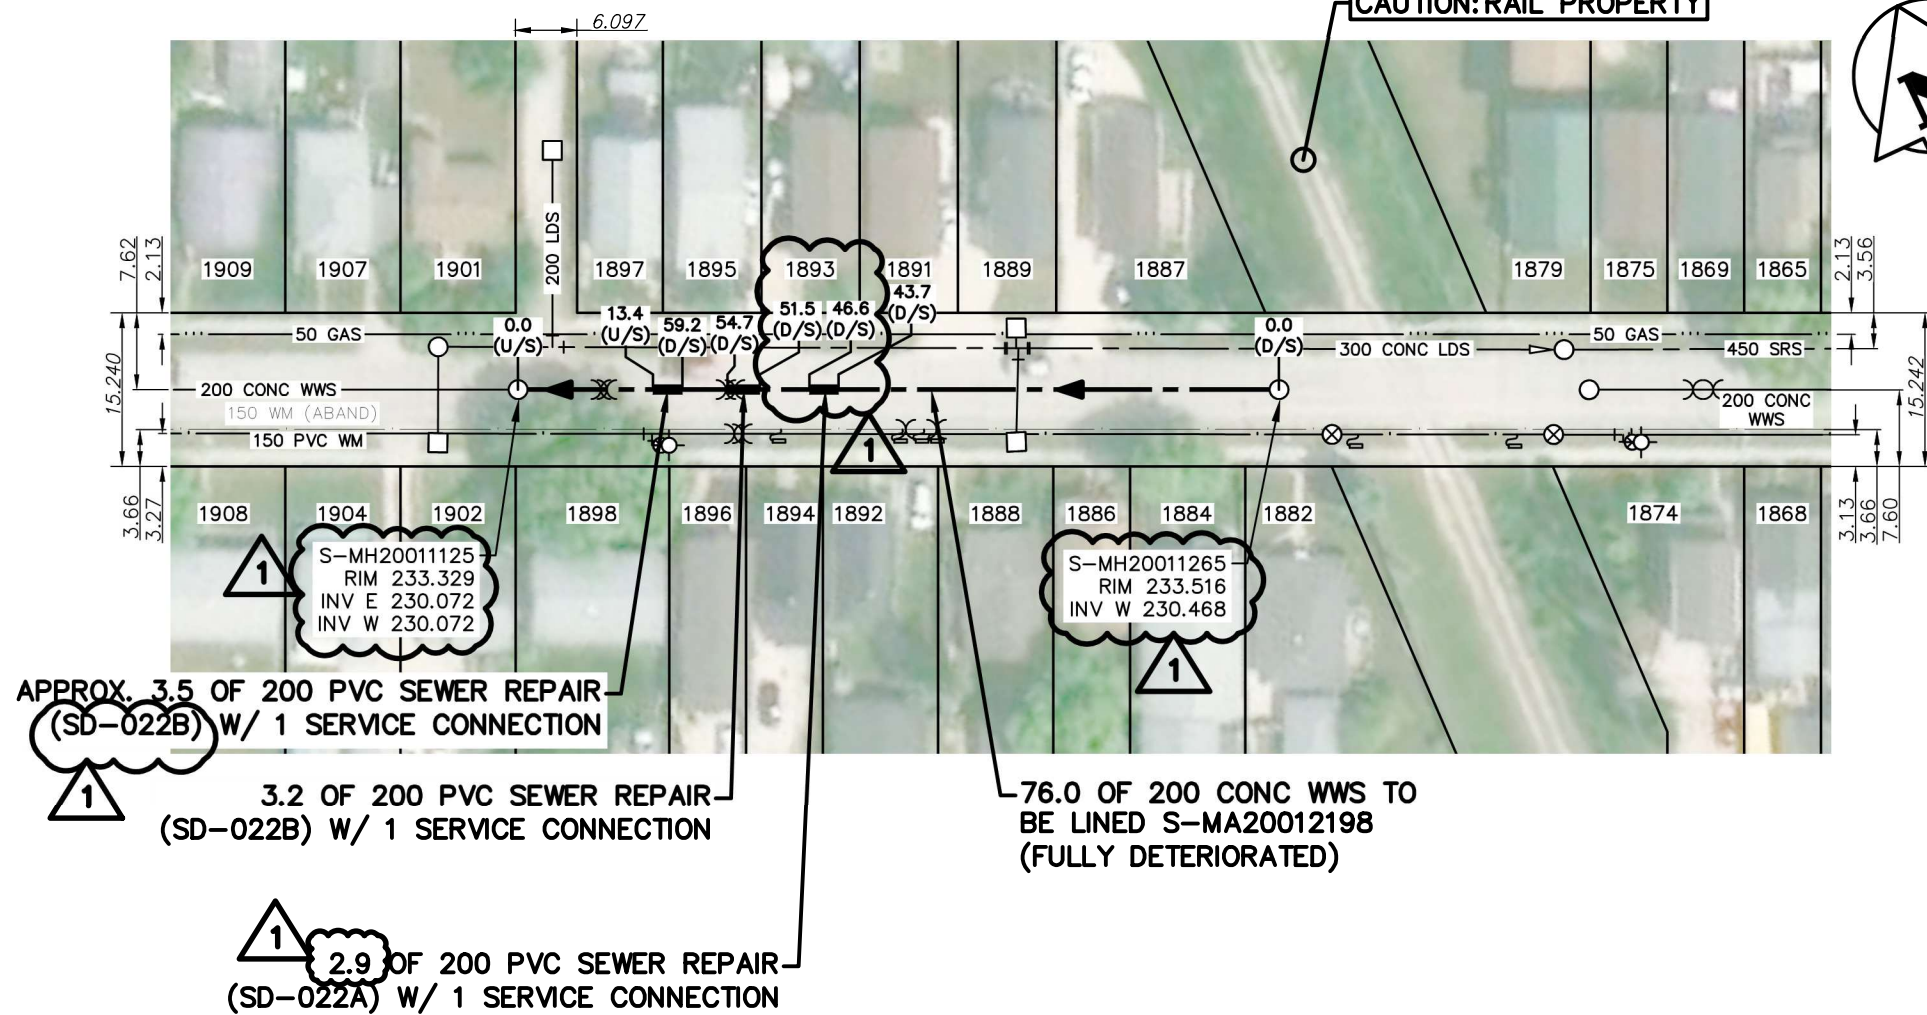


ROSS AVENUE

CAUTION: RAIL PROPERTY

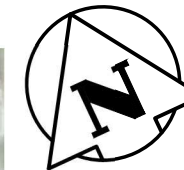

SEWER JUNCTION INFORMATION FROM SEWER VIDEO INSPECTION		
SEWER ID S-MA20012198		
DISTANCE FROM S-MH2001265		
DISTANCE	DIAMETER	CLOCK
2.3	100	10:00
10.2	150	11:00
12.4	150	2:00
20.3	150	11:00
29.4	150	2:00
32.4	150	10:00
35.3	150	12:00
42.5	150	2:00
46.4	150	10:00
54.4	150	10:00
54.9	150	10:00
59.8	150	10:00

SEWER JUNCTION INFORMATION FROM SEWER VIDEO INSPECTION		
SEWER ID S-MA20012198		
DISTANCE FROM S-MH2001125		
DISTANCE	DIAMETER	CLOCK
8.4	150	2:00
9.8	150	10:00

**WARNING**

IF POWER EQUIPMENT OR EXPLOSIVES ARE TO BE USED FOR EXCAVATION ON THIS PROJECT THE CONTRACTOR MUST:  
 1) NOTIFY THE GAS COMPANY OF THE PROPOSED LOCATION OF EXCAVATION.  
 2) TAKE PRECAUTION TO AVOID DAMAGE TO GAS COMPANY INSTALLATIONS.  
 SEE PROVINCIAL REGULATION 140/92 FOR DETAILS

**ENGINEERS  
GEOSCIENTISTS  
MANITOBA**  
 Certificate of Authorization  
 Stantec Consulting Ltd.  
 No. 1301

FOR INDEX SEE  
13826

TENDER NO. 1137-2025



**METRIC**

WHOLE NUMBERS INDICATE MILLIMETRES  
DECIMALIZED NUMBERS INDICATE METRES

**LOCATION APPROVED UNDERGROUND STRUCTURES**

SUPV. U/G STRUCTURES COMMITTEE DATE

**NOTE:**  
 LOCATION OF UNDERGROUND STRUCTURES AS SHOWN ARE BASED ON THE BEST INFORMATION AVAILABLE BUT NO GUARANTEE IS GIVEN THAT ALL EXISTING UTILITIES ARE SHOWN OR THAT THE GIVEN LOCATIONS ARE EXACT. CONFIRMATION OF EXISTENCE AND EXACT LOCATION OF ALL SERVICES MUST BE OBTAINED FROM THE INDIVIDUAL UTILITIES BEFORE PROCEEDING WITH CONSTRUCTION.

NO.	REVISIONS	DATE	BY
1	REVISED FOR TENDER ADDENDUM 2	26.03.26	NK
0	ISSUED FOR CONSTRUCTION	26.03.04	NK

**Stantec**  
 311 Portage Avenue, Winnipeg, Manitoba  
 Tel 204-489-5900 Fax 204-453-9012

DESIGNED BY	NK	CHECKED BY	RS
DRAWN BY	MR	APPROVED BY	NK
HOR. SCALE:	1:750	RELEASED FOR CONSTRUCTION:	S. COURNOYER, P. ENG.
VERTICAL:		DATE	26.03.03
DATE	26.02.13		

ENGINEER'S SEAL  
  
 CONSULTANT DRAWING NO.  
**C-135**

**THE CITY OF WINNIPEG**  
 WATER AND WASTE DEPARTMENT

**2025 SEWER MAIN RENEWALS BY CIPP LINING**  
 CONTRACT 4  
**ROSS AVENUE**  
 2ND MH W OF JUBA STREET TO  
 3RD MH W OF JUBA STREET

SHEET	OF
<b>37</b>	<b>48</b>
CAD FILE DRAWING NUMBER <b>20976c-132-139.dwg</b>	
CITY DRAWING NUMBER <b>13861</b>	