
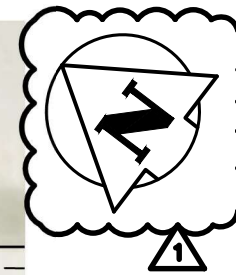


ST ANNES ROAD

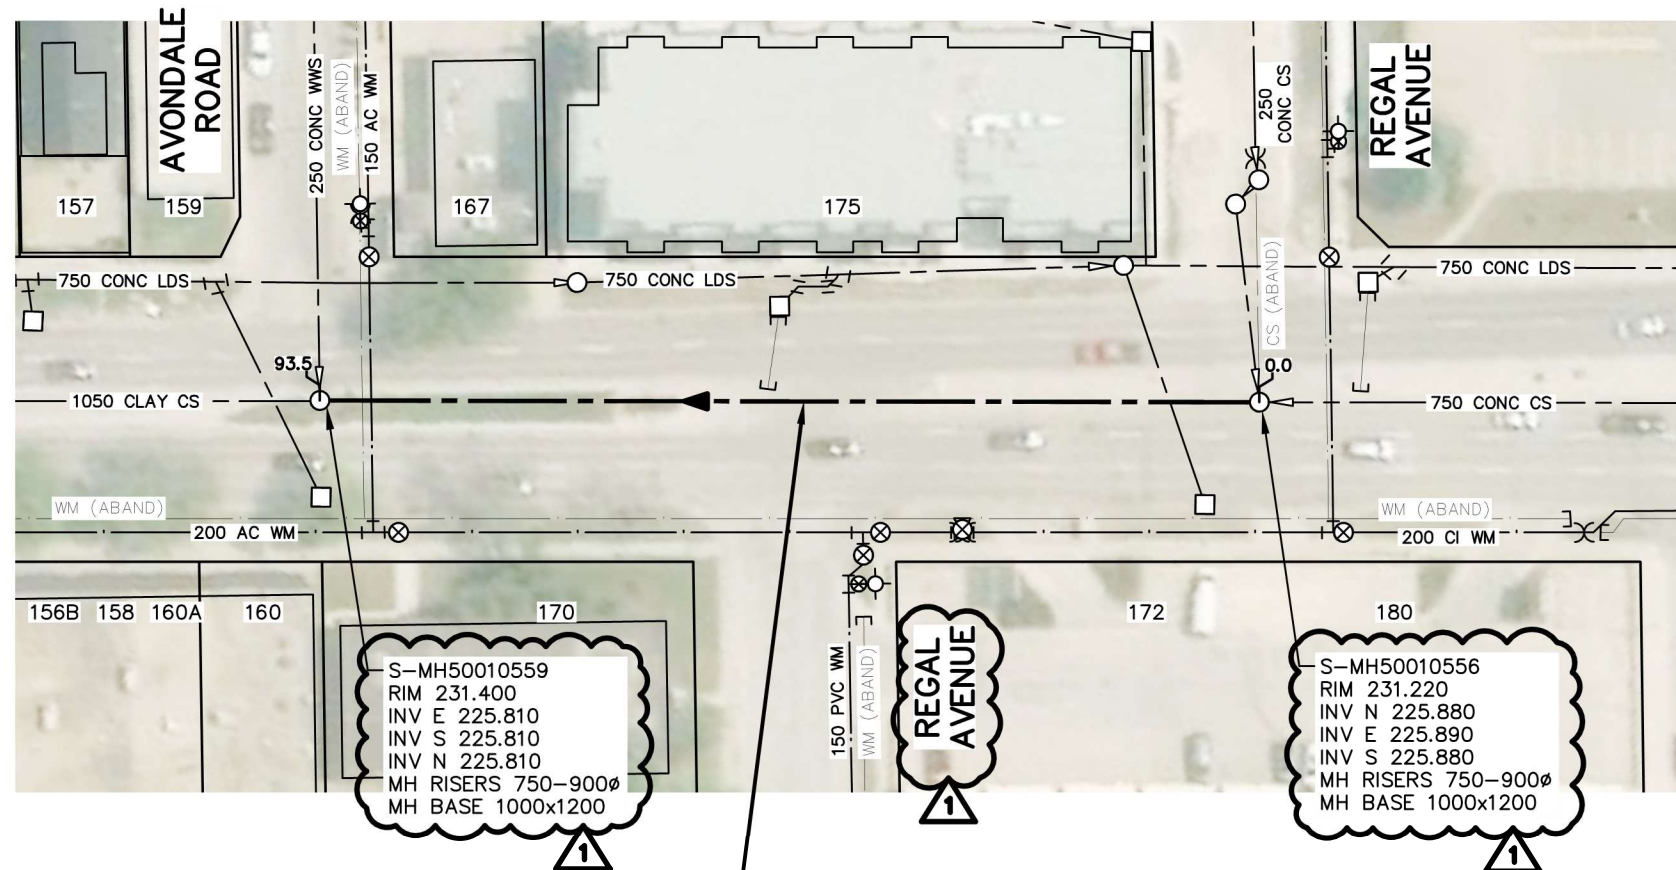

SEWER JUNCTION INFORMATION FROM SEWER VIDEO INSPECTION		
SEWER ID S-MA50013522		
DISTANCE FROM S-MH50010556		
DISTANCE	DIAMETER	CLOCK
15.8	150	10:00
32.1	150	1:00
48.9	150	1:00
60.1	150	1:00
77.5	150	11:00
80.6	150	1:00
92.0	250	3:00

93.5 OF 900 CLAY CS TO BE LINED S-MA50013522 (FULLY DETERIORATED)

WARNING

IF POWER EQUIPMENT OR EXPLOSIVES ARE TO BE USED FOR EXCAVATION ON THIS PROJECT THE CONTRACTOR MUST:
 1) NOTIFY THE GAS COMPANY OF THE PROPOSED LOCATION OF EXCAVATION.
 2) TAKE PRECAUTION TO AVOID DAMAGE TO GAS COMPANY INSTALLATIONS.
 SEE PROVINCIAL REGULATION 140/92 FOR DETAILS

ENGINEERS GEOSCIENTISTS MANITOBA
 Certificate of Authorization
 Stantec Consulting Ltd.
 No. 1301

FOR INDEX SEE 13826

TENDER NO. 1137-2025



METRIC

WHOLE NUMBERS INDICATE MILLIMETRES
 DECIMALIZED NUMBERS INDICATE METRES

LOCATION APPROVED UNDERGROUND STRUCTURES

SUPV. U/G STRUCTURES COMMITTEE DATE

NOTE:
 LOCATION OF UNDERGROUND STRUCTURES AS SHOWN ARE BASED ON THE BEST INFORMATION AVAILABLE BUT NO GUARANTEE IS GIVEN THAT ALL EXISTING UTILITIES ARE SHOWN OR THAT THE GIVEN LOCATIONS ARE EXACT. CONFIRMATION OF EXISTENCE AND EXACT LOCATION OF ALL SERVICES MUST BE OBTAINED FROM THE INDIVIDUAL UTILITIES BEFORE PROCEEDING WITH CONSTRUCTION.

NO.	REVISIONS	DATE	BY
1	REVISED FOR TENDER ADDENDUM 2	26.03.26	NK
0	ISSUED FOR CONSTRUCTION	26.03.04	NK

Stantec
 311 Portage Avenue, Winnipeg, Manitoba
 Tel 204-489-5900 Fax 204-453-9012

DESIGNED BY	NK	CHECKED BY	RS
DRAWN BY	MR	APPROVED BY	NK
HOR. SCALE:	1:750	RELEASED FOR CONSTRUCTION:	S. COURNOYER, P. ENG.
VERTICAL:		DATE	26.03.03
DATE	26.02.13		

ENGINEER'S SEAL

 CONSULTANT DRAWING NO. C-136

THE CITY OF WINNIPEG
 WATER AND WASTE DEPARTMENT

2025 SEWER MAIN RENEWALS BY CIPP LINING
 CONTRACT 4
ST ANNES ROAD
 MH AT AVONDALE ROAD TO
 MH AT REGAL AVENUE

SHEET	OF
38	48
CAD FILE DRAWING NUMBER	
20976c-132-139.dwg	
CITY DRAWING NUMBER	
13862	