
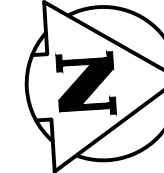


# ST DAVID PLACE (W LEG)

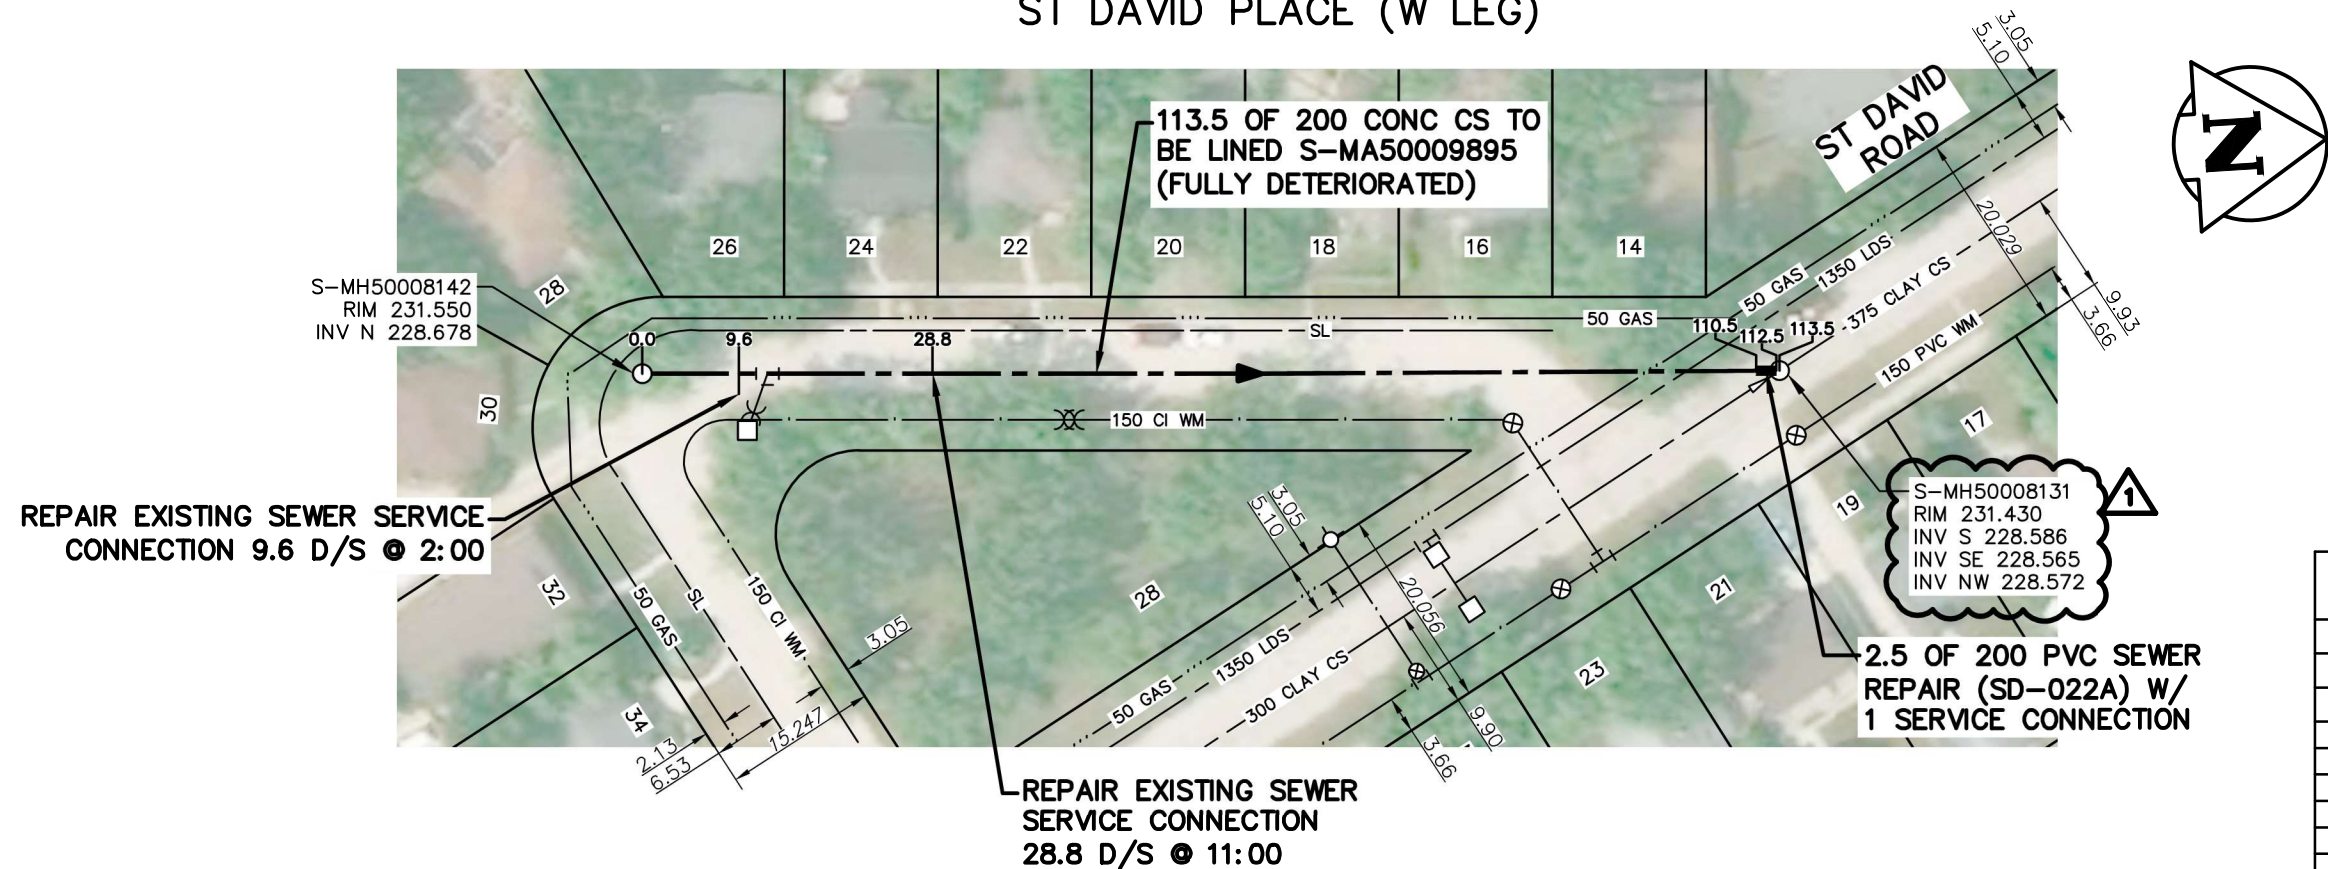

SEWER JUNCTION INFORMATION FROM SEWER VIDEO INSPECTION		
SEWER ID S-MA50009895		
DISTANCE FROM S-MH50008142		
DISTANCE	DIAMETER	CLOCK
1.8	150	9:00
3.3	150	9:00
5.6	150	10:00
8.0	150	9:00
9.6	150	2:00
11.9	150	9:00
26.4	150	9:00
28.8	150	11:00
43.4	150	9:00
62.9	150	9:00
77.8	150	9:00
89.7	150	9:00
112.2	250	9:00

## WARNING

IF POWER EQUIPMENT OR EXPLOSIVES ARE TO BE USED FOR EXCAVATION ON THIS PROJECT THE CONTRACTOR MUST:

- 1) NOTIFY THE GAS COMPANY OF THE PROPOSED LOCATION OF EXCAVATION.
- 2) TAKE PRECAUTION TO AVOID DAMAGE TO GAS COMPANY INSTALLATIONS.

SEE PROVINCIAL REGULATION 140/92 FOR DETAILS

**ENGINEERS GEOSCIENTISTS MANITOBA**  
Certificate of Authorization  
Stantec Consulting Ltd.  
No. 1301

FOR INDEX SEE 13826  
TENDER NO. 1137-2025



## METRIC

WHOLE NUMBERS INDICATE MILLIMETRES  
DECIMALIZED NUMBERS INDICATE METRES

### LOCATION APPROVED UNDERGROUND STRUCTURES

SUPV. U/G STRUCTURES COMMITTEE DATE

NOTE:  
LOCATION OF UNDERGROUND STRUCTURES AS SHOWN ARE BASED ON THE BEST INFORMATION AVAILABLE BUT NO GUARANTEE IS GIVEN THAT ALL EXISTING UTILITIES ARE SHOWN OR THAT THE GIVEN LOCATIONS ARE EXACT. CONFIRMATION OF EXISTENCE AND EXACT LOCATION OF ALL SERVICES MUST BE OBTAINED FROM THE INDIVIDUAL UTILITIES BEFORE PROCEEDING WITH CONSTRUCTION.

NO.	REVISIONS	DATE	BY
1	REVISED FOR TENDER ADDENDUM 2	26.03.26	NK
0	ISSUED FOR CONSTRUCTION	26.03.04	NK

**Stantec**  
311 Portage Avenue, Winnipeg, Manitoba  
Tel 204-489-5900 Fax 204-453-9012

DESIGNED BY	NK	CHECKED BY	RS
DRAWN BY	MR	APPROVED BY	NK
HOR. SCALE:	1:750	RELEASED FOR CONSTRUCTION:	S. COURNOYER, P. ENG.
VERTICAL:		DATE	26.03.03
DATE	26.02.13		

ENGINEER'S SEAL  
N. J. KEHLER  
Member 30100  
REGISTERED PROFESSIONAL ENGINEER  
2026-03-27  
CONSULTANT DRAWING NO. C-137

**THE CITY OF WINNIPEG**  
WATER AND WASTE DEPARTMENT

2025 SEWER MAIN RENEWALS BY CIPP LINING  
CONTRACT 4  
**ST DAVID PLACE (W LEG)**  
MH AT ST DAVID PLACE (S LEG) TO  
MH AT ST DAVID ROAD

SHEET	OF
<b>39</b>	<b>48</b>
CAD FILE DRAWING NUMBER	
<b>20976c-132-139.dwg</b>	
CITY DRAWING NUMBER	
<b>13863</b>	