WALLER AVENUE
(S OF C/L)

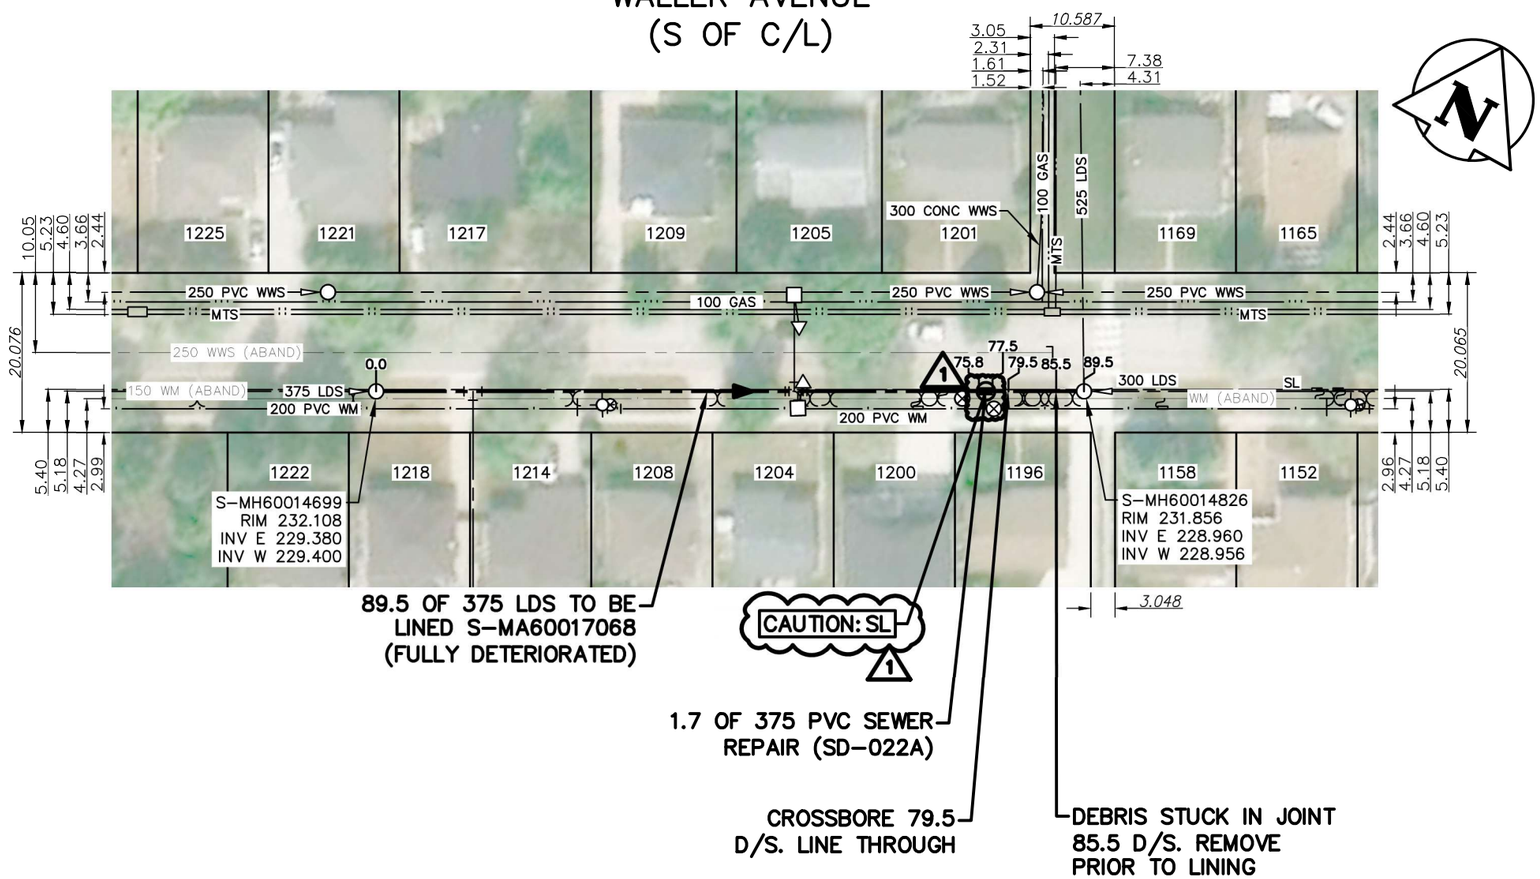

SEWER JUNCTION INFORMATION FROM SEWER VIDEO INSPECTION		
SEWER ID S-MA60017068		
DISTANCE FROM S-MH60014699		
DISTANCE	DIAMETER	CLOCK
13.2	250	2:00
52.7	200	2:00
53.3	200	10:00

WARNING

IF POWER EQUIPMENT OR EXPLOSIVES ARE TO BE USED FOR EXCAVATION ON THIS PROJECT THE CONTRACTOR MUST:

1) NOTIFY THE GAS COMPANY OF THE PROPOSED LOCATION OF EXCAVATION.

2) TAKE PRECAUTION TO AVOID DAMAGE TO GAS COMPANY INSTALLATIONS.

SEE PROVINCIAL REGULATION 140/92 FOR DETAILS

ENGINEERS GEOSCIENTISTS MANITOBA
Certificate of Authorization
Stantec Consulting Ltd.
No. 1301

FOR INDEX SEE 13826

TENDER NO. 1137-2025

1:750 0 7.5 22.5 37.5m

METRIC

WHOLE NUMBERS INDICATE MILLIMETRES
DECIMALIZED NUMBERS INDICATE METRES

LOCATION APPROVED
UNDERGROUND STRUCTURES

SUPV. U/G STRUCTURES COMMITTEE — DATE

NOTE:

LOCATION OF UNDERGROUND STRUCTURES AS SHOWN ARE BASED ON THE BEST INFORMATION AVAILABLE BUT NO GUARANTEE IS GIVEN THAT ALL EXISTING UTILITIES ARE SHOWN OR THAT THE GIVEN LOCATIONS ARE EXACT. CONFIRMATION OF EXISTENCE AND EXACT LOCATION OF ALL SERVICES MUST BE OBTAINED FROM THE INDIVIDUAL UTILITIES BEFORE PROCEEDING WITH CONSTRUCTION.

B.M. ELEV.

NO.	REVISIONS	DATE	BY
1	REVISED FOR TENDER ADDENDUM 2	26.03.26	NK
0	ISSUED FOR CONSTRUCTION	26.03.04	NK

Stantec
311 Portage Avenue, Winnipeg, Manitoba
Tel 204-489-5900 Fax 204-453-9012

DESIGNED BY	NK	CHECKED BY	RS
DRAWN BY	MR	APPROVED BY	NK
HOR. SCALE:	1:750	RELEASED FOR CONSTRUCTION:	
VERTICAL:		S. COURNOYER, P. ENG.	
DATE	26.02.13	DATE	26.03.03

ENGINEER'S SEAL
PROVINCE OF MANITOBA
N. J. KEHLER
Member 30100
REGISTERED PROFESSIONAL ENGINEER
2026-03-27

CONSULTANT DRAWING NO.
C-140

Winnipeg
THE CITY OF WINNIPEG
WATER AND WASTE DEPARTMENT

2025 SEWER MAIN RENEWALS BY CIPP LINING
CONTRACT 4
WALLER AVENUE (S OF C/L)
1ST MH E OF DONNELLY STREET TO
2ND MH E OF DONNELLY STREET

SHEET 42 OF 48
CAD FILE DRAWING NUMBER 20976c-140-146.dwg
CITY DRAWING NUMBER 13866

BID OPPORTUNITY: 1137-2025
CONTRACT NUMBER: 4
FILE PATH: C:\Users\gbandekar\DC\ACCDocs\Stantec Consulting\111220976_C4_CoW_2025_CIPP\Project Files\01_wip\04_civil\sheet_files\
FILE NAME: 20976c-140-146.dwg