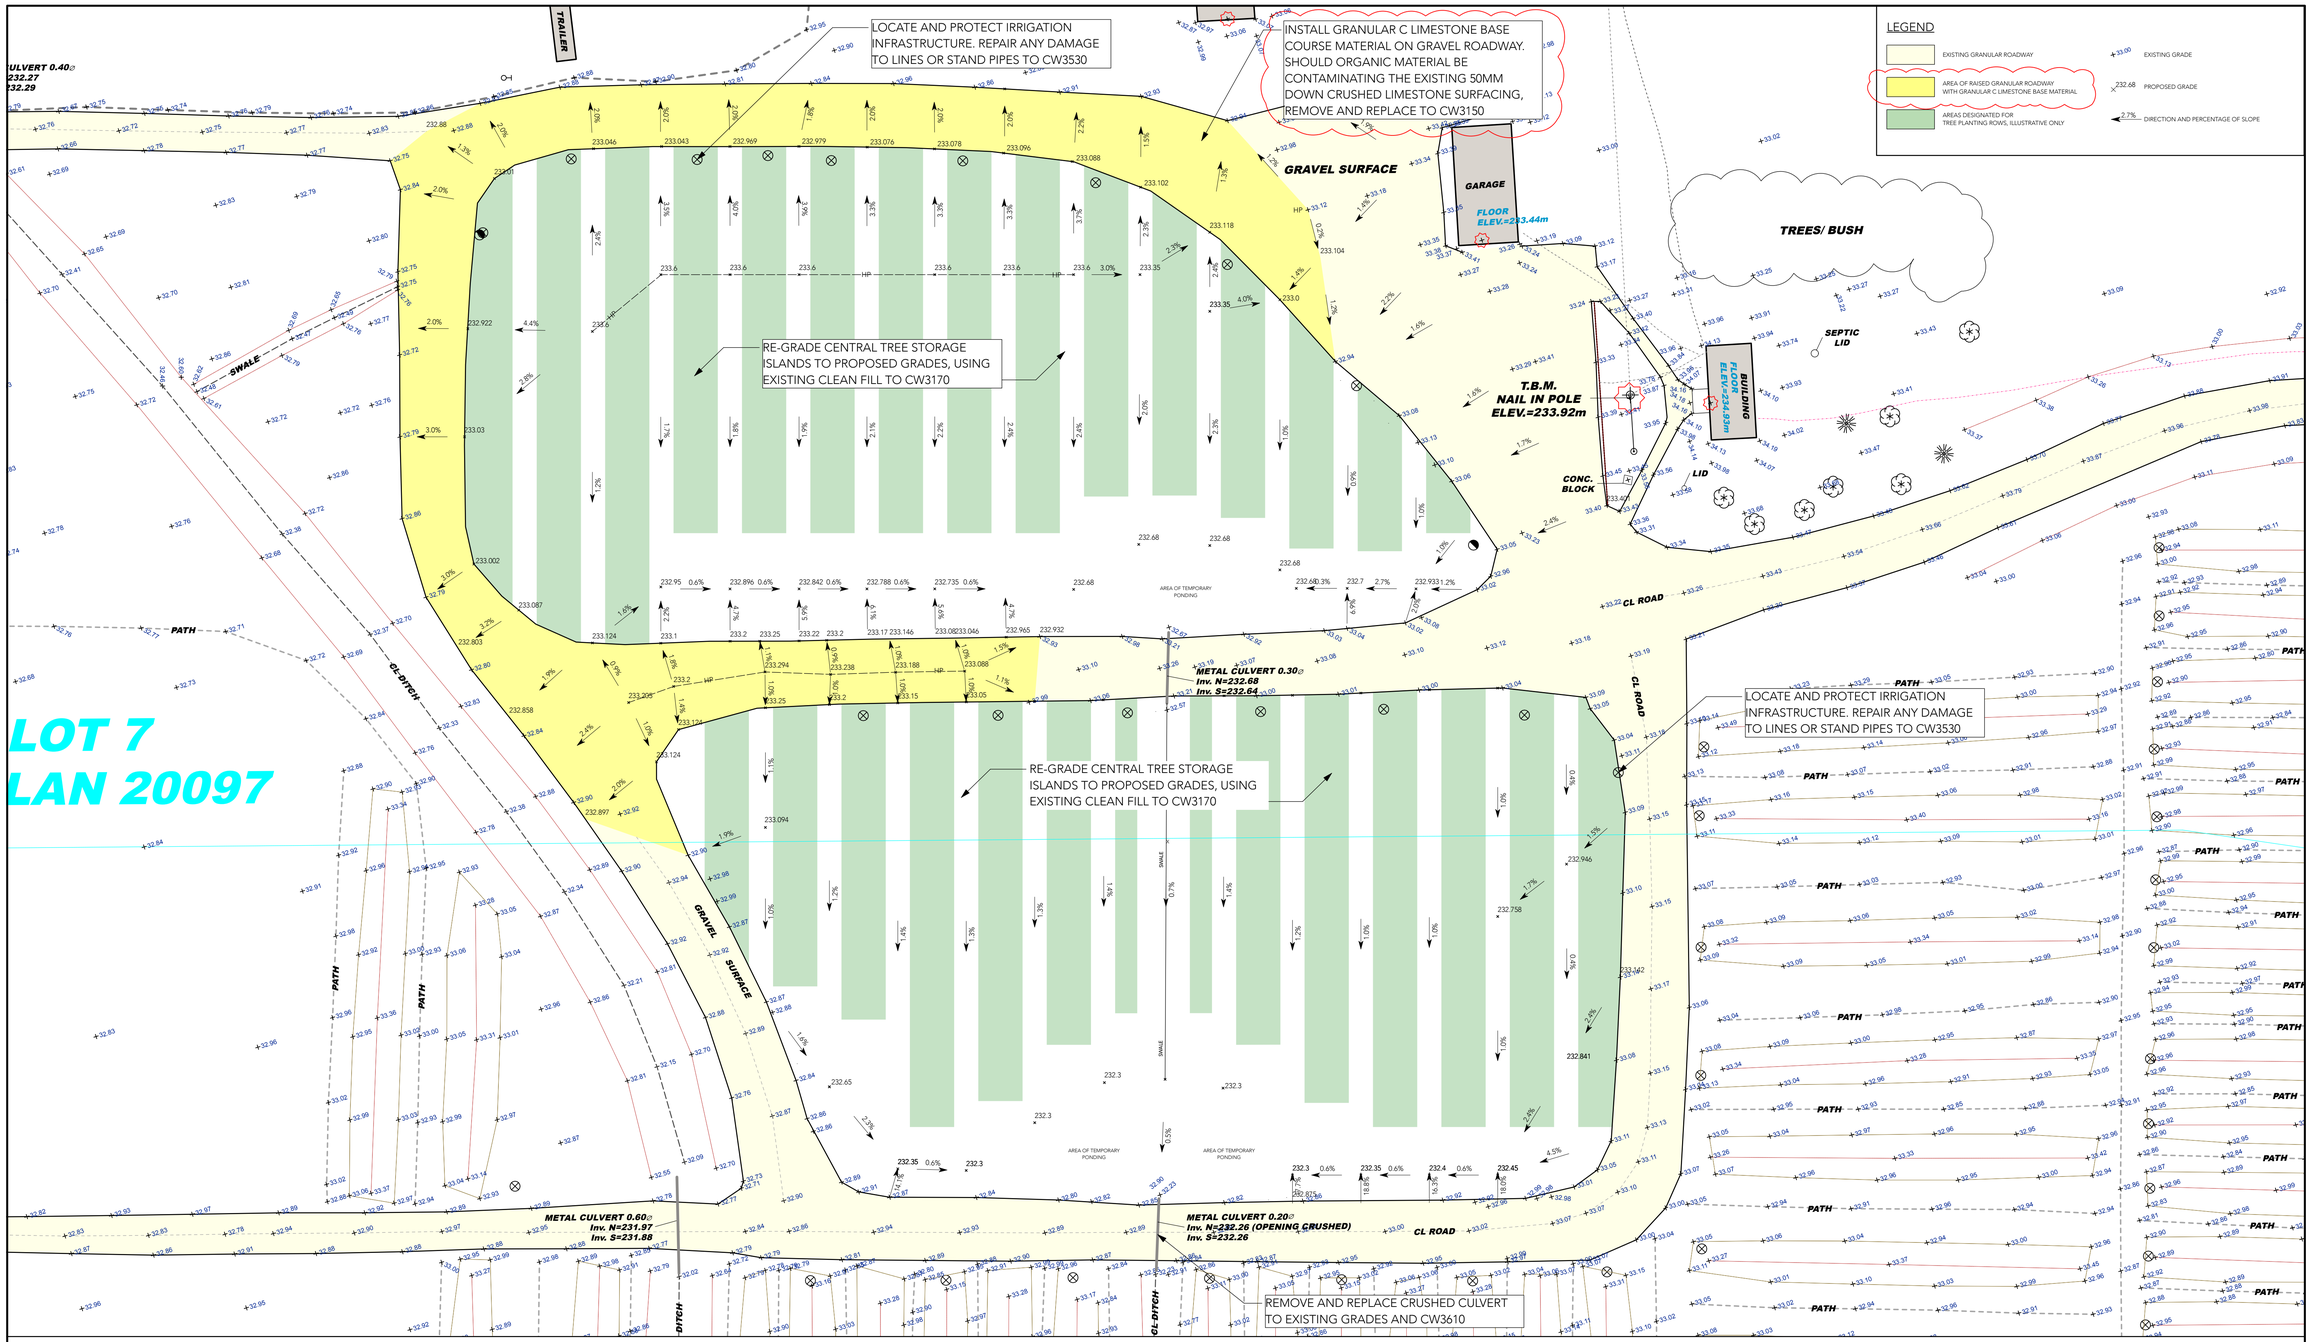

© DWAsitework Inc. All rights reserved. All drawings are conceptual in nature. It is to be clearly understood that the author, in producing said drawings, shall not be liable for any and all loss, damage or injury that may result from the use of the drawings, whether such loss, damage or injury is suffered by the Owner or any other person or persons subsequent to the project being constructed and use commencing on the site, whether such claims are brought by persons using the site, or by the owners or others of neighbouring properties.

Should any claim be made directly against the author as a result of the drawings themselves, or as a result of the way in which the project is constructed in accordance with those drawings, or as a result of any loss, injury or damage, the Owners shall indemnify the author, and the author shall be released from any claim, whatever it may be to be indemnified by the Owners in full, including the costs of defending any actions brought against the author, or the costs of paying any settlement entered into by the author, or setting any judgments made against the author.

No reproductions may be made without the permission of the Landscape Architect and when made, must bear his / her name. Any and all designs herein are the IP property of the Landscape Architect. If stamped and dated, the designs herein are licenced for construction, once only. All prints to be returned to the Landscape Architect on request.

This drawing shall not be used for building purposes until countersigned by the Landscape Architect.

The contractor shall check all dimensions and other data on site and report any discrepancies to the Landscape Architect.

Figured dimensions to be taken in preference to scaled dimensions. If in doubt please ask.

Location of underground structures as shown are based on the best information available but no guarantee is given that all existing utilities are shown or that the given locations are exact. Confirmation of existence and exact location of all services must be obtained from the individual utilities before proceeding with construction.

DO NOT SCALE DRAWING - PLOT MAY NOT BE AT 100%

DWASITEWORK

manitoba association of landscape architects
Elizabeth Christiansen
ELIZABETH CHRISTIANSEN
Member No. 158
FEBRUARY 4, 2025

Winnipeg

NO.	REVISION / NOTE	DATE	BY
8			
7			
6			
5			
4			
3			
2			
1	REVISED NOTATIONS	02/18/25	EC
0	RELEASED FOR TENDER	02/04/25	EC

PROJECT
SITE DRAINAGE IMPROVEMENTS
CIVIC TREE NURSERY
4027 PEMBINA HIGHWAY
WINNIPEG, MB R3V 1X5

SCALE 1:500
DATE FEBRUARY 4, 2025
DRAWN BY EC
CHECKED BY EC
PROJECT NO. 24028

DRAWING TITLE
DEVELOPMENT & GRADING PLAN

SHEET NO.
L-003-R1