


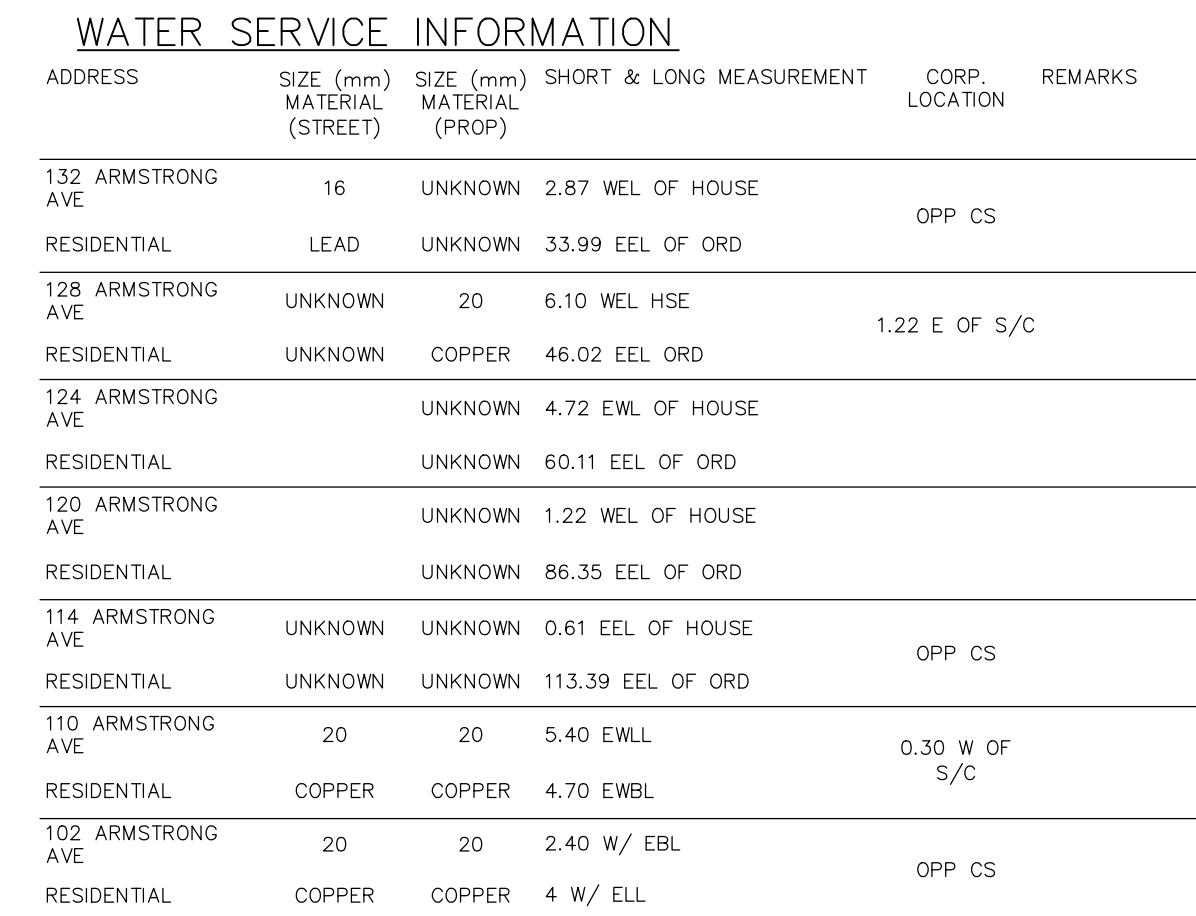

FOR INDEX SEE
D-17246

NOTE: ALL VALVES TO BE INSTALLED COUNTERCLOCKWISE TO CLOSE

