


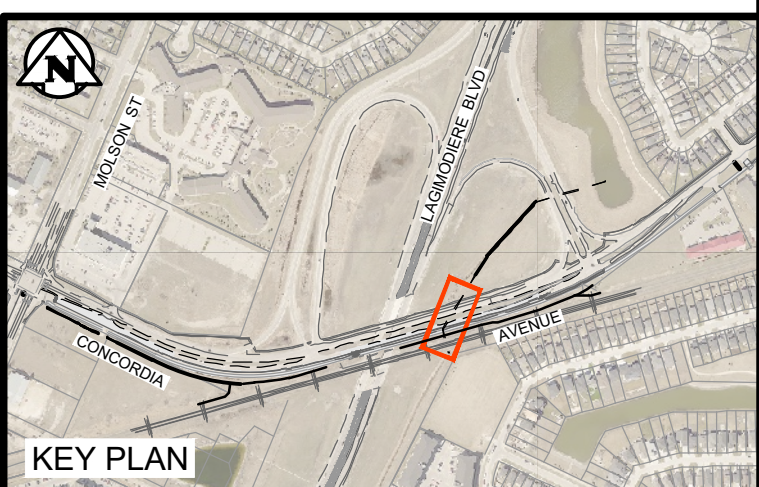

WHOLE NUMBERS INDICATE MILLIMETRES
DECIMALIZED NUMBERS INDICATE METRES



LOCATION APPROVED UNDERGROUND STRUCTURES				 TETRA TECH				ORIGINAL DRAWING REVISION "0" SEALED BY I.J. MAHARAJ 25.08.07				 THE CITY OF WINNIPEG PUBLIC WORKS DEPARTMENT ENGINEERING DIVISION			
SUPV. U/G STRUCTURES COMMITTEE				DATE				MAJOR REHABILITATION OF LAGIMODIERE TWIN OVERPASSES (OVER CONCORDIA AVE. & CPR KEEWATIN)				CITY DRAWING NUMBER P123-25-3007			
NOTE: LOCATION OF UNDERGROUND STRUCTURES AS SHOWN ARE BASED ON THE BEST INFORMATION AVAILABLE BUT NO GUARANTEE IS GIVEN THAT ALL EXISTING UTILITIES ARE SHOWN OR THAT THE GIVEN LOCATIONS ARE EXACT. LOCATION OF EXISTENCE AND EXACT LOCATION OF ALL SERVICES MUST BE OBTAINED FROM THE INDIVIDUAL UTILITIES BEFORE PROCEEDING WITH CONSTRUCTION.				DESIGNED BY IJM				REVIEWED BY TRC				SHEET 7 OF 14			
DRAWN BY NL				APPROVED BY KJM				SCALE: HOR 1 : 250 VER 1 : 50				ACCEPTED BY DATE CAM WARD, P.ENG. 25.08.07			
1 ISSUED FOR ADDENDUM 5 25.09.22 IJM				0 ISSUED FOR TENDER 25.08.07 IJM				CONSULTANT DRAWING NO. 704-INF-MB103007-01-DWG-C3007				DRAINAGE WORKS PROPOSED CSP CULVERTS AT CONCORDIA AVE STA 1+000 TO 1+110			
NO. REVISIONS				DATE BY				DATE 25.08.07				3007			