



CONSTRUCTION NOTES:

- ALL WORKS TO BE CONSTRUCTED IN ACCORDANCE WITH THE LATEST REVISION OF THE CITY OF WINNIPEG STANDARD CONSTRUCTION SPECIFICATIONS AND THE SPECIFICATIONS FOR THIS CONTRACT.
- THE CONTRACTOR IS RESPONSIBLE FOR CONTACTING UTILITY COMPANIES AND ARRANGING FOR LOCATES FOR ALL UNDERGROUND INFRASTRUCTURE AND SAFETY WATCHES DURING CONSTRUCTION. LOCATES SHOULD BE UNDERTAKEN PRIOR TO CONSTRUCTION.
- LOCATION OF EXISTING UTILITIES/SERVICES TO BE CONFIRMED IN THE FIELD BY THE CONTRACTOR.
- THE CONTRACTOR IS RESPONSIBLE FOR THE CONTROL OF RUNOFF FROM RAINFALL, SNOWMELT, GROUNDWATER, INFRASTRUCTURE OR EQUIPMENT DURING ALL STAGES OF THE PROJECT.
- CONTRACTOR TO TAKE PRECAUTIONARY STEPS TO AVOID DAMAGE FROM CONSTRUCTION ACTIVITIES TO TREES WITHIN THE LIMITS OF CONSTRUCTION.
- TRENCHES AND EXCAVATIONS WITHIN 1 METRE OF A PAVED AREA INCLUDING SIDEWALKS SHALL BE CLASS 3 BACKFILL.
- ANY RESTORATION OF PAVEMENT CUTS MUST ADHERE TO THE PAVEMENT RESTORATION GUIDELINES IN THE MOST RECENT EDITION OF THE CITY OF WINNIPEG'S STREET CUTS MANUAL.
- THE CONTRACTOR IS RESPONSIBLE FOR ALL INCIDENTAL EROSION CONTROL MEASURES.

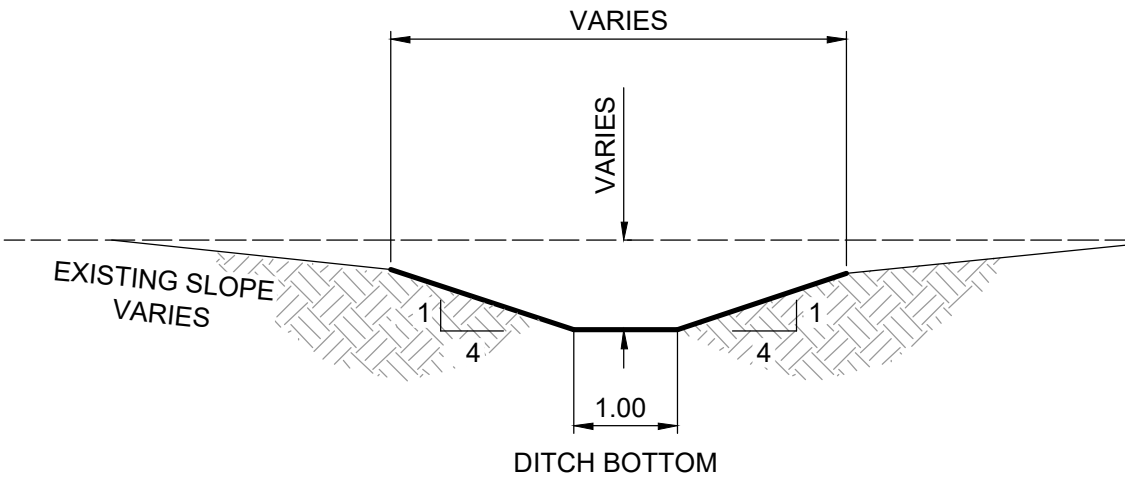

1 DITCH SECTION
N.T.S.


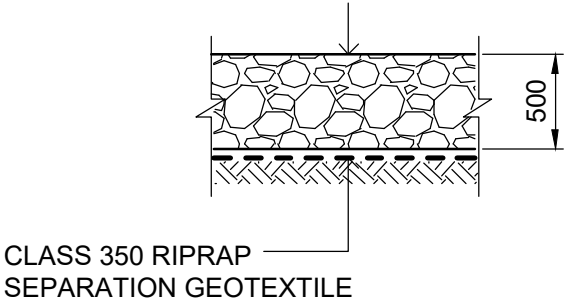


2 RIPRAP SECTION
1:40

METRIC
WHOLE NUMBERS INDICATE MILLIMETRES
DECIMALIZED NUMBERS INDICATE METRES



Certificate of Authorization
Tetra Tech Canada Inc.
No. 6499

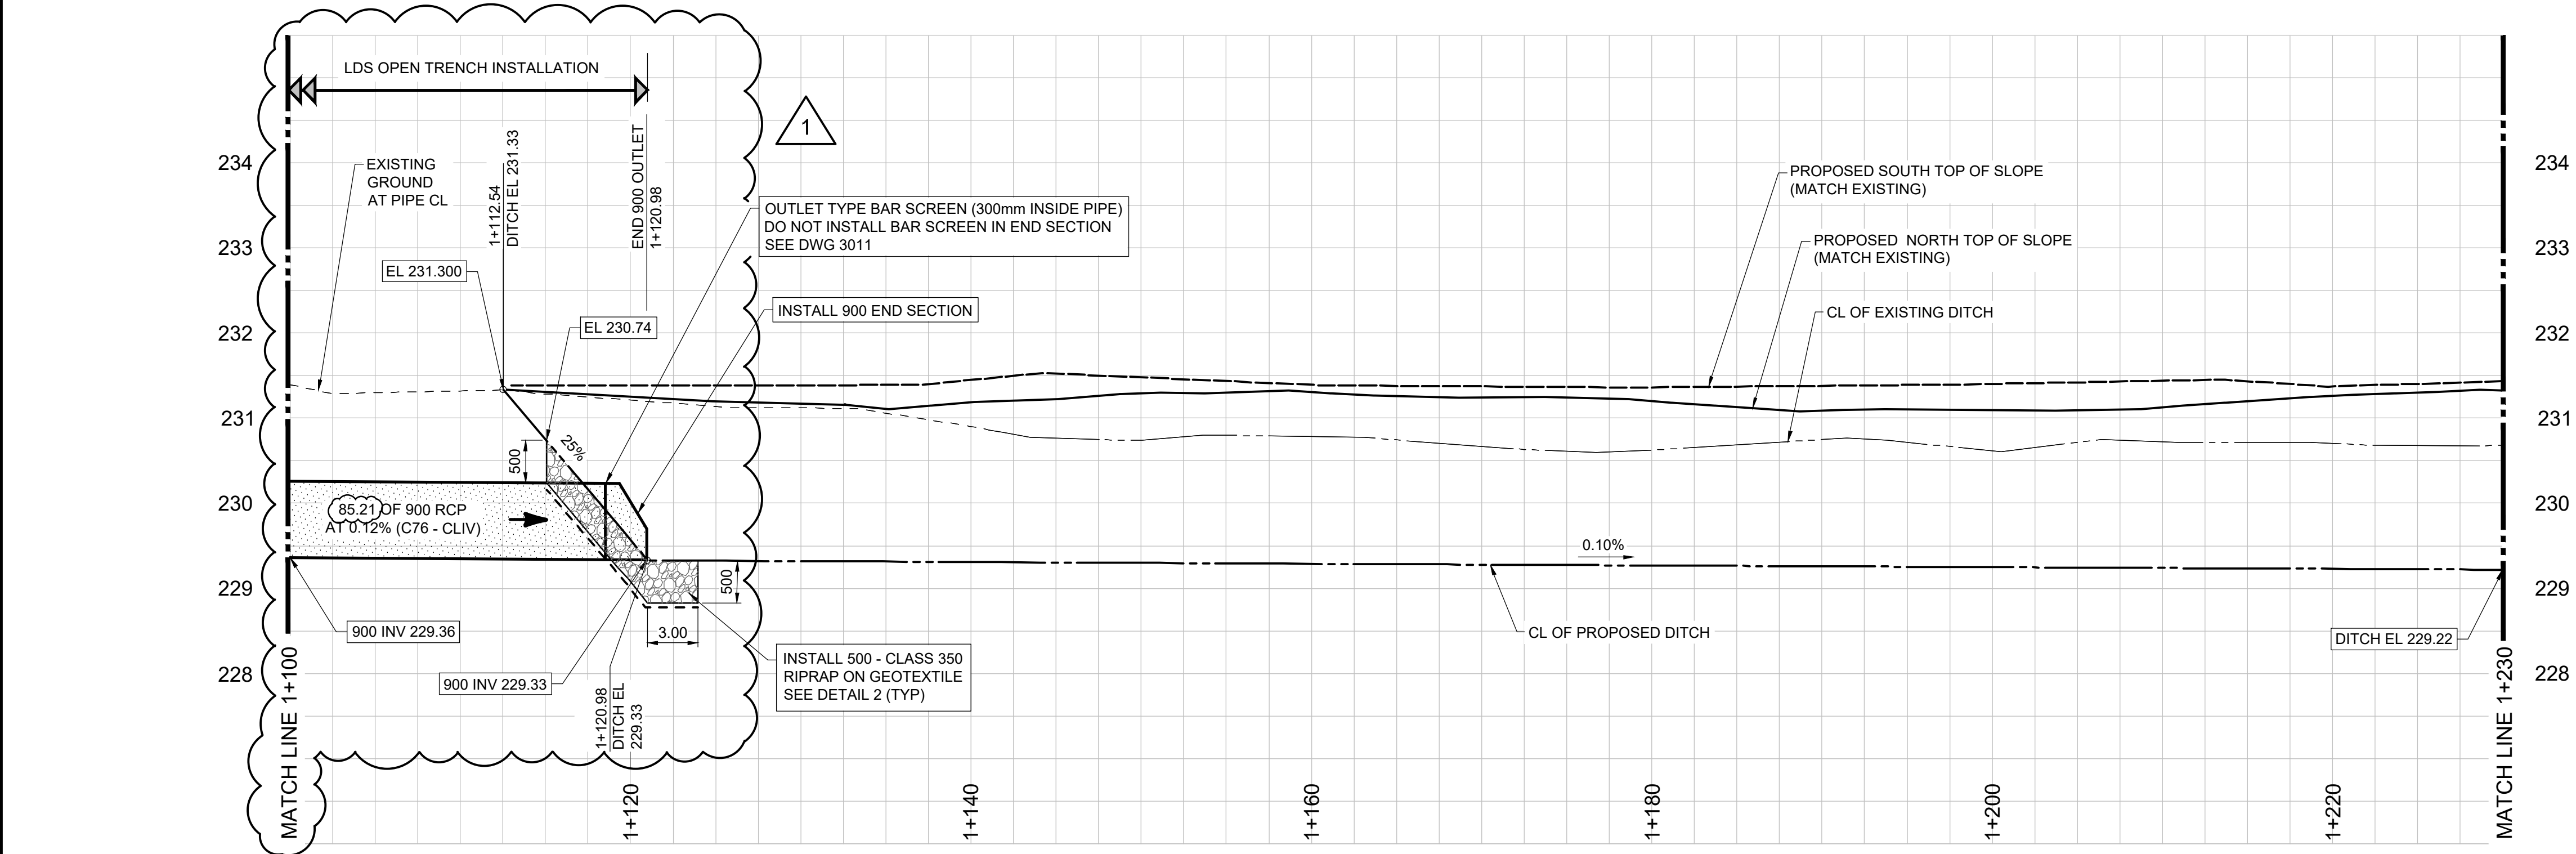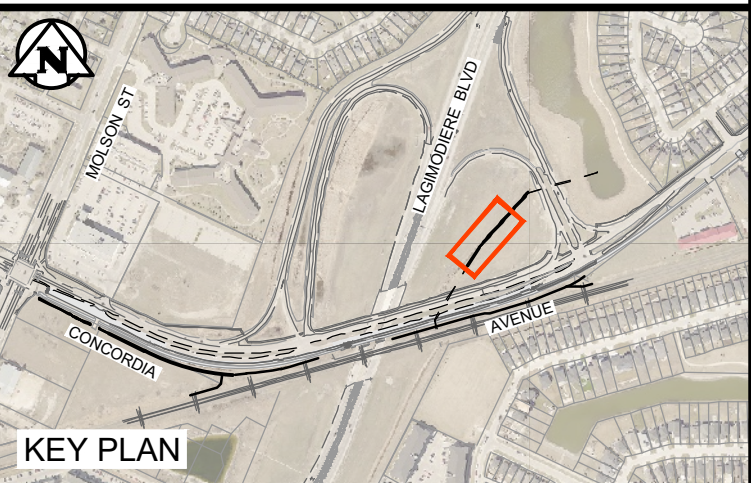

*CAUTION
EXACT LOCATIONS OF EXISTING UTILITIES
AT TIME OF DESIGN UNKNOWN.
CONTRACTOR TO LOCATE ALL CONNECTIONS AND
UTILITIES PRIOR TO CONSTRUCTION.
ALIGNMENTS OF PROPOSED SEWERS ARE
SUBJECT TO CHANGE DUE TO CONFLICTS.

