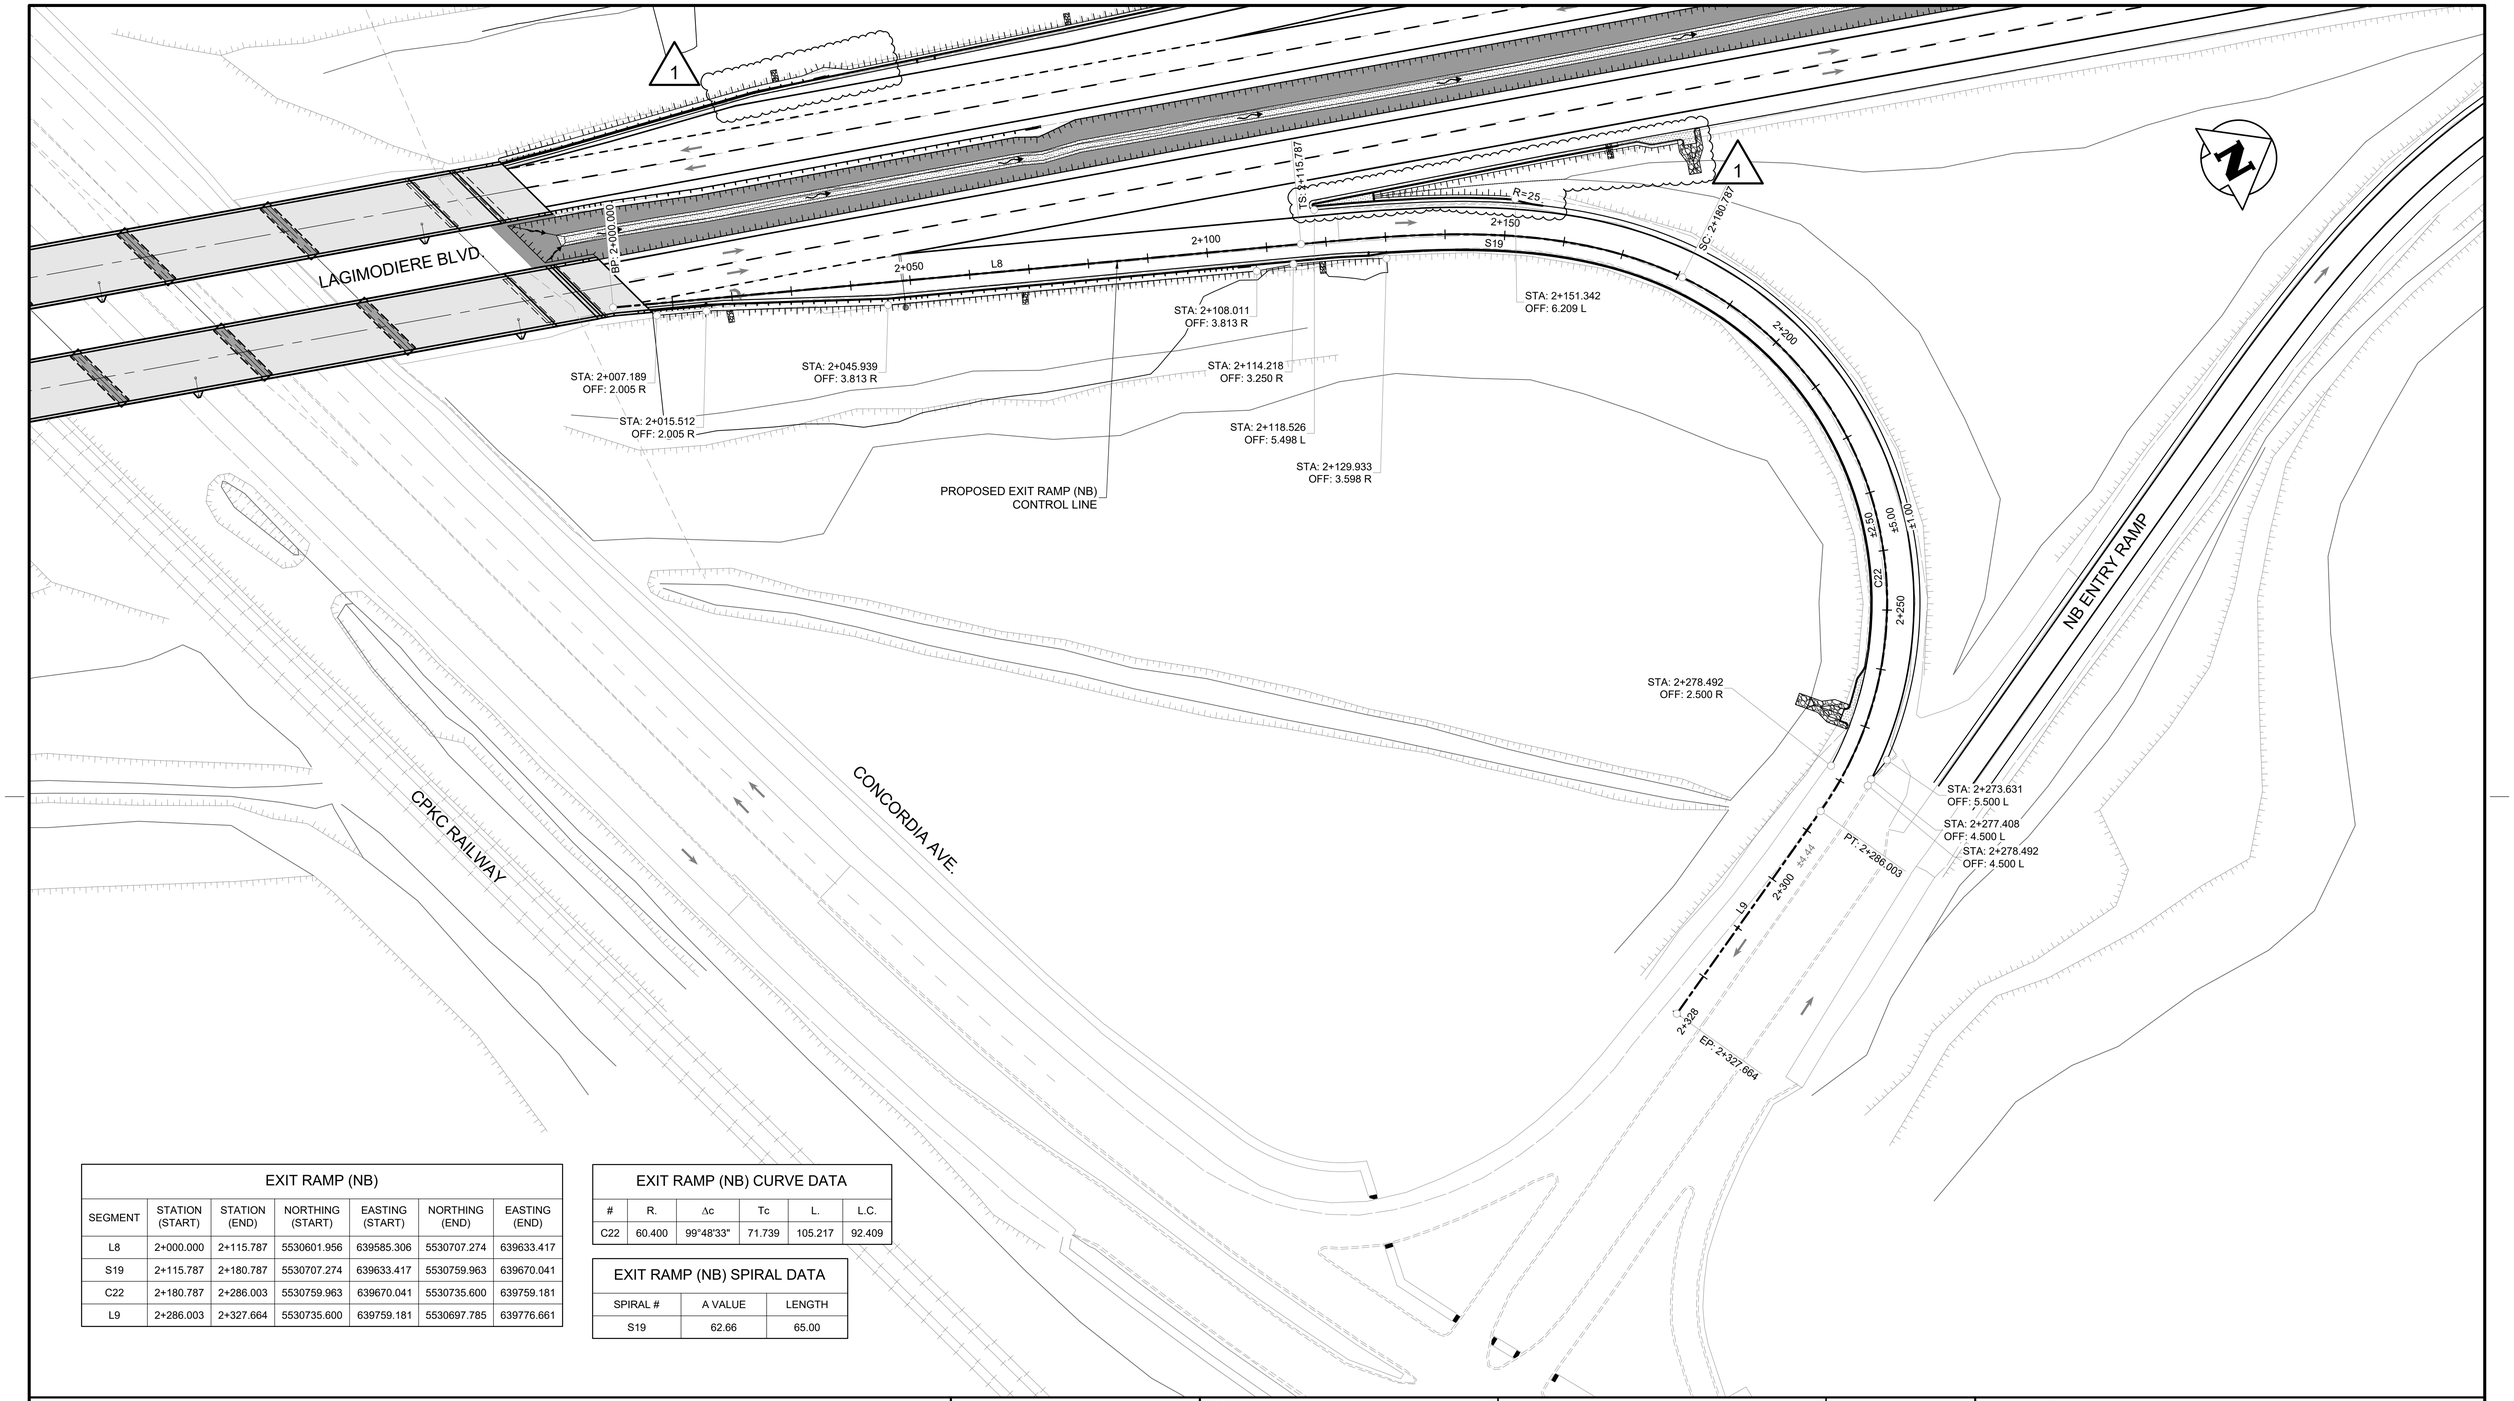

EXIT RAMP (NB)						
SEGMENT	STATION (START)	STATION (END)	NORTHING (START)	EASTING (START)	NORTHING (END)	EASTING (END)
L8	2+000.000	2+115.787	5530601.956	639585.306	5530707.274	639633.417
S19	2+115.787	2+180.787	5530707.274	639633.417	5530759.963	639670.041
C22	2+180.787	2+286.003	5530759.963	639670.041	5530735.600	639759.181
L9	2+286.003	2+327.664	5530735.600	639759.181	5530697.785	639776.661

EXIT RAMP (NB) CURVE DATA					
#	R.	Δc	Tc	L.	L.C.
C22	60.400	99°48'33"	71.739	105.217	92.409

EXIT RAMP (NB) SPIRAL DATA		
SPIRAL #	A VALUE	LENGTH
S19	62.66	65.00

ENGINEERS GEOSCIENTISTS MANITOBA
Certificate of Authorization
Tetra Tech Canada Inc.
No. 6499

UNDERGROUND STRUCTURES

LOCATION OF UNDERGROUND STRUCTURES AS SHOWN ARE BASED ON THE BEST INFORMATION AVAILABLE, BUT NO GUARANTEE IS GIVEN THAT ALL EXISTING UTILITIES ARE SHOWN OR THAT THE GIVEN LOCATIONS ARE EXACT. CONFIRMATION OF EXISTENCE AND EXACT LOCATION OF ALL SERVICES MUST BE OBTAINED FROM THE INDIVIDUAL UTILITIES BEFORE PROCEEDING WITH CONSTRUCTION.

B.M.
ELEV.

NO.	REVISIONS	DATE	BY
1	ISSUED FOR ADDENDUM 5	25.09.22	JNC
0	ISSUED FOR TENDER	25.08.07	JNC

TETRA TECH

DESIGNED BY	EF	REVIEWED BY	JT
DRAWN BY	EF	APPROVED BY	JNC
SCALE:	1:250	ACCEPTED BY / DATE	CAM WARD, P.ENG. 25.08.07
DATE	25.08.07		

ORIGINAL DRAWING
REVISION " 0 " SEALED BY
J.N. CRANG
25.08.07

CONSULTANT DRAWING NO.
734-INF.MBI03007.01-DWG-C4109

Winnipeg
THE CITY OF WINNIPEG
PUBLIC WORKS DEPARTMENT

LAGIMODIERE TWIN OVERPASSES
OVER CPKC KEEWATIN
REHABILITATION AND RELATED WORKS

CITY DRAWING NUMBER
P123-25-4109
SHEET 9 OF 12

CONTROL LINE GEOMETRY
CONCORDIA INTERCHANGE NB EXIT RAMP

4109