


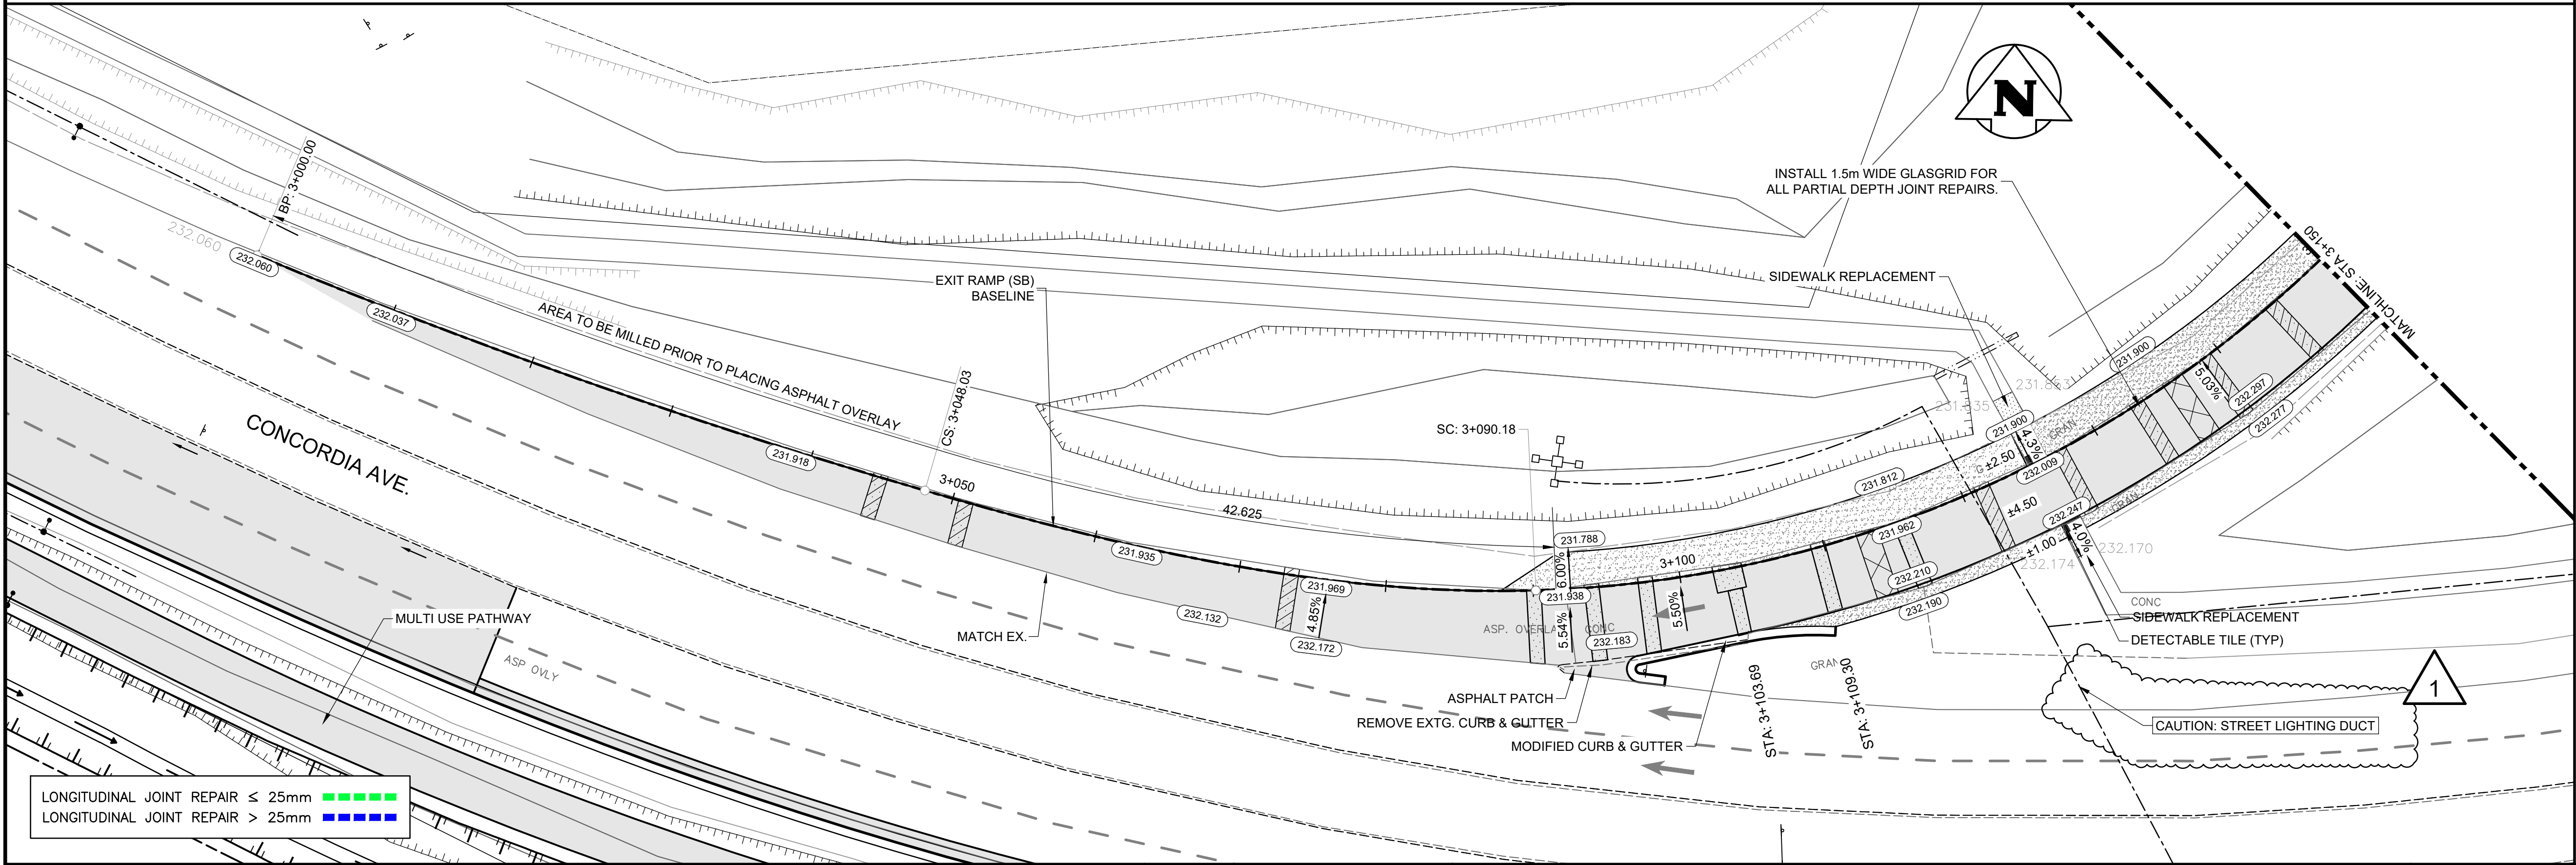




































 




CONC	CONCRETE ROADWAY
ASP	ASPHALT ROADWAY
ASP OVLY	ASPHALT OVERLAY ROADWAY
PVS	PAVING STONE/BRICK
TYP	TYPICAL
EX	EXISTING
MH	MANHOLE
WV	WATER VALVE
EL	ELEVATION
CB	CATCH BASIN
CP	CATCH PIT
CI	CURB INLET
CL	CONTROL LINE

WHOLE NUMBERS INDICATE MILLIMETRES
DECIMALIZED NUMBERS INDICATE METRES

IF POWER EQUIPMENT OR EXPLOSIVES ARE TO BE USED FOR EXCAVATION ON THIS PROJECT THE CONTRACTOR MUST:


1. NOTIFY THE GAS COMPANY OF THE PROPOSED LOCATION OF EXCAVATION.
2. TAKE PRECAUTION TO AVOID DAMAGE TO GAS COMPANY INSTALLATIONS SEE PROVINCIAL REGULATION 210/72 FOR DETAILS.
3. OBTAIN EXCAVATION PERMITS PRIOR TO CONSTRUCTION.




	HYDRANT			CONCRETE		150 WM	WATERMAIN		150 WM
	MANHOLE			ASPHALT		300 LDS	LAND DRAINAGE SEWER		300 LDS
	CATCH BASIN			SIDEWALK		250 WWS	WASTE WATER SEWER		250 WWS
	CATCH PIT			PAVING STONES			HYDRANT		+
	WATERMAIN			PAVEMENT REPAIR FABRIC			VALVE		X
	LAND DRAINAGE SEWER			PARTIAL DEPTH REPAIR			BL PROFILE		---
	WASTE WATER SEWER		232.000	PROPERTY LINE			LEFT LANE EDGE		---
	HYDRO			ELEVATION		(232.000)	RIGHT LANE EDGE		---
	FULL DEPTH REPAIR			DETECTABLE TILE			LEFT SHOULDER EDGE		---
	M.T.S.			GRANULAR SHOULDER			RIGHT SHOULDER EDGE		---
	GAS								
EXISTING	LEGEND-PLAN	PROPOSED	EXISTING	LEGEND-PLAN	PROPOSED	EXISTING	LEGEND-PROFILE	PROPOSED	

LOCATION OF UNDERGROUND STRUCTURES AS SHOWN ARE BASED ON THE BEST INFORMATION AVAILABLE. BUT NO GUARANTEE IS GIVEN THAT ALL EXISTING UTILITIES ARE SHOWN OR THAT THE GIVEN LOCATIONS ARE EXACT. CONFIRMATION OF EXISTENCE AND EXACT LOCATION OF ALL SERVICES MUST BE OBTAINED FROM THE INDIVIDUAL UTILITIES BEFORE PROCEEDING WITH CONSTRUCTION.

B.M. ELEV.			
1	ISSUED FOR ADDENDUM 5	25.09.22	JNC
0	ISSUED FOR TENDER	25.08.07	JNC
NO.	REVISIONS	DATE	BY

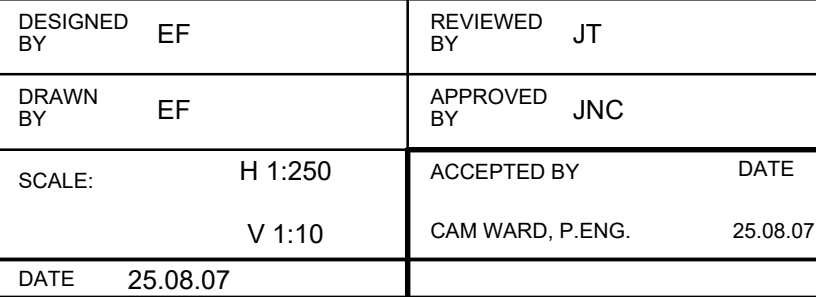

CONSULTANT DRAWING NO.

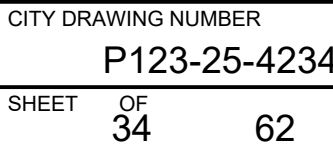

4234