

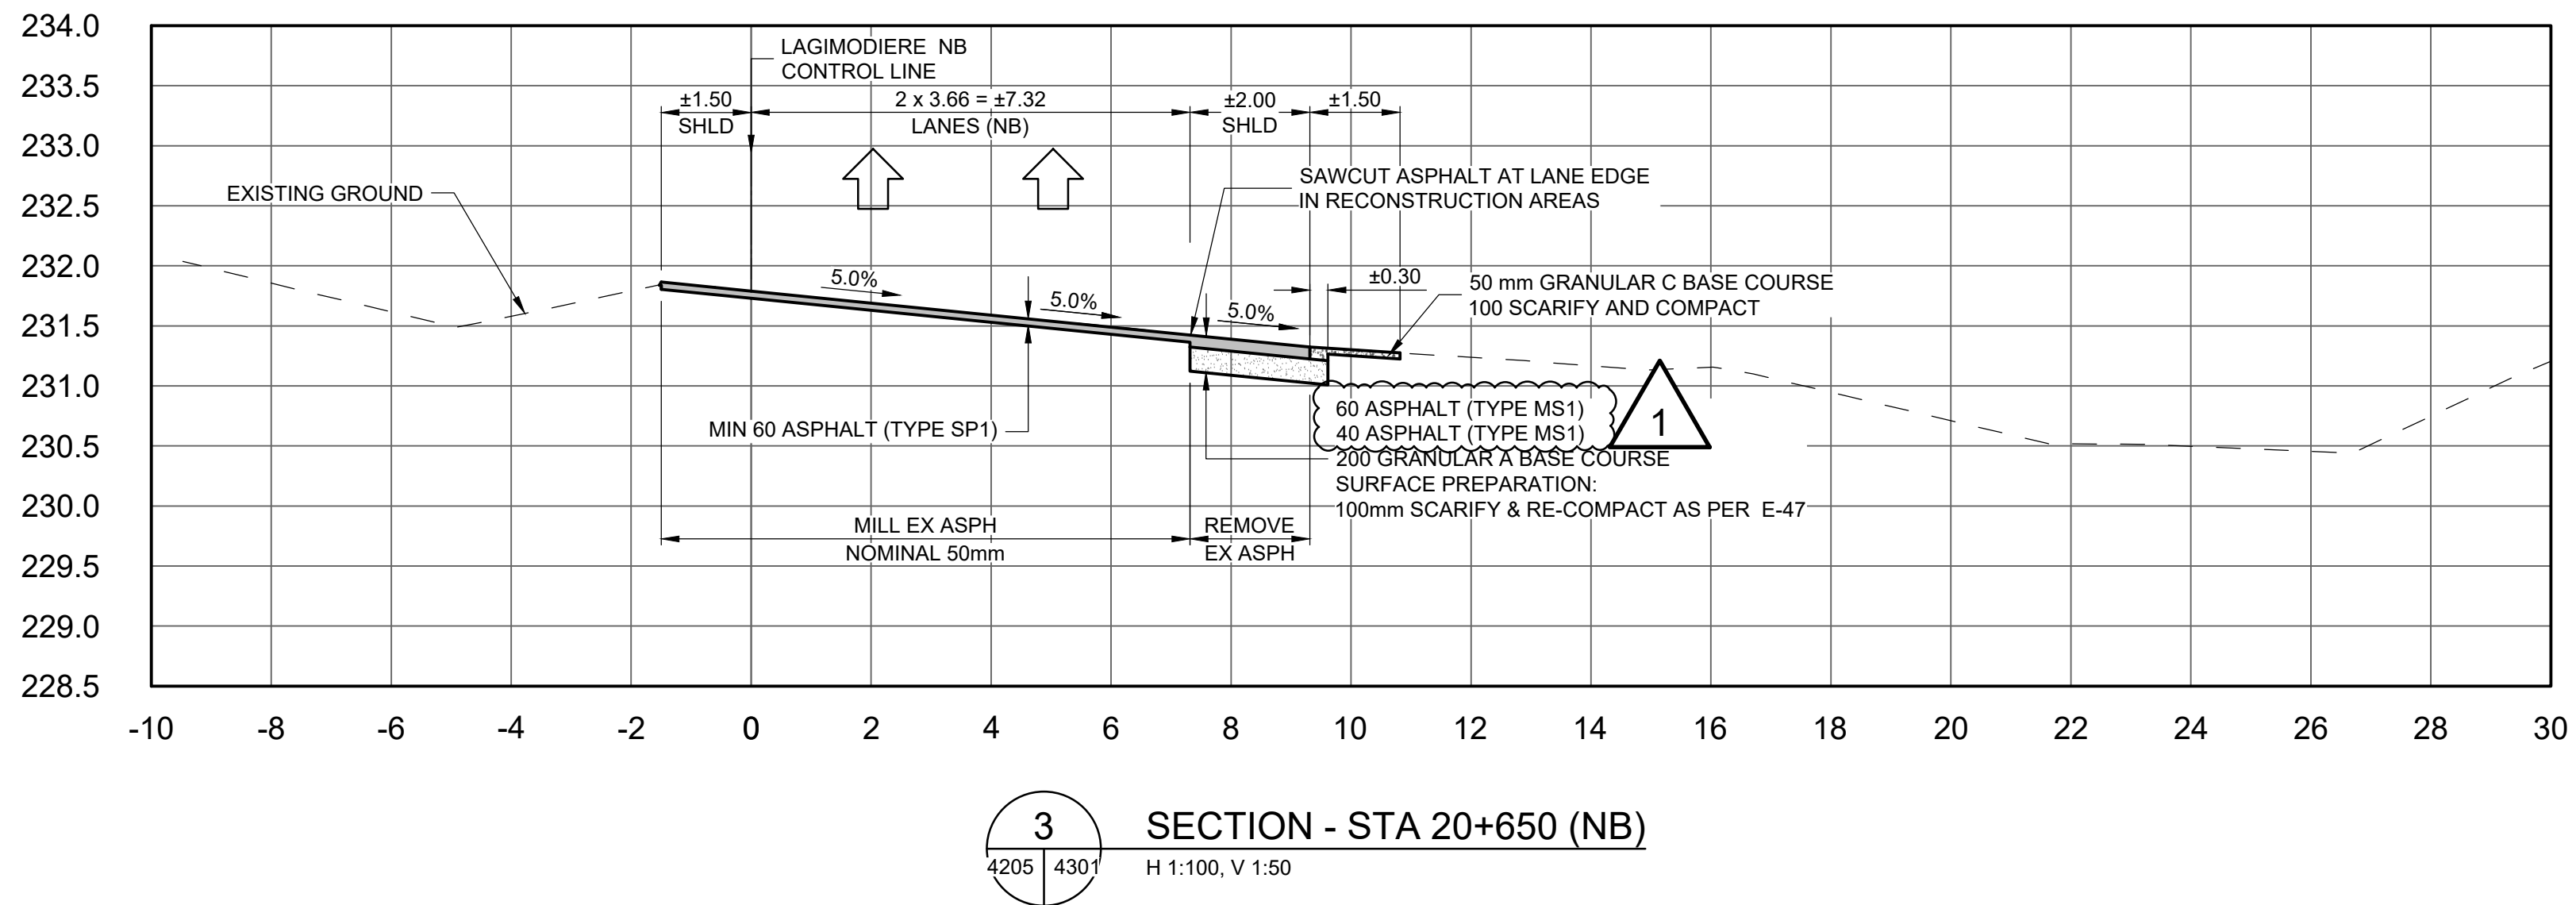


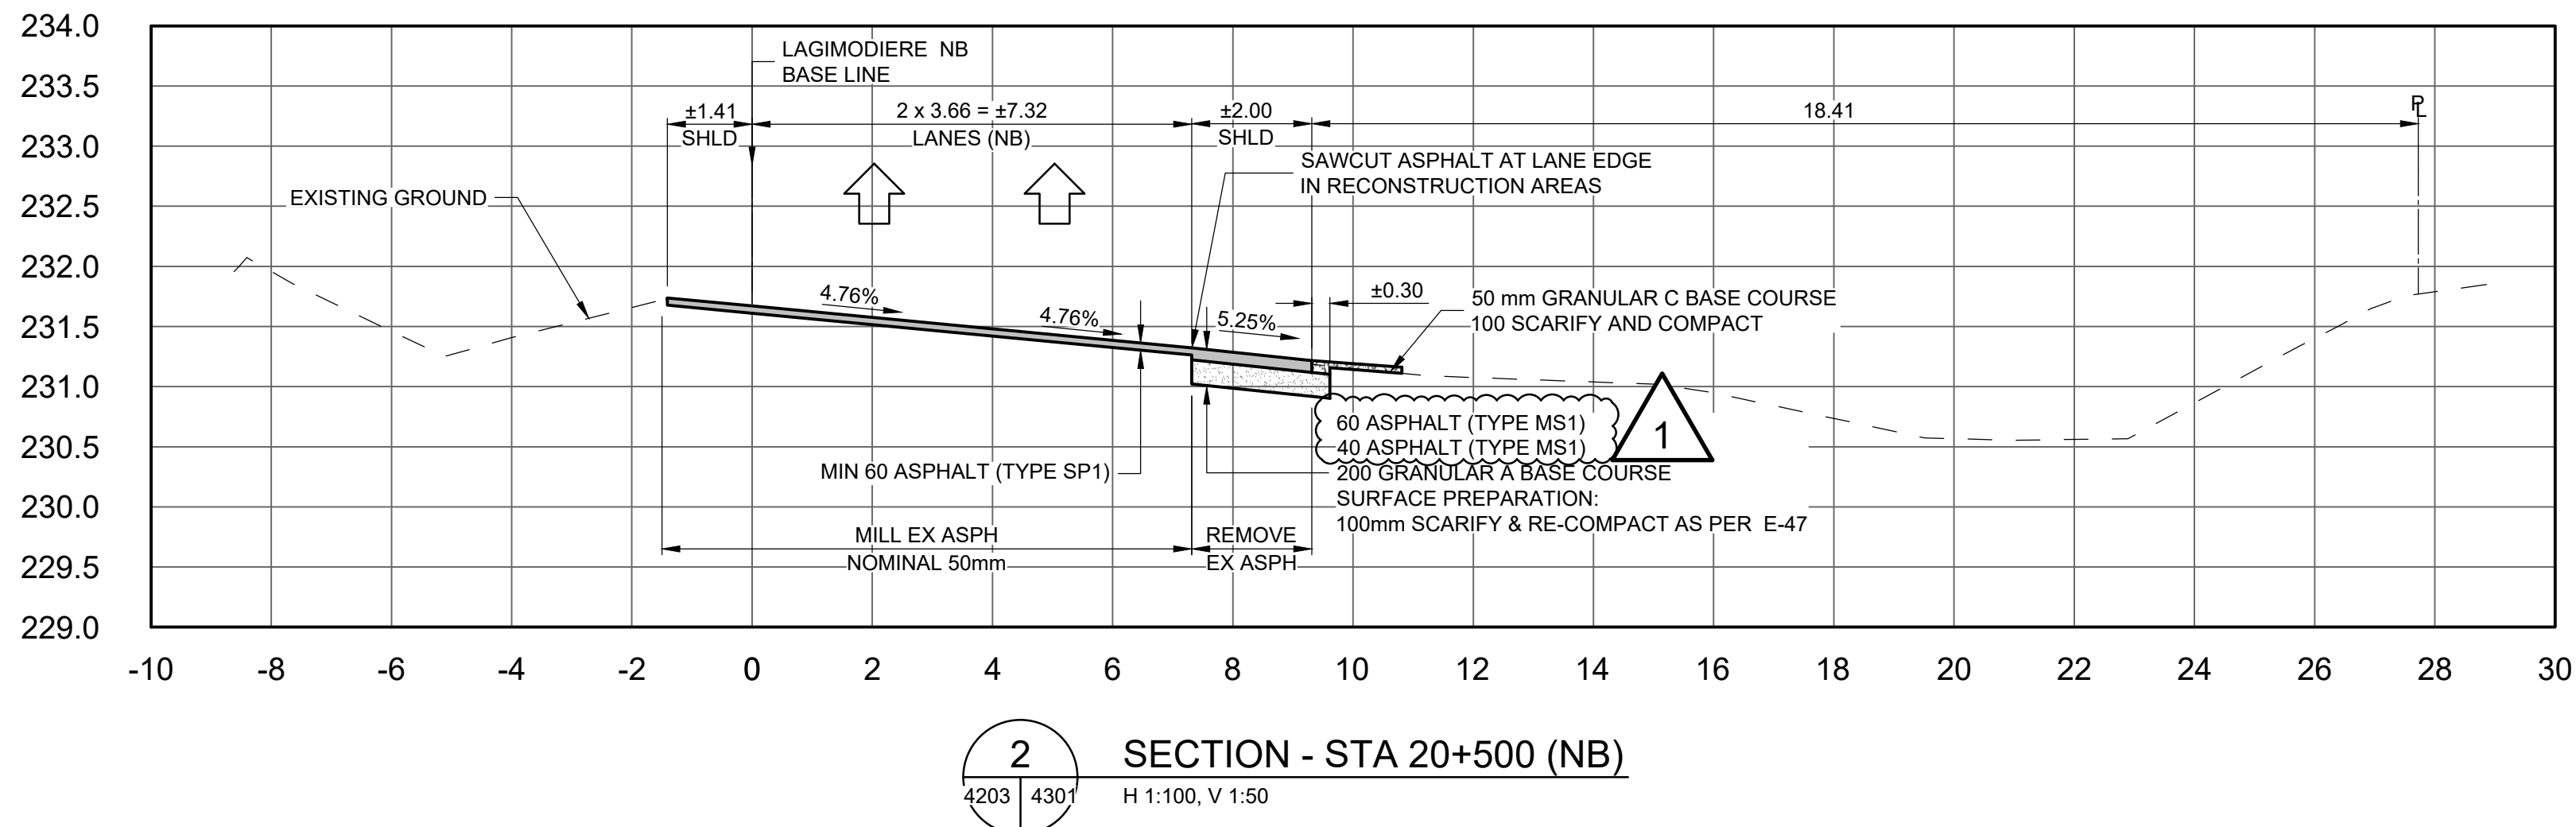

METRIC

WHOLE NUMBERS INDICATE MILLIMETRES
DECIMALIZED NUMBERS INDICATE METRES

B.M. ELEV.				 TETRA TECH		ORIGINAL DRAWING REVISION " 0 " SEALED BY J.N. CRANG 25.08.07	
				DESIGNED BY	EF	REVIEWED BY	JT
				DRAWN BY	DD	APPROVED BY	JNC
				SCALE: AS NOTED		ACCEPTED BY	DATE
1	ISSUED FOR ADDENDUM 5	25.09.22	JNC			CAM WARD, P.ENG.	25.08.07
0	ISSUED FOR TENDER	25.08.07	JNC				
NO. REVISIONS				DATE	25.08.07	734-INF.MB103007.01-DWG-C4301	

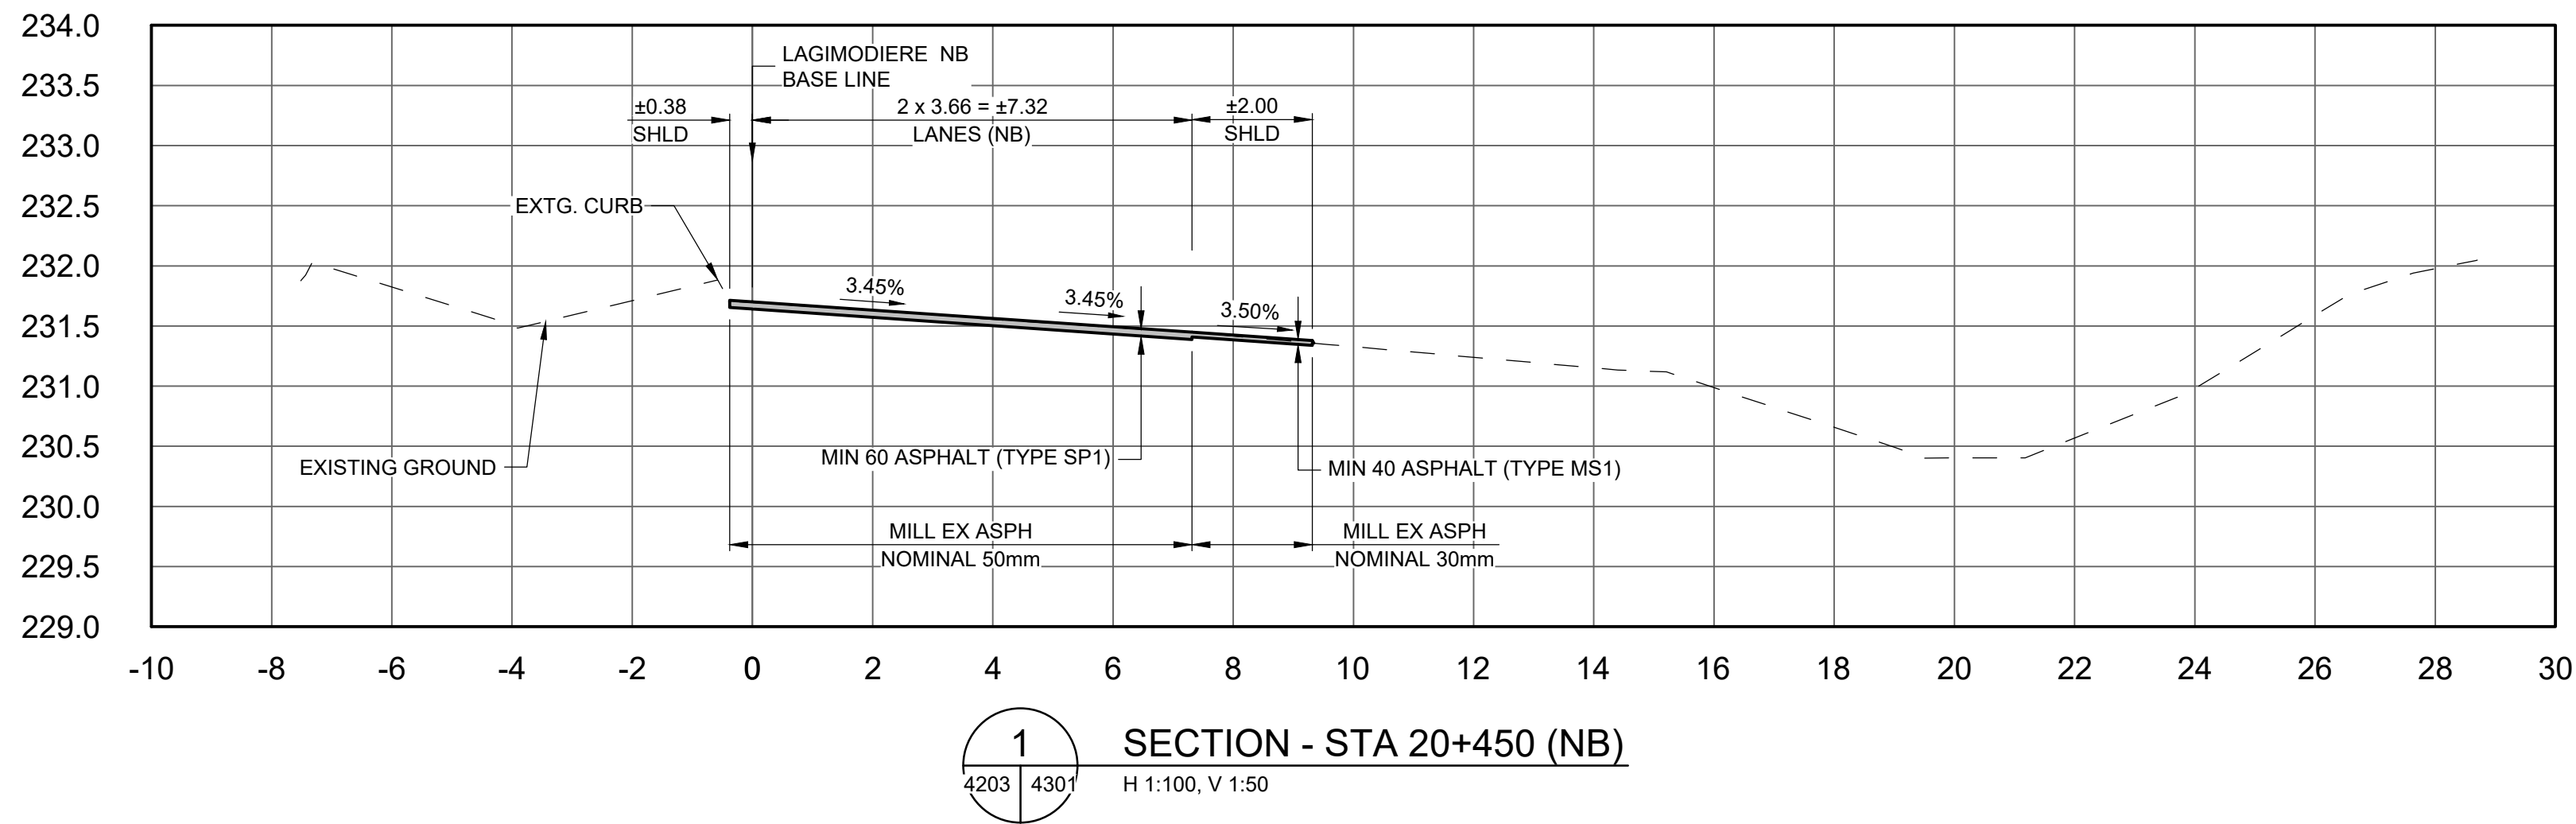

THE CITY OF WINNIPEG
PUBLIC WORKS DEPARTMENT

LAGIMODIERE TWIN OVERPASSES OVER CPKC KEEWATIN REHABILITATION AND RELATED WORKS	CITY DRAWING NUMBER P123-25-4301
CROSS SECTIONS (1 TO 3) LAGIMODIERE BOULEVARD	SHEET OF 1 20
4301	