




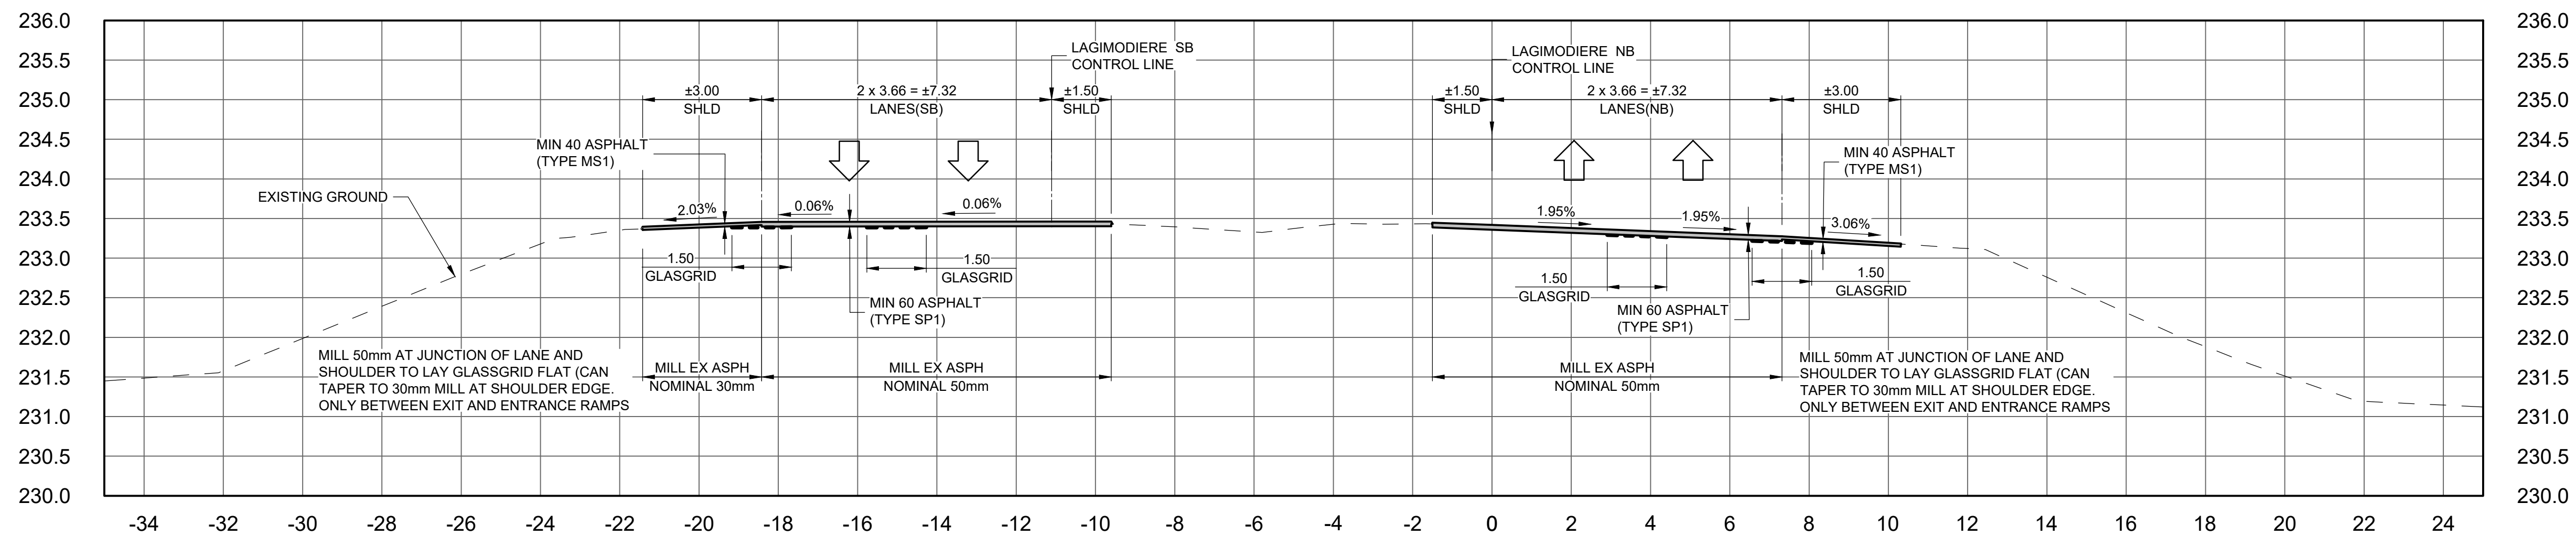

8 SECTION - STA 21+650 (NB)
H 1:100, V 1:50

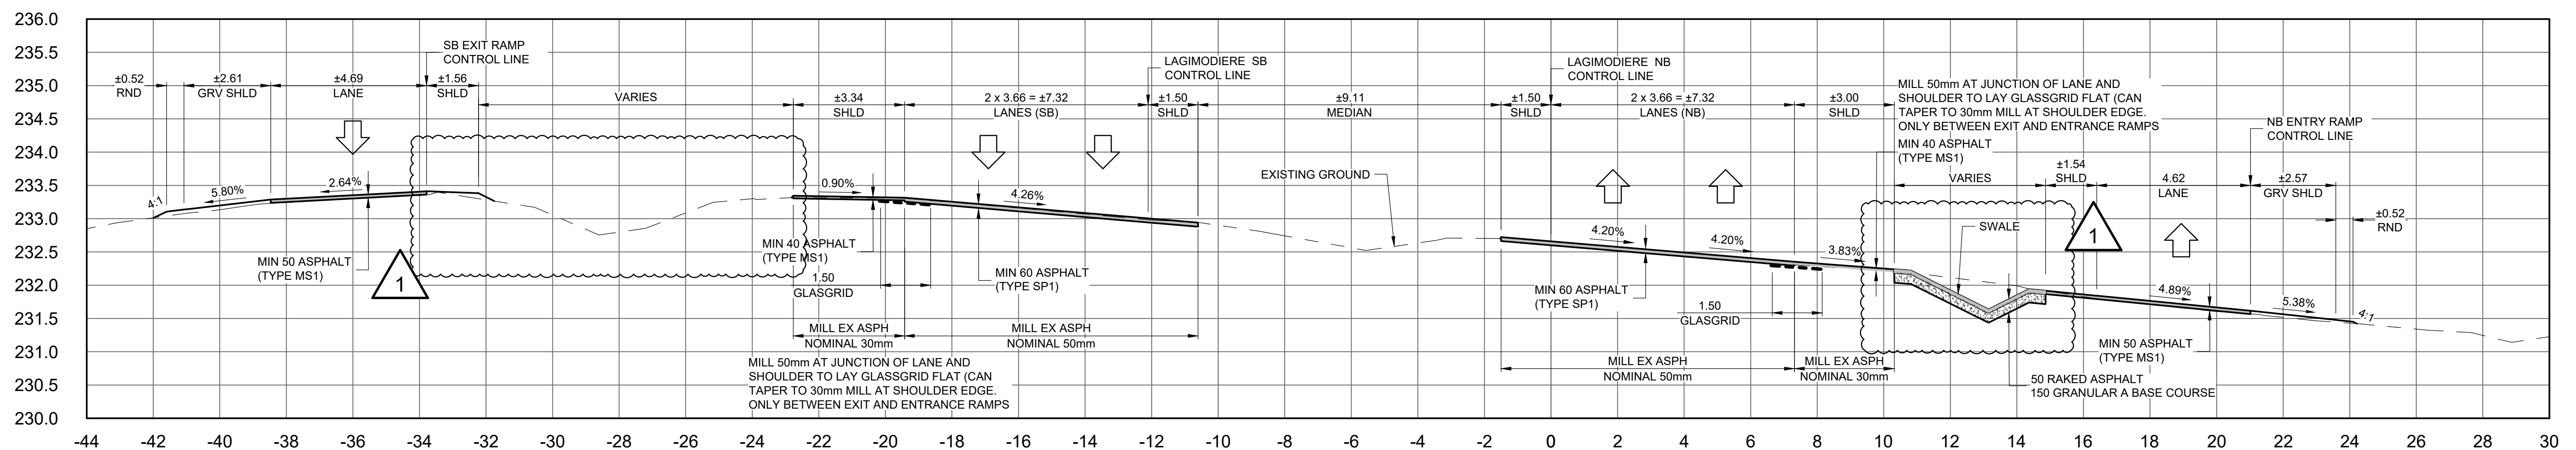

9 SECTION - STA 21+720 (NB)
4219 4304 H 1:100, V 1:50

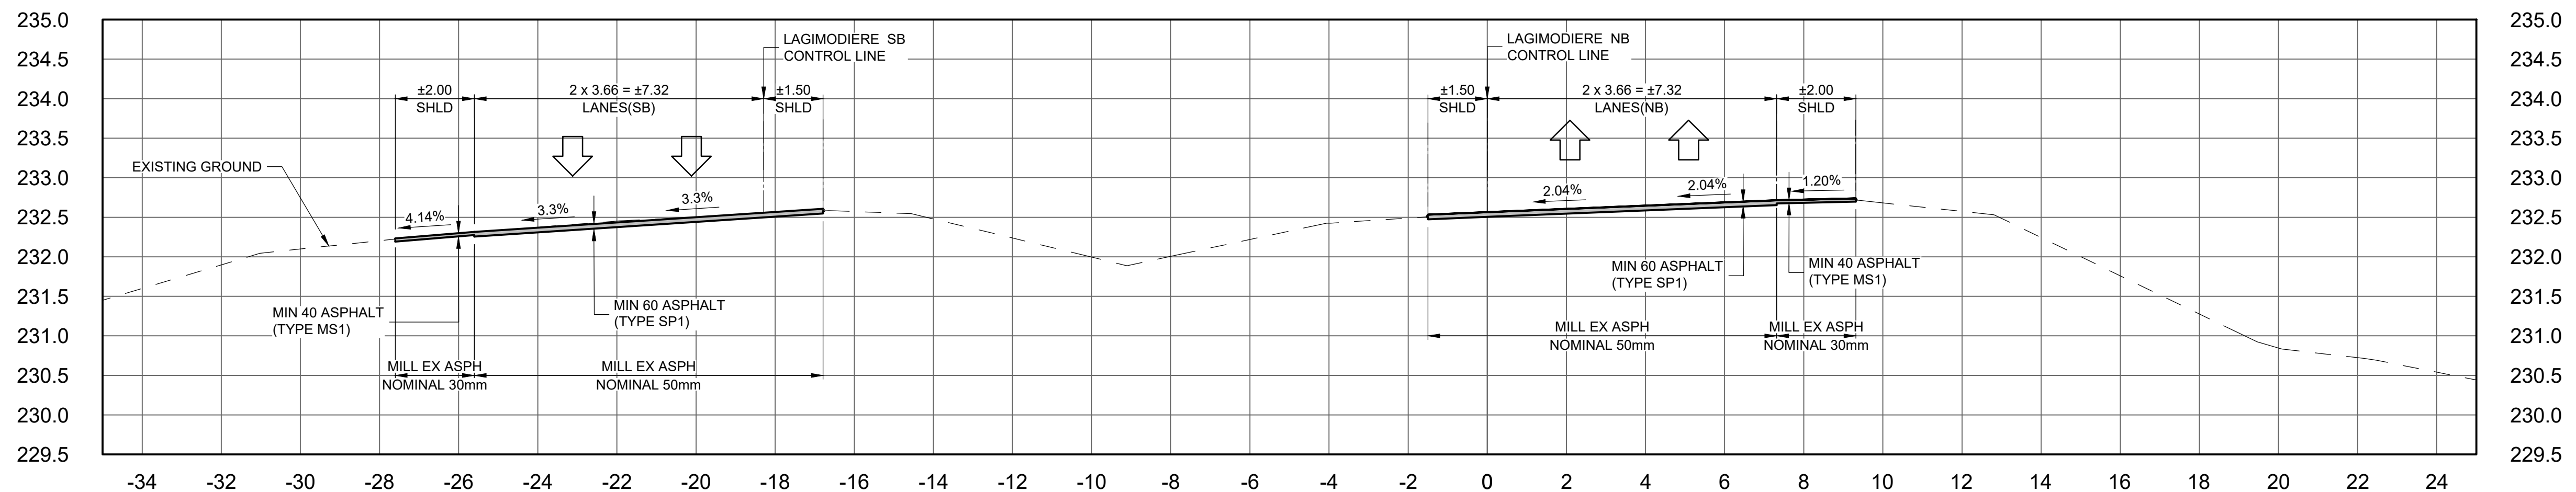

10 SECTION - STA 22+080 (NB)
H 1:100, V 1:50

METRIC

WHOLE NUMBERS INDICATE MILLIMETRES
DECIMALIZED NUMBERS INDICATE METRES

B.M. ELEV.				TETRA TECH				THE CITY OF WINNIPEG PUBLIC WORKS DEPARTMENT ENGINEERING DIVISION											
1	ISSUED FOR ADDENDUM 5	25.09.22	JNC	DESIGNED BY EF				REVIEWED BY JT											
0	ISSUED FOR TENDER	25.08.07	JNC	DRAWN BY DD				APPROVED BY JNC											
NO. REVISIONS				DATE BY				SCALE: AS NOTED				ACCEPTED BY DATE							
				DATE 25.08.07				CAM WARD, P.ENG.				25.08.07							
								ORIGINAL DRAWING REVISION " 0 " SEALED BY J.N. CRANG 25.08.07											
								CONSULTANT DRAWING NO. 734-INF.MBI03007.01-DWG-C4304											
								LAGIMODIERE TWIN OVERPASSES OVER CPKC KEEWATIN REHABILITATION AND RELATED WORKS								CITY DRAWING NUMBER P123-25-4304			
								CROSS SECTIONS (8 TO 10) LAGIMODIERE BOULEVARD								SHEET OF 4 20			
																4304			