
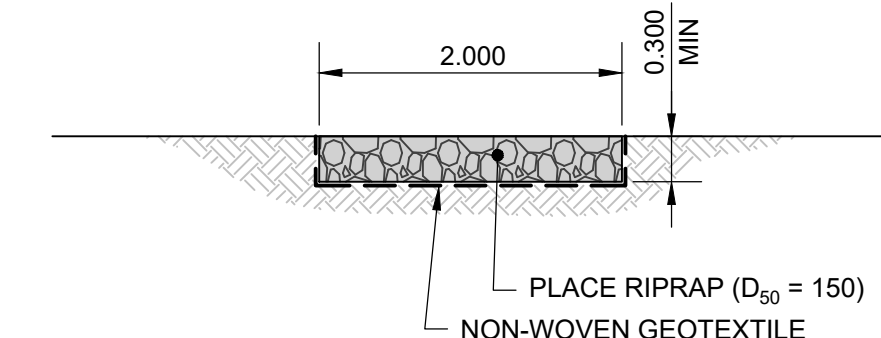
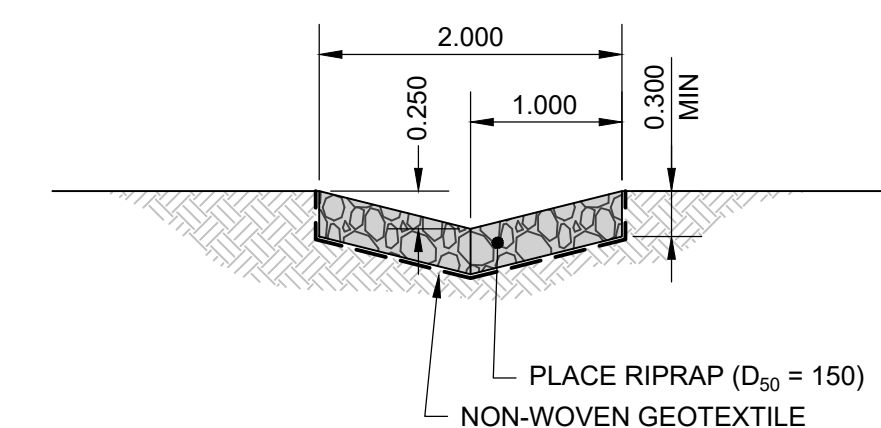
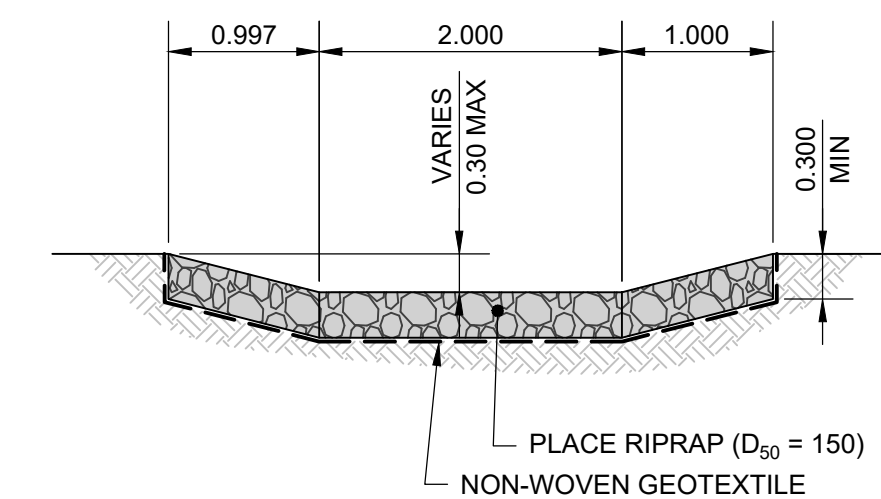
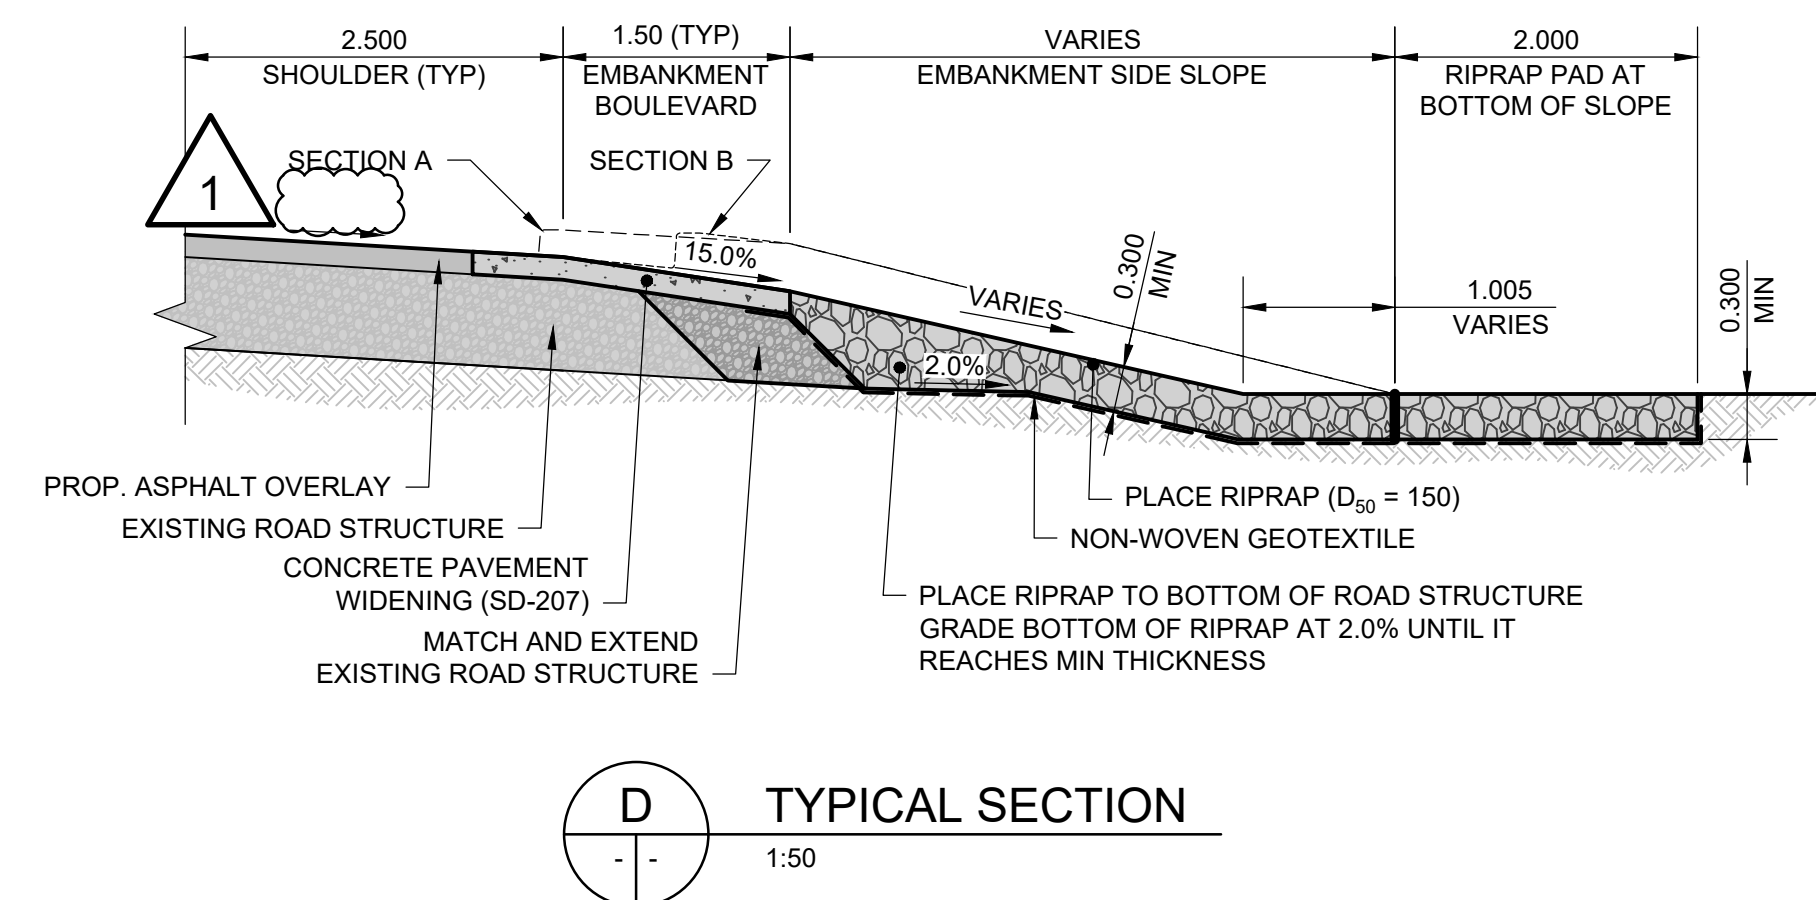
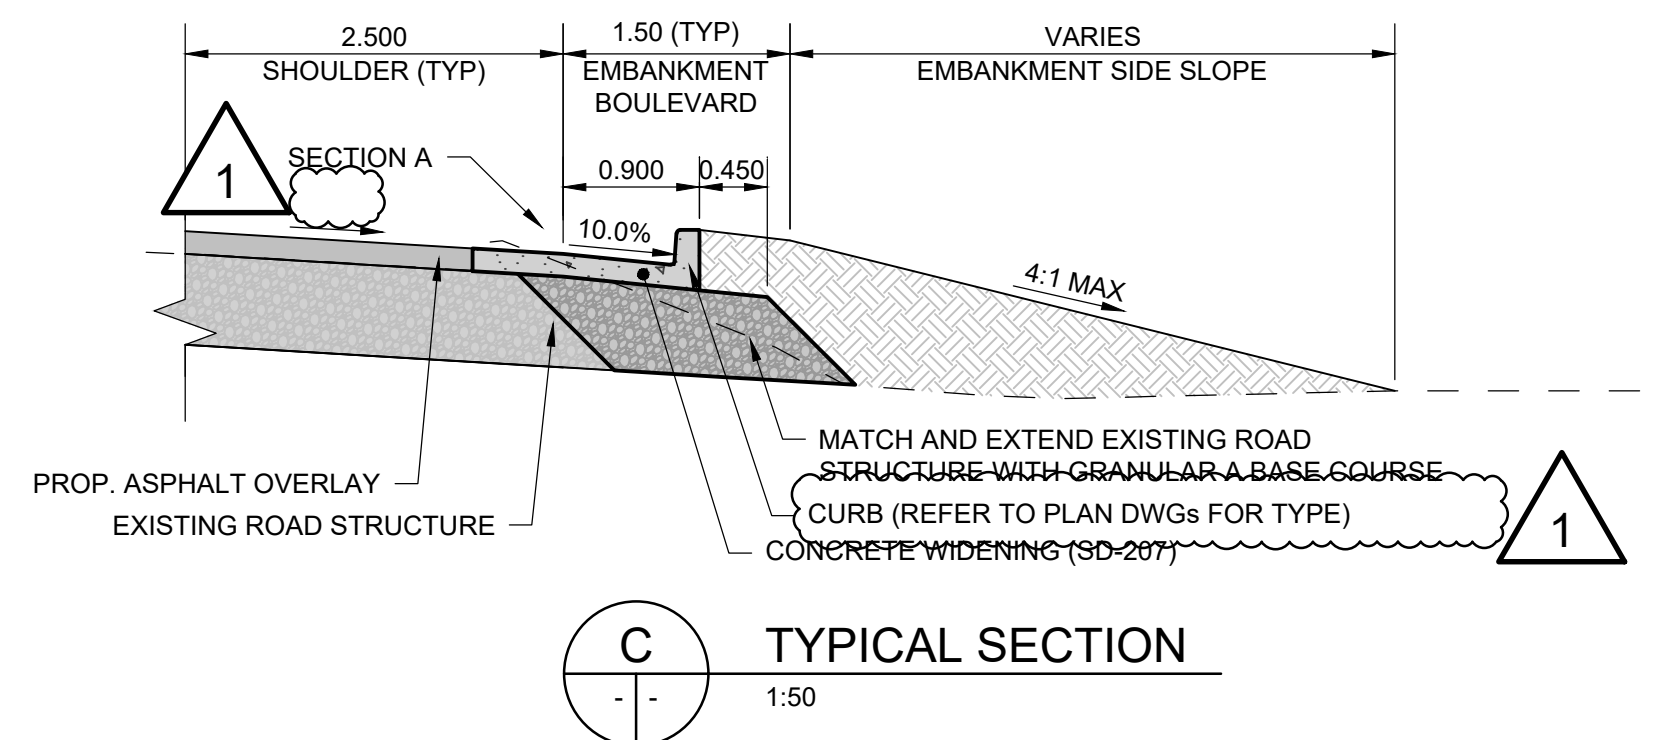
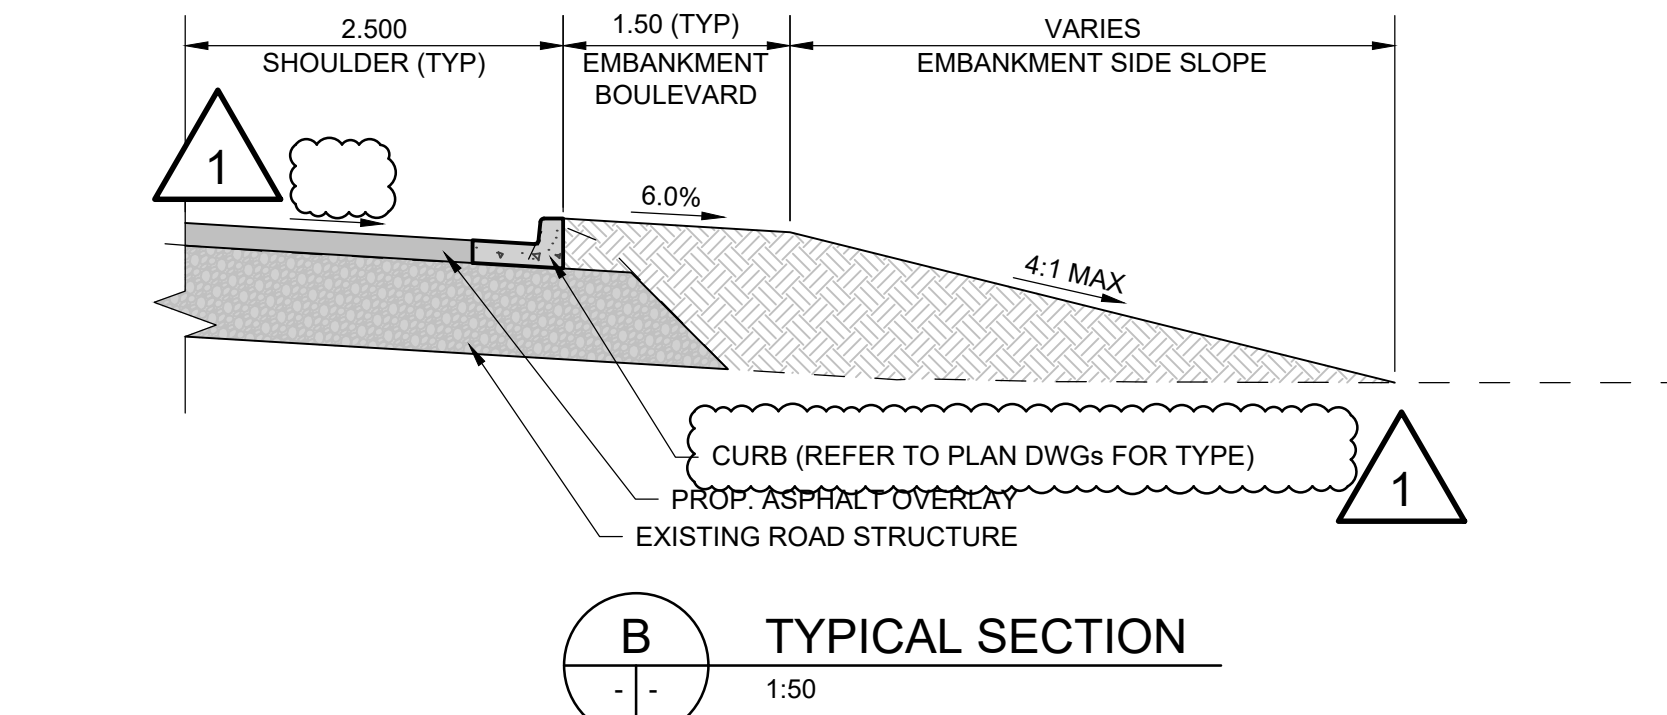
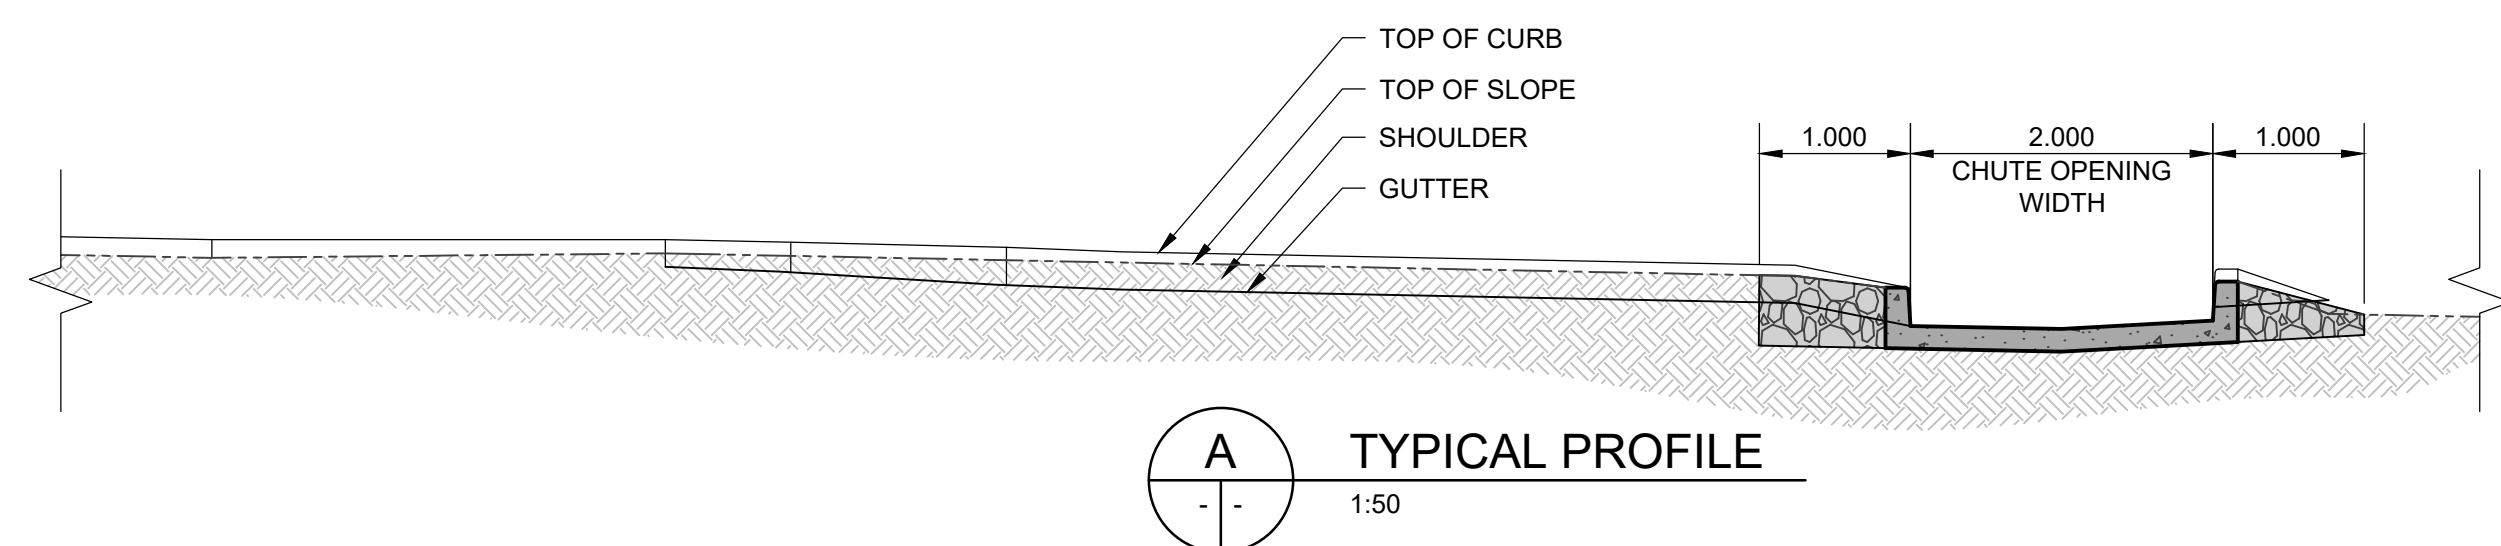


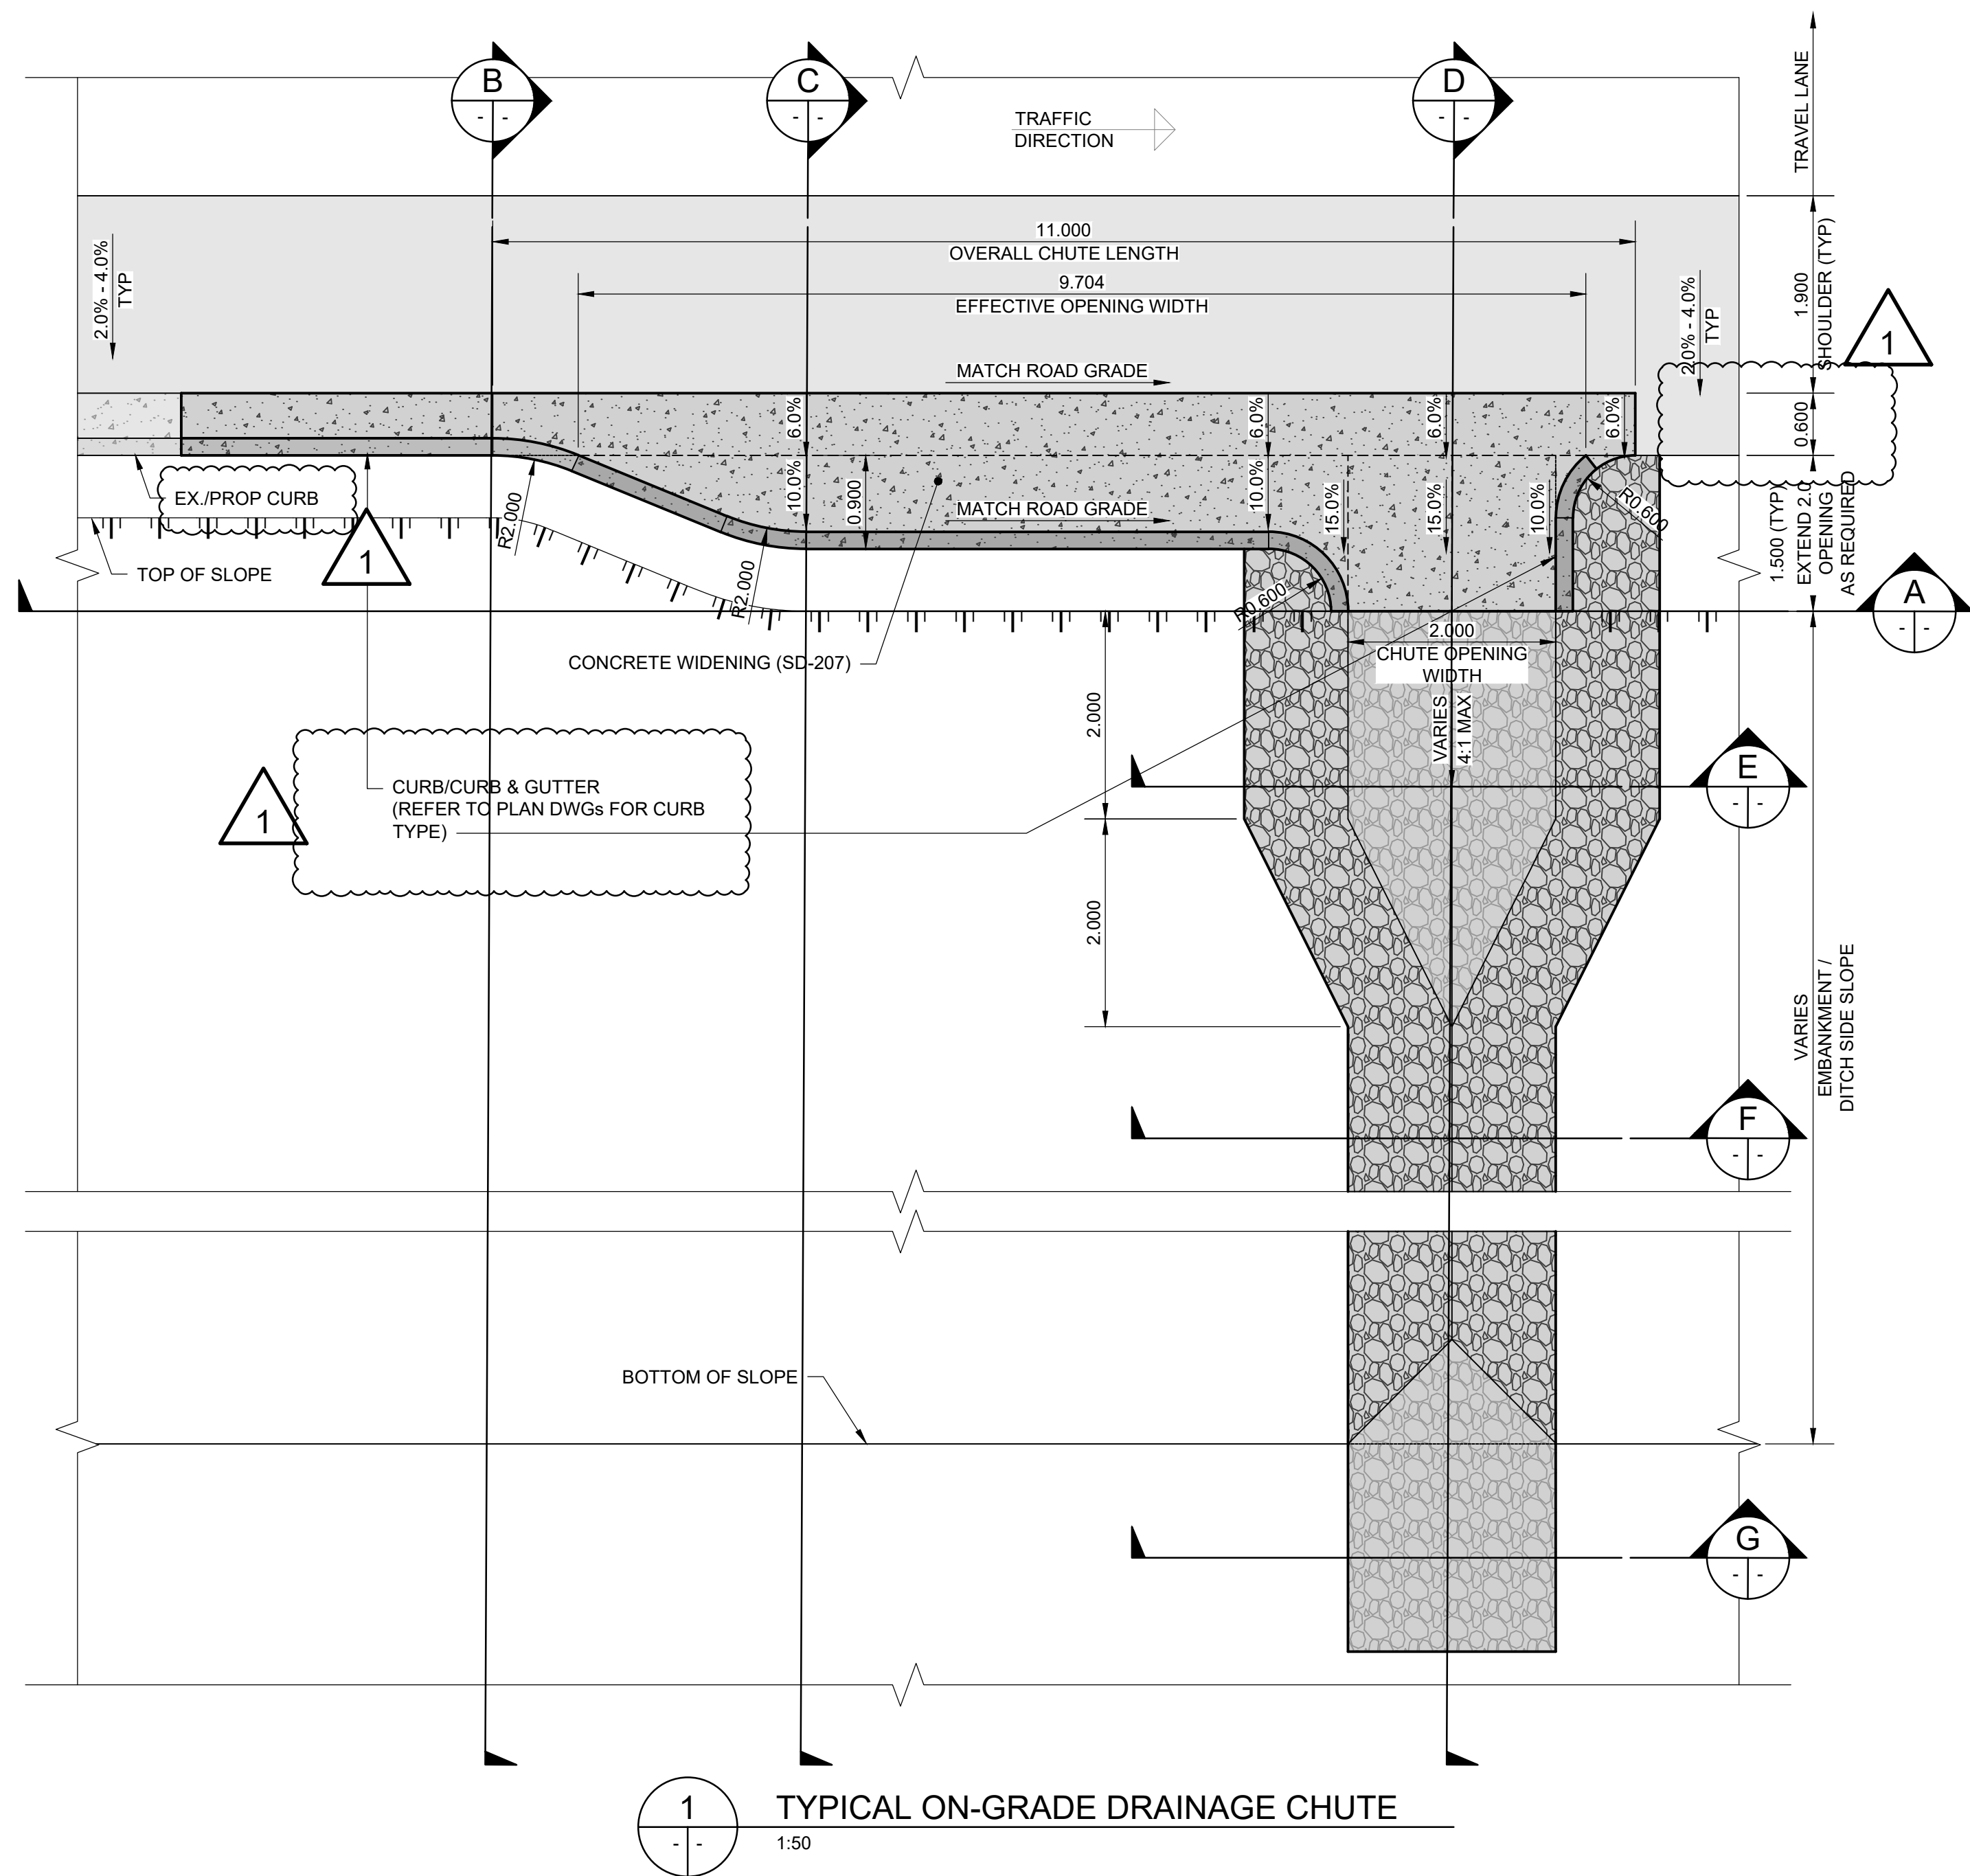

METRIC

WHOLE NUMBERS INDICATE MILLIMETRES
DECIMALIZED NUMBERS INDICATE METRES

B.M. ELEV.				 TETRA TECH	ORIGINAL DRAWING REVISION "0" SEALED BY J.N. CRANG 25.08.07	 THE CITY OF WINNIPEG PUBLIC WORKS DEPARTMENT	LAGIMODIERE TWIN OVERPASSES OVER CPKC KEEWATIN REHABILITATION AND RELATED WORKS		CITY DRAWING NUMBER	
		P123-25-4320								
		SHEET OF 20 20								
1	ISSUED FOR ADDENDUM 5	25.09.22	JNC	SCALE: AS NOTED	ACCEPTED BY DATE	CONSULTANT DRAWING NO. 734-INF-MB103007.01-DWG-C4320	ON-GRADE DRAINAGE CHUTE DETAIL		4320	
0	ISSUED FOR TENDER	25.08.07	JNC		CAM WARD, P.ENG. 25.08.07					
NO.	REVISIONS	DATE	BY	DATE	25.08.07					

**ENGINEERS
GEOSCIENTISTS
MANITOBA**

Certificate of Authorization
Tetra Tech Canada Inc.
No. 6499