
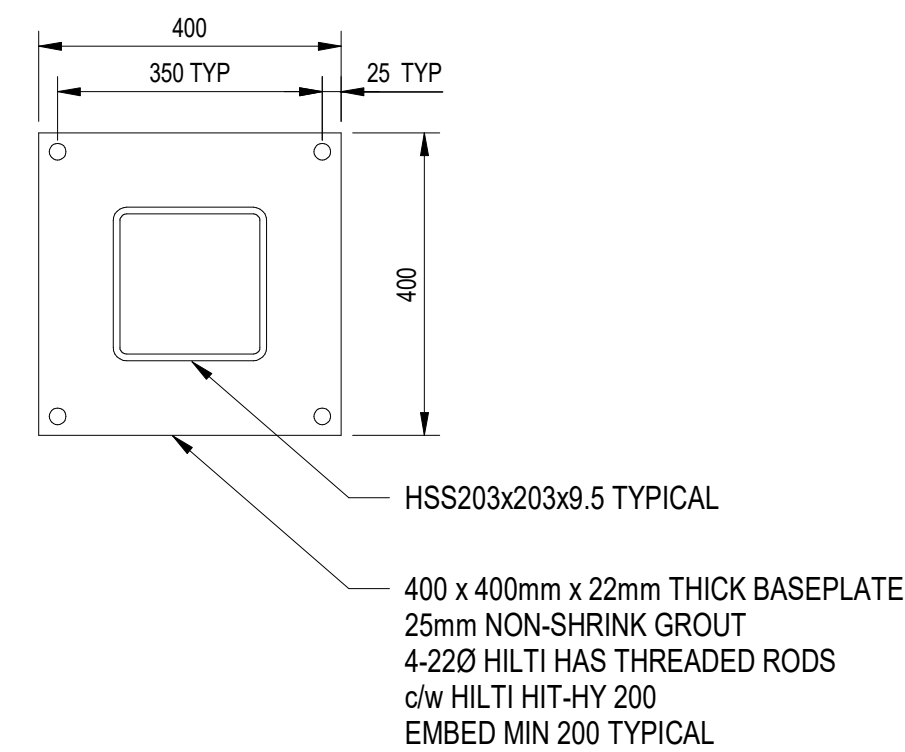
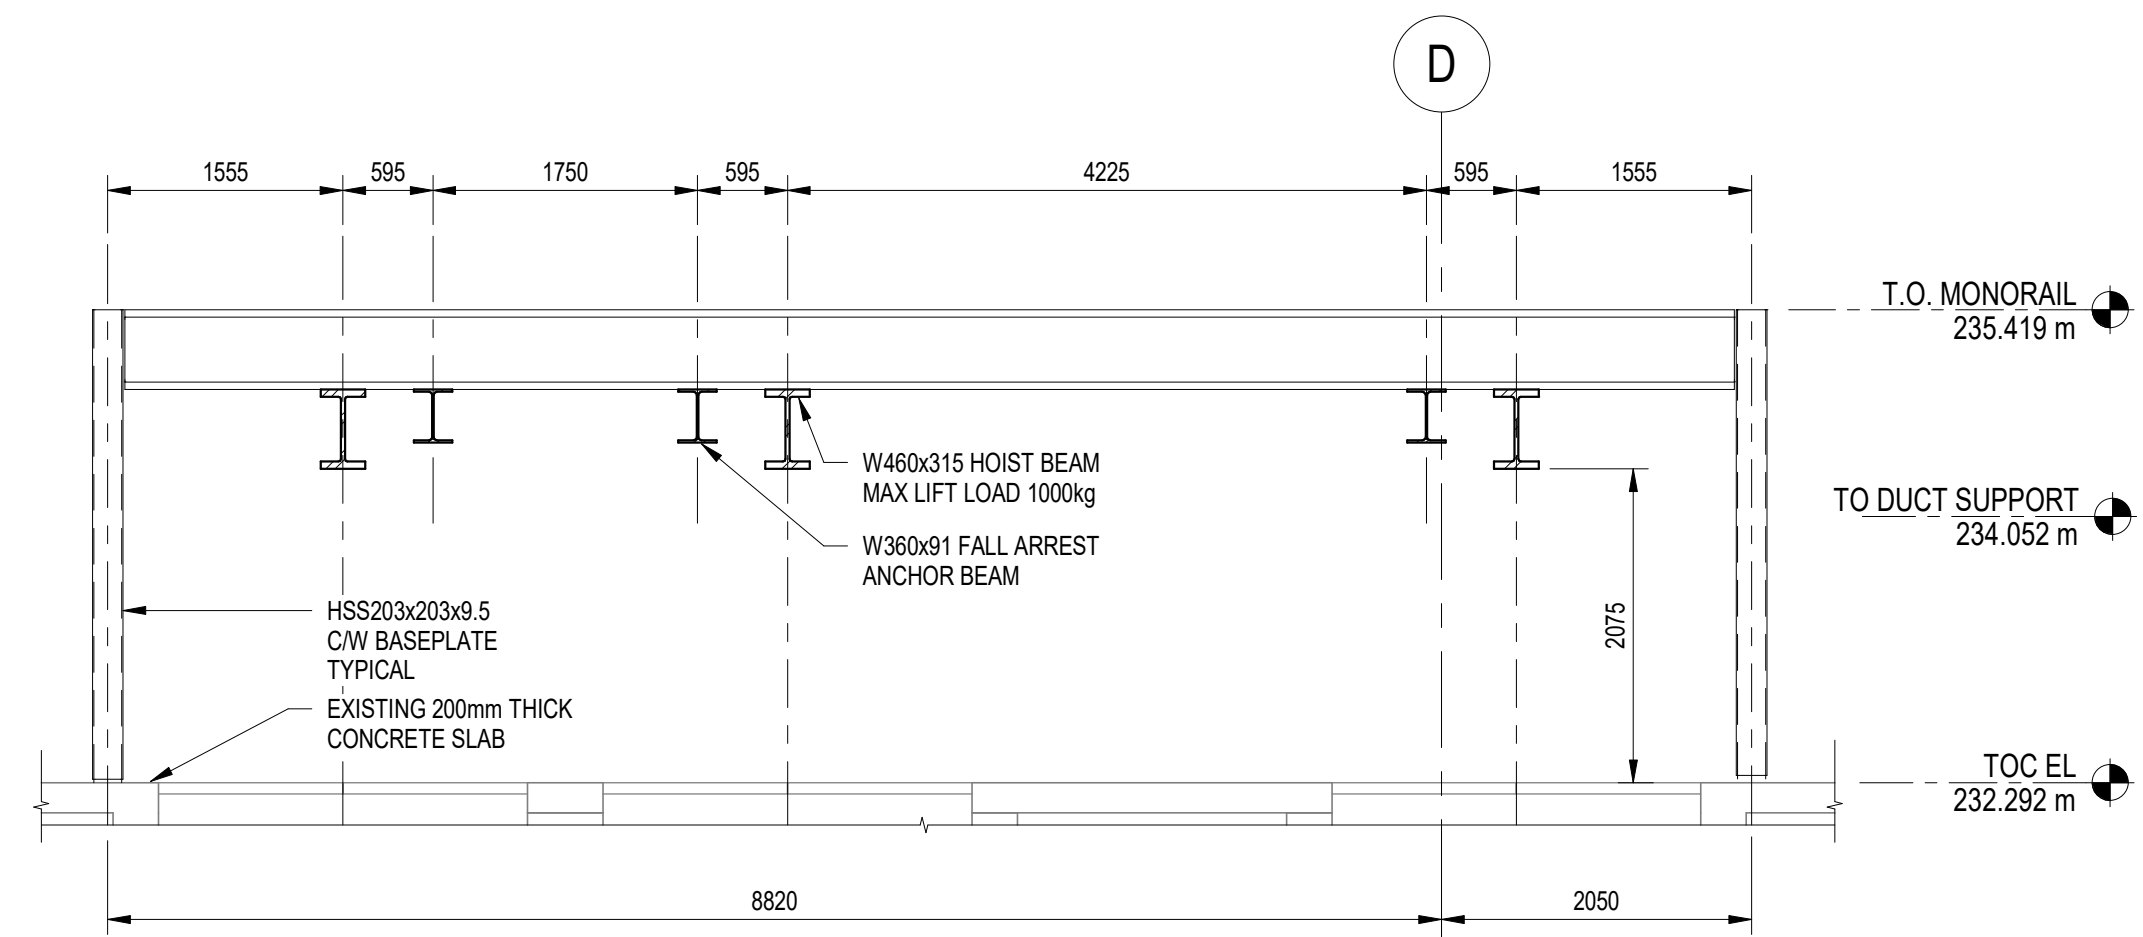
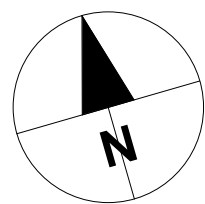


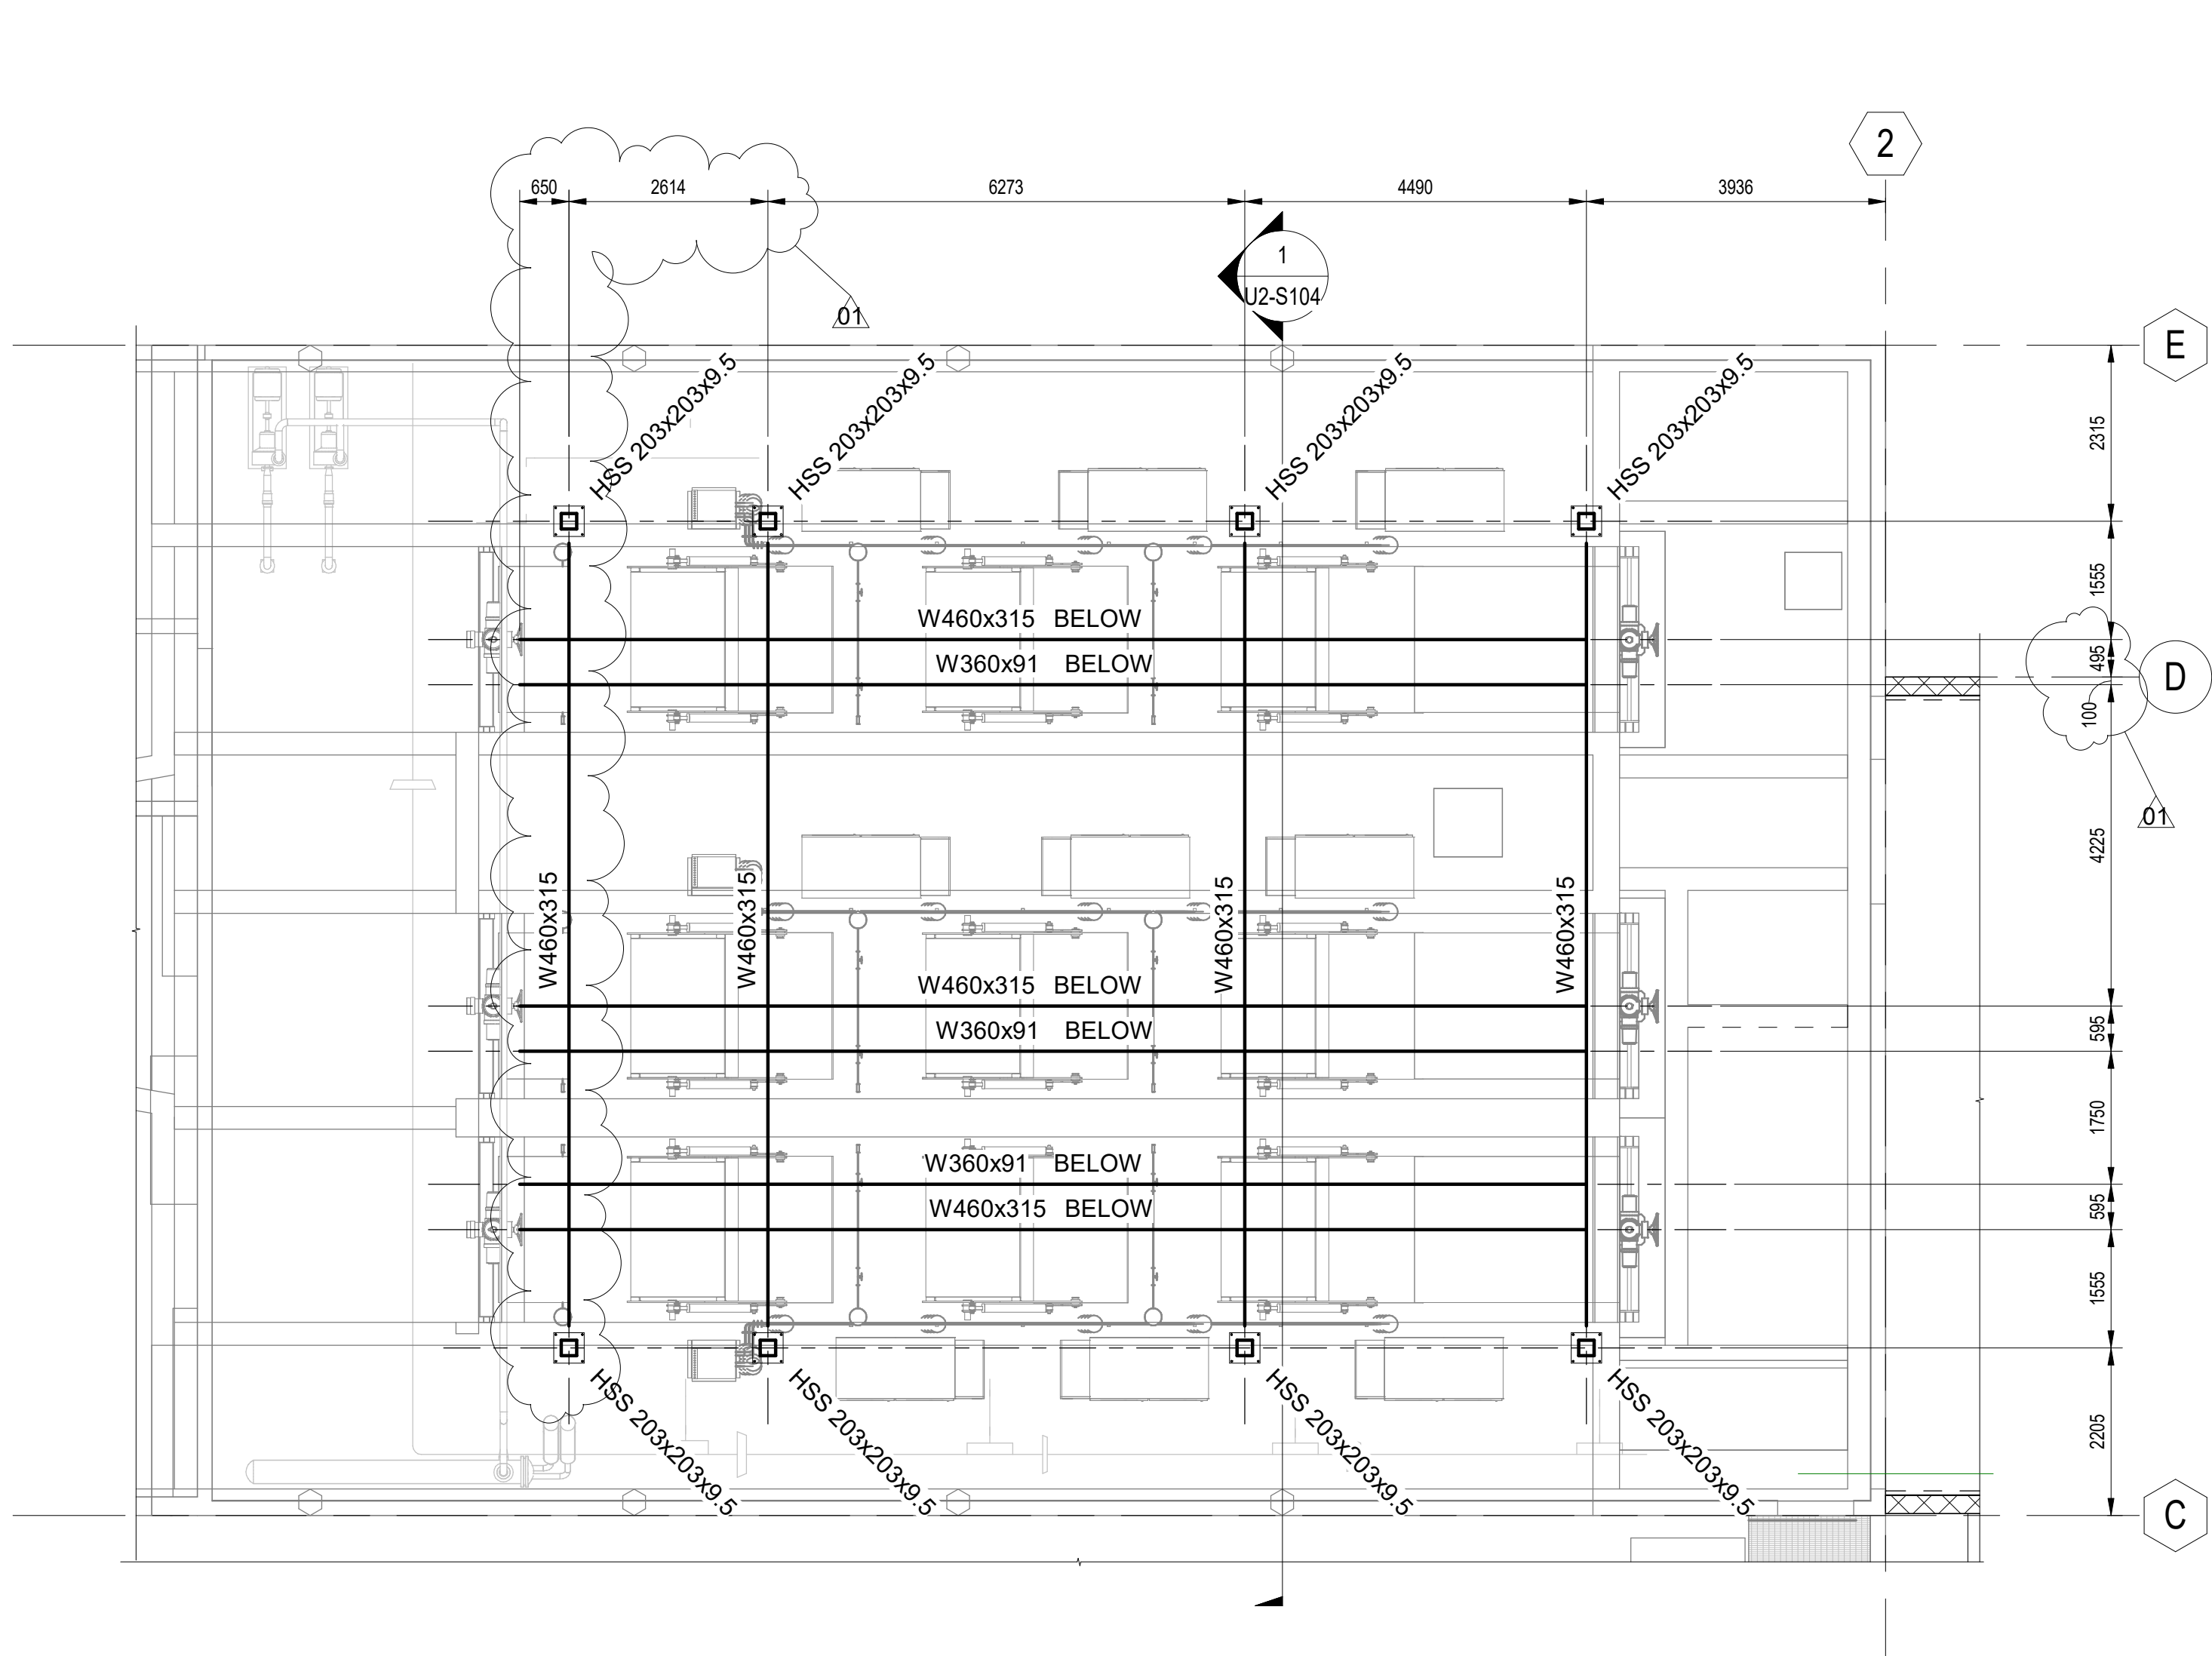

NO	REVISIONS	DATE	DESIGN	CHECK
01	ISSUED FOR ADDENDUM 3	2025-04-04	CT	MB
00	ISSUED FOR TENDER	2025-02-26	CT	MB

AECOM	
DESIGNED BY: CT	CHECKED BY: MB
DRAWN BY: BF	APPROVED BY:
SCALE: As indicated	RELEASED FOR CONSTRUCTION BY:
DATE: 2023-07-24	DATE:
CONSULTANT NO.: U2-S104	

ENGINEER'S SEAL

THE CITY OF WINNIPEG WATER AND WASTE DEPARTMENT			
NORTH END SEWAGE TREATMENT PLANT NEWPCC UV UPGRADES STRUCTURAL NEW MONORAIL/ SUPPORT STRUCTURE ENLARGED PLAN, SECTION AND DETAIL			
CITY DRAWING NUMBER	SHEET	REV. 00	SIZE A1