




LAST SAVE: 2025-04-28 7:09:32 AM
PATH: Autocad Dwg/City of Winnipeg - NEWPCC Upgrades 2023/SMOD-U101.rvt

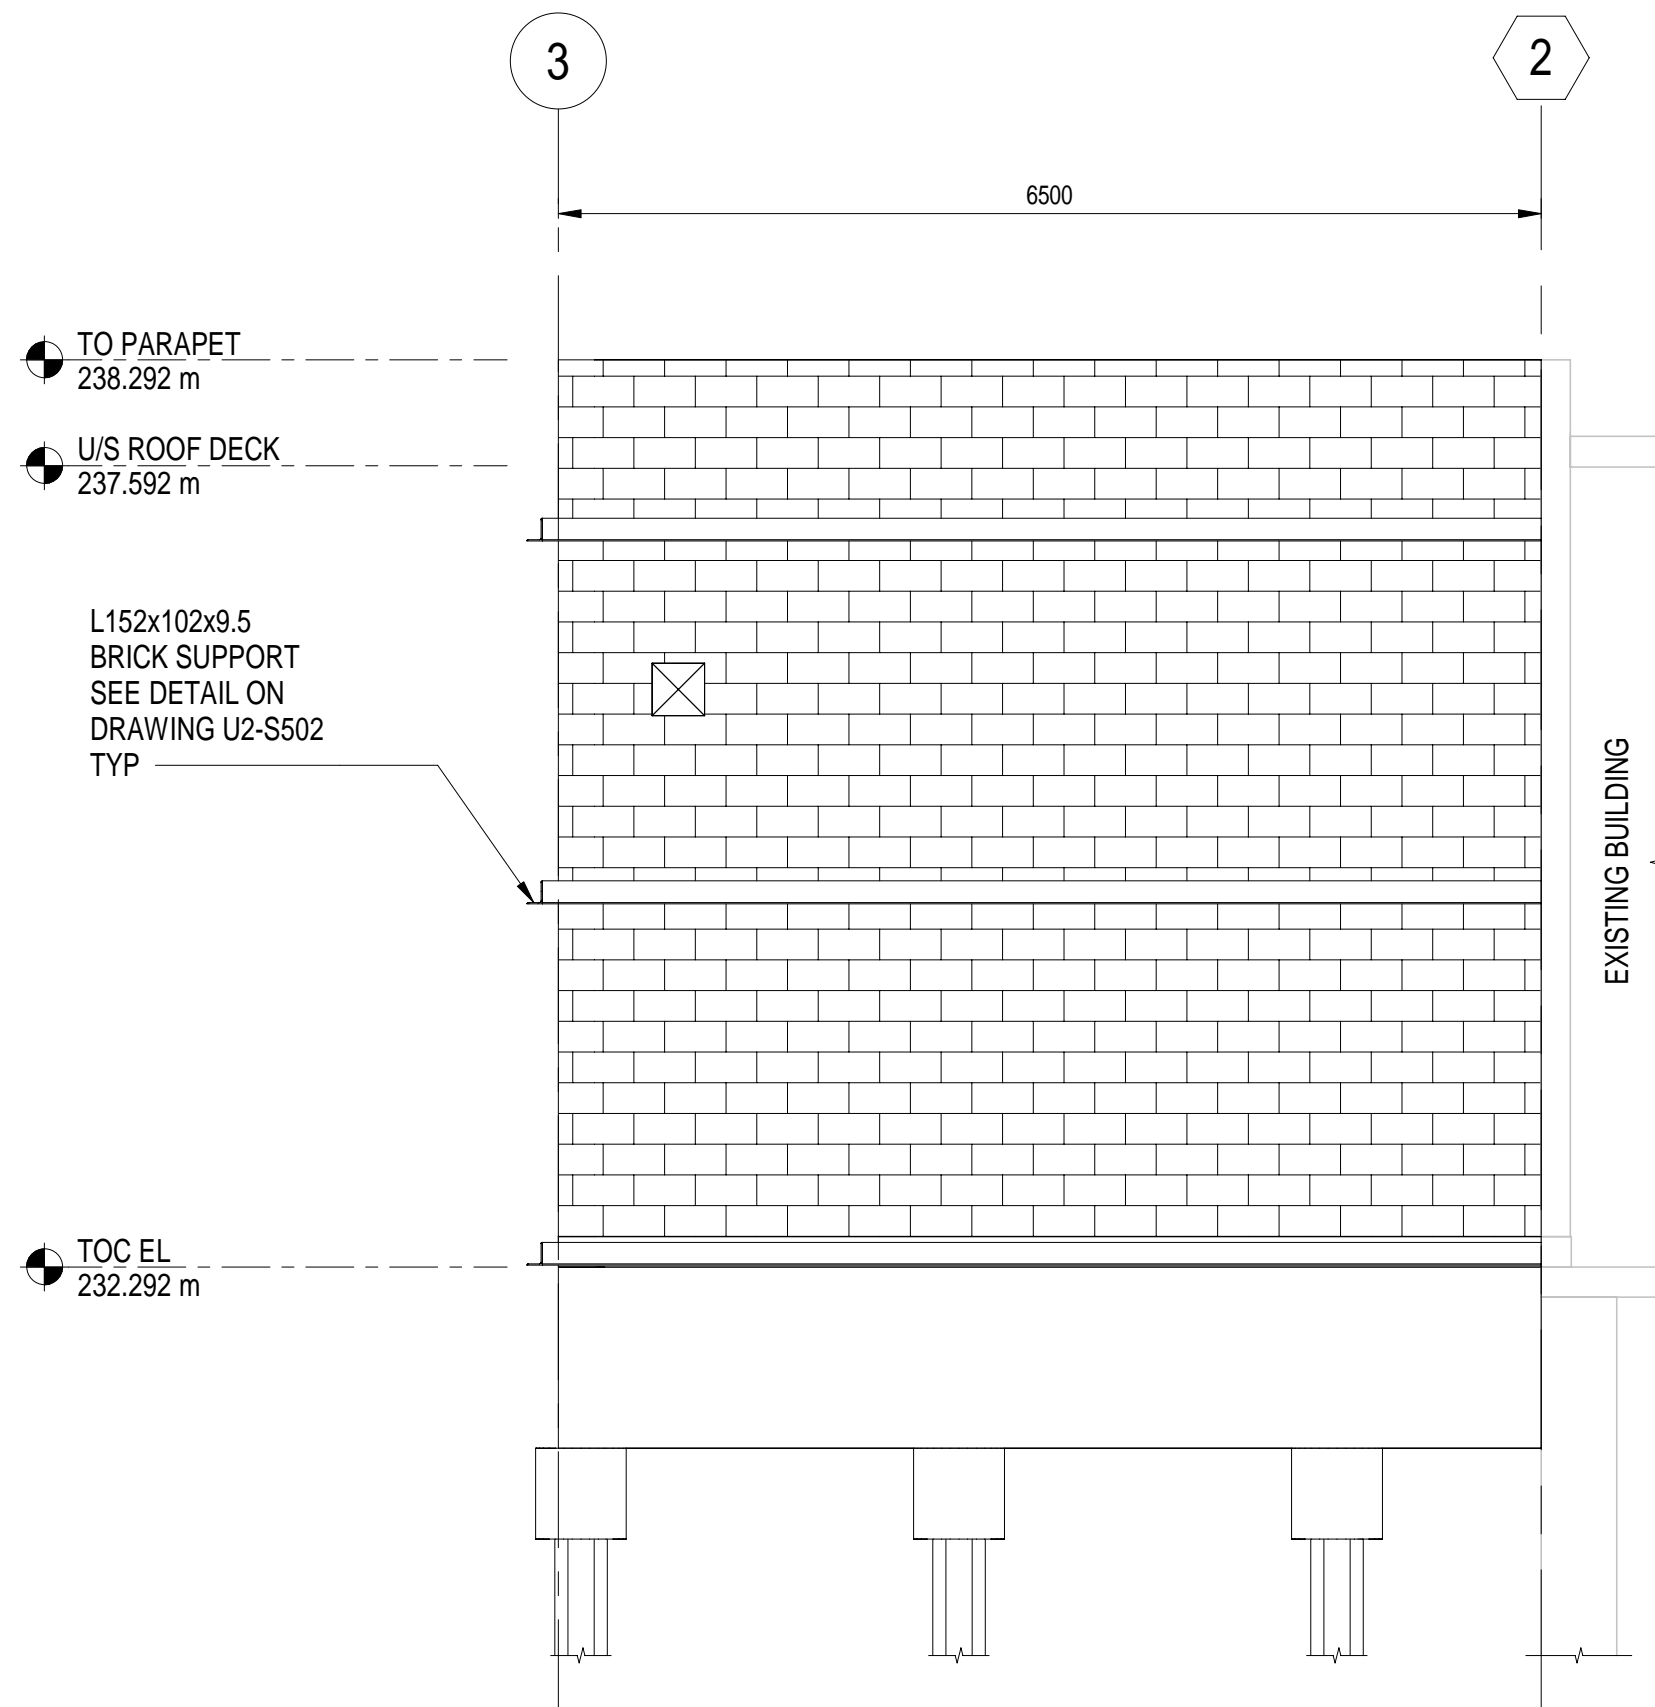


NORTH ELEVATION - NEW UV STORAGE ROOM
SCALE: 1 : 50

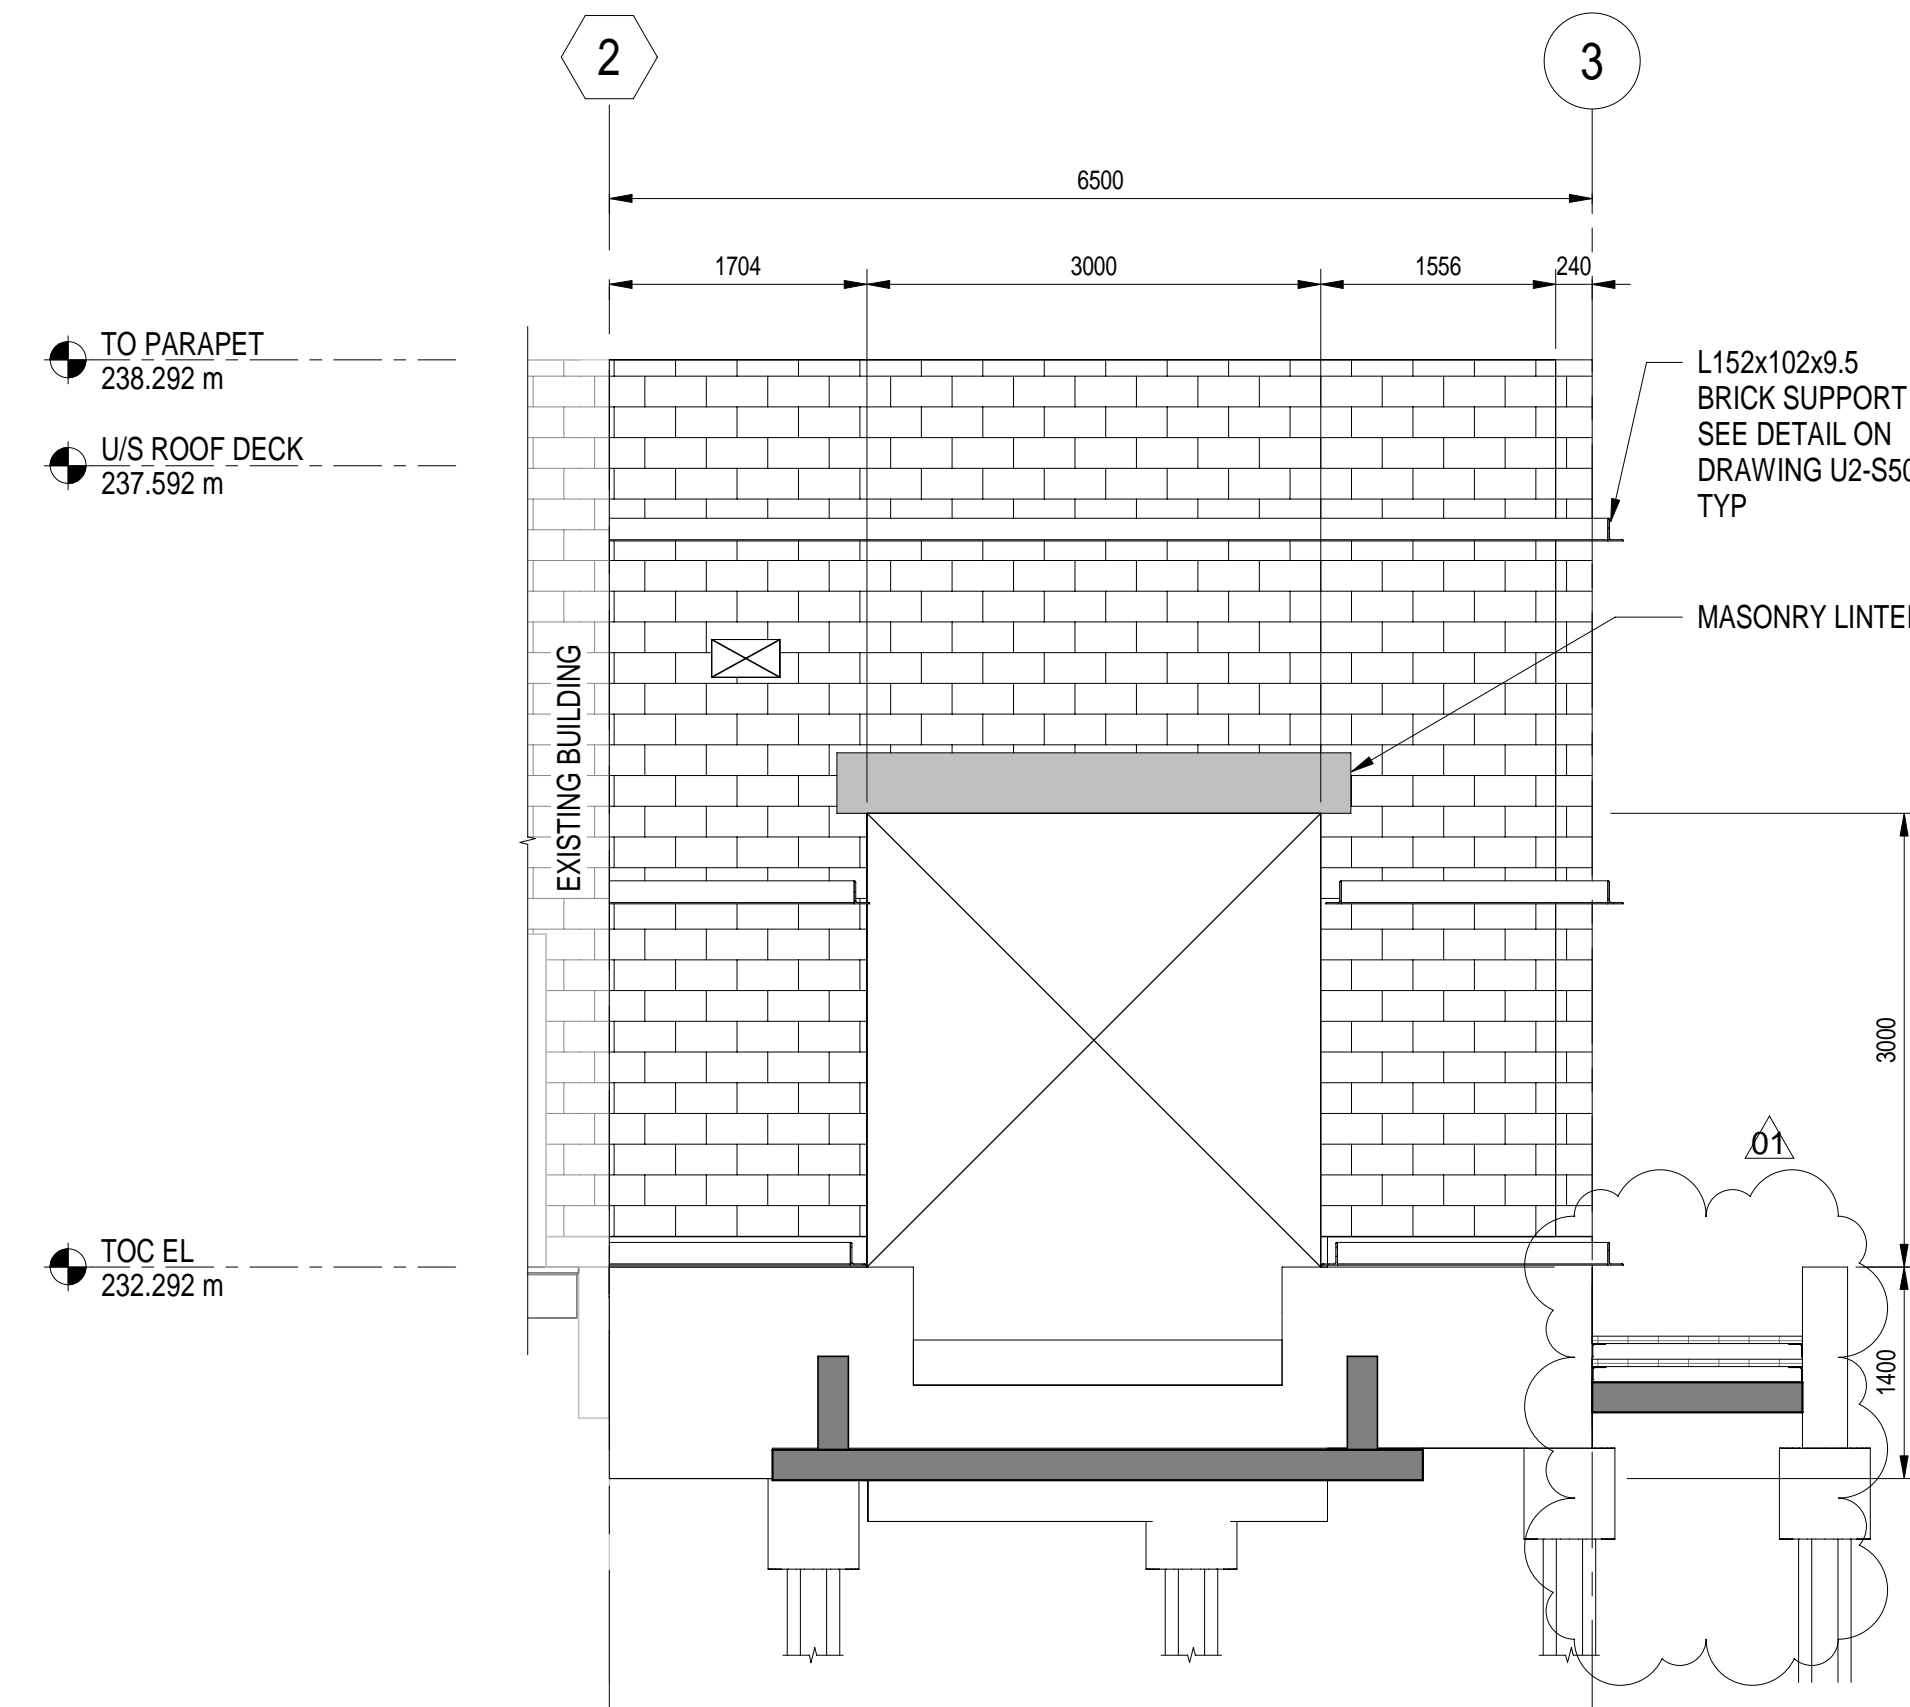


SOUTH ELEVATION - NEW UV STORAGE ROOM
SCALE: 1 : 50

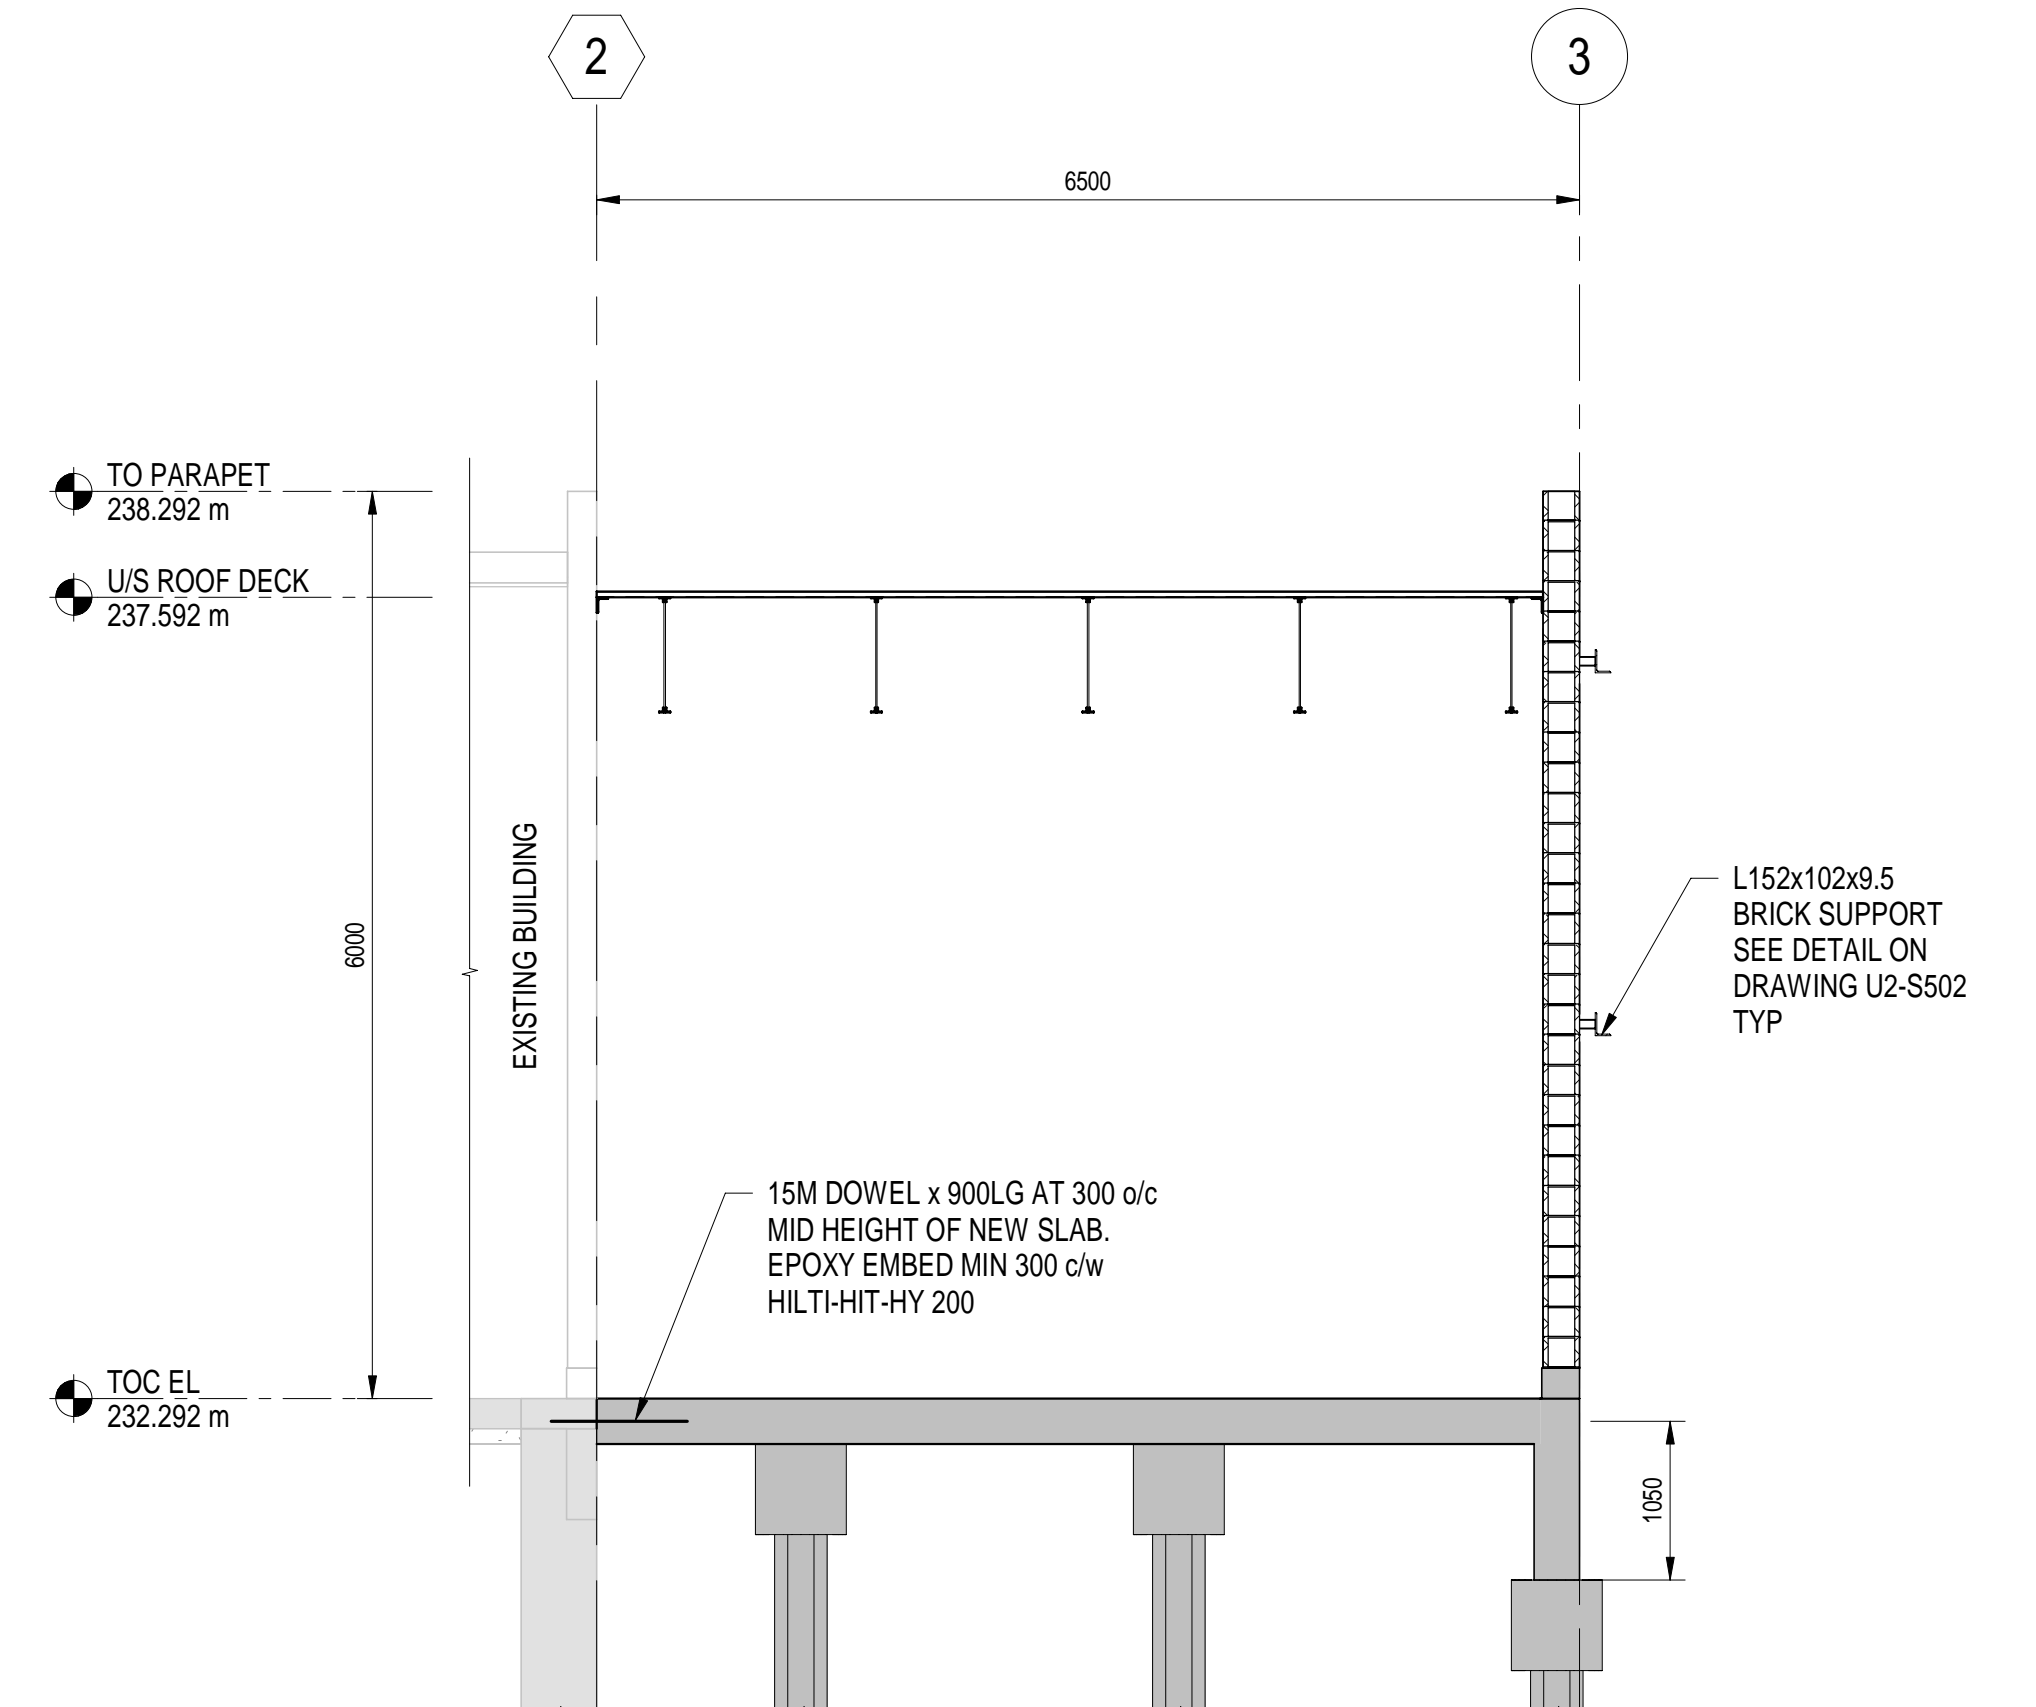

1 SECTION
U2-S102

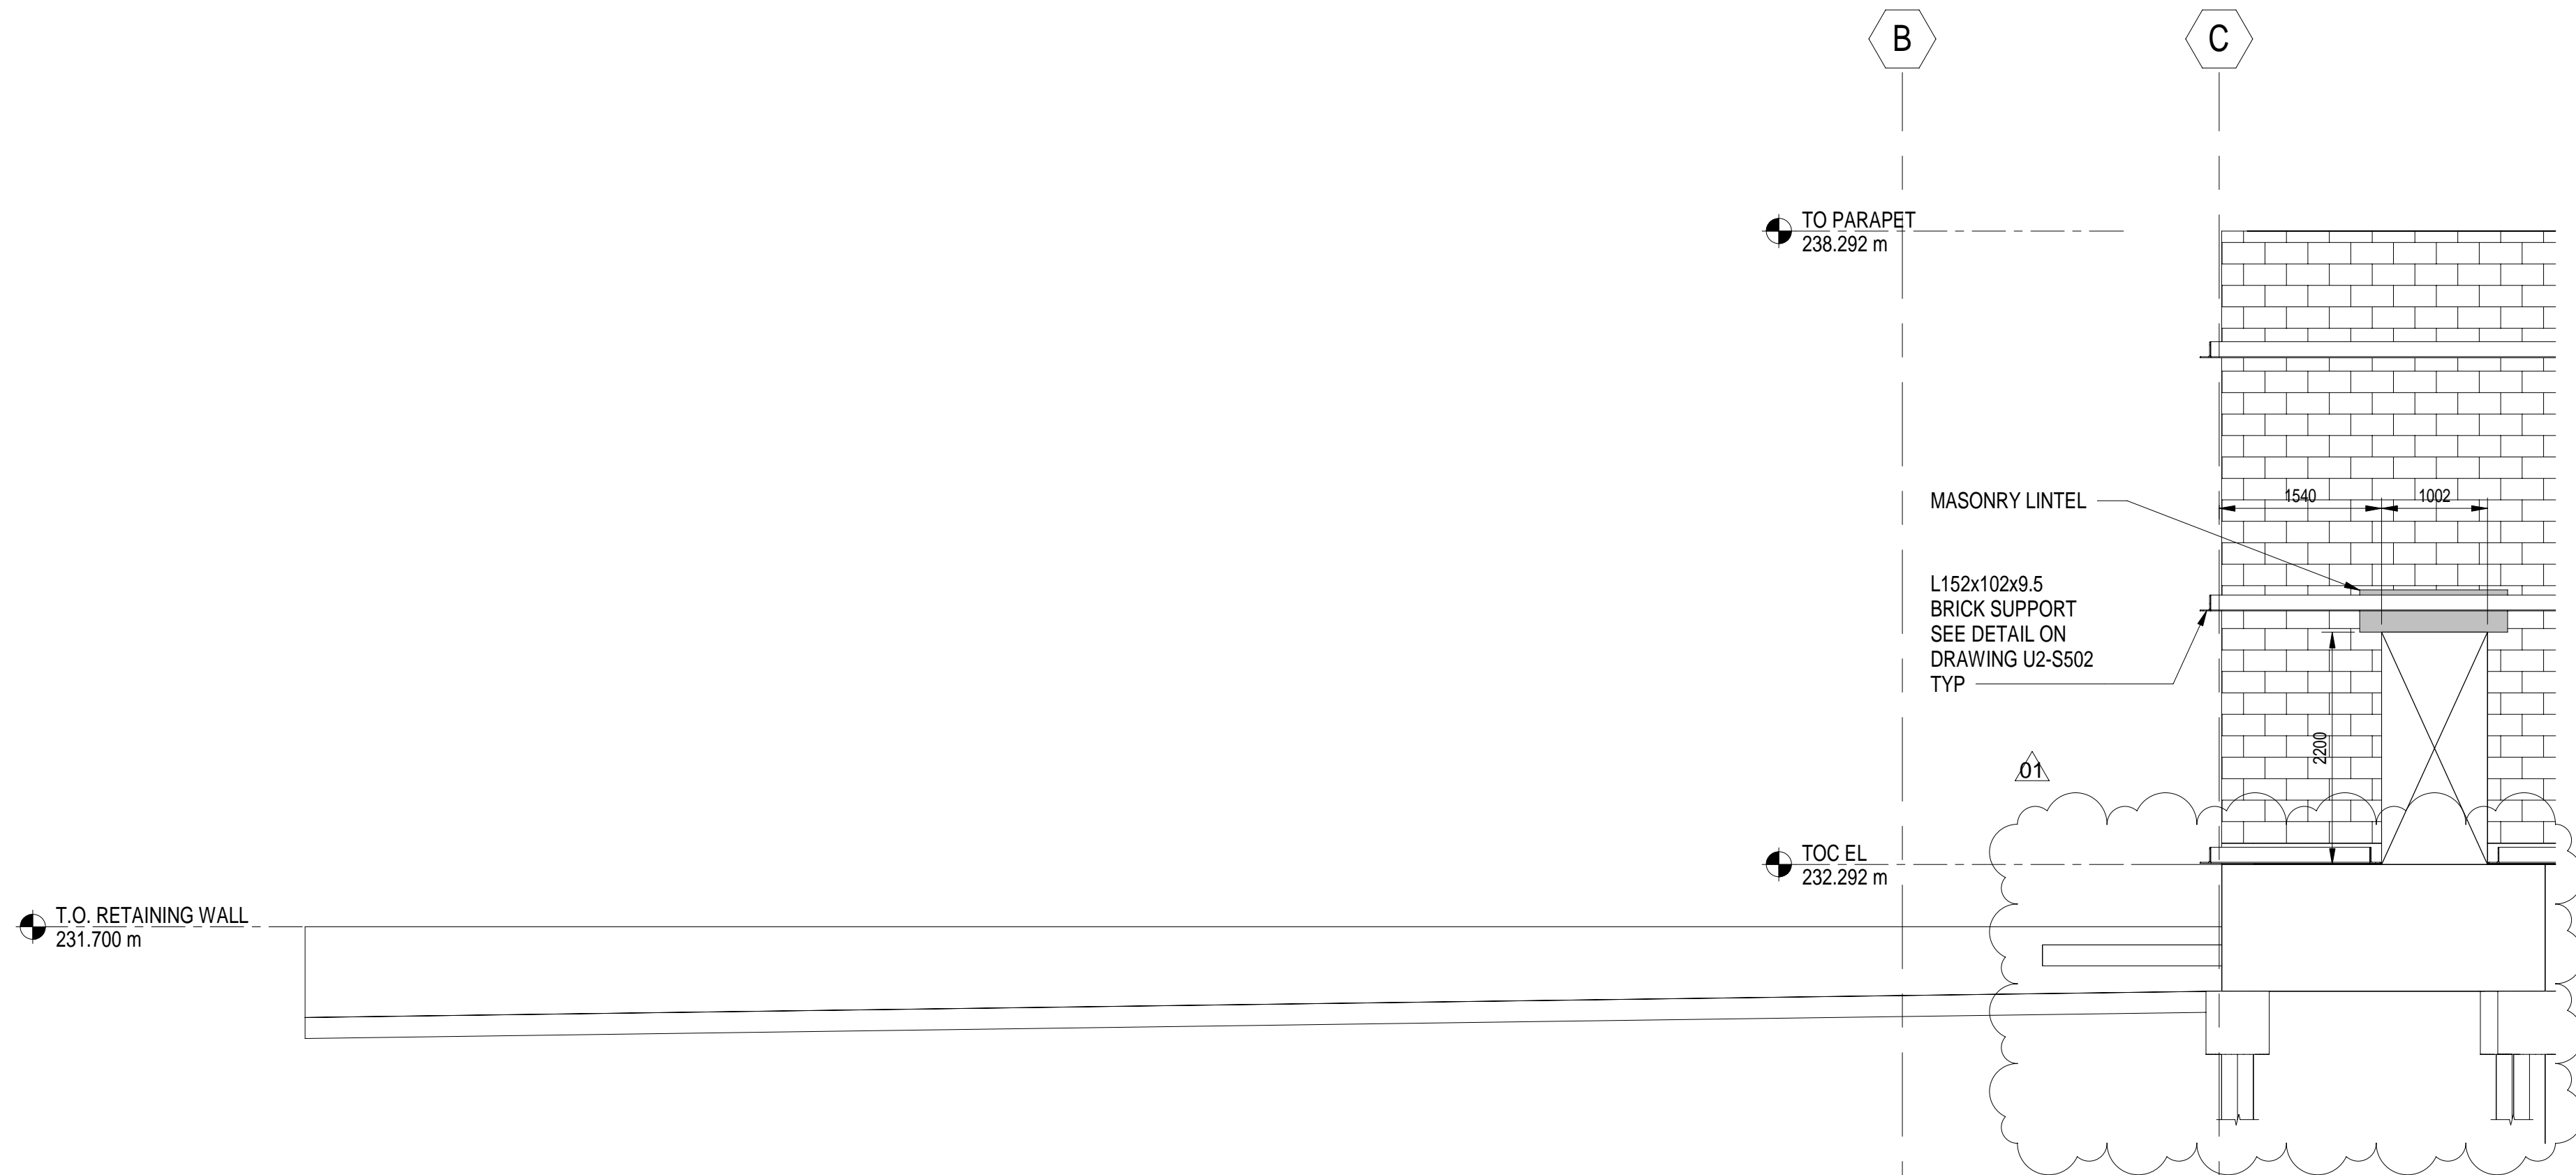

PARTIAL EAST ELEVATION - NEW UV STORAGE ROOM
SCALE: 1 : 50

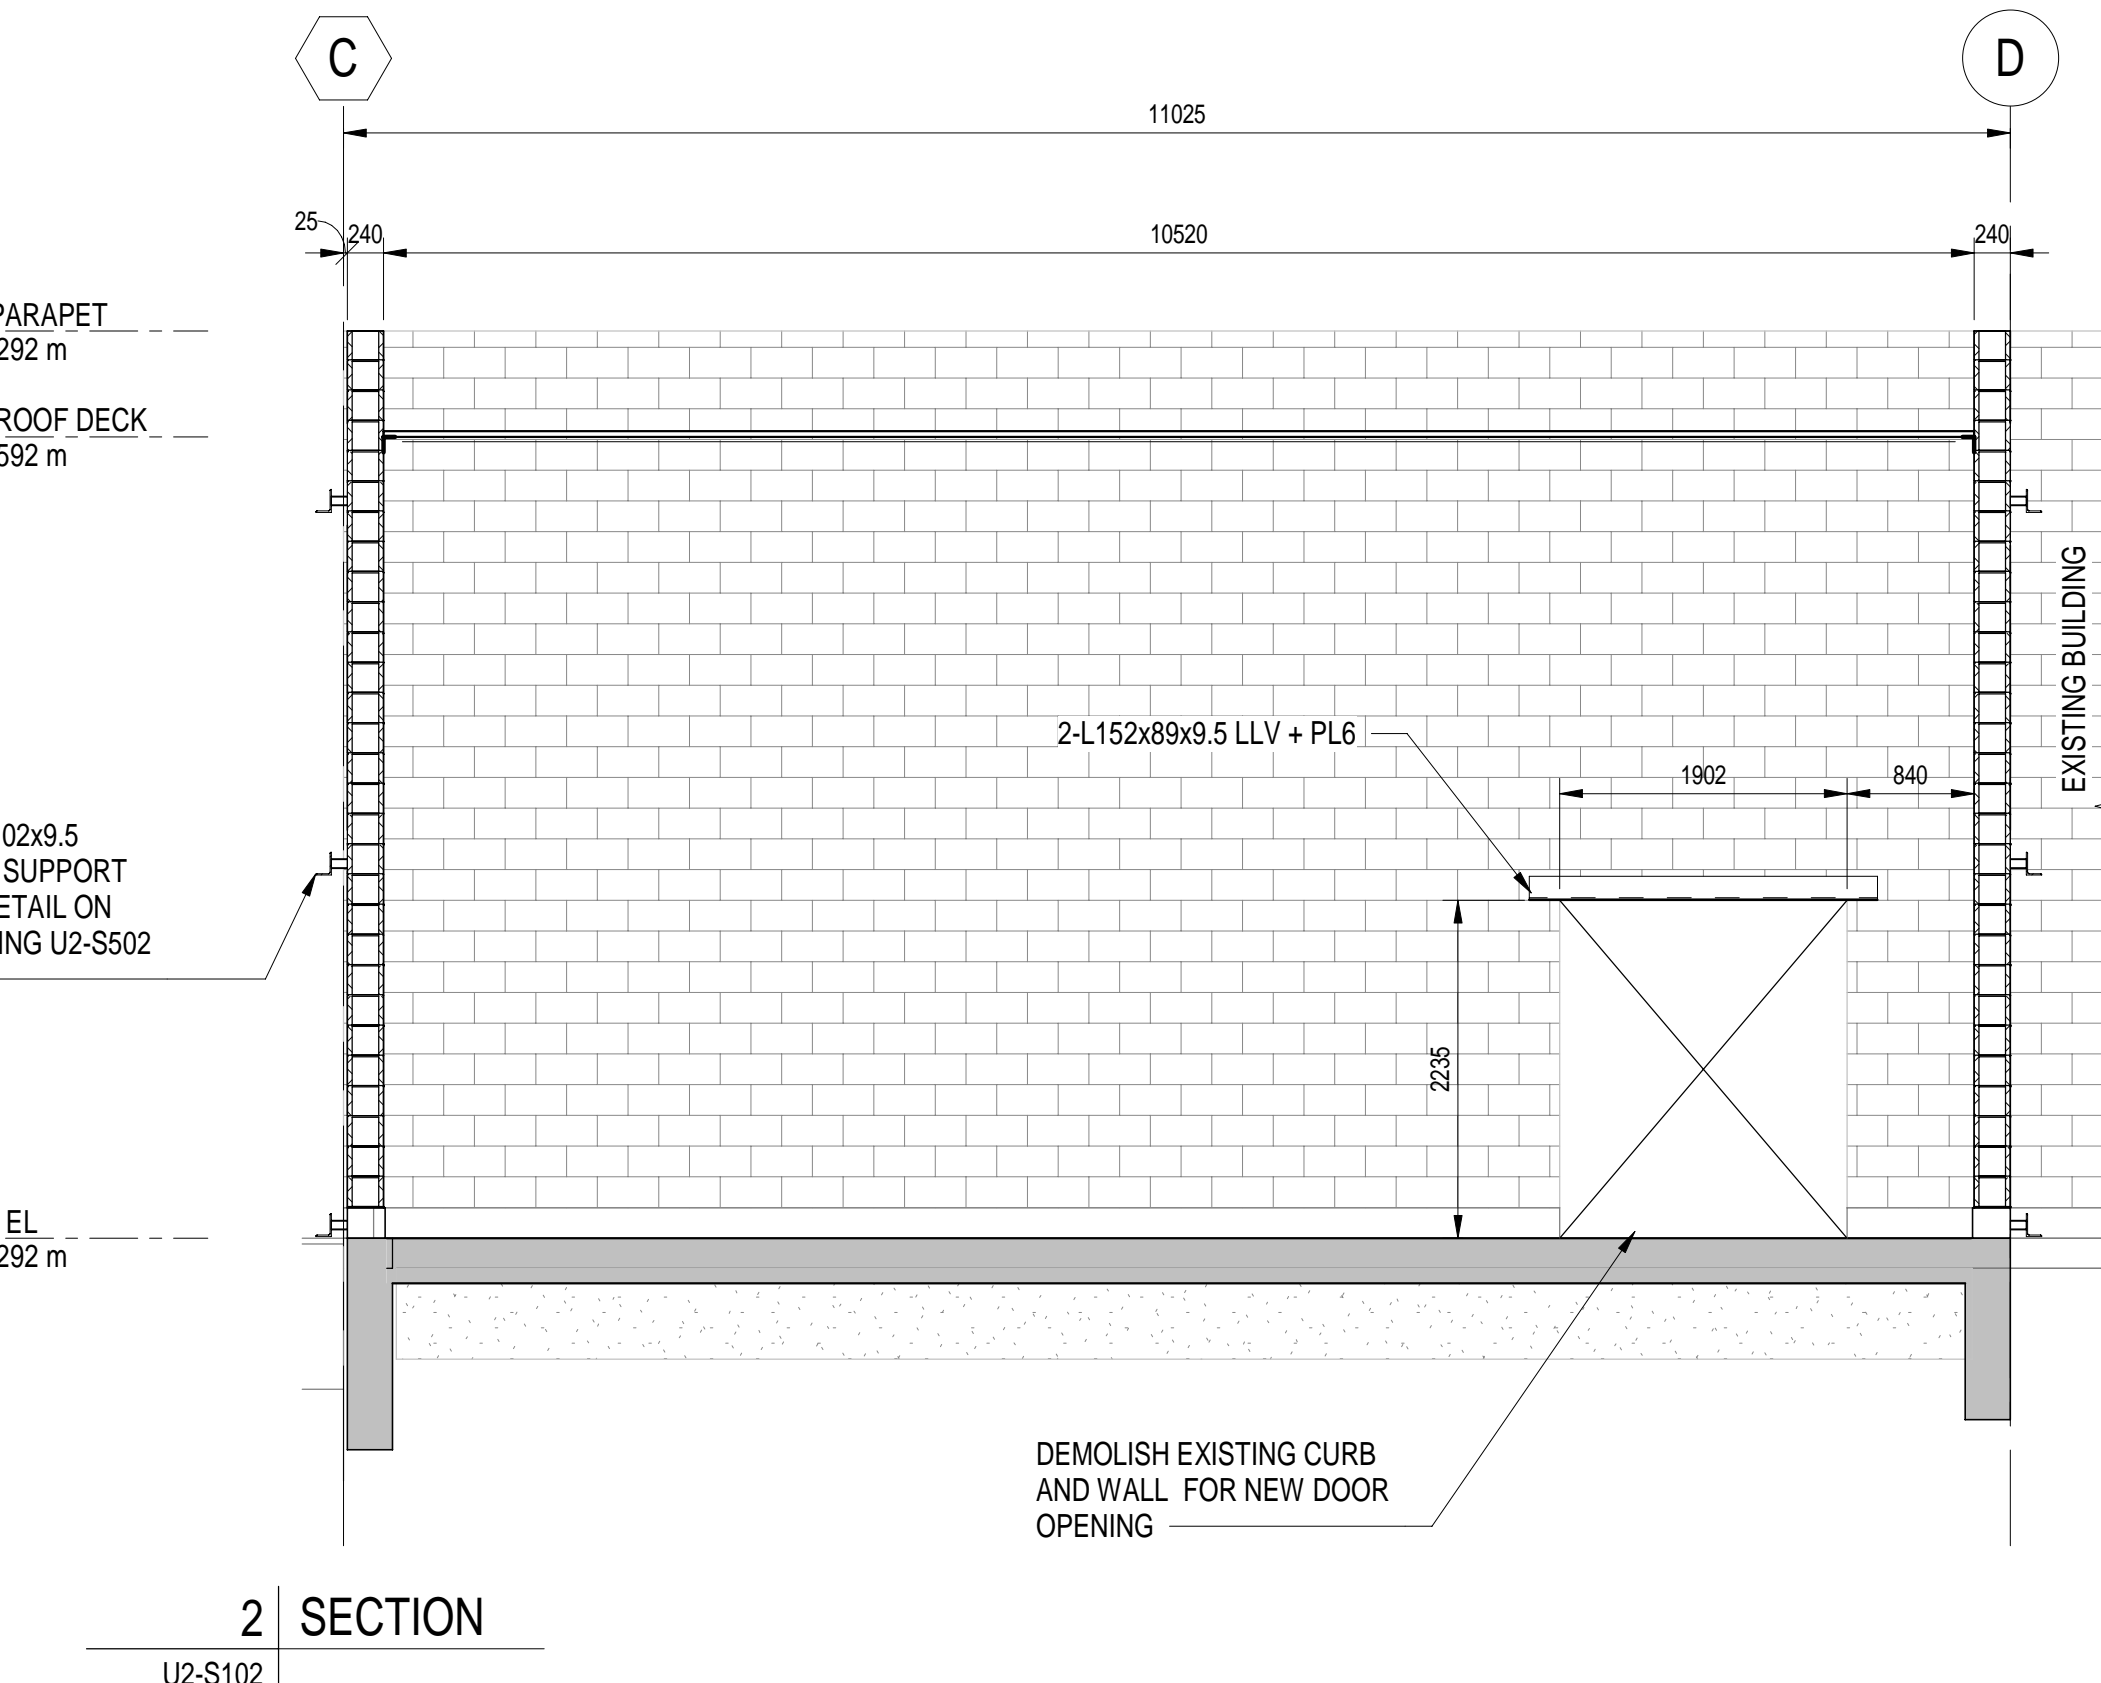

2 SECTION
U2-S102



NO.	REVISIONS	DATE	DESIGN	CHECK
01	ISSUED FOR ADDENDUM 7	2025-04-24	CT	MB
00	ISSUED FOR TENDER	2025-02-26	CT	MB
PA	ISSUED FOR 60% REVIEW	2024-09-06	MB	CK

AECOM	
DESIGNED BY: MB	CHECKED BY: CK
DRAWN BY: MK	APPROVED BY: NW
SCALE: 1 : 50	RELEASED FOR CONSTRUCTION
DATE: 2023-07-24	BY:
DATE:	DATE:
CONSULTANT NO.: U2-S201	



THE CITY OF WINNIPEG WATER AND WASTE DEPARTMENT			
NORTH END SEWAGE TREATMENT PLANT NEWPCC UV UPGRADES STRUCTURAL NEW UV STORAGE ROOM SECTIONS AND ELEVATIONS			
CITY DRAWING NUMBER	SHEET	REV.	SIZE
		01	A1

TENDER NO. 30-2025