


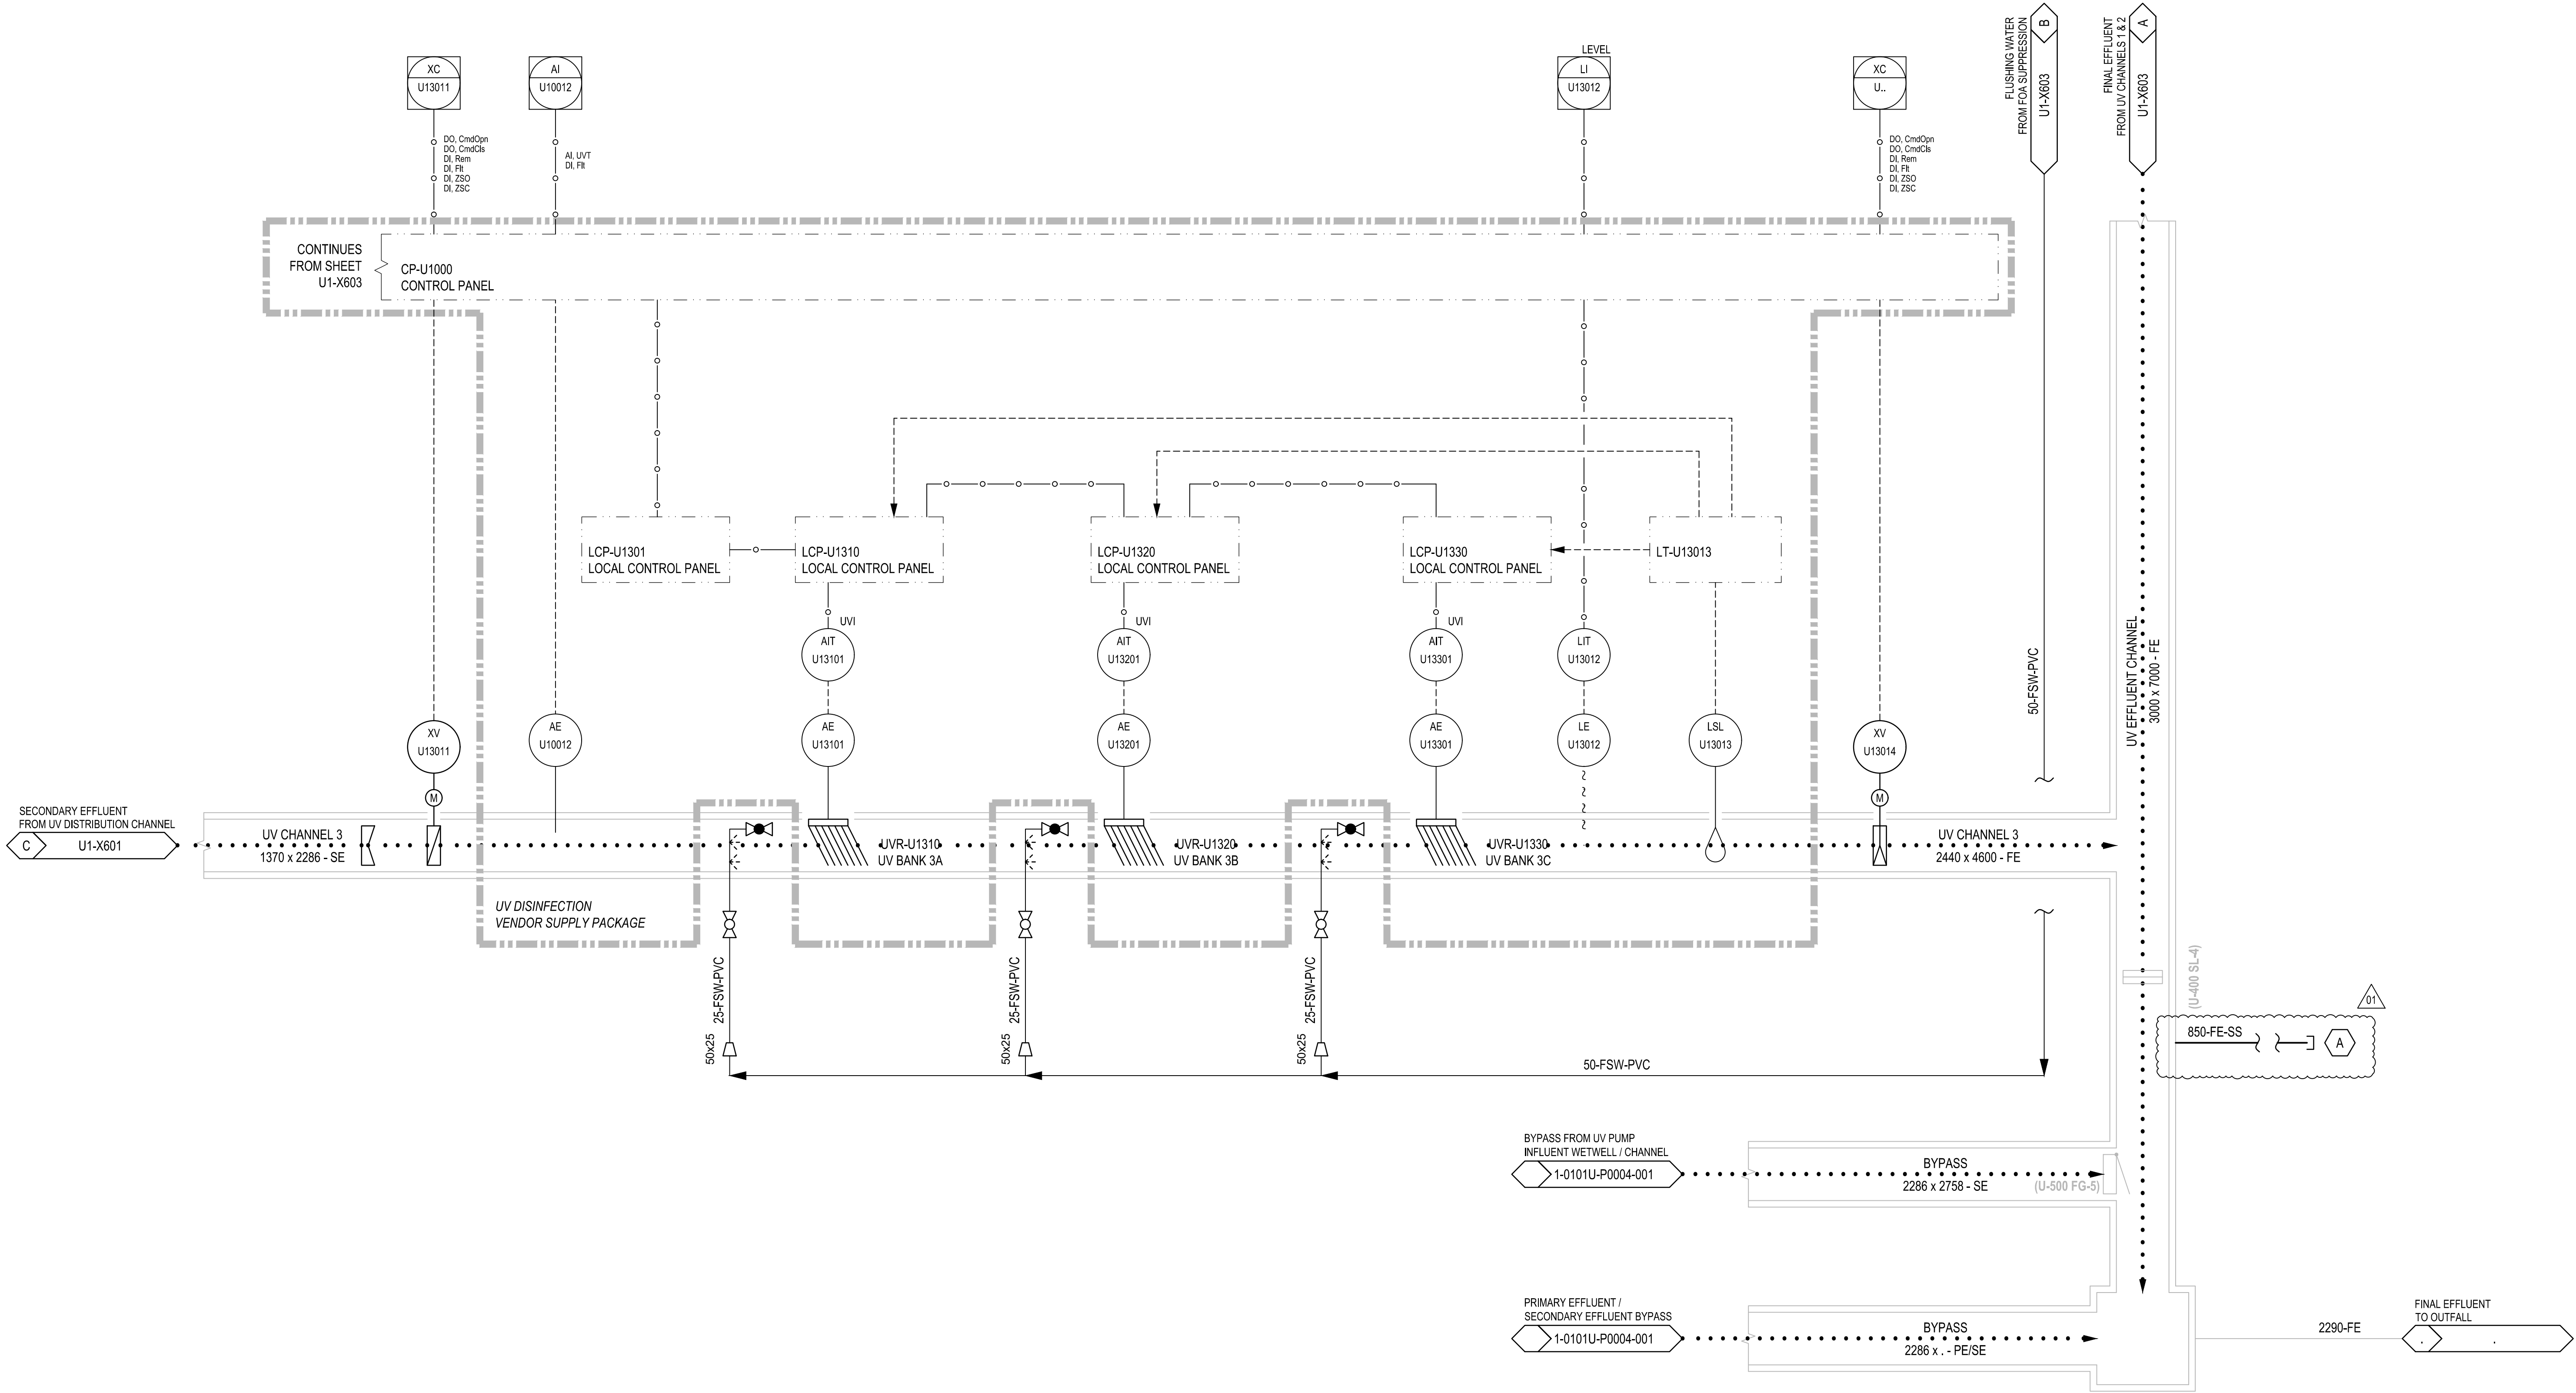


KEYNOTES:
A. FINAL EFFLUENT PIPING TO CONNECT TO CIVIL PIPING. SEE CIVIL DRAWINGS AND SPECIFICATIONS.

GENERAL NOTES:
1. SEE MANUFACTURER'S DRAWINGS FOR COMPREHENSIVE LIST OF FEATURES & I/O.



NO.	REVISIONS	DATE	DESIGN	CHECK
01	ISSUED FOR ADDENDUM 8	2025-04-30	IG	PB
00	ISSUED FOR TENDER	2025-02-26	IG	PB

AECOM	
DESIGNED BY: IG	CHECKED BY: PB
DRAWN BY: MM	APPROVED BY: NW
SCALE: NTS	RELEASED FOR CONSTRUCTION BY:
DATE: 2023-07-24	DATE:
CONSULTANT NO.:	U1-X604

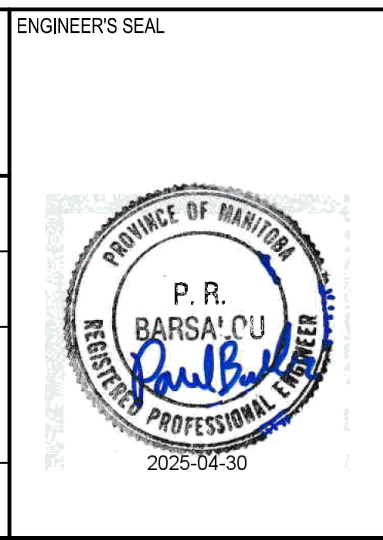

THE CITY OF WINNIPEG WATER AND WASTE DEPARTMENT			
NORTH END SEWAGE TREATMENT PLANT NEWPCC UV UPGRADES PROCESS & INSTRUMENTATION DIAGRAM UV DISINFECTION FACILITY UV CHANNEL 3			
CITY DRAWING NUMBER	SHEET	REV.	SIZE
	-	01	A1

TENDER NO. 30-2025