




GENERAL ARRANGEMENT
SCALE 1:300

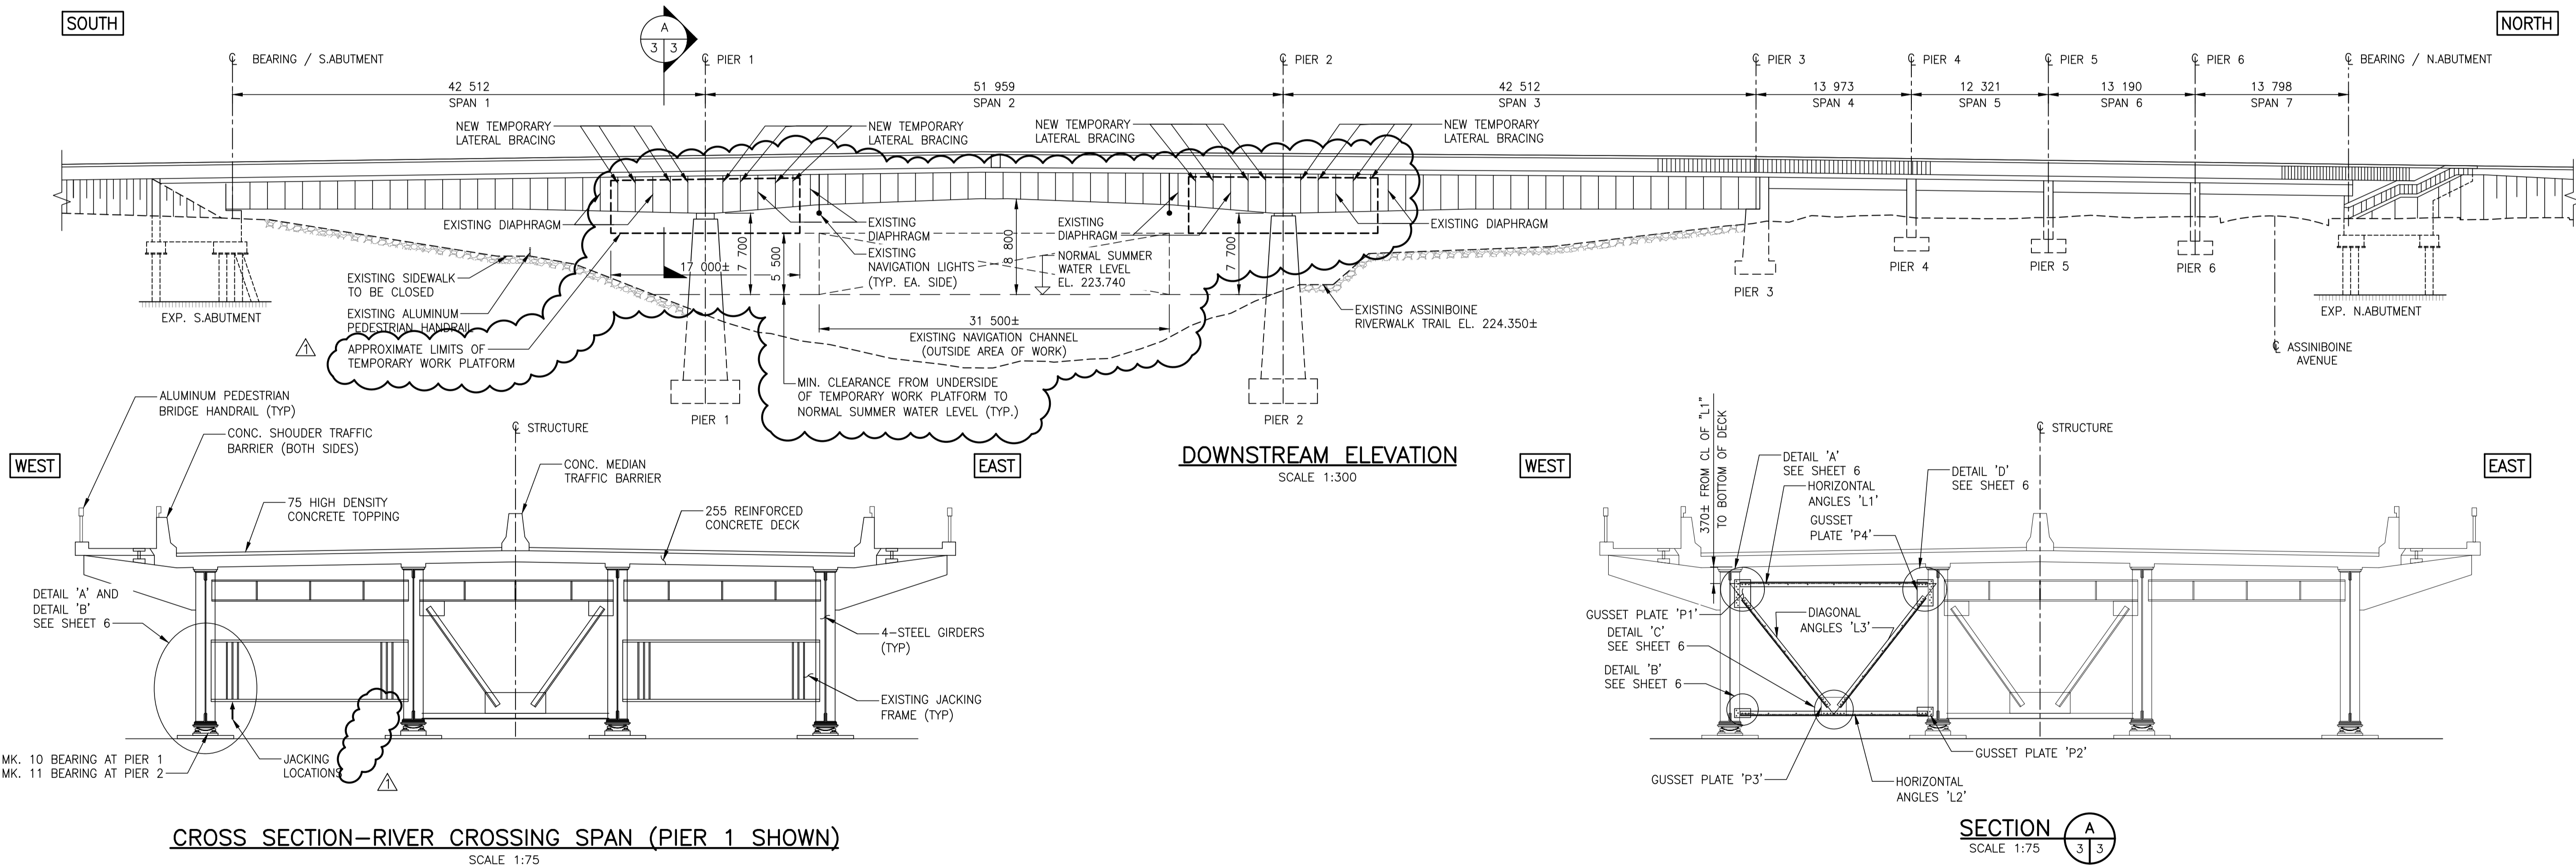

DOWNSTREAM ELEVATION
SCALE 1:300

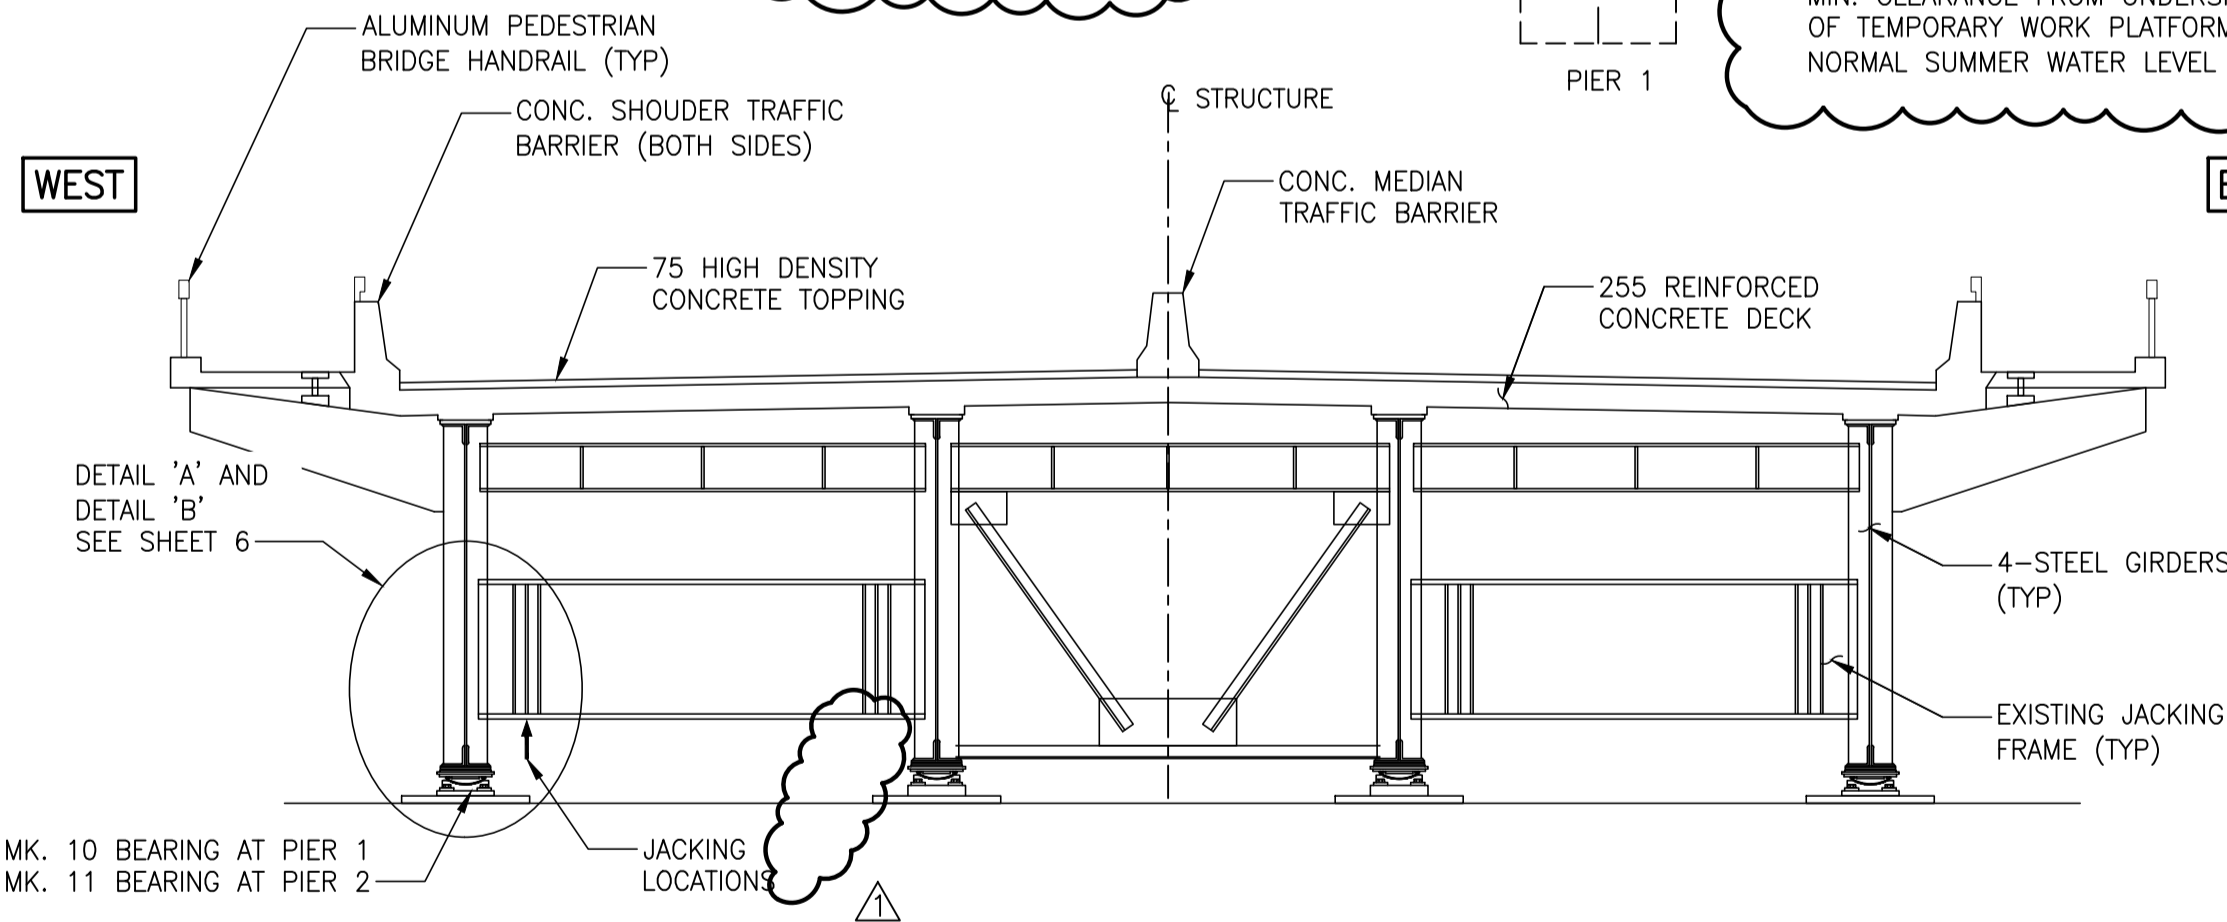

CROSS SECTION-RIVER CROSSING SPAN (PIER 1 SHOWN)
SCALE 1:75

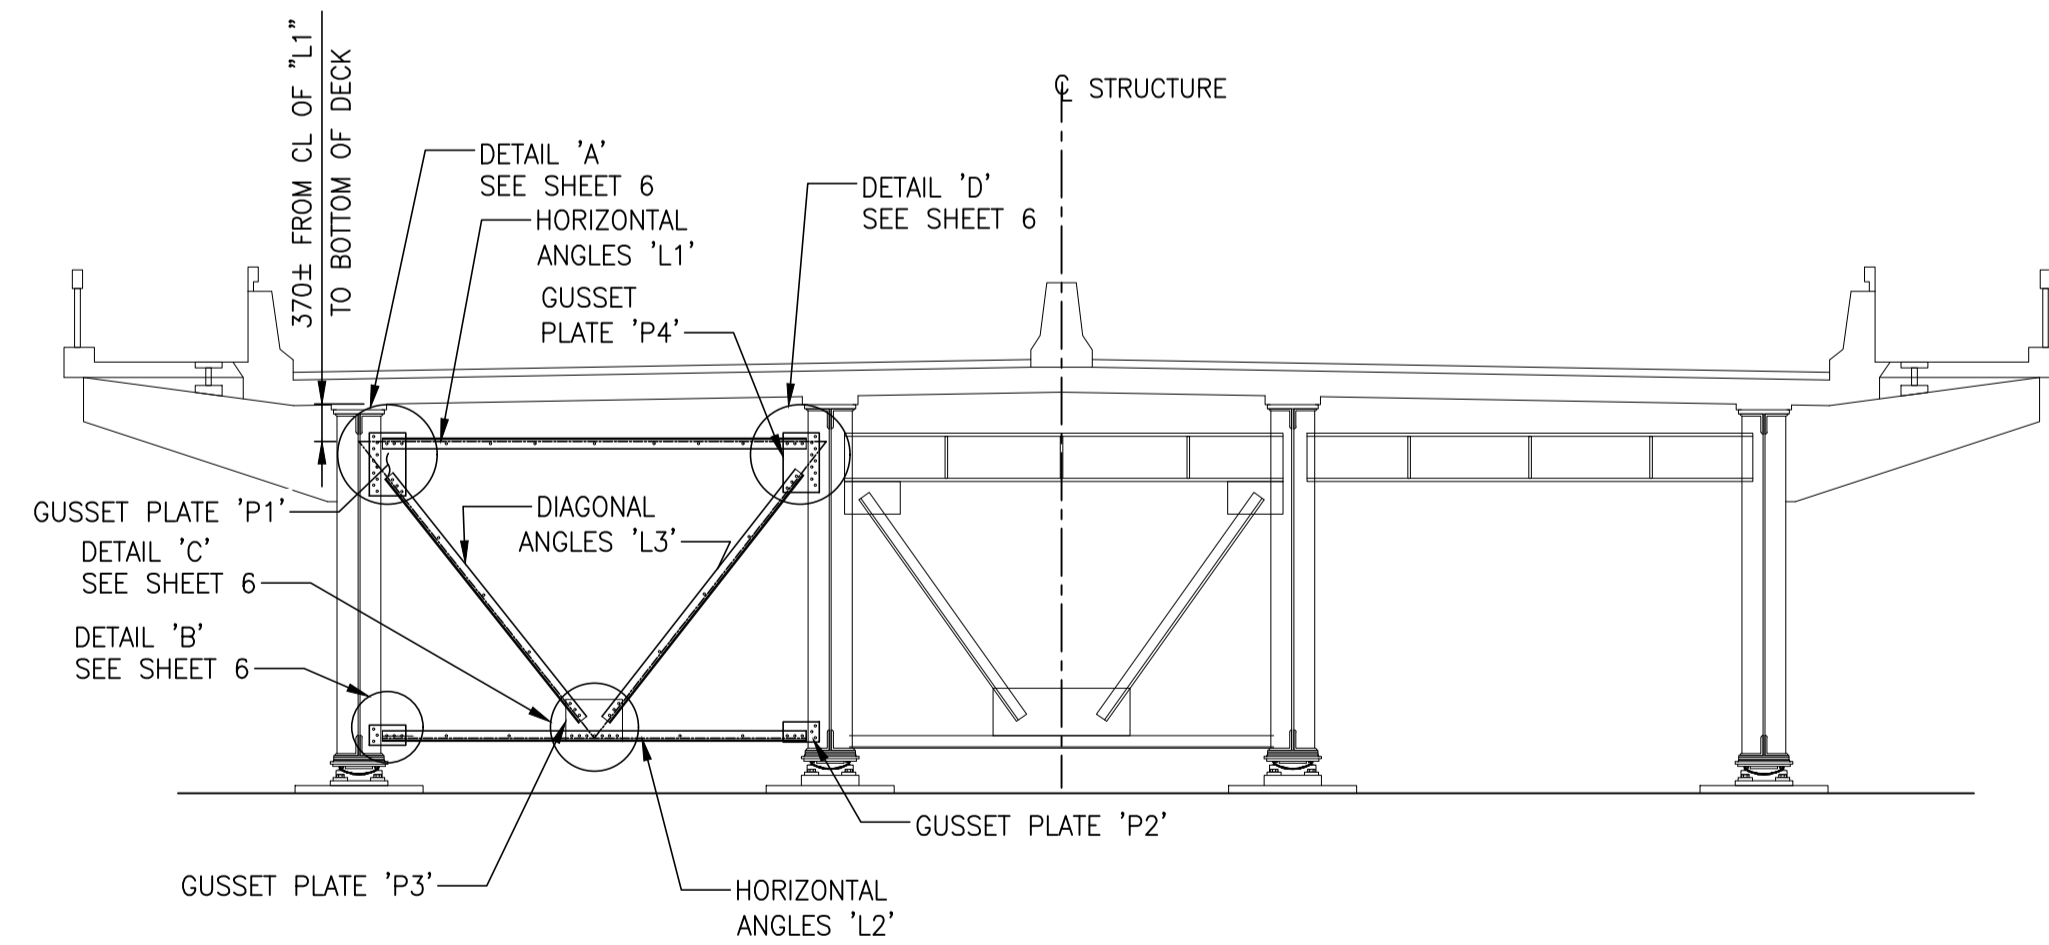




SECTION A-A
SCALE 1:75

NEW TEMPORARY LATERAL BRACING 8 REQUIRED
AT PIER 1 AND PIER 2 (16 TOTAL)

METRIC
WHOLE NUMBERS INDICATE MILLIMETRES
DECIMALIZED NUMBERS INDICATE METRES



NOTE:
These design documents are prepared solely for the use by the party with whom the design professional has entered into a contract and there are no representations of any kind made by the design professional to any party with whom the design professional has not entered into a contract.

LOCATIONS APPROVED UNDERGROUND STRUCTURES				G.B.M.								WSP Canada Inc. 1600 Buffalo Place Winnipeg MB R3T 6S8 T+ 1 204-943-3178 www.wsp.com								 THE CITY OF WINNIPEG PUBLIC WORKS DEPARTMENT ENGINEERING DIVISION			
ELEV.																							
SIGNED BY: _____								DESIGNED BY GN				CHECKED BY EH											
SUPV U/G STRUCTURES				DATE																			
LOCATION OF UNDERGROUND STRUCTURES AS SHOWN ARE BASED ON THE BEST INFORMATION AVAILABLE BUT NO GUARANTEE IS GIVEN THAT ALL EXISTING UTILITIES ARE SHOWN OR THAT THE GIVEN LOCATIONS ARE EXACT CONFIRMATION OF EXISTENCE AND EXACT LOCATION OF ALL SERVICES MUST BE OBTAINED FROM THE INDIVIDUAL UTILITIES BEFORE PROCEEDING								DRAWN BY BK				APPROVED BY MLW											
				1 REVISED FOR ADDENDUM No. 3				25.06.12				MLW											
				0 ISSUED FOR TENDER				25.05.13				MLW											
				No. REVISIONS				DATE				BY											
								DATE				DATE											
								25.05.13															