A1 SIZE – 594mm x 841mm

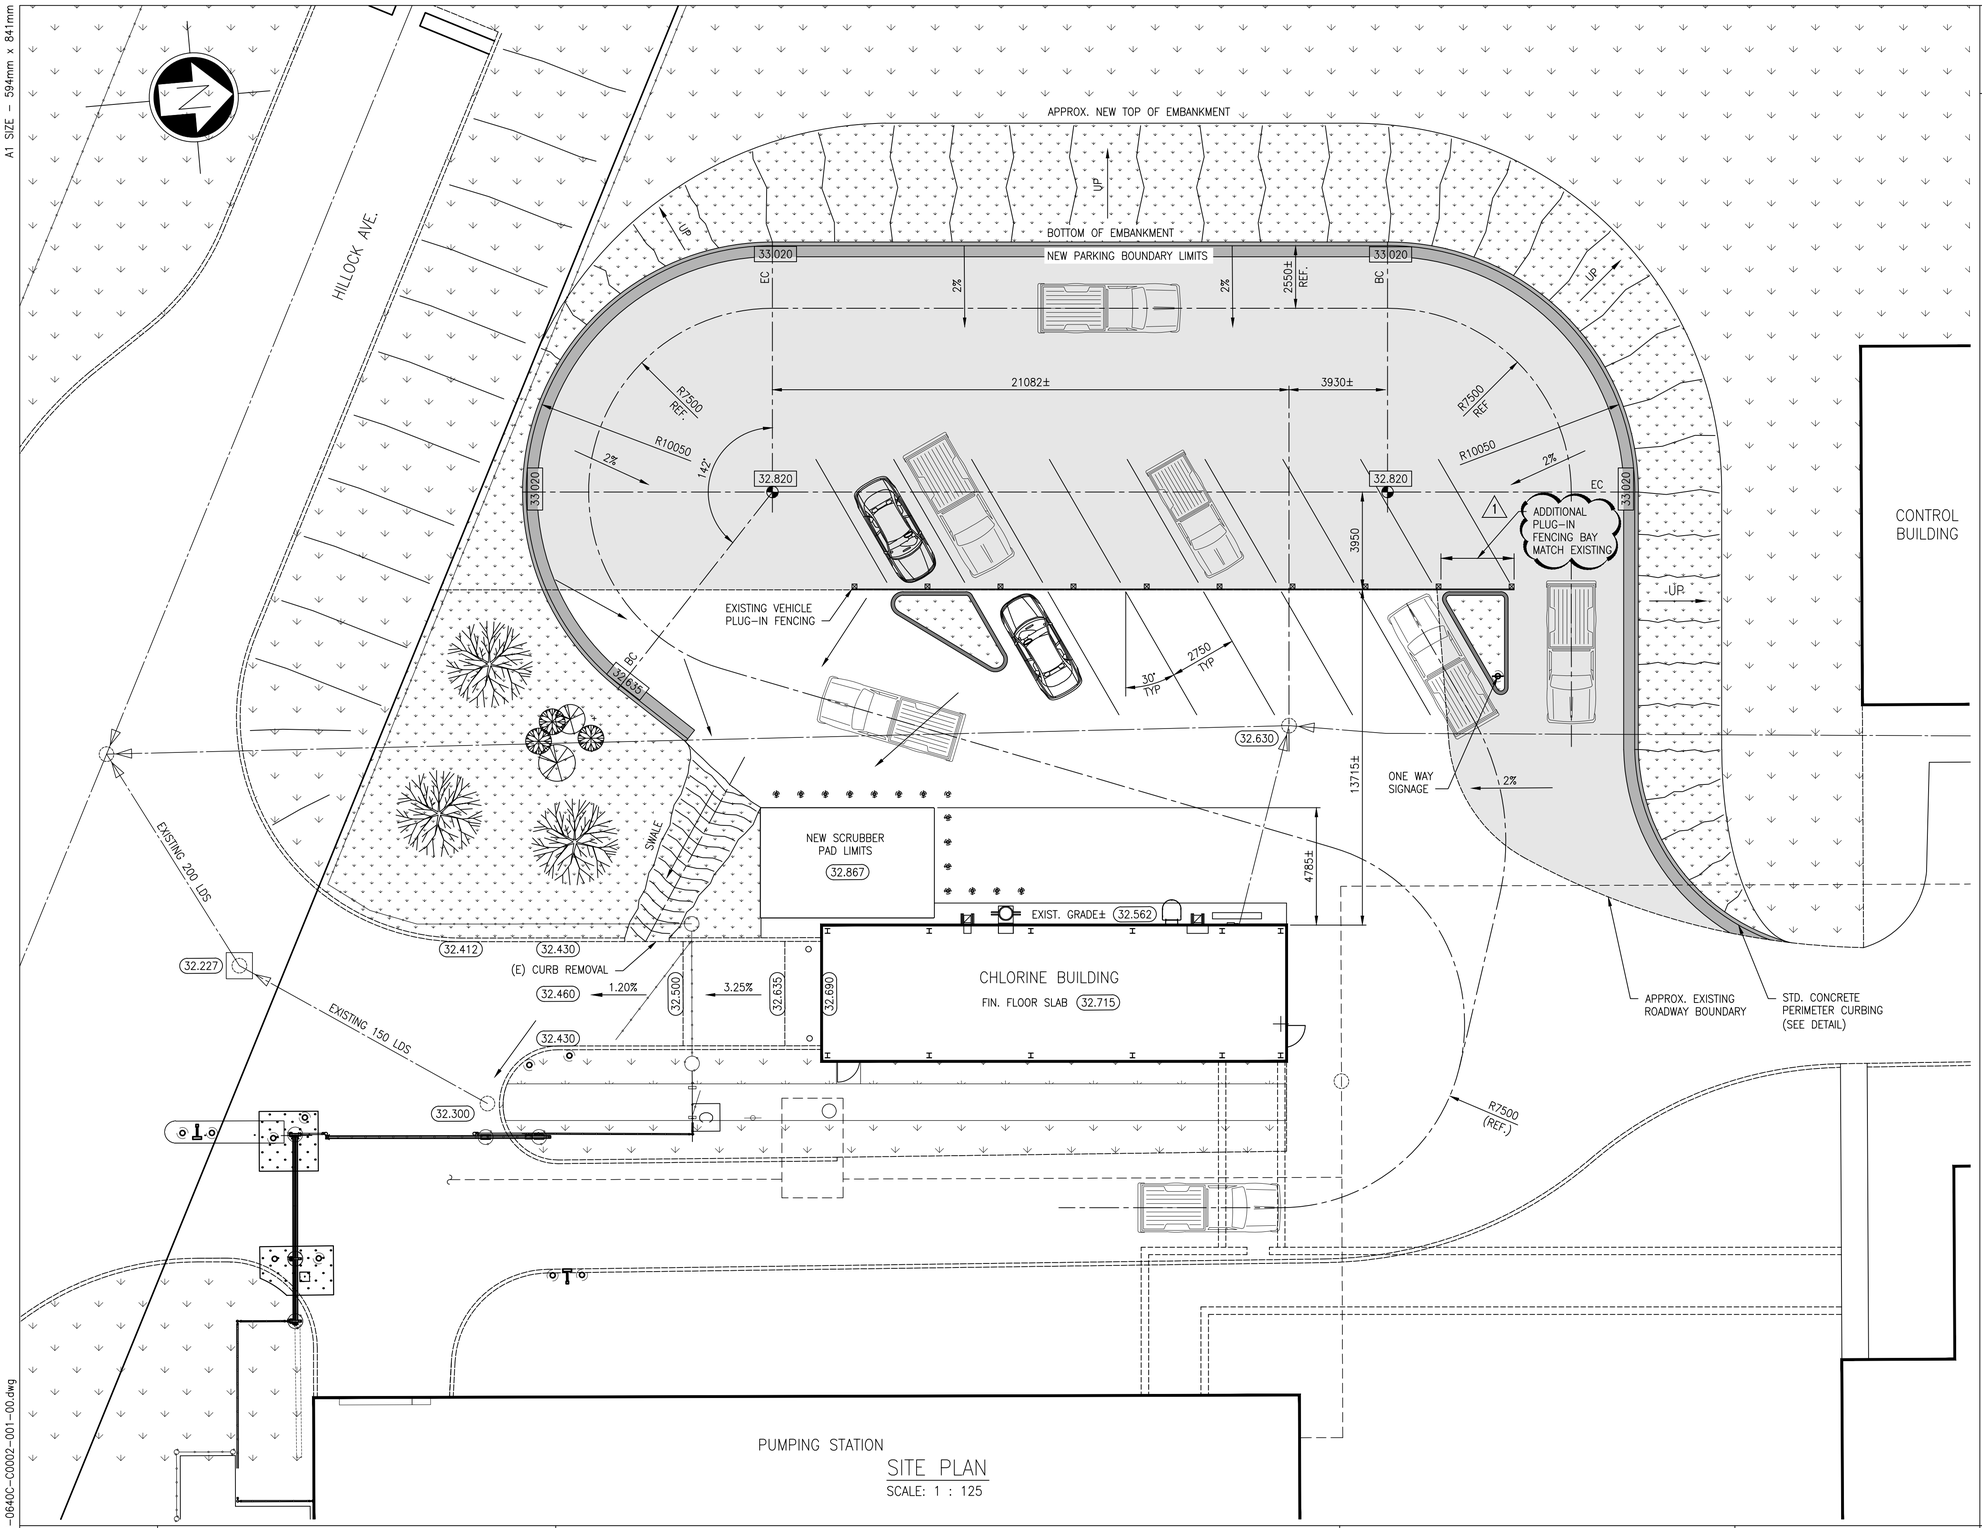

SITE PLAN
SCALE: 1 : 125

NOTES:

1. SEE DRAWING 1–0640C–S0001–001 & 1–0640C–S0001–002 FOR GENERAL NOTES.

SPECIFIC NOTES:

1. THE DRAWING IS BASED ON EXISTING CITY OF WINNIPEG DRAWINGS, SATELITE INFO AND NEW DRAWINGS. LOCATIONS & ELEVATIONS SHOWN ARE NOT GUARANTEED TO BE ACCURATE. SITE CONFIRM VIA SURVEY ALL LOCATIONS PRIOR TO COMPLETING ANY WORK.
2. REPORT ALL DISCREPANCIES TO THE CONTRACT ADMINISTRATOR.
3. ALL NEW WORKS TO BE IN ACCORDANCE WITH CITY OF WINNIPEG MANAGEMENT DETAILS & STANDARDS DIVISION 4 – SURFACE WORKS SPECIFICATIONS – LATEST REVISIONS.
4. ALL NEW EARTHWORKS TO BE IN ACCORDANCE WITH CITY OF WINNIPEG STANDARDS CW 3510, CW 3520 & CW 3540.
5. ALL NEW PAVEMENT WORKS TO BE IN ACCORDANCE WITH CITY OF WINNIPEG STANDARDS CW 3110, CW 3235, CW 3240, CW 3310 CW 3325 AND CW 3410.

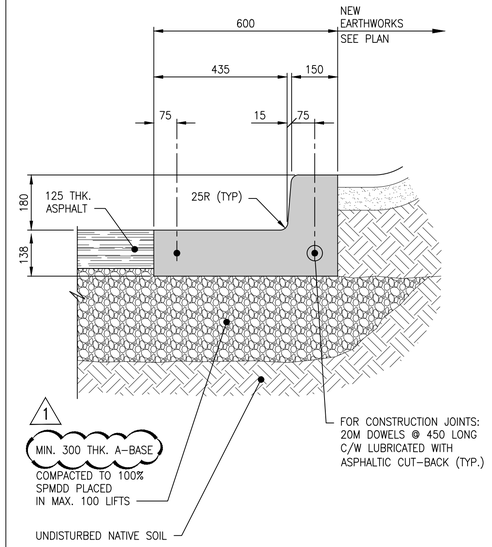

DETAIL – CURB
SCALE: 1 : 10

– C.O.W. REF. DRAWINGS SD–200 & SD–243 –

LEGEND:

- EXISTING GROUND\GRASS
- NEW\REVISED LANDSCAPING
- NEW ASPHALT PARKING SURFACE

DRAWING NUMBER	REFERENCE DRAWINGS
D–6279	McPHILLIPS PUMPING STATION – SITE PLAN
McP–73	McPHILLIPS STREET PUMPING STATION – SITE AND LOCATION PLAN & GENERAL NOTES
McP–32	McPHILLIPS STREET PUMPING STATION – YARD PIPING PROFILES
McP–31	McPHILLIPS STREET PUMPING STATION – YARD PIPING PLAN

METRIC
WHOLE NUMBERS INDICATE MILLIMETRES
DECIMALIZED NUMBERS INDICATE METRES

2 0 2 4 6 8m
1 : 125

0.25 0 0.25 0.5m
1 : 10

ENGINEERS GEOSCIENTISTS MANITOBA
Certificate of Authorization
AtkinsRéalis Canada Inc.
No. 4489

NO.	REVISIONS	DATE	DESIGN	CHECK
01	ISSUED FOR ADDENDUM 7	2025/07/09	KK	BD
00	ISSUED FOR TENDER AND CONSTRUCTION	2025/04/30	KK	FM

AtkinsRéalis
148 Nature Park Way, Winnipeg, Manitoba
Canada R3P 0X7 204-786-8080

DESIGNED BY: K. KOTYK	CHECKED BY: F. MARSHALL
DRAWN BY: B. DICKSON	APPROVED BY: V. ELIMBAN
SCALE: AS SHOWN	ISSUED FOR CONSTRUCTION BY: M. SKINNER
DATE: 2023–10–05	DATE: 2025/04/30
CONSULTANT NO.: 694715	

ENGINEER'S SEAL

Winnipeg
THE CITY OF WINNIPEG
WATER AND WASTE DEPARTMENT

MCPHILLIPS PUMPING STATION
CHLORINE SYSTEM UPGRADES
CIVIL
PARKING LOT EXPANSION
PLAN

CITY DRAWING NUMBER	SHEET	REV.	SIZE
1–0640C–C0002	001	01	A1

1–0640C–C0002–001–00.dwg

LAST SAVE: 2025/07/09 – 9:52am
PATH: C:\Users\dickb\Working Drawings\1–0640C–C0002–001–00.dwg