

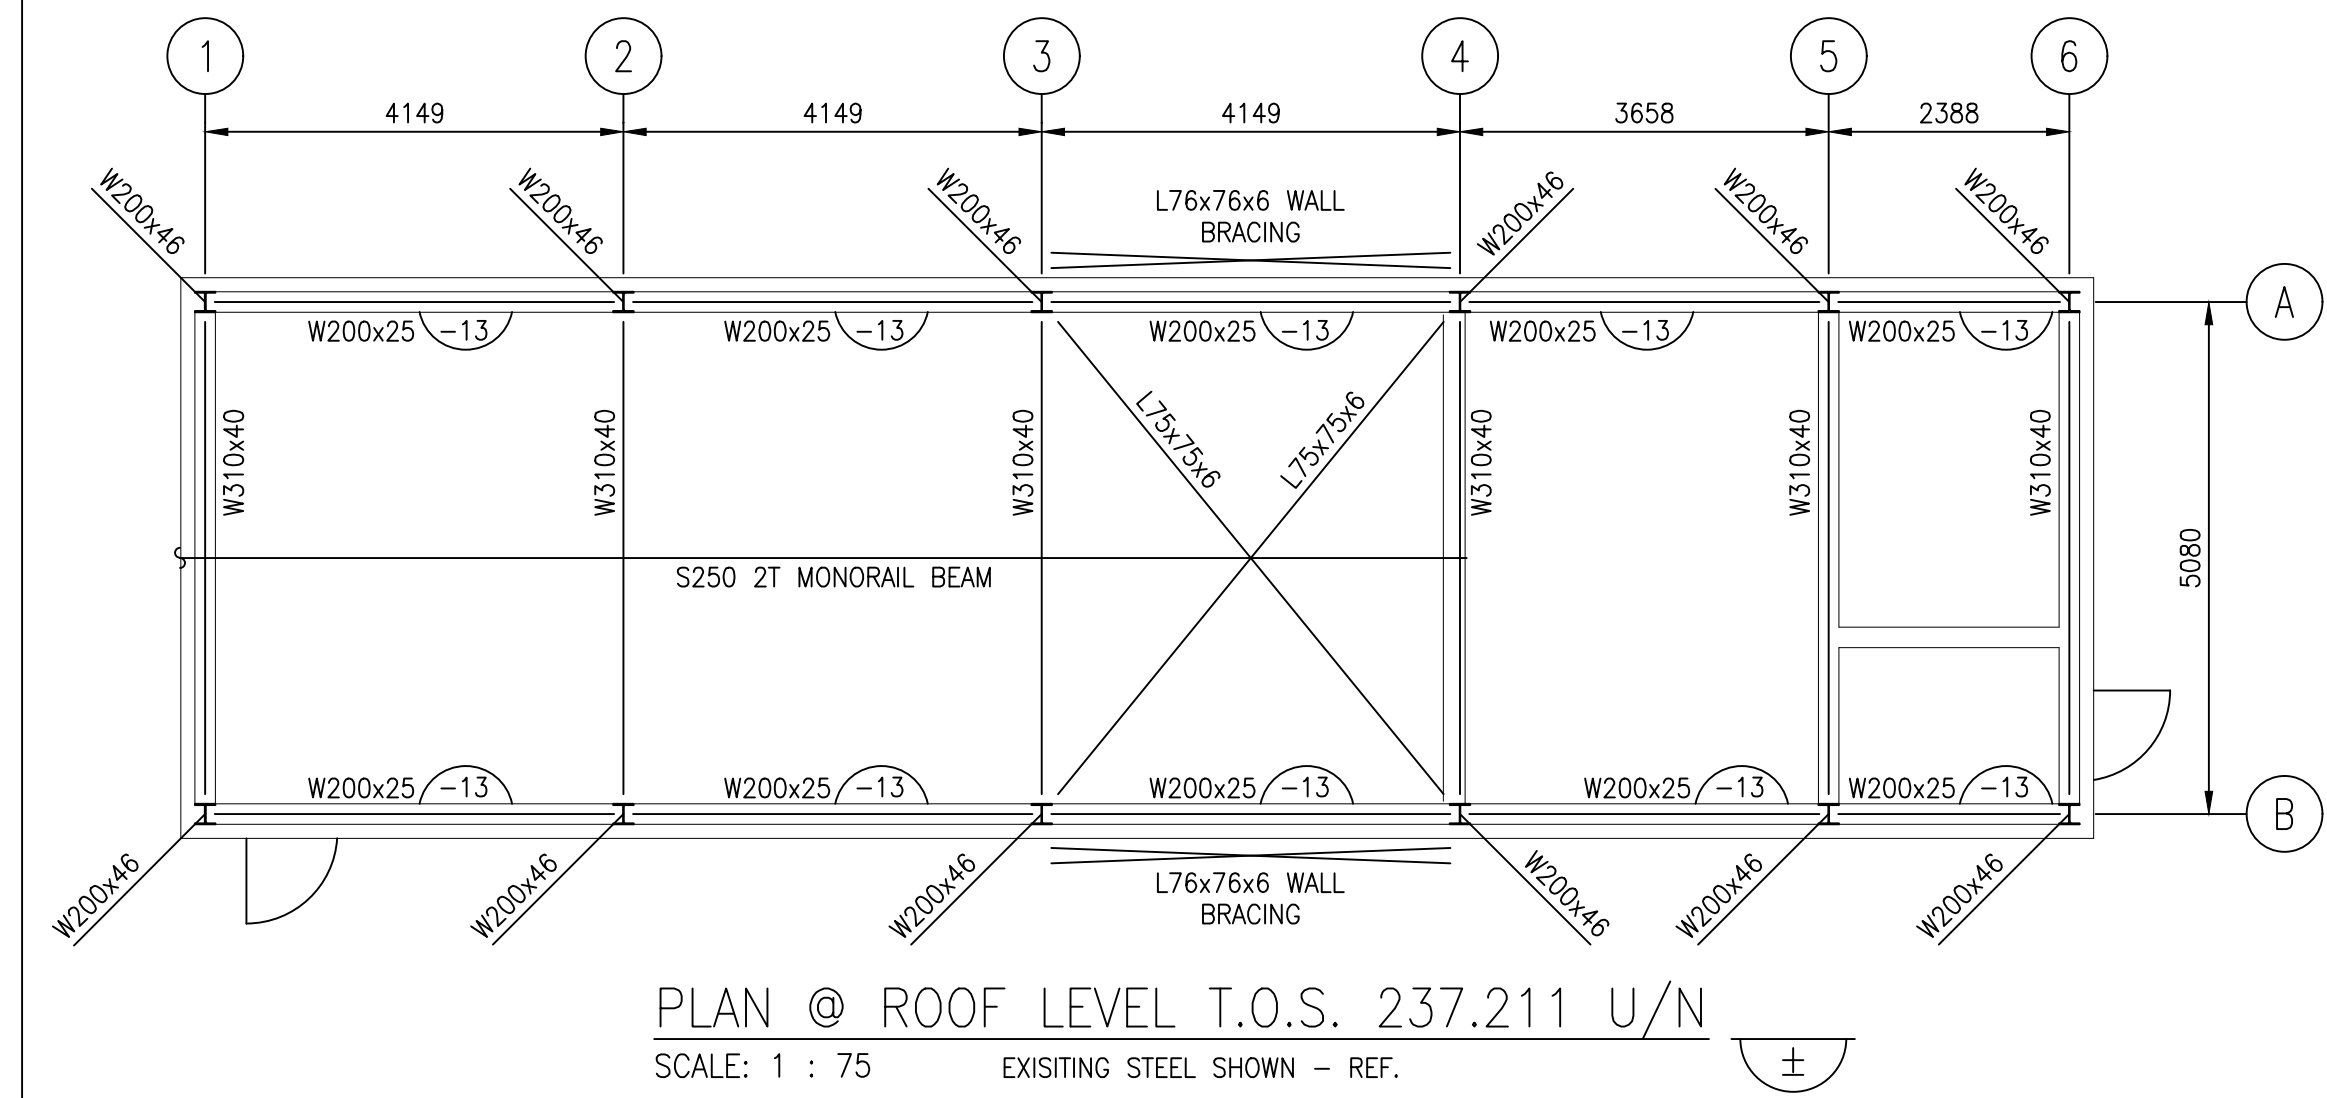
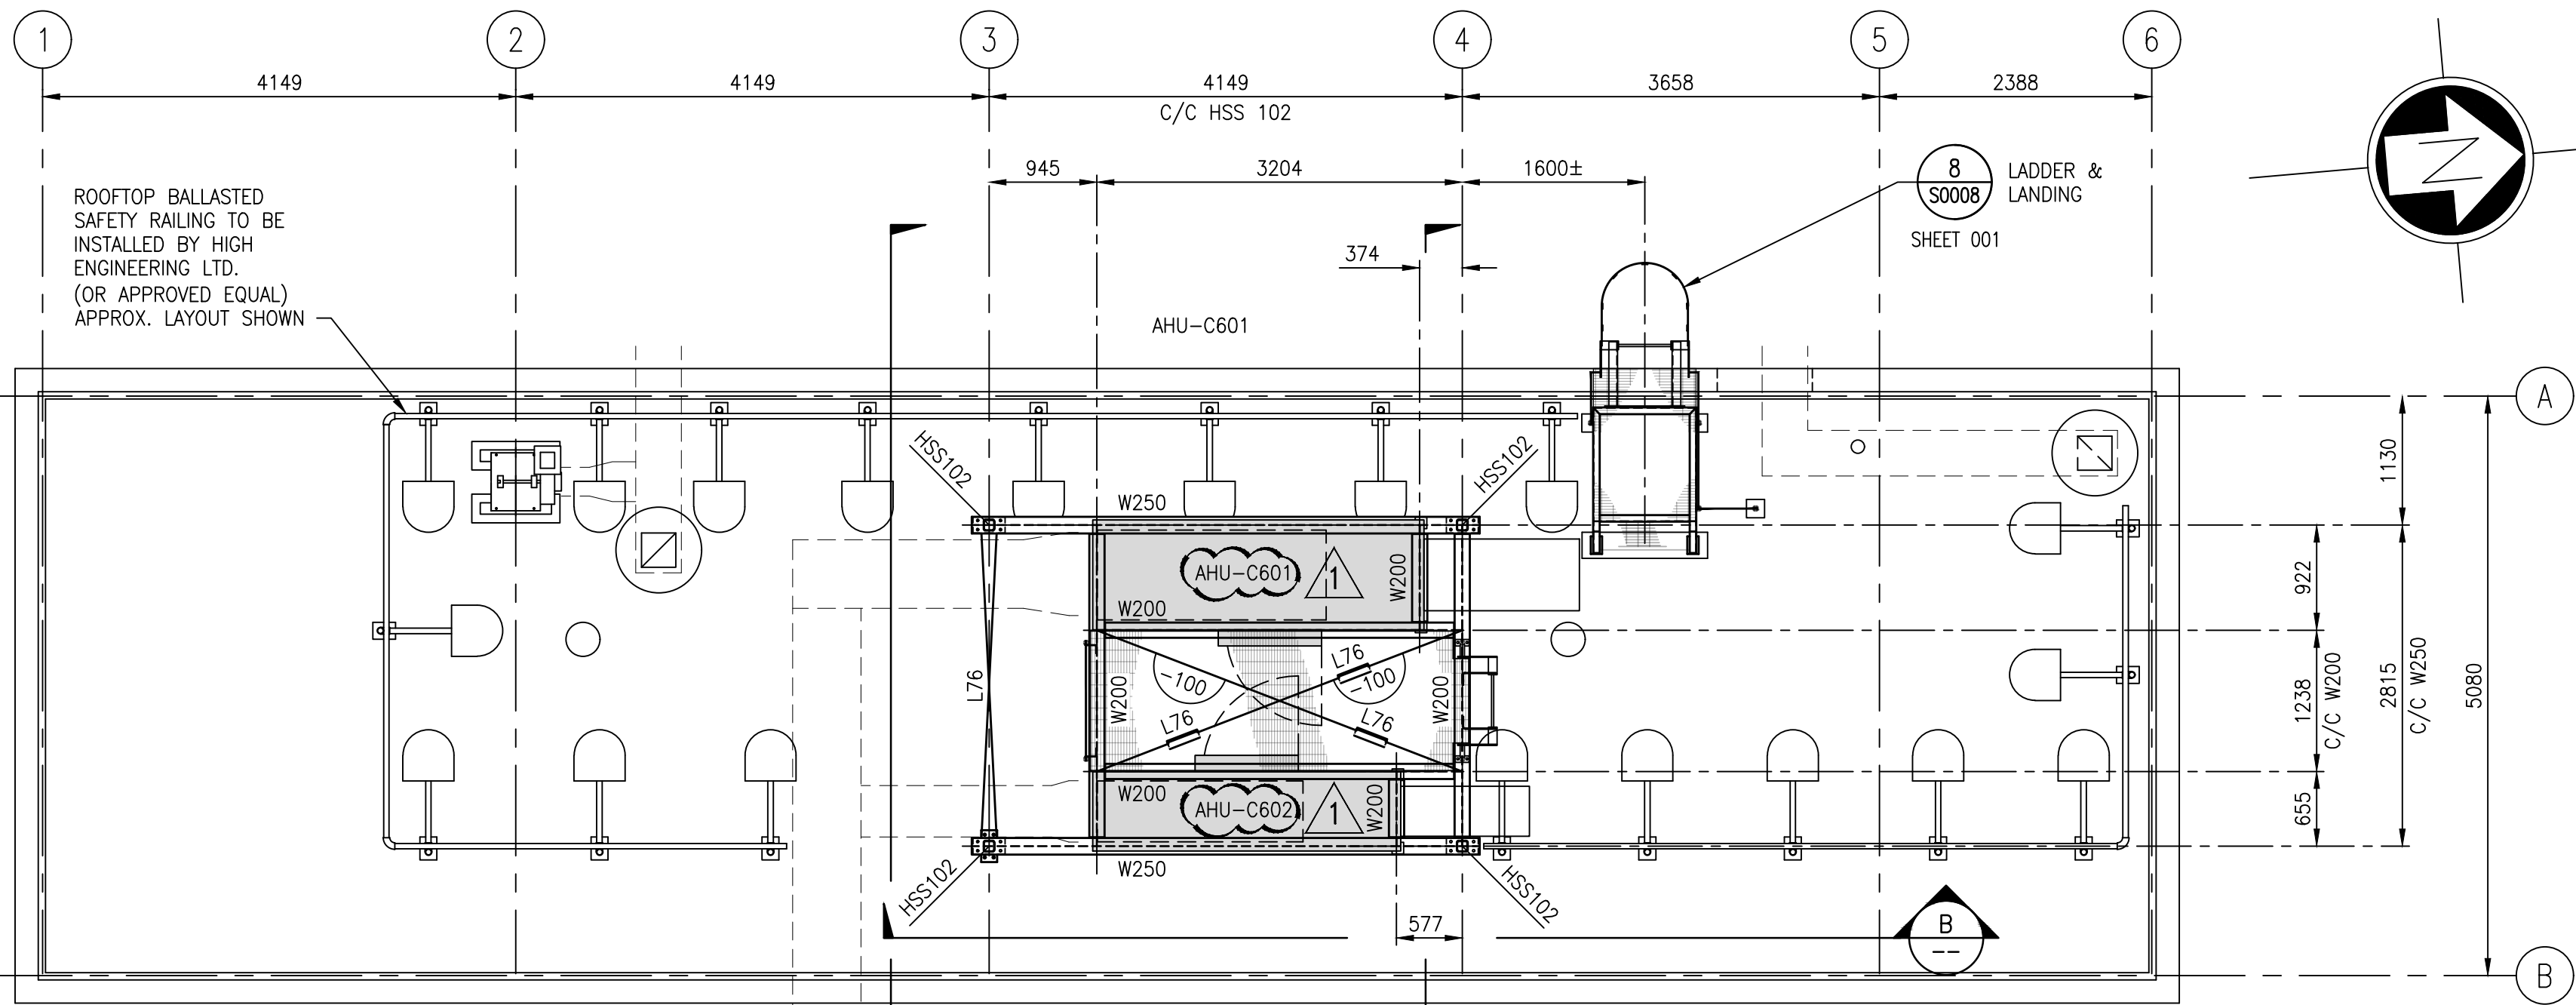
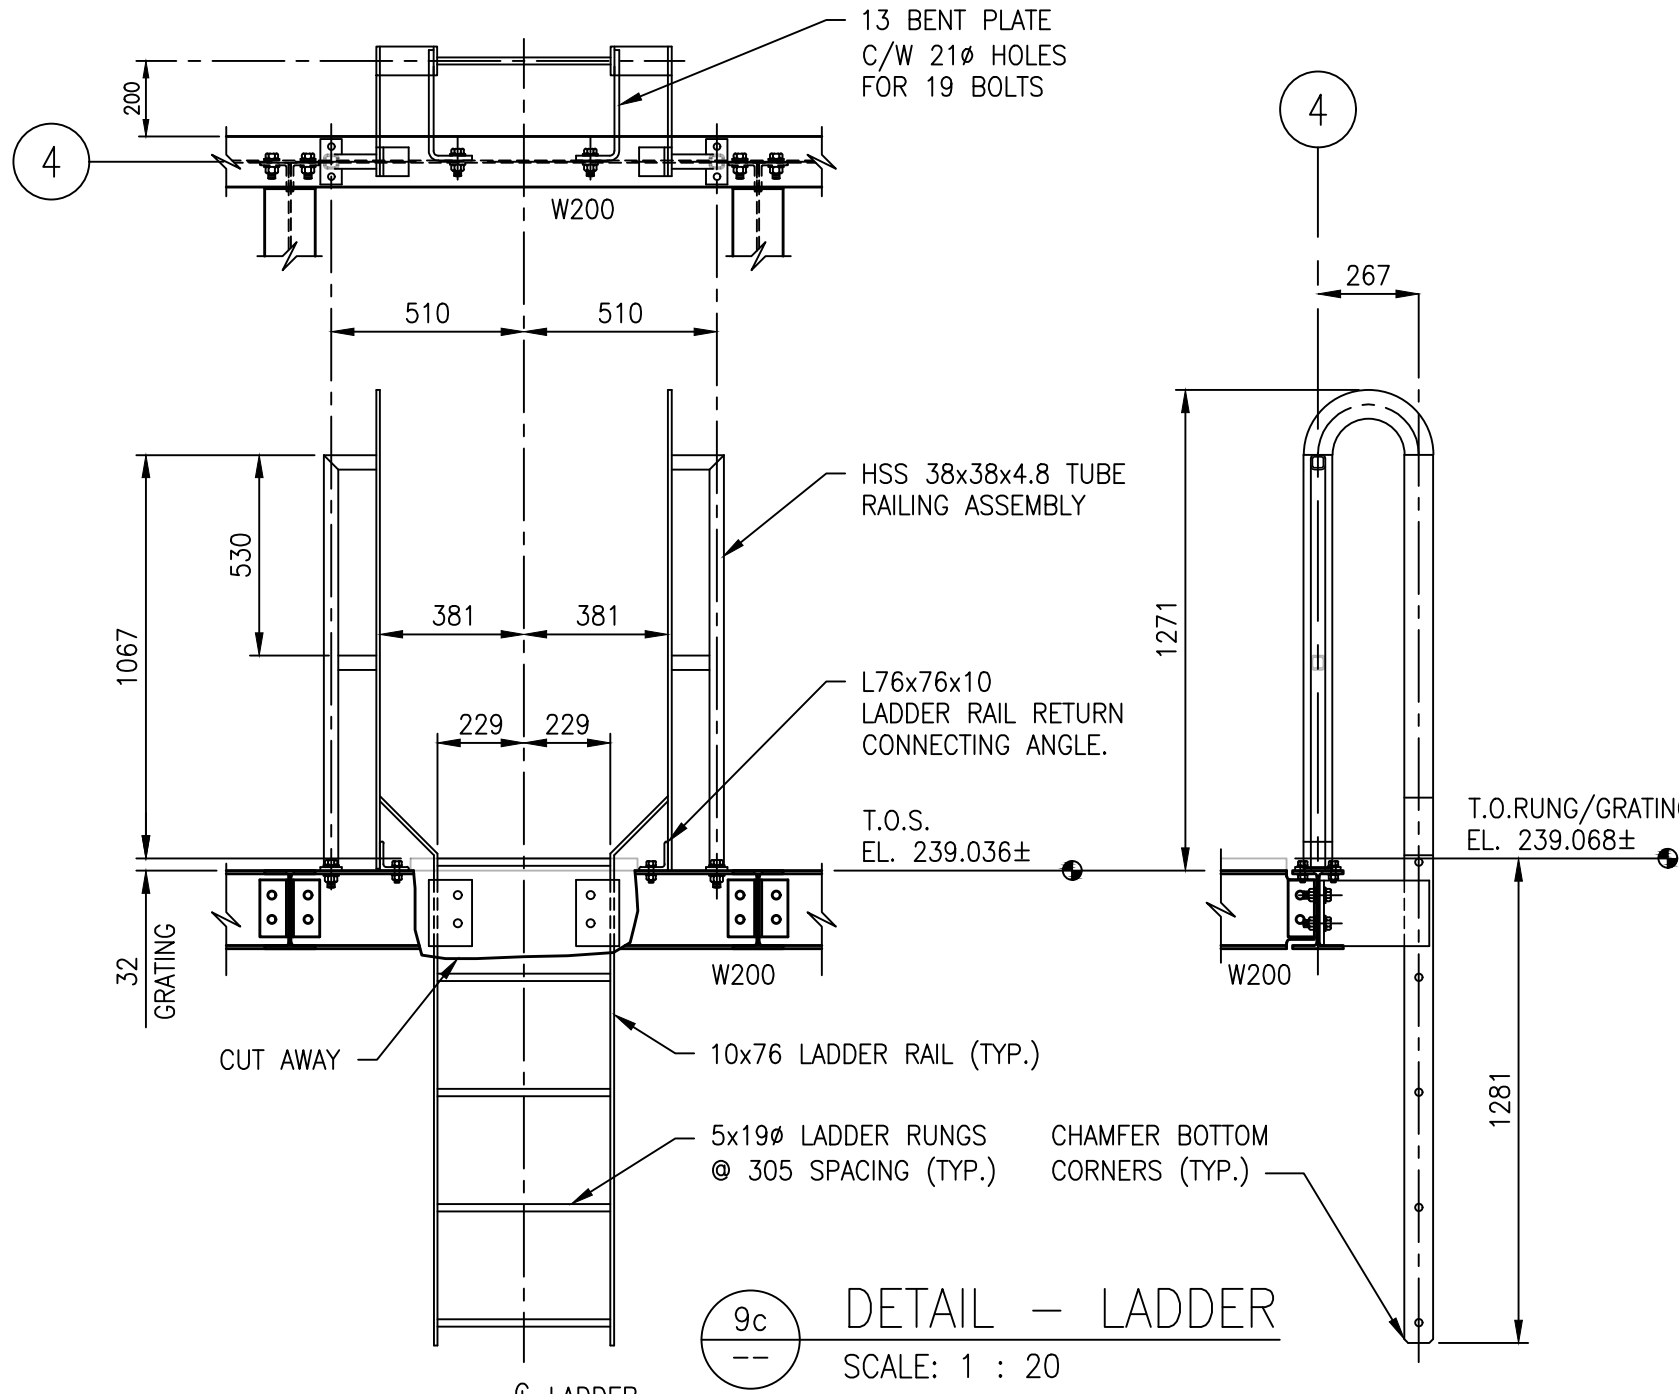


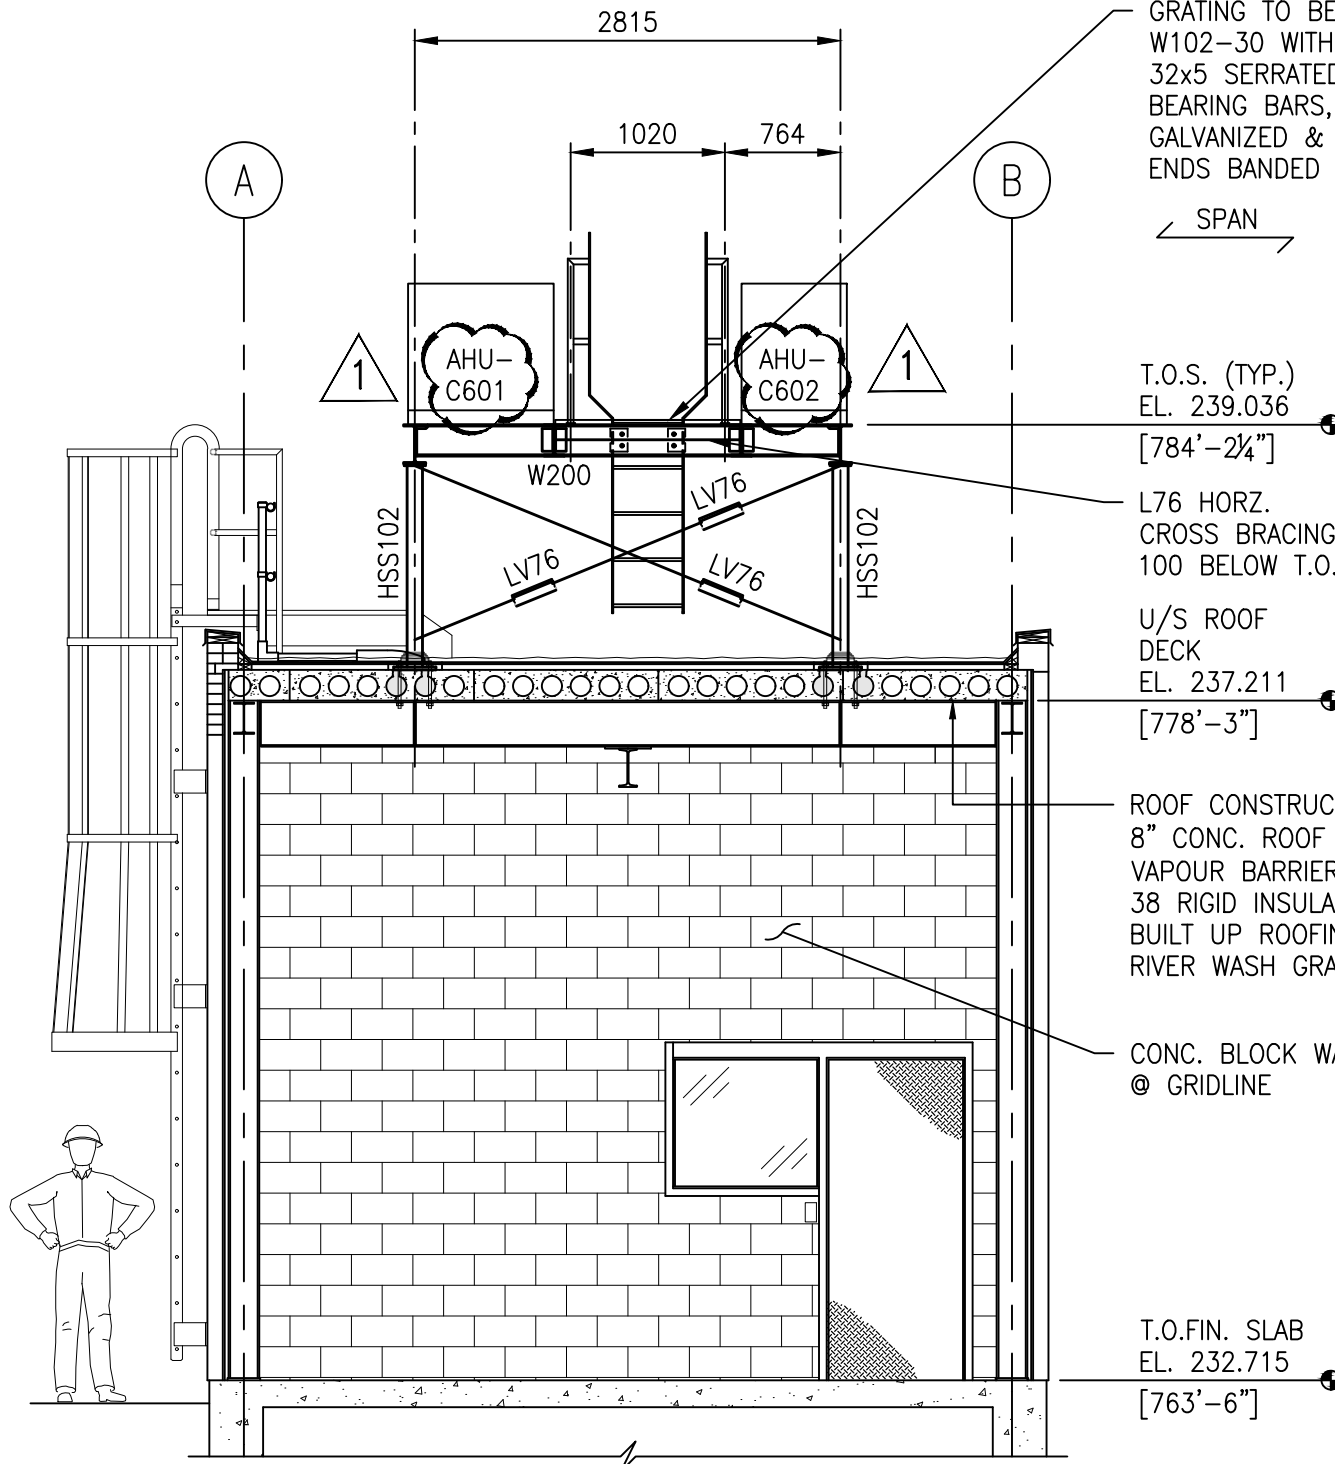

NOTES:
1. SEE DRAWING 1-0640C-S0001-001 & 1-0640C-S0001-002 FOR GENERAL NOTES.




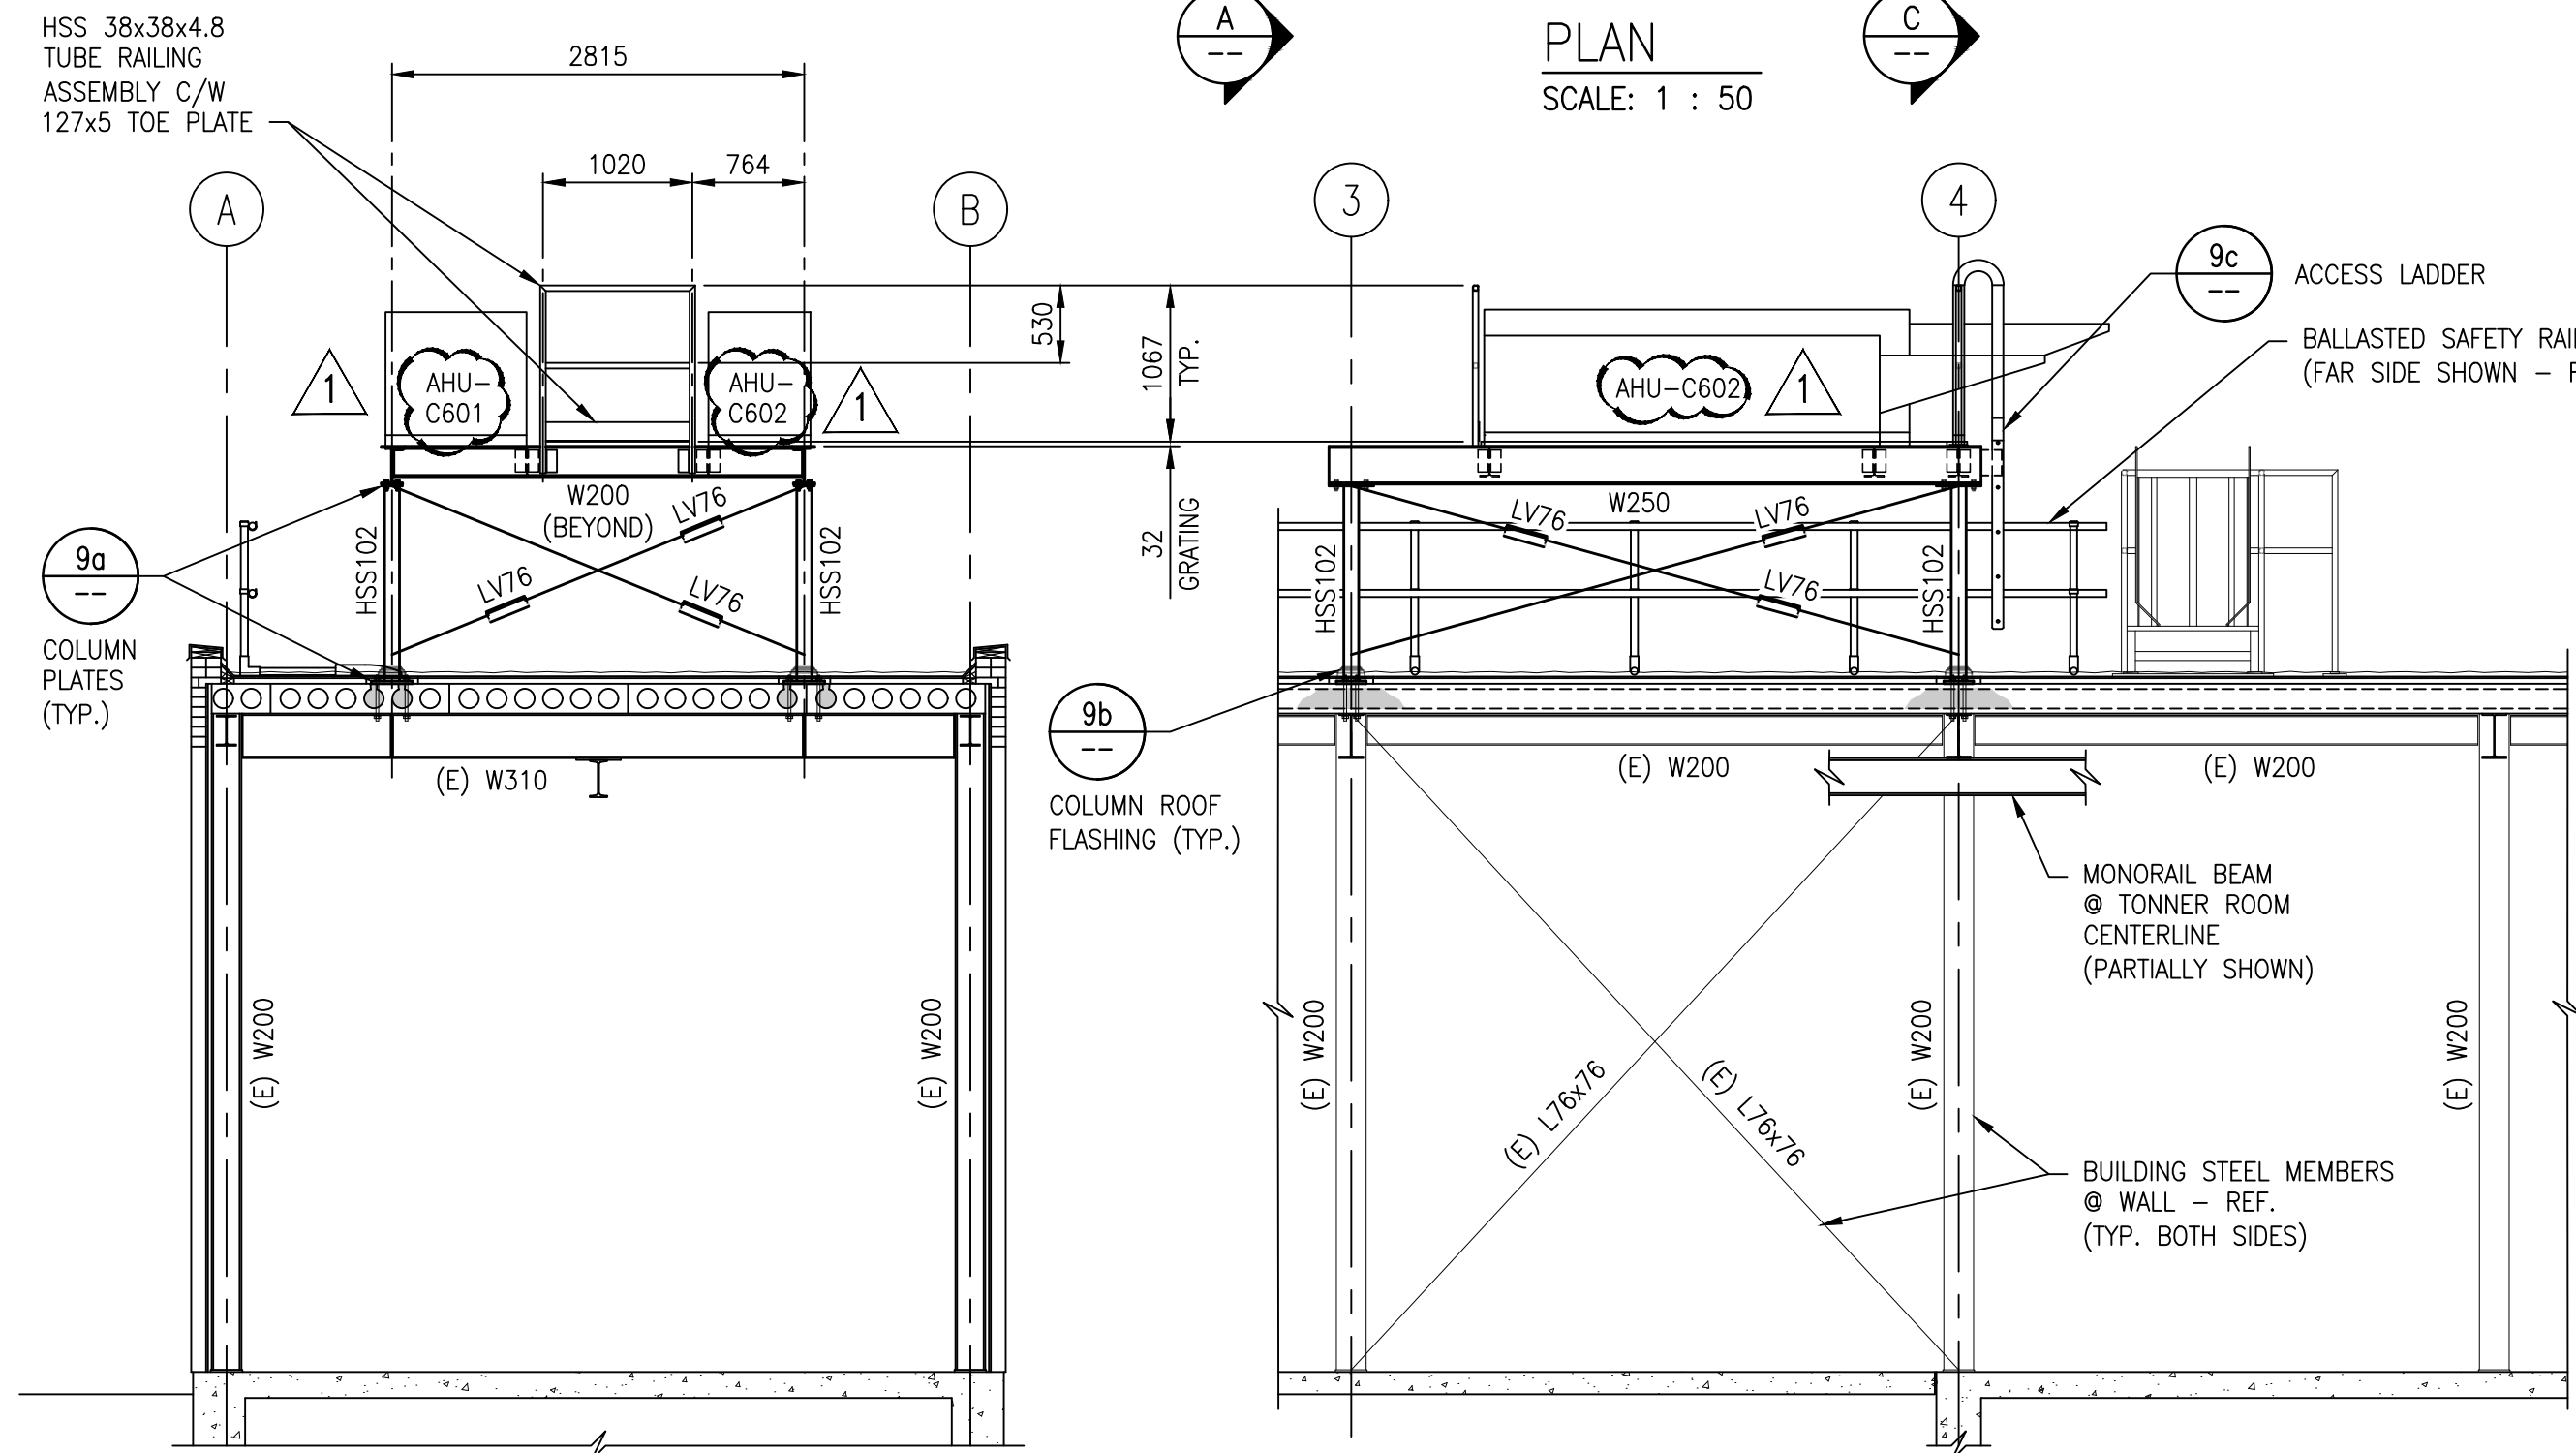


ELEVATION A SCALE: 1 : 50

ELEVATION B SCALE: 1 : 50

ELEVATION C SCALE: 1 : 50

DETAIL - AHU SUPPORT FRAME SCALE: 1 : 50

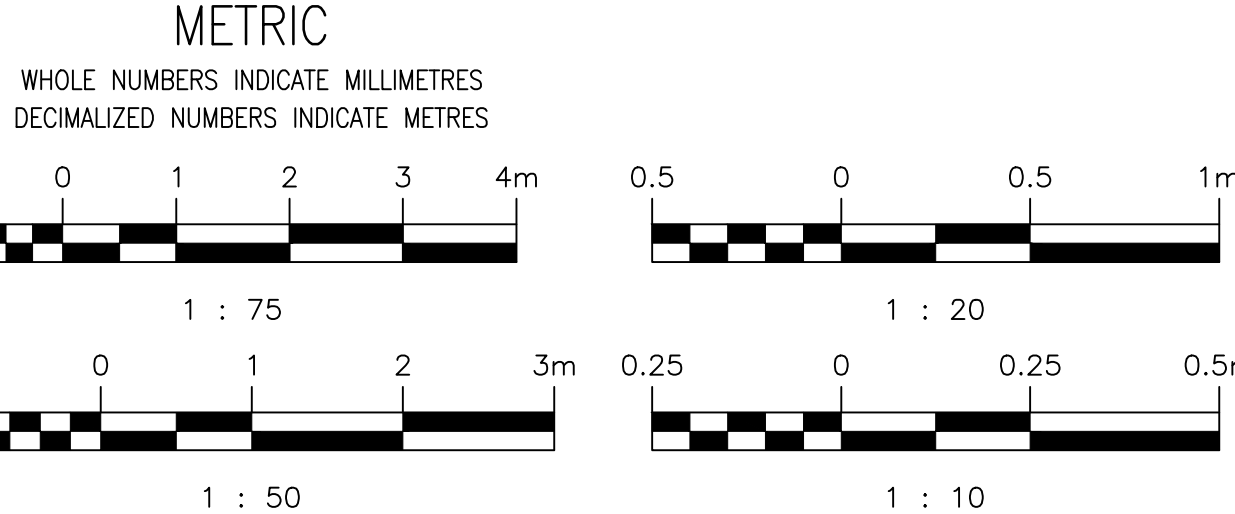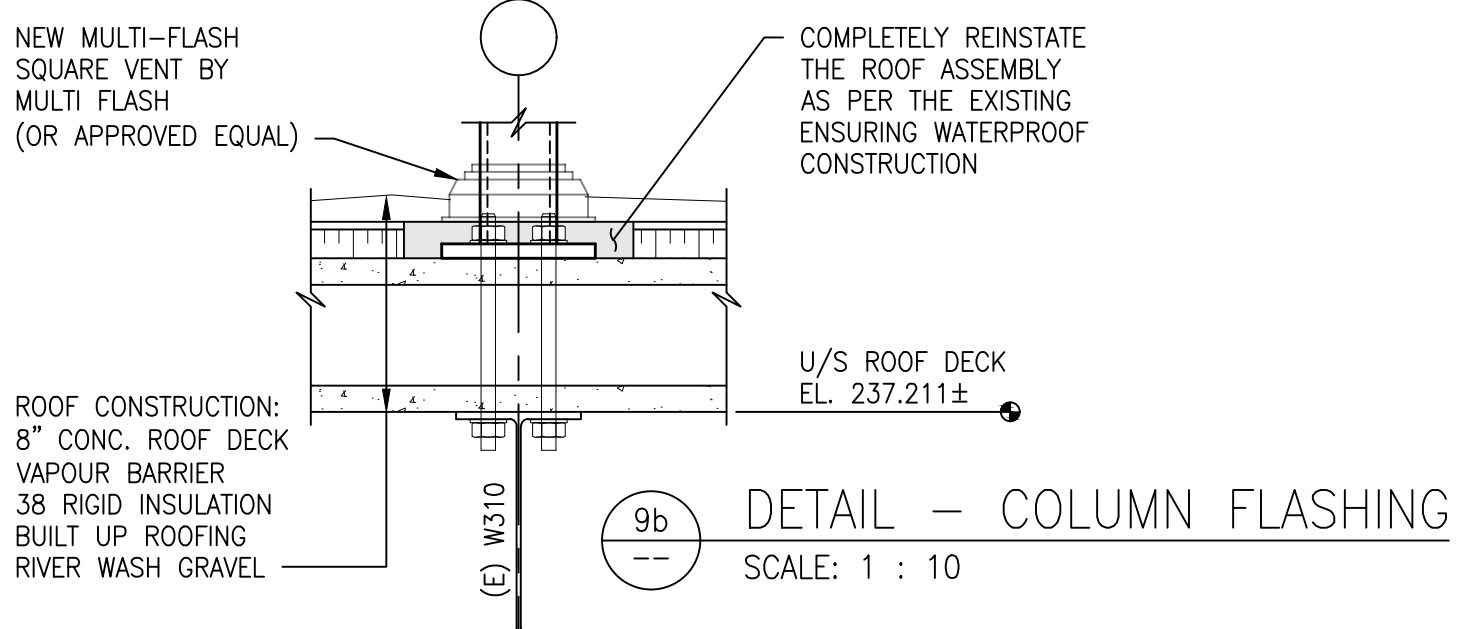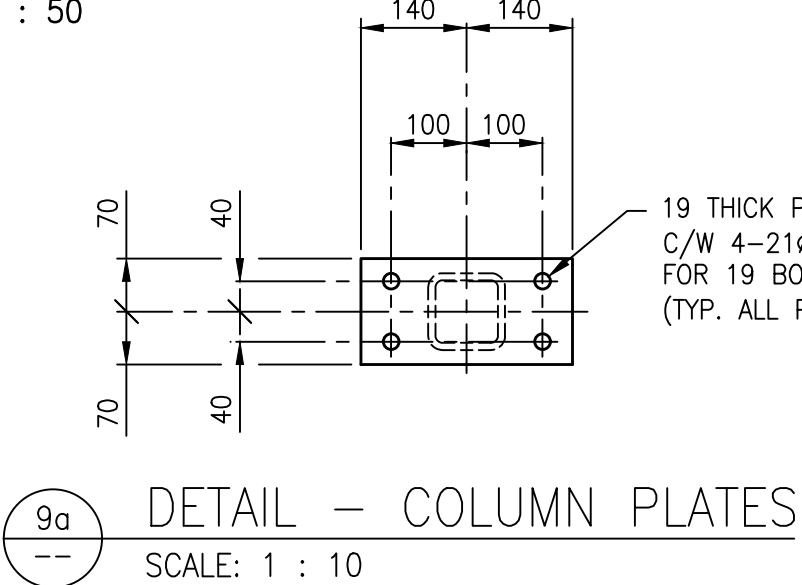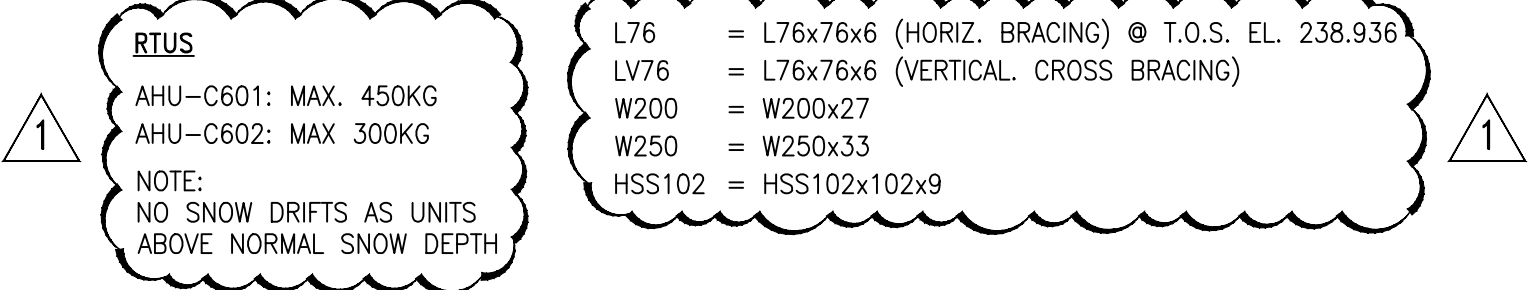

ENGINEERS
GEOSCIENTISTS
MANITOBA
Certificate of Authorization
AtkinsRéalis Canada Inc.
No. 4489

DESIGNED BY:	K. KOTYK	CHECKED BY:	F. MARSHALL
DRAWN BY:	B. DICKSON	APPROVED BY:	V. ELIMBAN
SCALE:	AS SHOWN	ISSUED FOR CONSTRUCTION BY:	M. SKINNER
DATE:	2023-10-05	DATE:	2025/04/30
CONSULTANT NO.:	694715		

ENGINEER'S SEAL

THE CITY OF WINNIPEG
WATER AND WASTE DEPARTMENT

MCPHILLIPS PUMPING STATION
CHLORINE SYSTEM UPGRADES
STRUCTURAL
NEW WORK ASSEMBLIES
PLAN, ELEVATIONS & DETAILS

CITY DRAWING NUMBER
1-0640C-S0008

SHEET
002

REV.
01

SIZE
A1