

465-2025 ADDENDUM 2

WINNPEG TRANSIT – FORT ROUGE FACILITY

URGENT

**PLEASE FORWARD THIS DOCUMENT TO
WHOEVER IS IN POSSESSION OF THE
BID/PROPOSAL**

ISSUED: 2025-07-31
BY: Lunide Milius-Alphonse
TELEPHONE NO. 204 896-1209

**THIS ADDENDUM SHALL BE INCORPORATED
INTO THE BID/PROPOSAL AND SHALL FORM
A PART OF THE CONTRACT DOCUMENTS**

Template Version: Add 2024-02-01

Please note the following and attached changes, corrections, additions, deletions, information and/or instructions in connection with the Bid/Proposal, and be governed accordingly. Failure to acknowledge receipt of this Addendum in Paragraph 10 of Form A: Bid/Proposal may render your Bid/Proposal non-responsive.

PART B – BIDDING PROCEDURES

Revise: B2.1 to read: The Submission Deadline is 4:00 p.m. Winnipeg time, August 6, 2025.


QUESTIONS AND ANSWERS

Q1: Do bollards need to be galvanized, nothing is mentioned in the specs if it regular primed or if it is galvanized?

A1: The bollards are covered with an HDPE sleeve and should be factory primed, painted, or galvanized (bare steel is not acceptable).

Q2: Clouded in blue below, are the removable bollards detail the same as shown on the detail G of drawing S0006?

Clouded in red below, it shows “*PROPOSE BOLLARD (TYP)*” but is not pointed on any bollard. Please advise for us to know the quantity and if the detail would be the same as shown on detail F of drawing S0006?

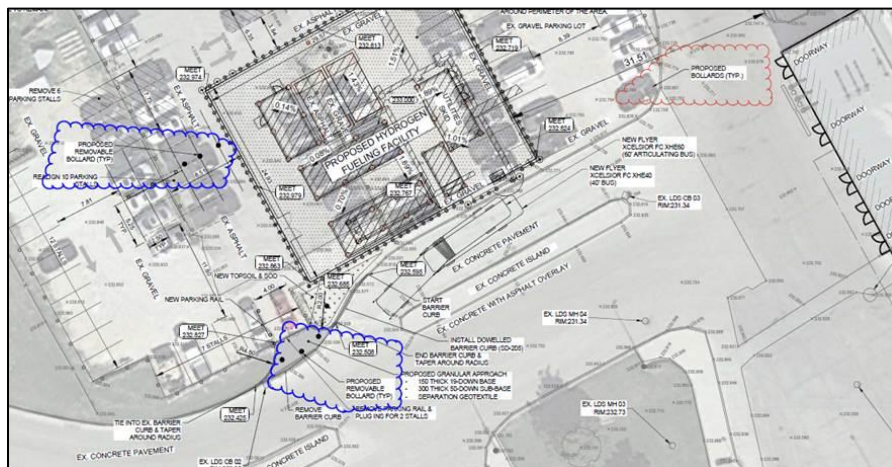

PROPOSED LOT GRADING PLAN

A2: The six (6) removable bollards shown on Drawing C04 shall match Detail G on Drawing S06.

The bollard label "*PROPOSED BOLLARDS (TYP)*" on Drawing C04 is meant to be pointing to the four (4) bollards around the new fire hydrant and should match Detail F on Drawing S06.