



GENERAL NOTES


- THESE DRAWINGS SHALL NOT BE SCALED.
- THE CONTRACTOR SHALL VISIT THE SITE AND SATISFY ONESELF ALL DIMENSIONS, DATUM AND DETAILED INFORMATION SHOWN ARE CORRECT.
- THE CONTRACTOR IS TO REVIEW AND COORDINATE ALL STRUCTURAL, MECHANICAL AND ELECTRICAL DRAWINGS FOR ADDITIONAL OPENINGS THROUGH FLOORS, WALLS, AND CEILINGS FOR DUCT, PIPE & ELECTRICAL RISERS AND ALL OPENINGS NOT SHOWN ON DRAWINGS.
- ALL PRODUCTS AND MATERIALS TO BE USED AND INSTALLED SHALL CONFORM WITH MANUFACTURER'S SPECIFICATIONS & APPLICABLE CODES.

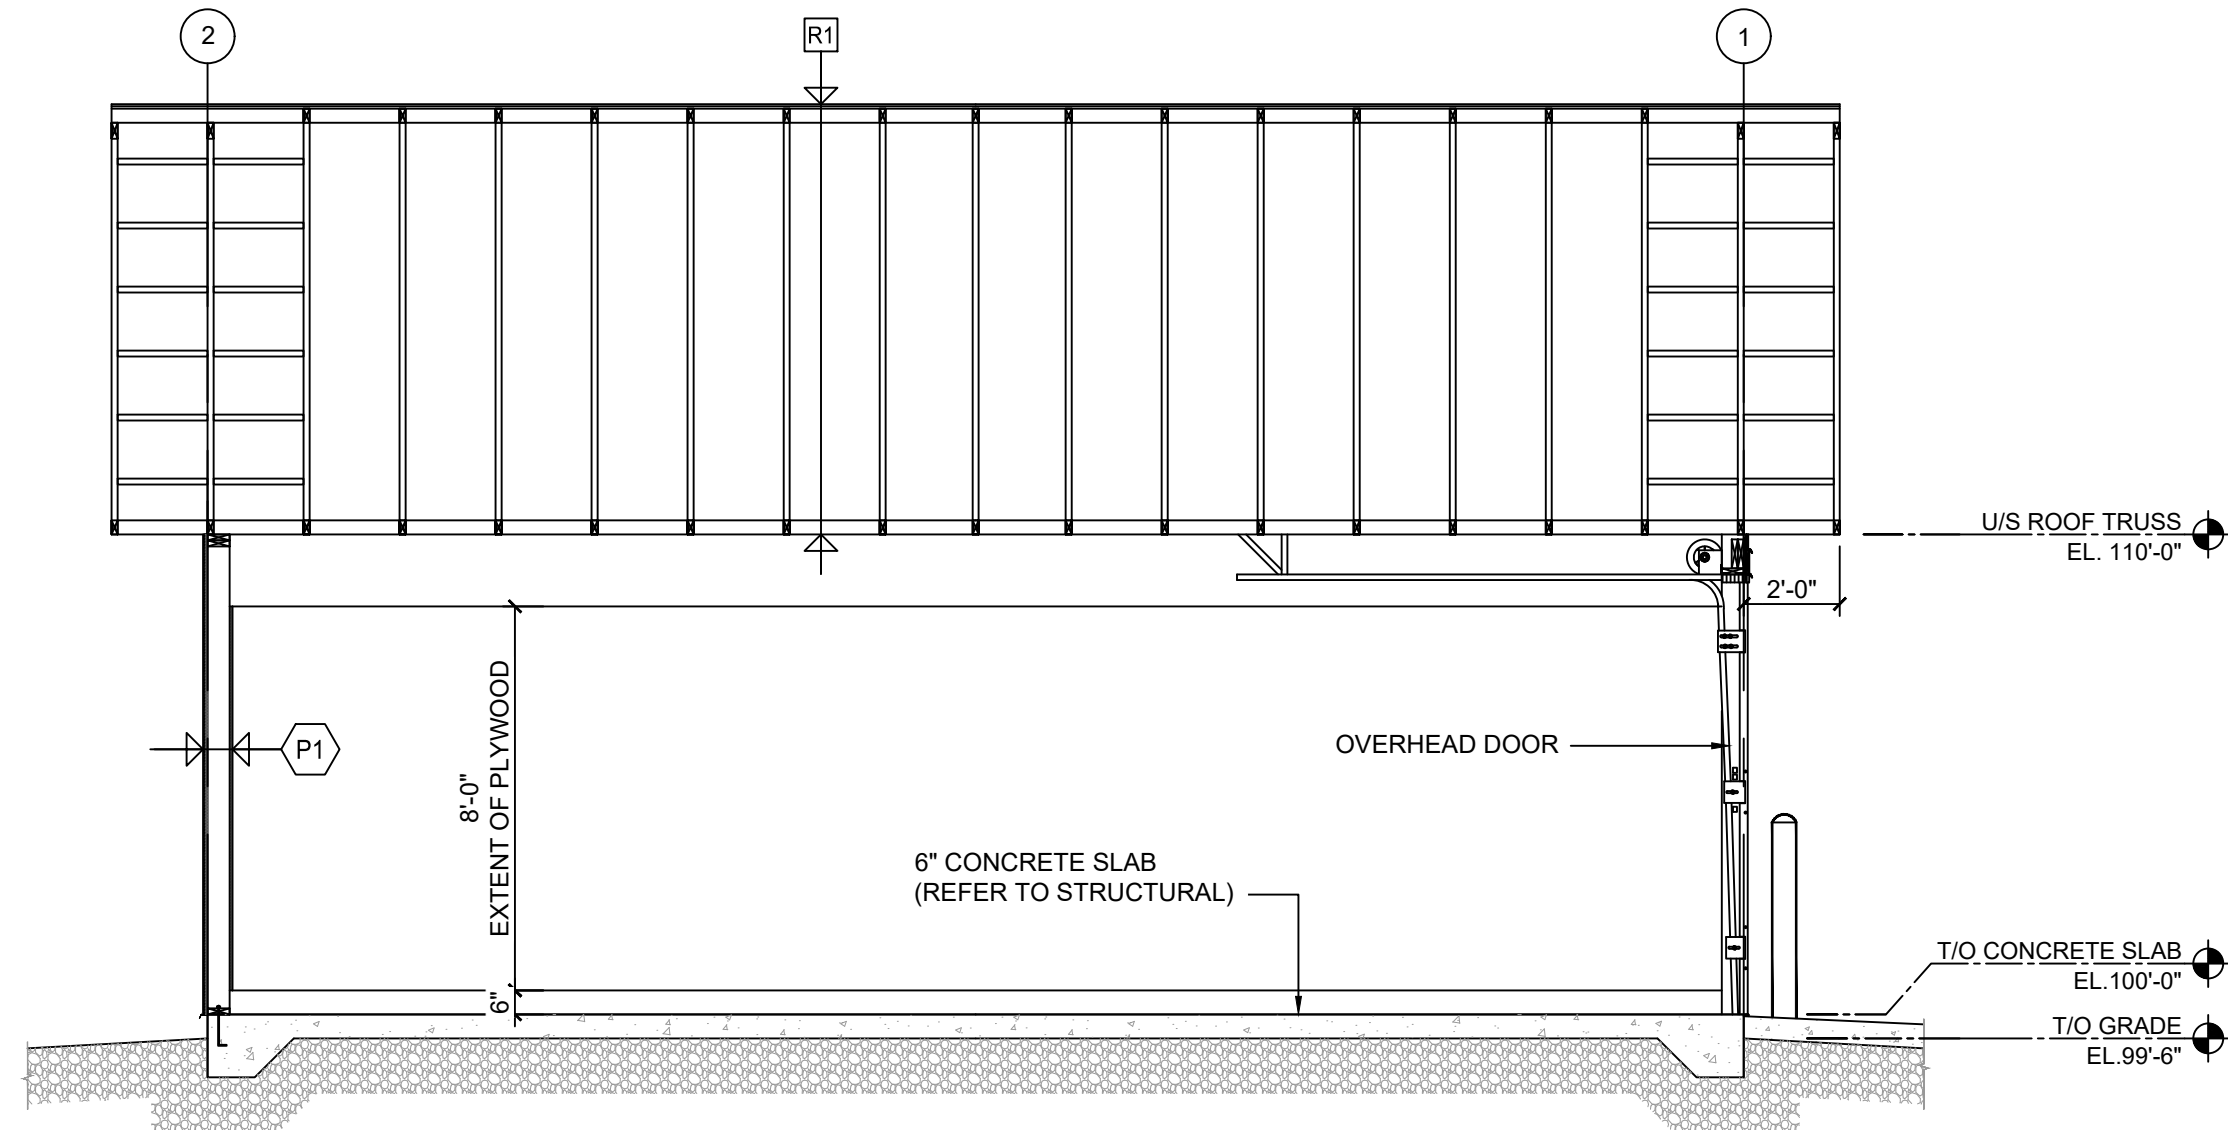


1 BUILDING SECTION
A3 1/4" = 1' - 0"

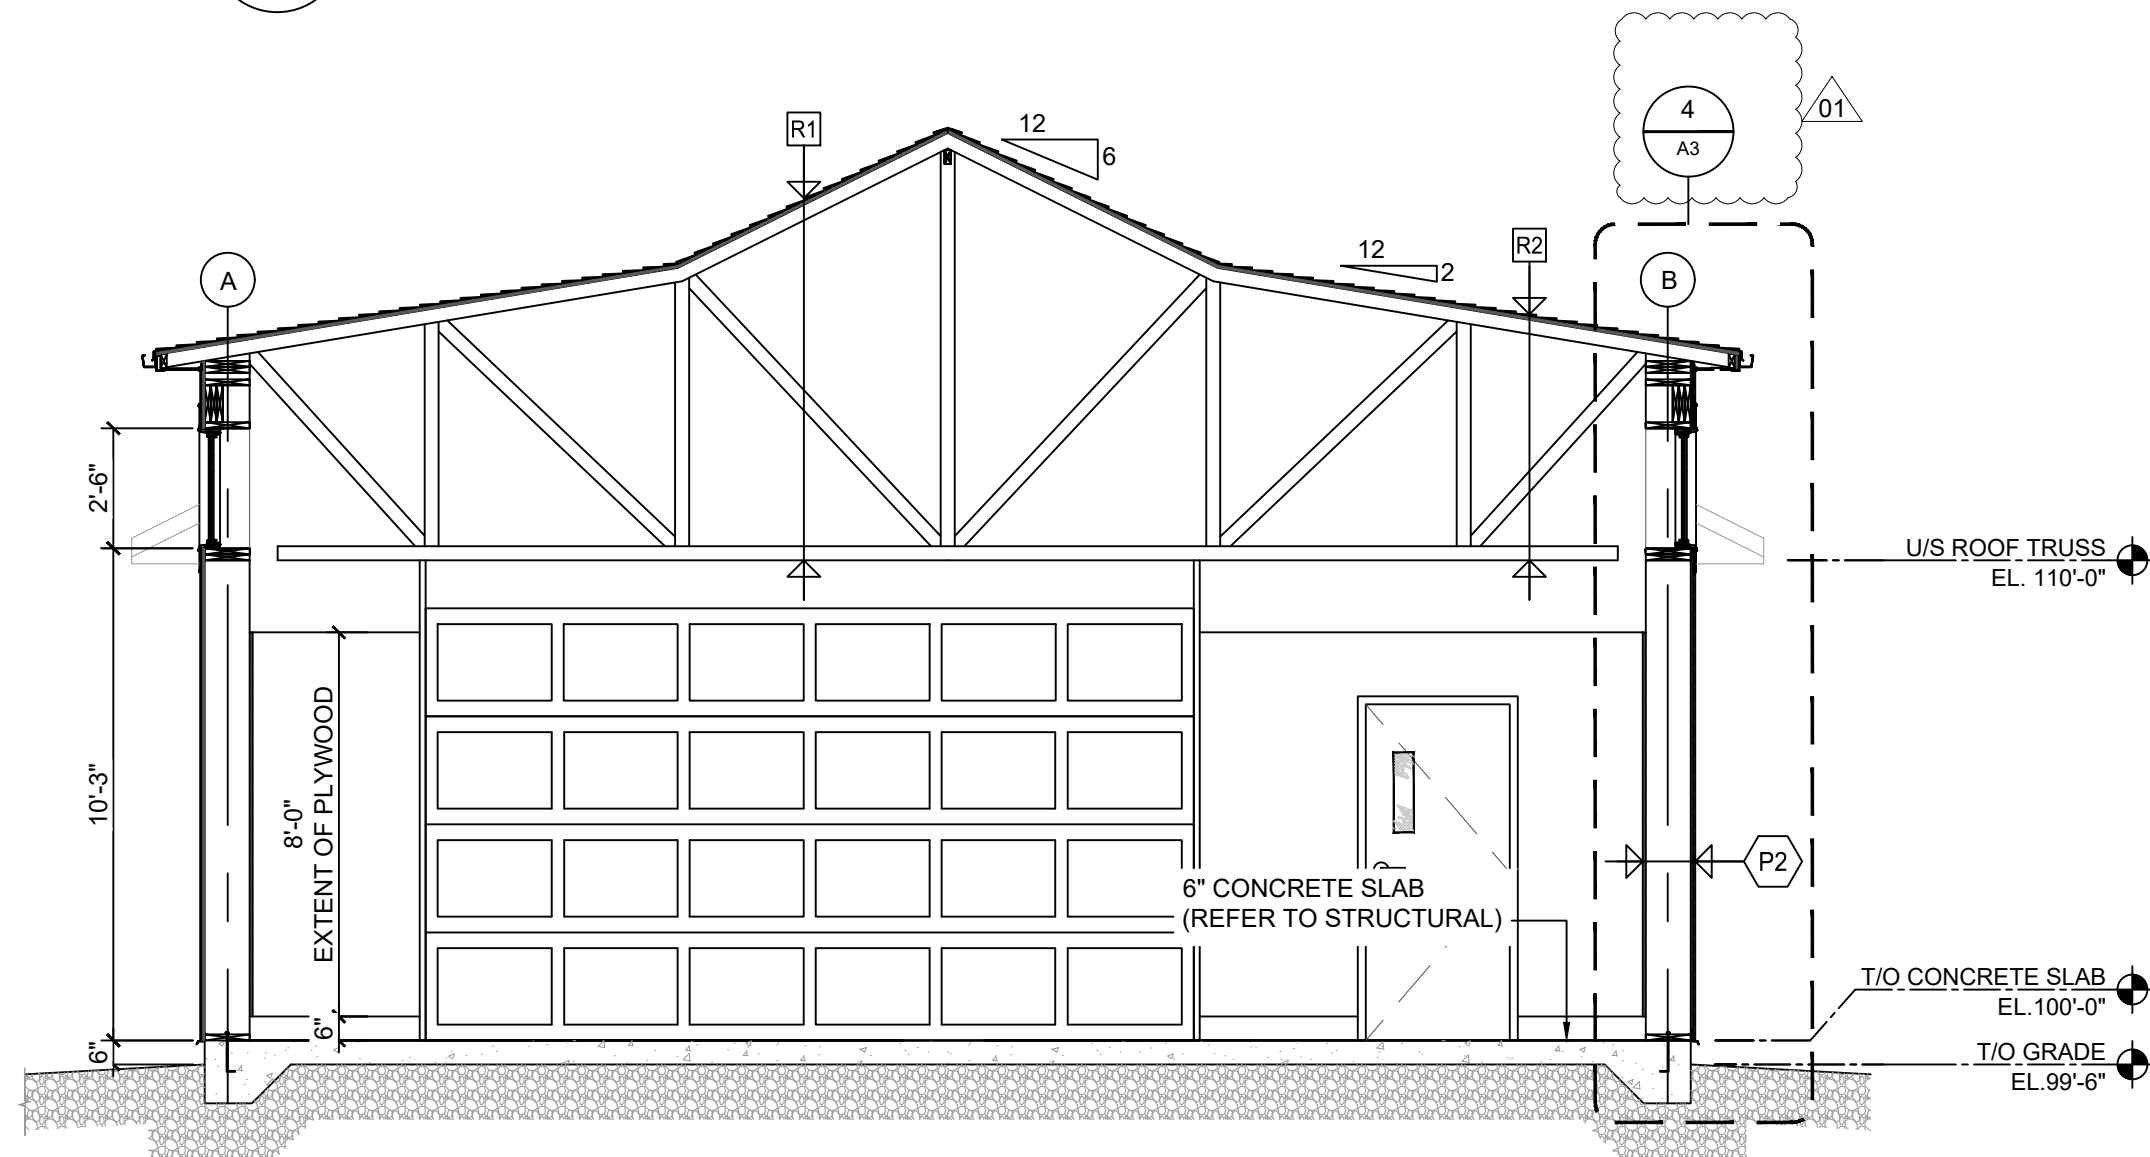


2 BUILDING SECTION
A3 1/4" = 1' - 0"

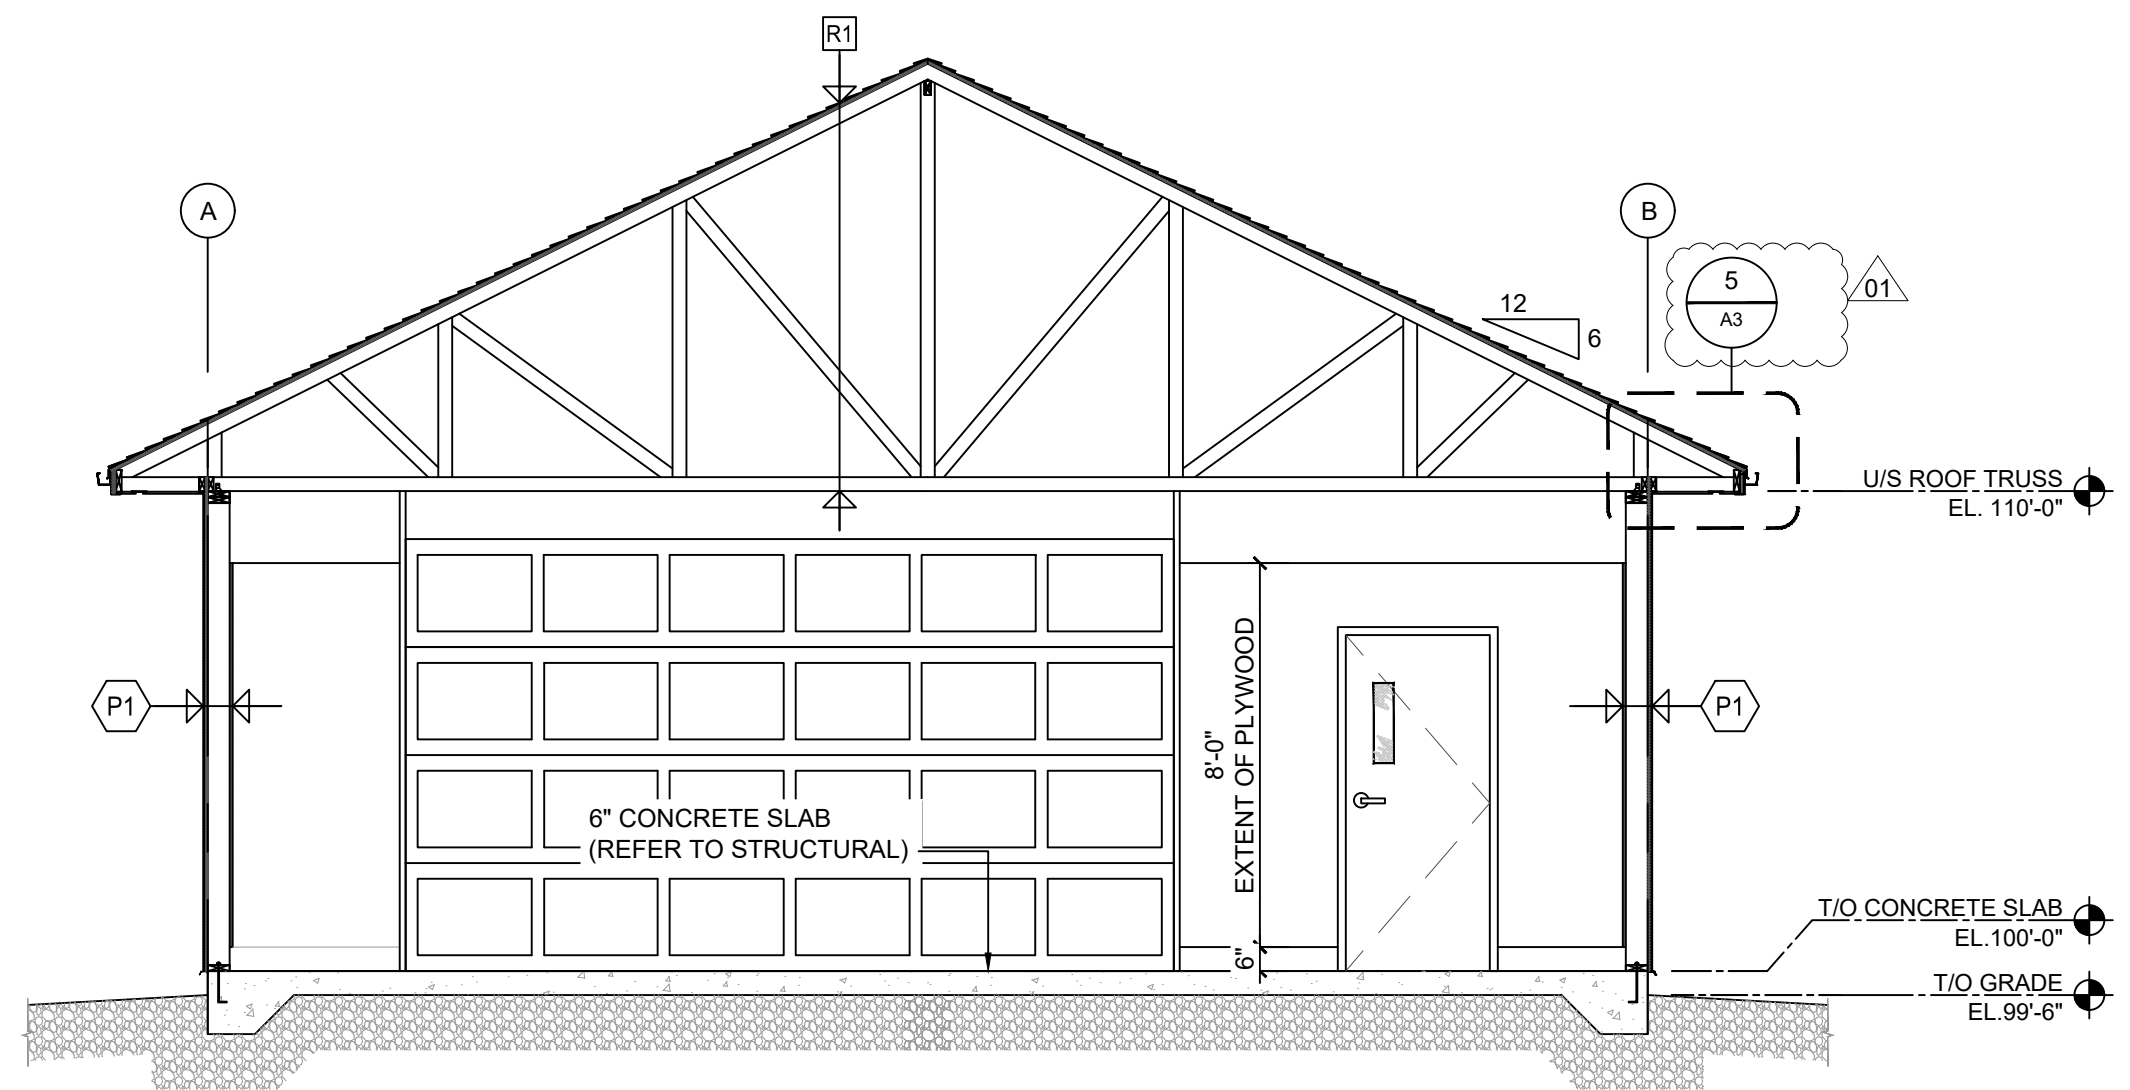

3 BUILDING SECTION
A3 1/4" = 1' - 0"

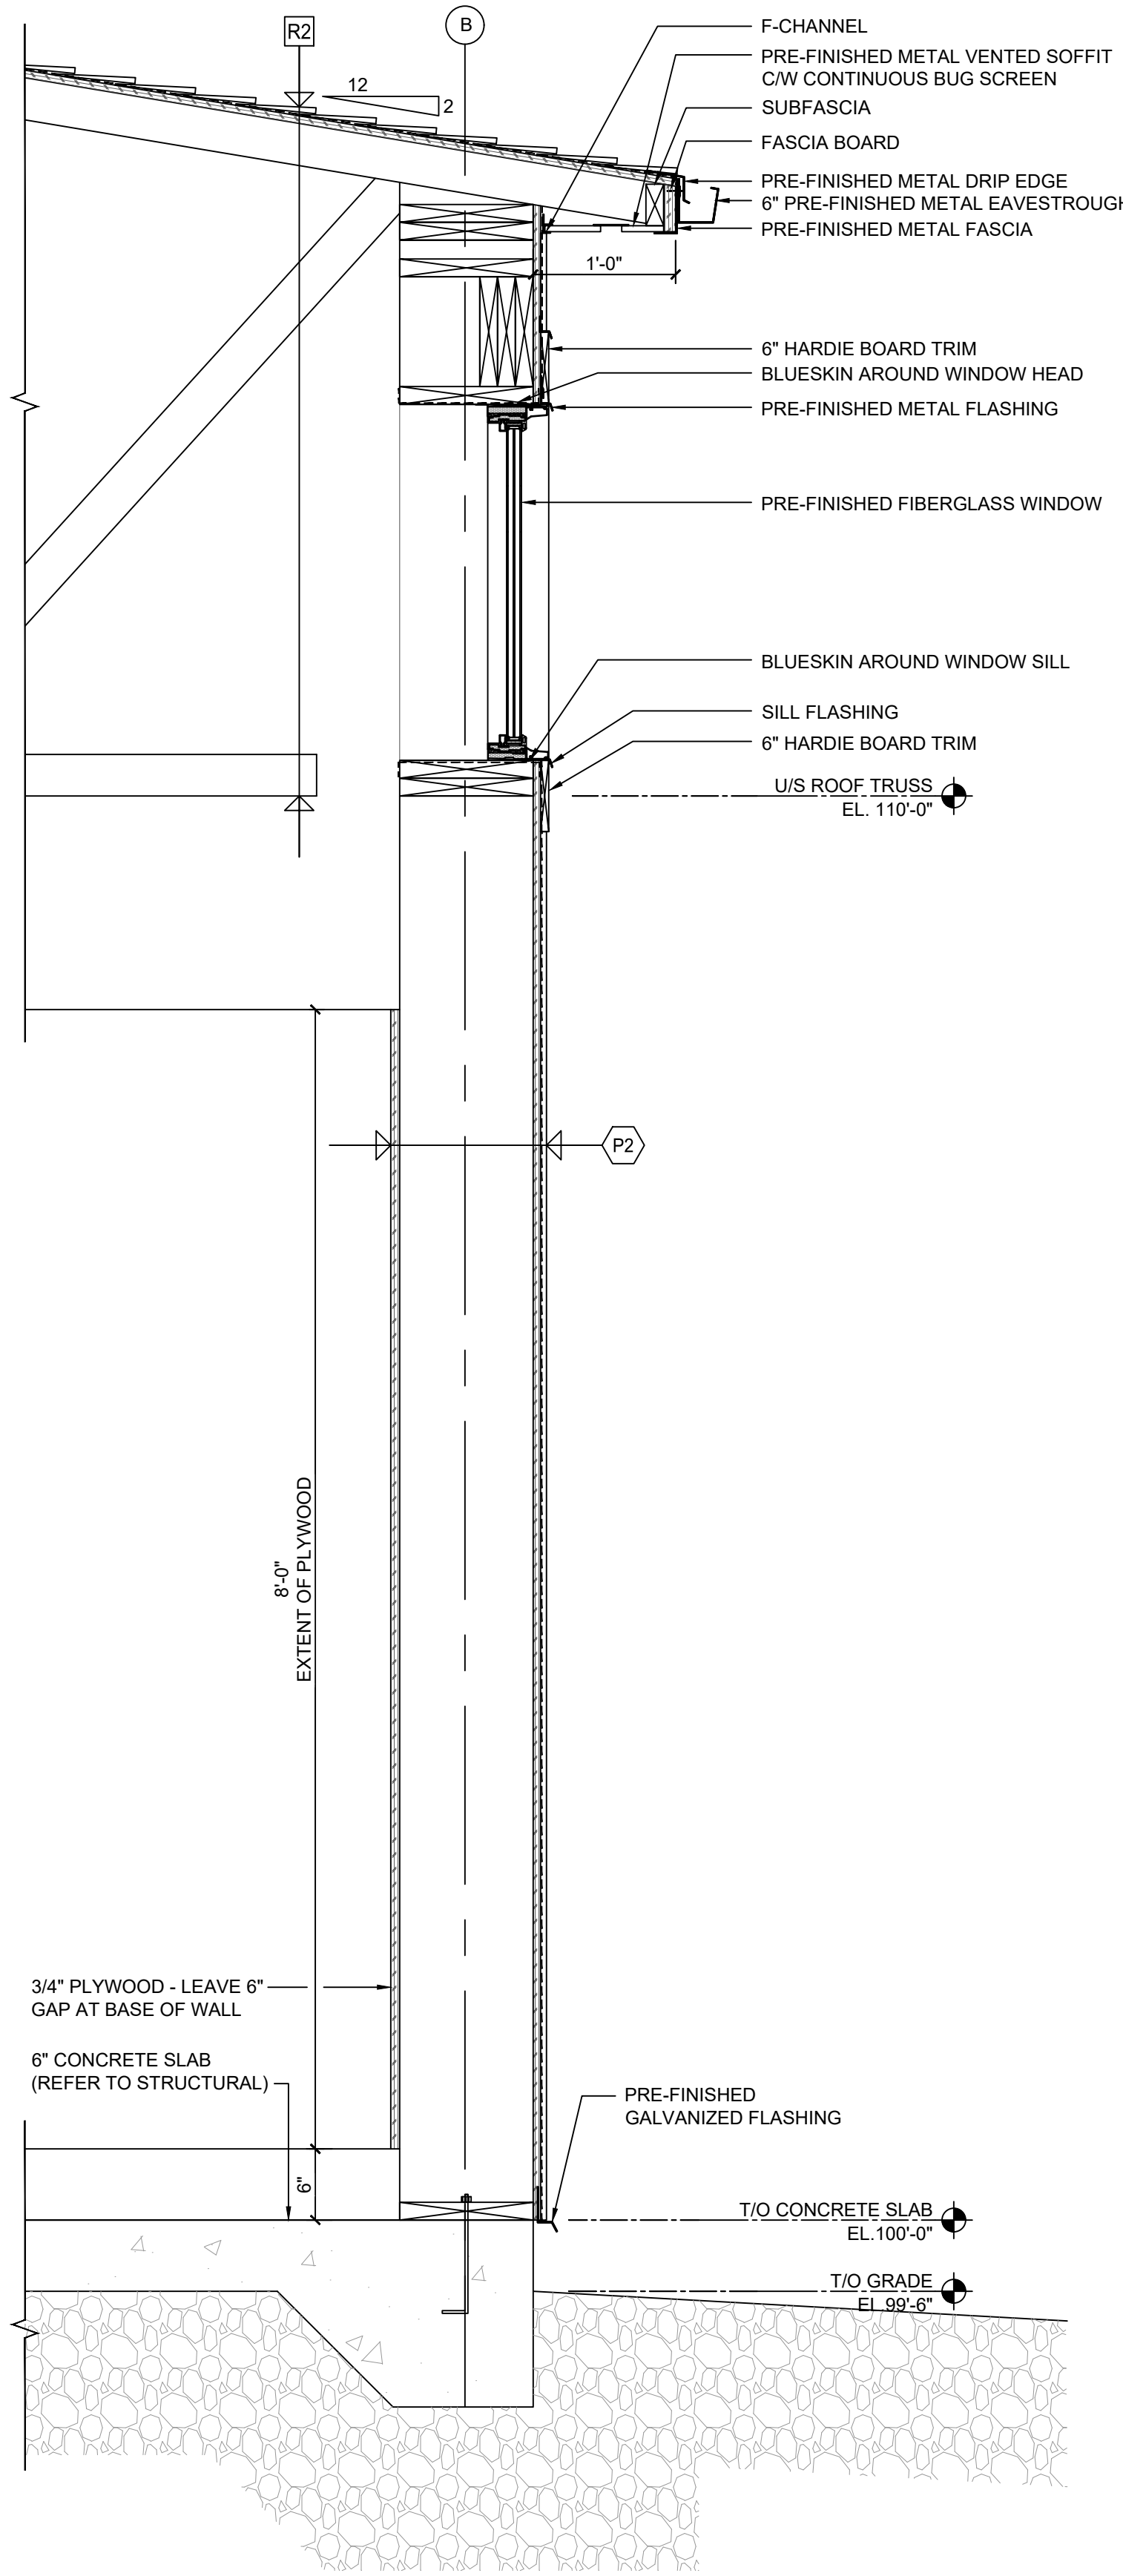

4 WALL SECTION
A3 1" = 1' - 0"

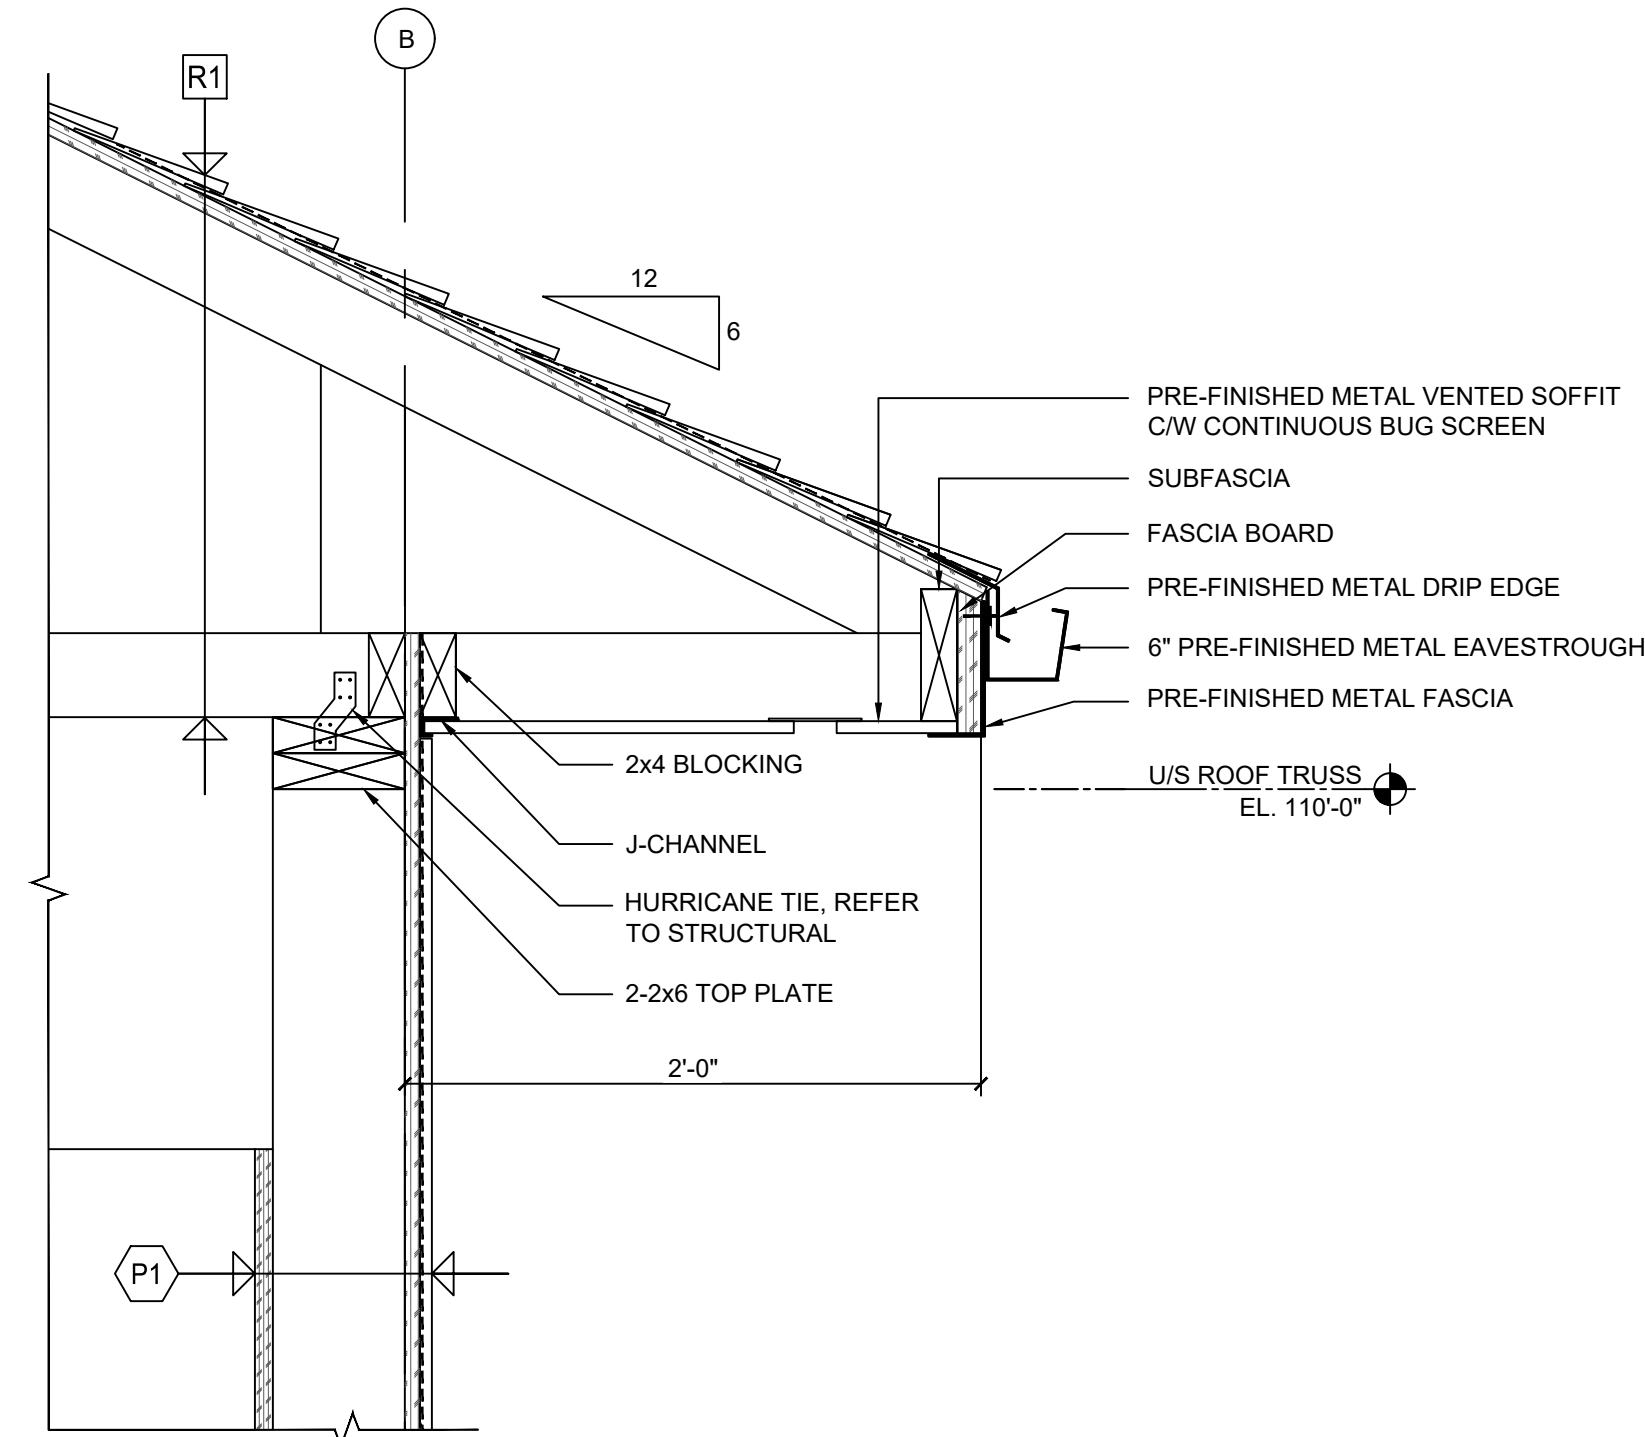

5 OVERHANG DETAIL
A3 1 1/2" = 1' - 0"

No.	REVISION/DESCRIPTION	BY	DATE
01	ADDENDUM #1	HA	07.14 2025
00	ISSUED FOR CONSTRUCTION	HA	05.01 2025

SEAL



DATE	DESIGN	MAA Digital Signature Applied	CHECKED	APPROVED
2025.05.01	BY: HA	BY: HA	BY: BP	BY: BP



PROJECT
PARKS & OPEN SPACE DIVISION
BUNN'S CREEK PARK - STORAGE GARAGE

365 McIVOR

SHEET TITLE
BUILDING SECTIONS
WALL SECTION
DETAILS

SCALE	PROJECT No.	SHEET No.
AS SHOWN	2023-049	A3-R1