


No.	Date	Description
1	2025/12/11	Contract Documents
2	2026/01/15	Addendum 3

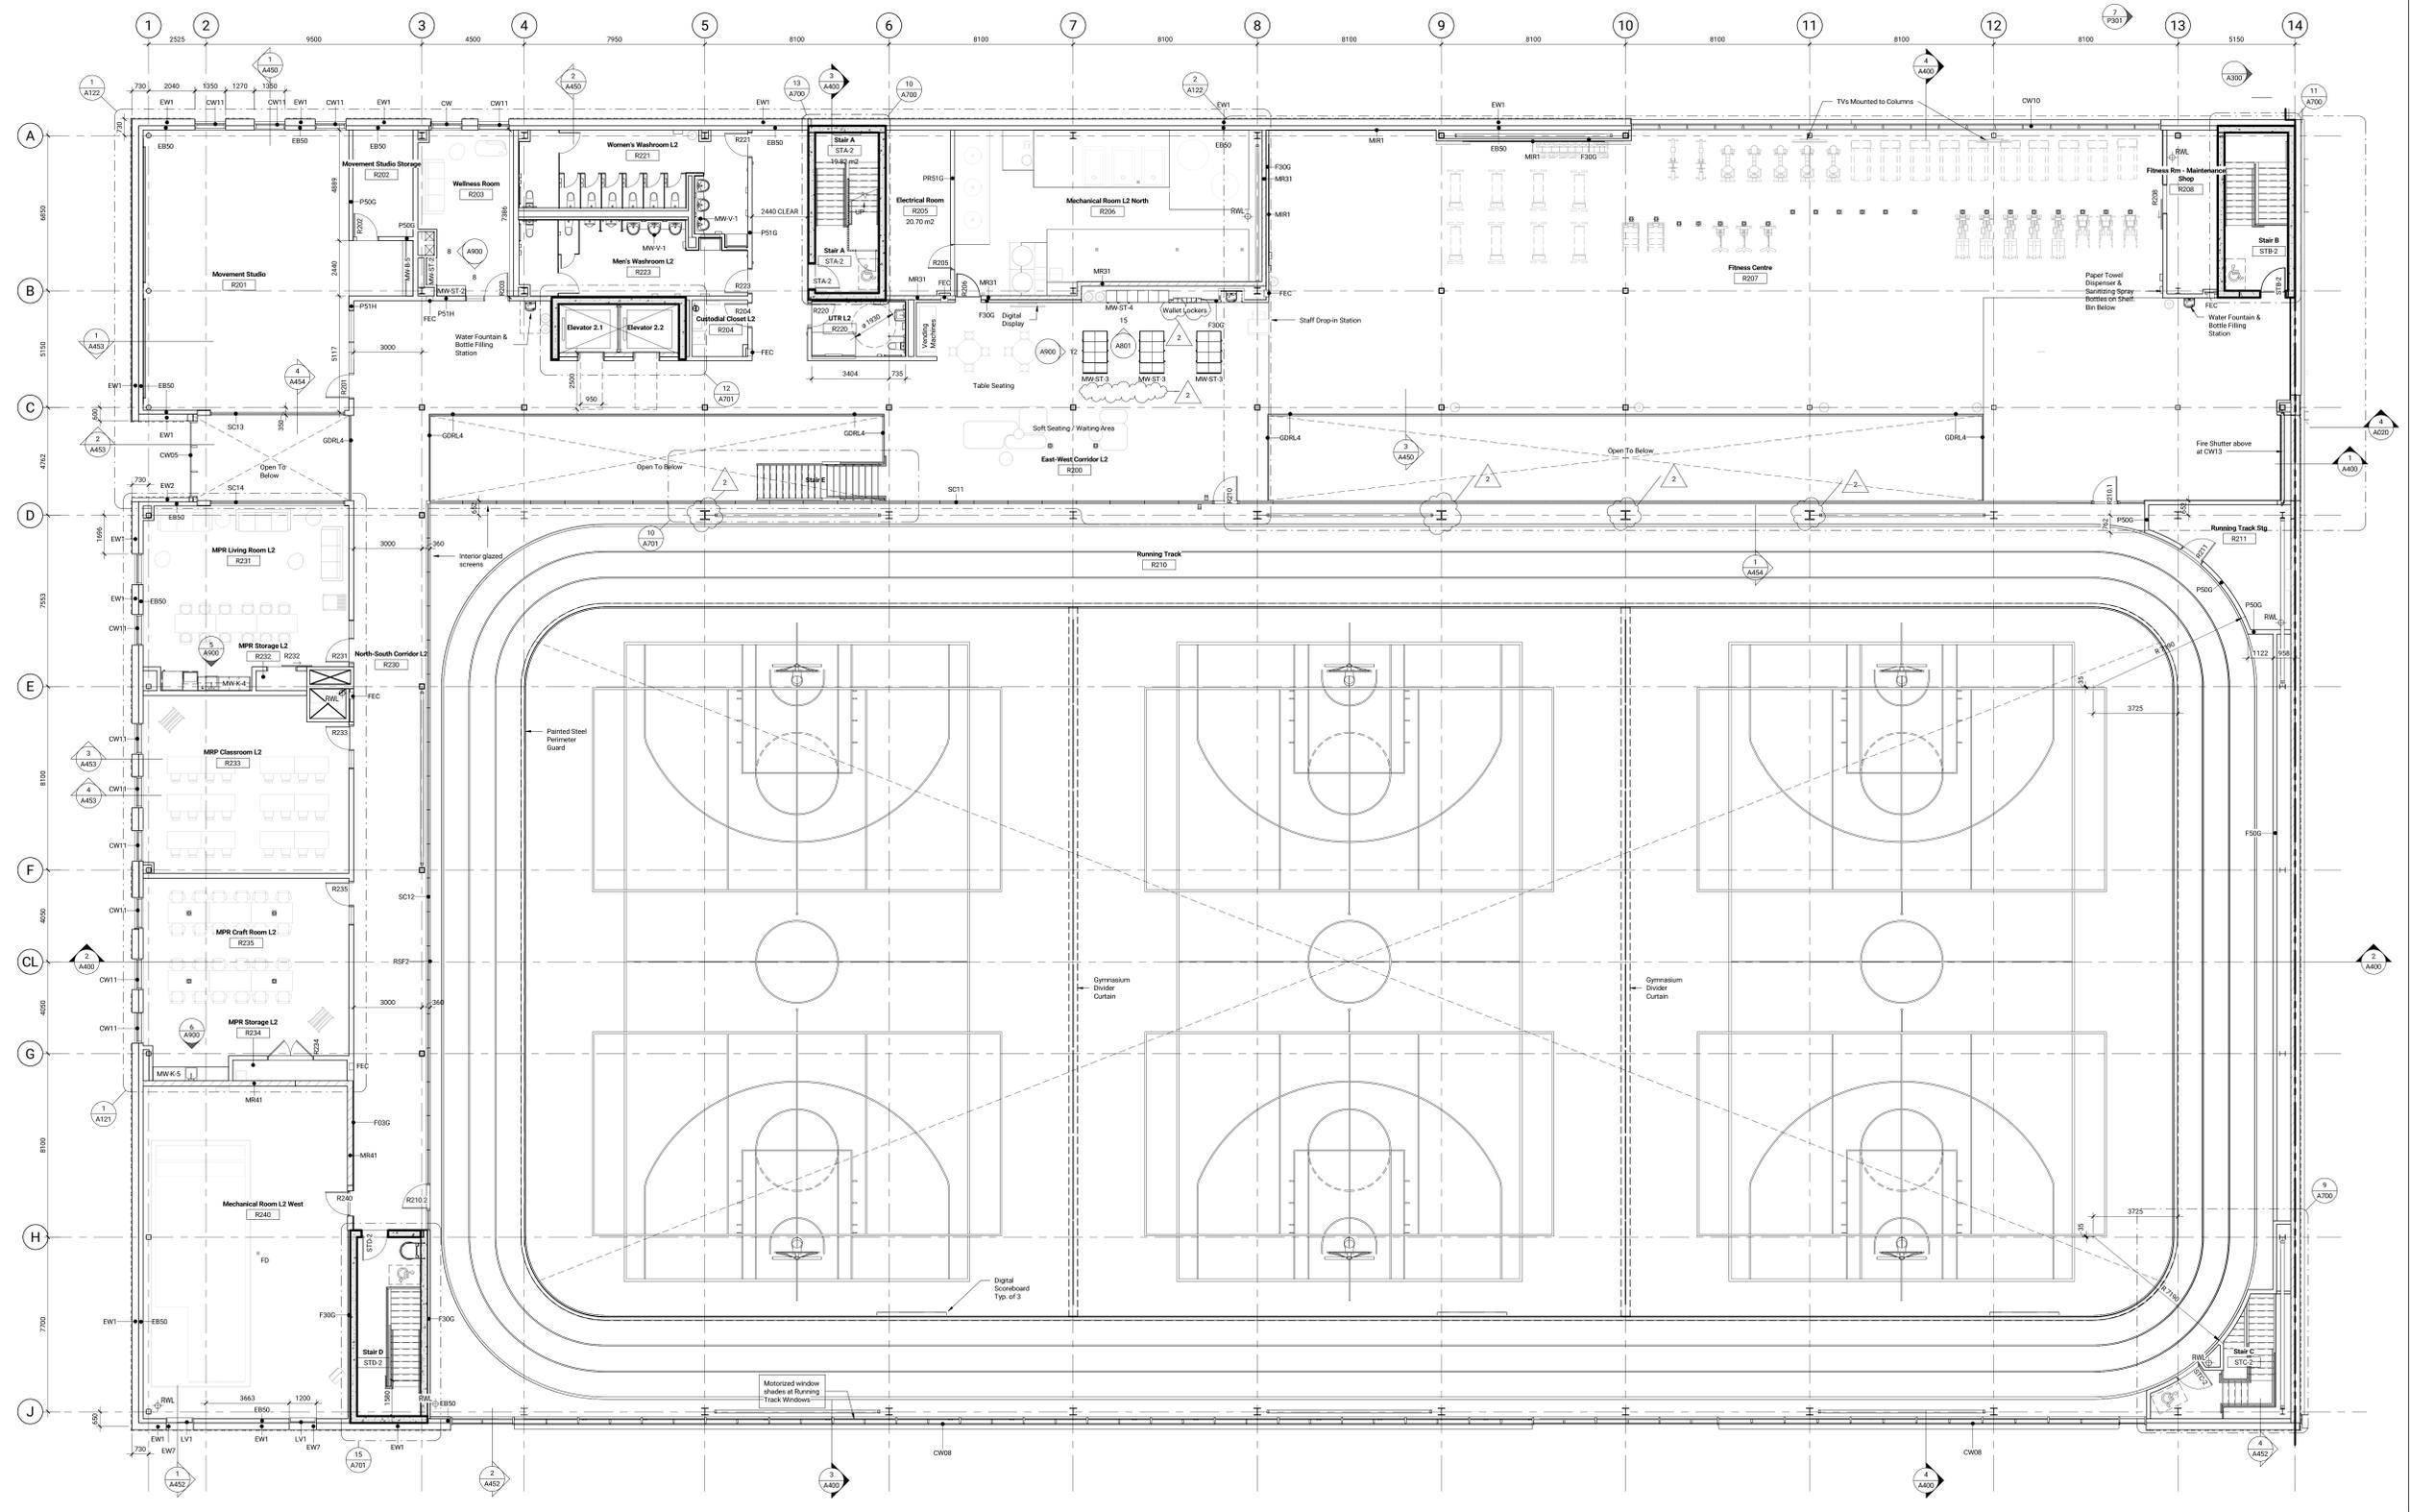

Contractor Must Check & Verify all Dimensions on the Job.  
Do Not Scale Drawings.  
All Drawings, Specifications and Related Documents are the Copyright Property of the Architect and shall be the Mutual Property. Reproduction or Circulation, Distribution and/or Release of any Part or in Whole is Prohibited Without the Written Permission of the Architect.  
This Drawing is Not to be Used for Construction Until Signed by the Architect.

**South Winnipeg Recreation  
Campus Phase 1**  
Address: 15 Ruth Crossing & 25 Ruth Crossing  
Winnipeg, MB  
Consultant Project No: 220007  
City of Winnipeg Project No: 2020/127  
City of Winnipeg Tender No: CS-2025B