




No.	Date	Description
1	2025/12/11	Contract Documents
2	2026/01/15	Addendum 3

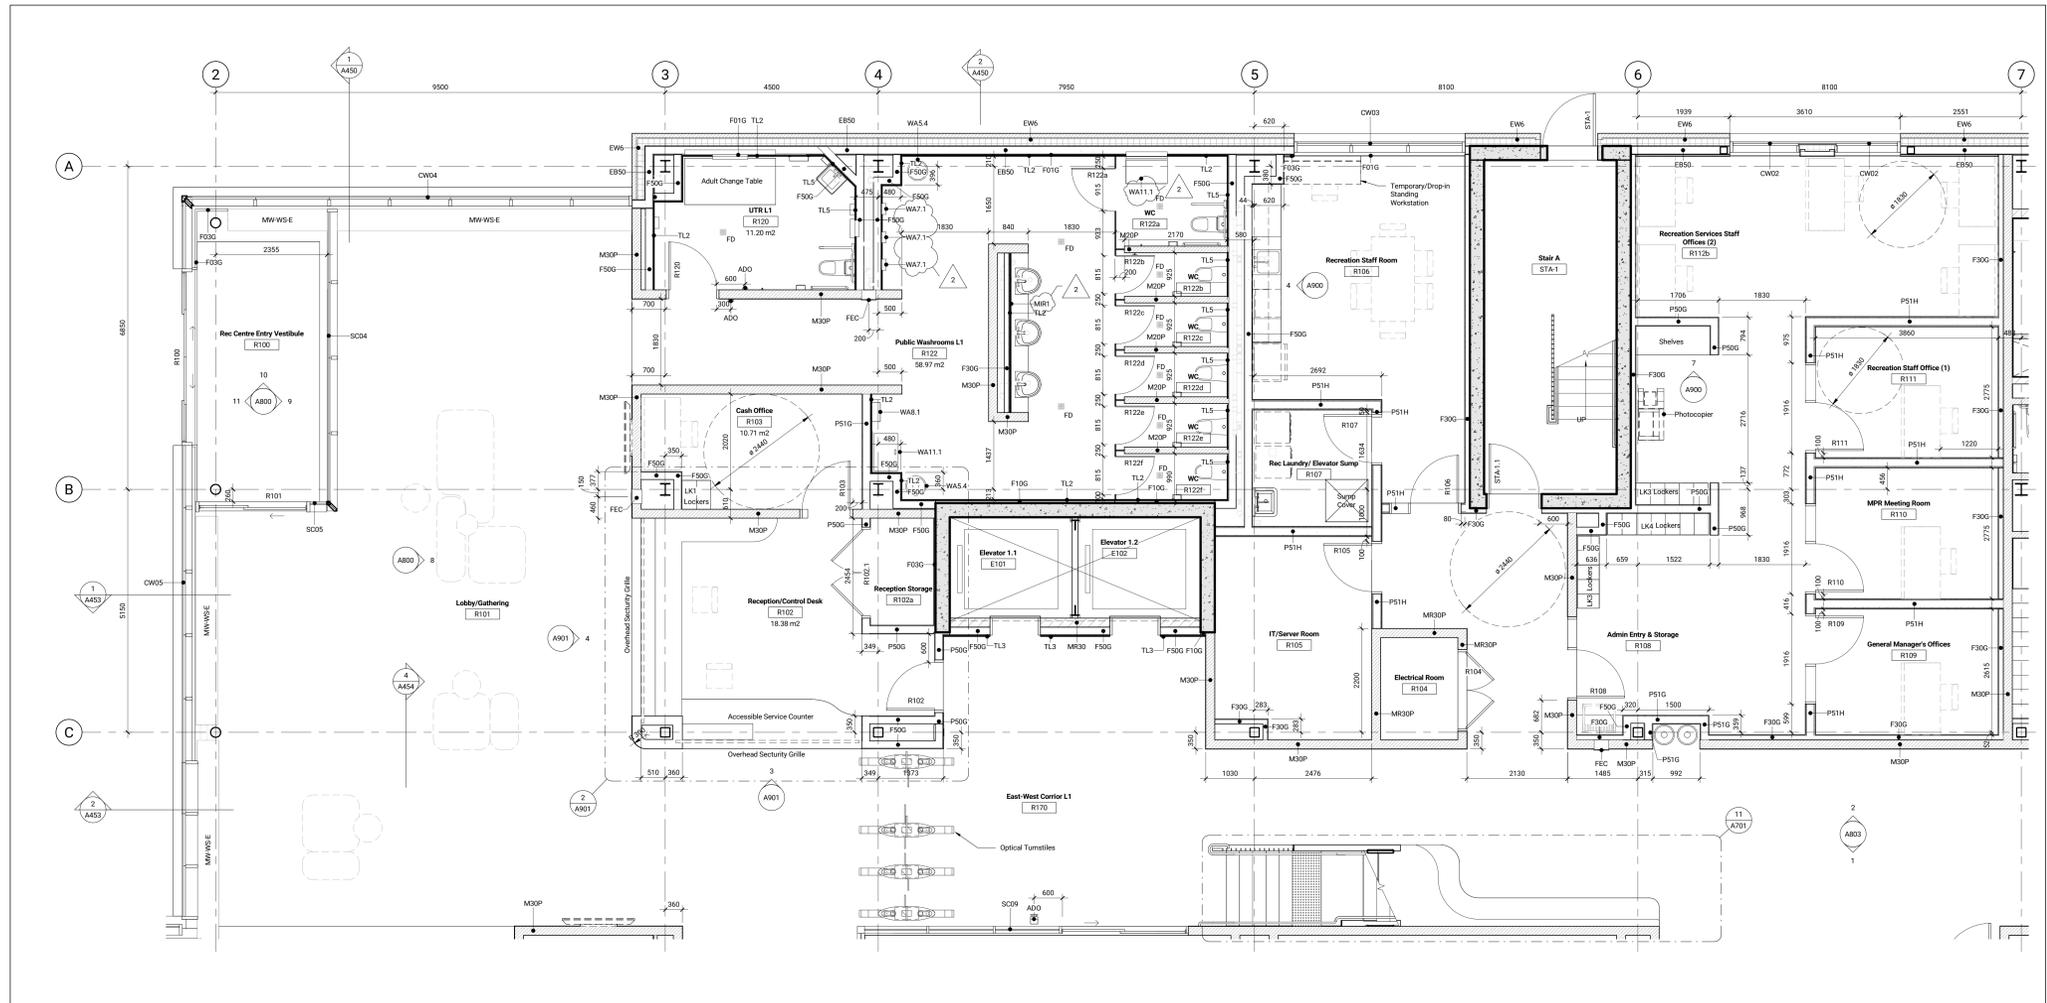

Level 1 Enlarged Plan - Recreation Centre - Reception and Admin Department 1:50 A120

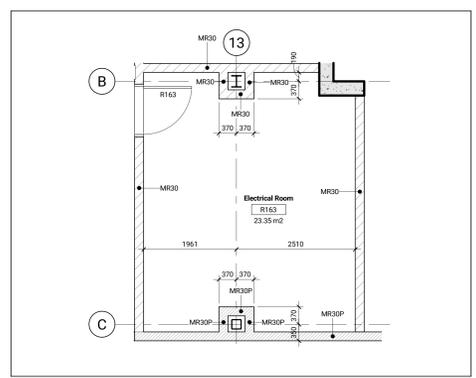

Level 1 Enlarged Plan - Recreation Centre - Electrical Room 1:50 A120

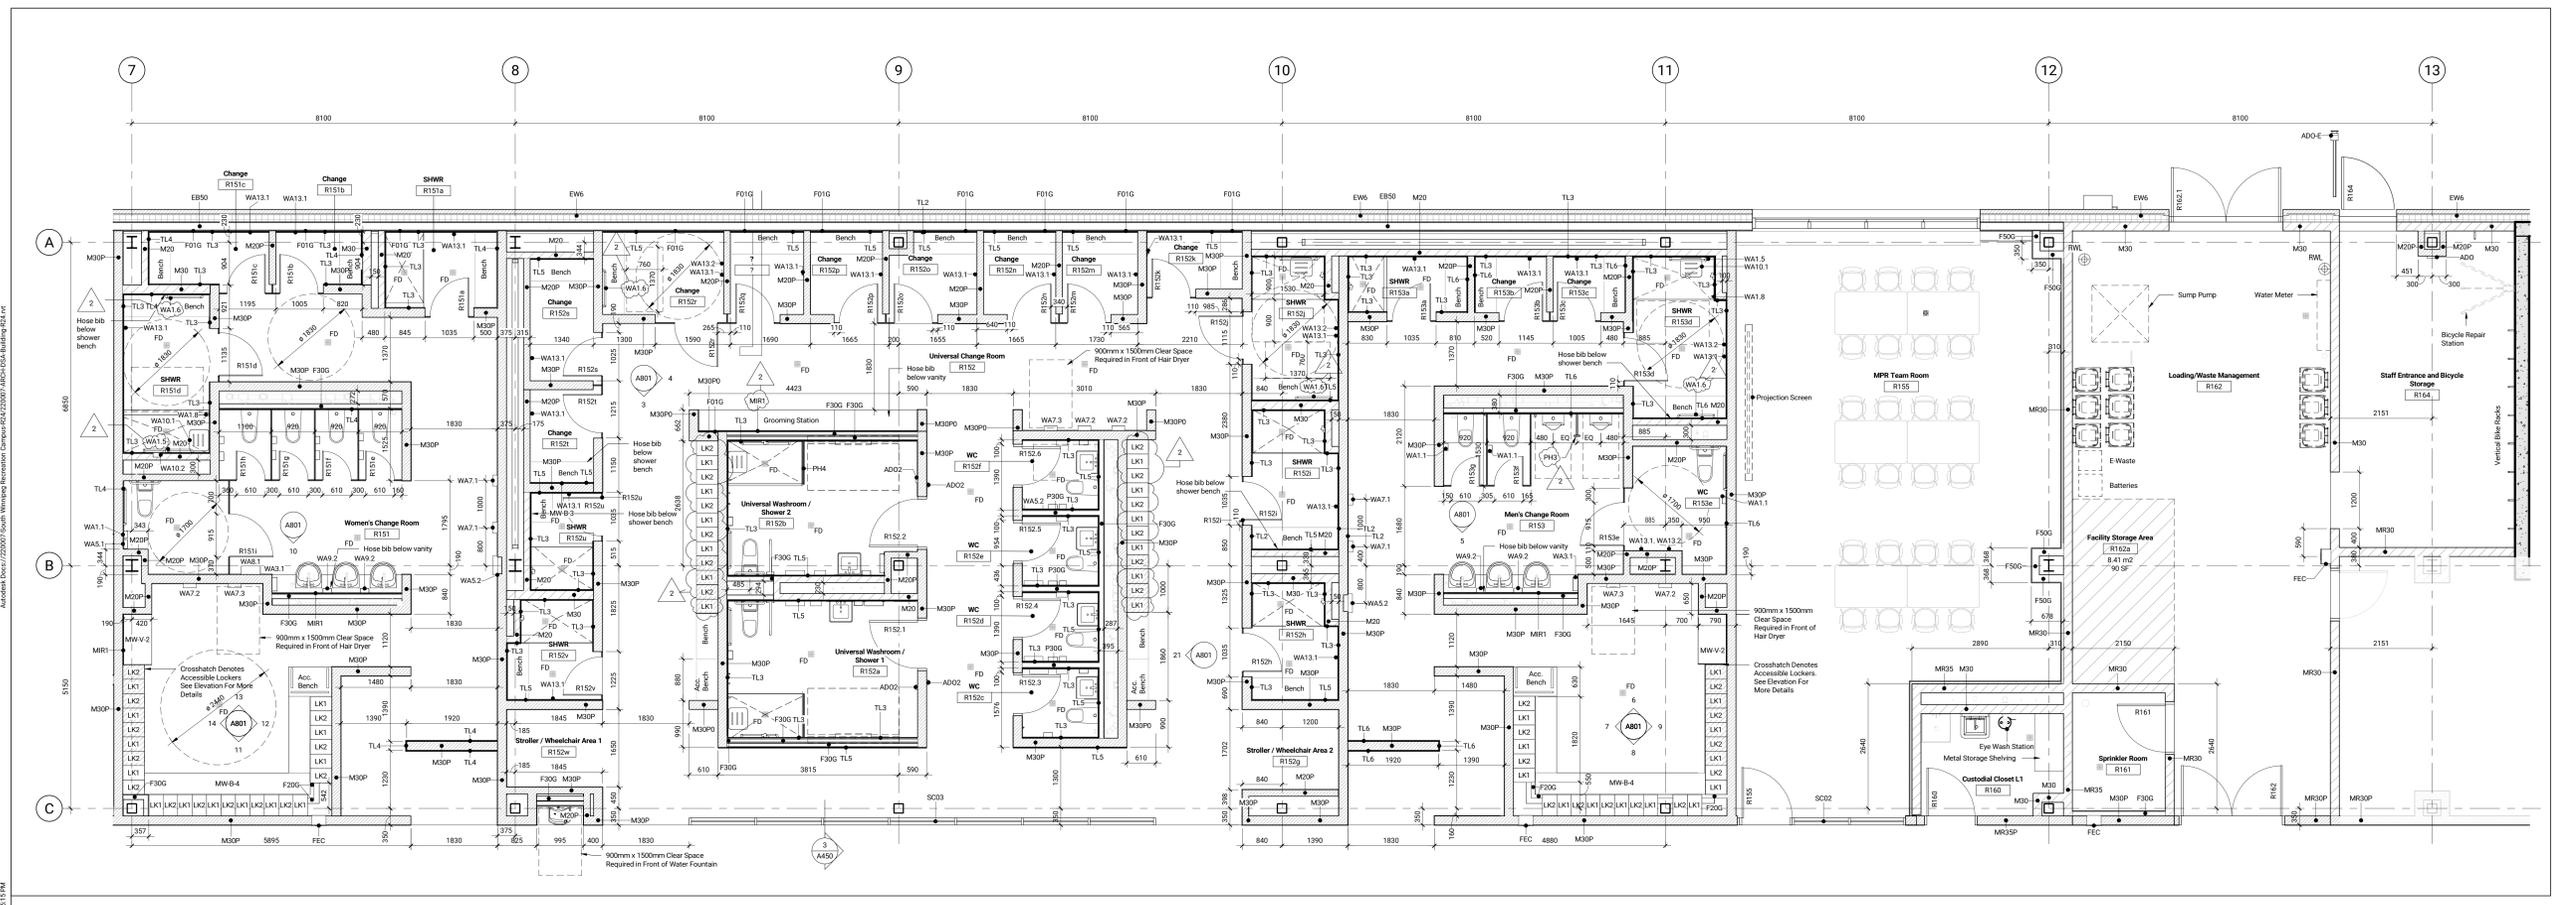

Level 1 Enlarged Floor Plans - Recreation Centre GL-A to GL-C 1:50 A120

Contractor Must Check & Verify All Dimensions on the Job.  
Do Not Scale Drawings.  
All Drawings, Specifications and Related Documents are the Copyright Property of the Architect and shall be returned upon Request. Reproduction or Circulation, Modification or Release of Documents or Parts in Whole or in Part without the Written Permission of the Architect.  
This Drawing is Not to be Used for Construction Until Signed by the Architect.

**South Winnipeg Recreation  
Campus Phase 1**  
Address: 15 Ruth Crossing & 25 Ruth Crossing  
Winnipeg, MB  
Consultant Project No.: 220007  
City of Winnipeg Project No.: 2020/127  
City of Winnipeg Tender No.: 63-2020B