LEGEND

Plan Symbols

- Ceiling Type/Height Above Floor Level
- Recessed Potlight
- Recessed Wall Wash Potlight
- Pendant Light Fixture
- Wall Mounted Luminaire
- Wall Mounted Linear Luminaire
- Round Surface Mounted Luminaire
- Recessed Luminaire
- Surface Mounted Luminaire
- Suspended Luminaire
- Strip Lighting
- Track Lighting Fixture
- Spotlight
- Sprinkler Head - Upright
- Sprinkler Head - Concealed
- Sprinkler Head - Pendant
- Sprinkler Head - Side Wall/Window
- Supply Air Diffuser
- Return Air Diffuser
- Linear Diffuser
- Exhaust Arm
- Radiant Panel
- Access Panel
- Roller Blind
- Projection Screen
- Occupancy Sensor
- Daylight Sensor
- Specialty Sensor
- Speaker - Low Level Paging
- Speaker - Audio/Visual
- Fire Alarm - Speaker/Strobe
- Fire Alarm - Bell
- Fire Alarm - Strobe
- Fire Alarm - Horn/Strobe
- Smoke Detector
- Exit Sign - Ceiling Mounted
- Exit Sign - Wall Mounted
- Emergency Light
- Camera - Security
- Camera - Security Wall Mounted
- Camera - Audio/Visual
- Camera - Audio/Visual Wall Mounted
- Clock - Wall Mounted
- Suspended Projector (N.I.C.)
- TRX Mount
- Ceiling Mounted Outlet

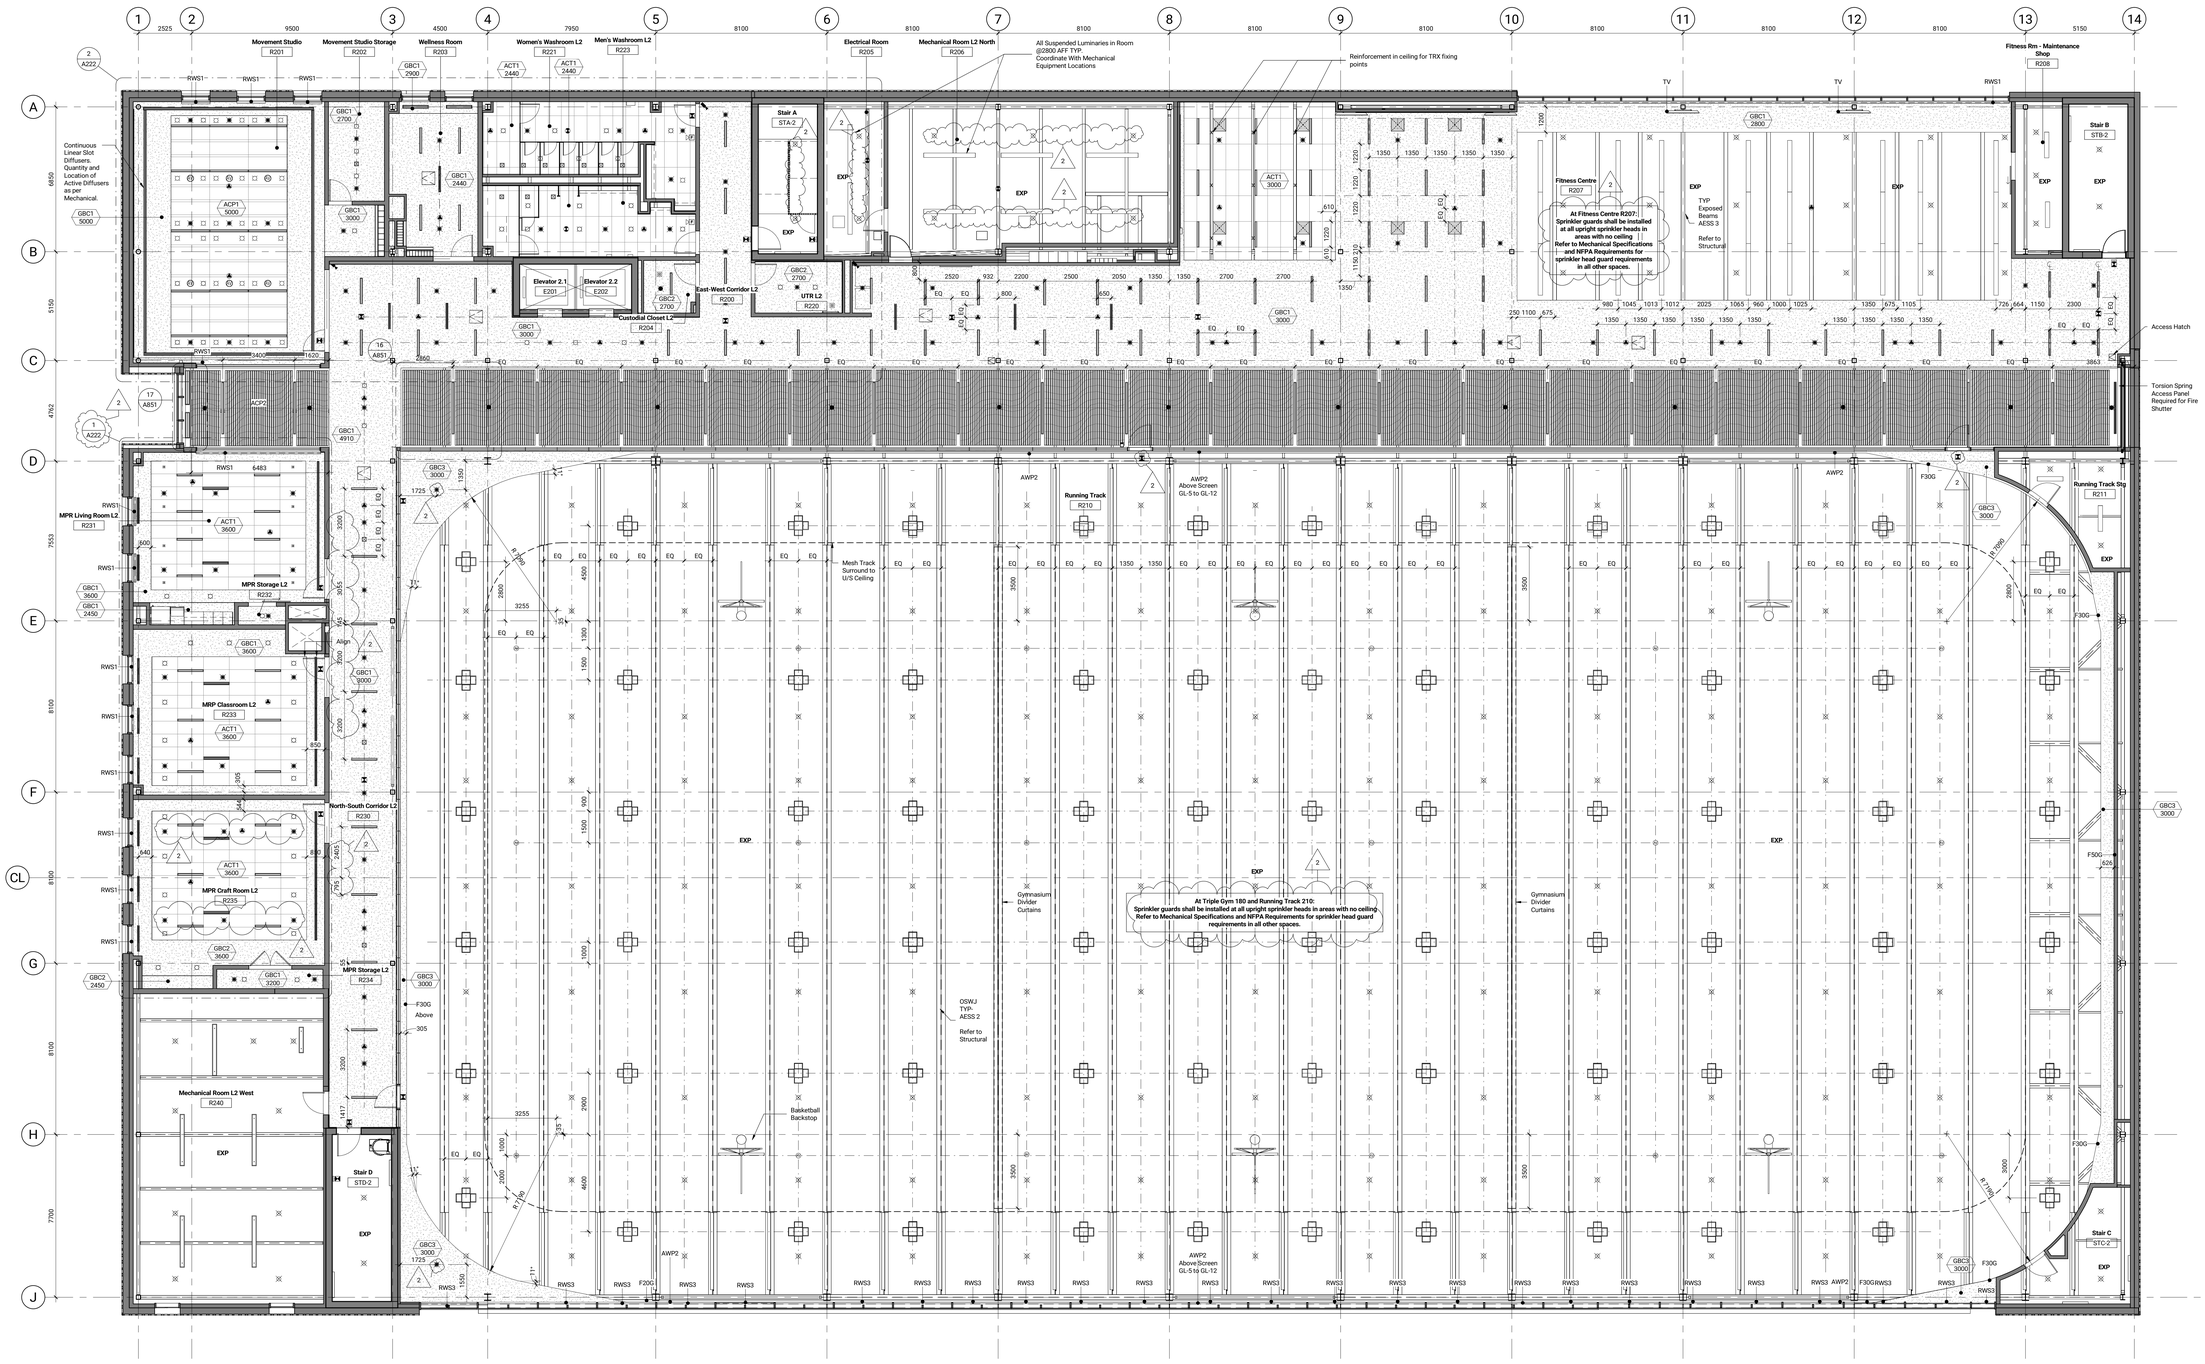

diamond schmitt
BrookMcIlroy/

Winnipeg
THE CITY OF WINNIPEG
ASSETS & PROJECT MANAGEMENT DEPARTMENT
MUNICIPAL ACCOMMODATIONS DIVISION
3-65 GARRY STREET, R3C 4K4

Manitoba
Manitoba Public Service Delivery
200 - 400 Ellice Avenue,
Winnipeg, Manitoba
R3B 3M3

Issued

No.	Date	Description
1	2025/12/11	Contract Documents
2	2026/01/15	Addendum 3

Contractor Must Check & Verify all Dimensions on the Job.

Do Not Scale Drawings.

All Drawings, Specifications and Related Documents are the Copyright Property of the Architect and Must be Returned Upon Request. Reproduction of Drawings, Specifications and Related Documents in Part or in Whole is Forbidden Without the Written permission of the Architect.

This Drawing is Not to be Used for Construction Until Signed by the Architect.

South Winnipeg Recreation Campus Phase 1

Address: 15 Ruth Crossing & 25 Ruth Crossing
Winnipeg, MB
Consultant Project No: 220007
City of Winnipeg Project No: 2020-127
City of Winnipeg Tender No: 63-20258

Level 2 - Reflected Ceiling Plan - Recreation Centre

1 : 100

A211

Autodesk Docs://220007-South Winnipeg Recreation Campus/R24/220007-ARCH-05A-Building-R24.rvt

2026-01-15 6:05:26 PM