


Level 2 Enlarged RCP Movement Studio & Washrooms  
1:50 A222

- LEGEND**
- Plan Symbols**
- Ceiling Type/height Above Floor Level
  - Recessed Putlight
  - Recessed Wall Wash Potlight
  - Pendant Light Fixture
  - Wall Mounted Luminaire
  - Wall Mounted Linear Luminaire
  - Round Surface Mounted Luminaire
  - Recessed Luminaire
  - Surface Mounted Luminaire
  - Suspended Luminaire
  - Strip Lighting
  - Track Lighting Fixture
  - Spotlight
  - Sprinkler Head - Upright
  - Sprinkler Head - Concealed
  - Sprinkler Head - Pendant
  - Sprinkler Head - Side Wall/Window
  - Supply Air Diffuser
  - Return Air Diffuser
  - Linear Diffuser
  - Exhaust Arm
  - Radiant Panel
  - Access Panel
  - Roller Blind
  - Projection Screen
  - Occupancy Sensor
  - Daylight Sensor
  - Specialty Sensor
  - Speaker - Low Level Paging
  - Speaker - Audio/Visual
  - Fire Alarm - Speaker/Strobe
  - Fire Alarm - Bell
  - Fire Alarm - Strobe
  - Fire Alarm - Horn/Strobe
  - Smoke Detector
  - Exit Sign - Ceiling Mounted
  - Exit Sign - Wall Mounted
  - Emergency Light
  - Camera - Security
  - Camera - Security Wall Mounted
  - Camera - Audio/Visual
  - Camera - Audio/Visual Wall Mounted
  - Clock - Wall Mounted
  - Suspended Projector (N.I.C.)
  - TRX Mount
  - Ceiling Mounted Outlet

Issued

No.	Date	Description
1	2025/12/11	Contract Documents
2	2026/01/15	Addendum 3

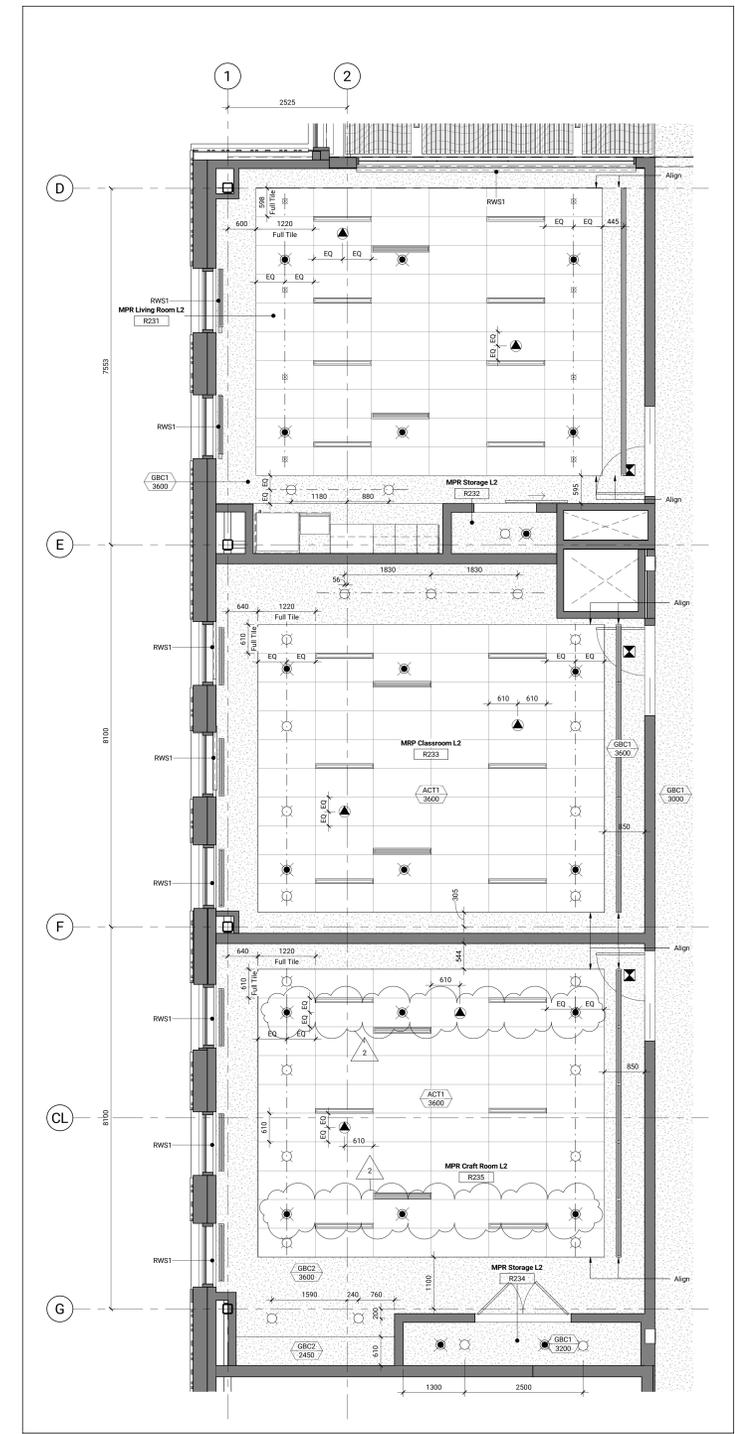

Level 2 Enlarged RCP - MPR  
1:50 A222

2026-01-15 6:05:22 PM Autodesk Docs://220007-South Winnipeg Recreation Campus-RCP-A222-001-004-Building-02.rvt