




Level 1 Plan - Stair C
1:50 A700

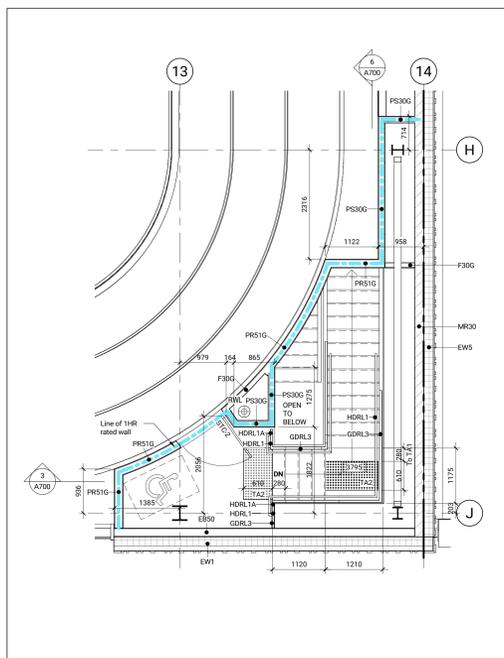


Level 2 Plan - Stair C
1:50 A700

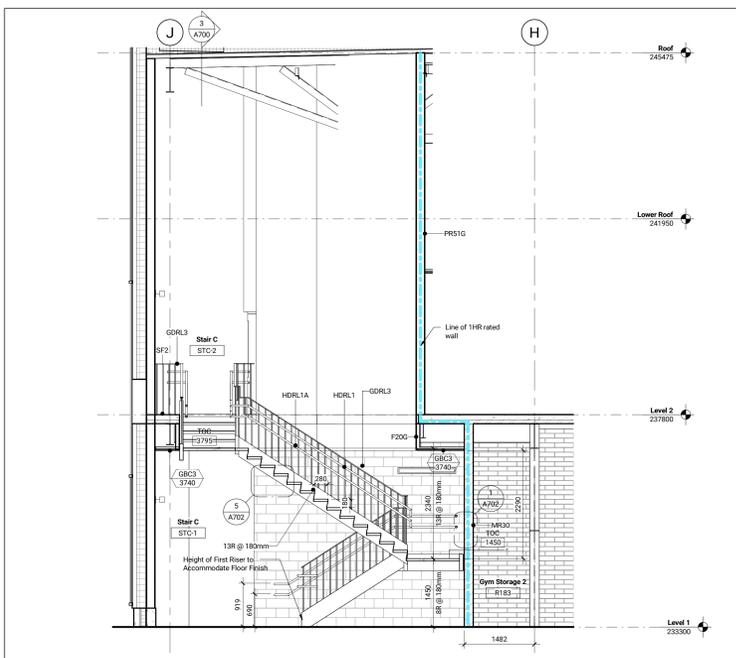


Stair C - Long Section
1:50 A700

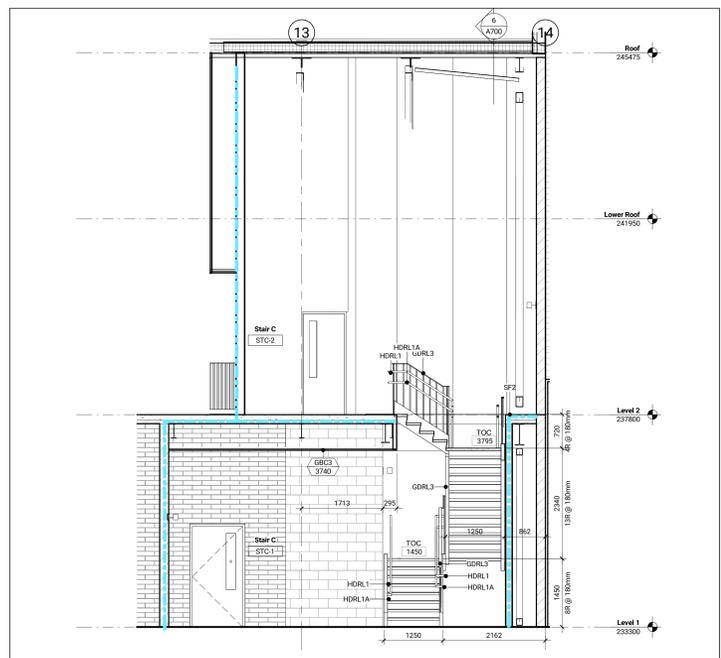


Stair C - Short Section
1:50 A700

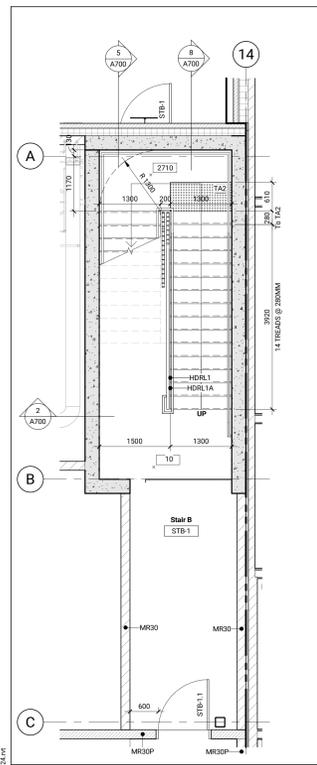


Level 1 Plan - Stair B
1:50 A700

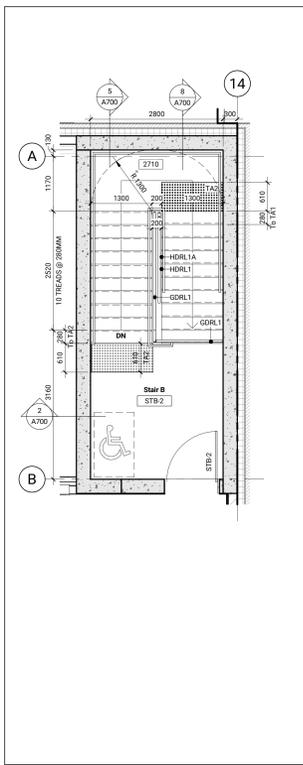


Level 2 Plan - Stair B
1:50 A700

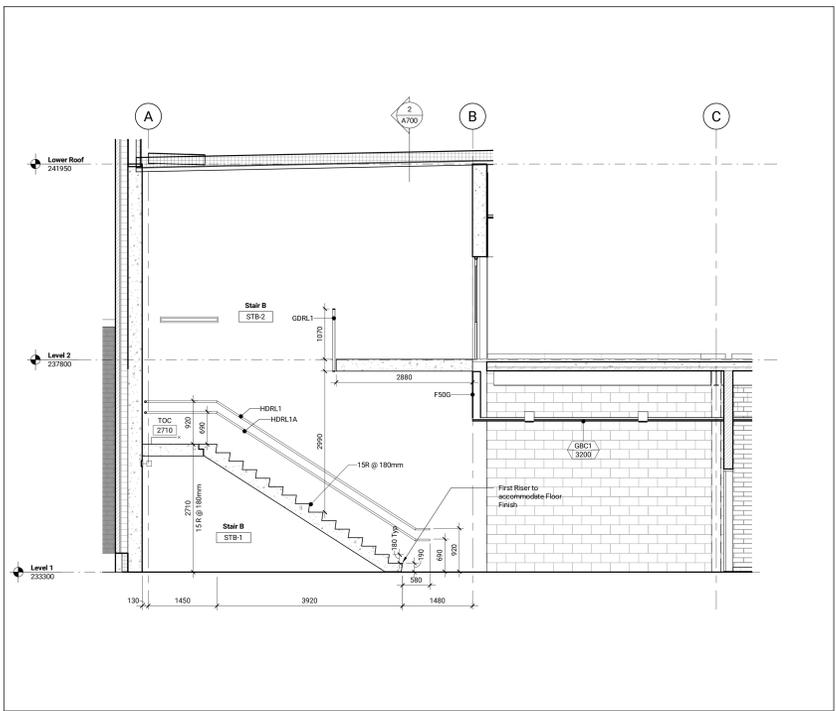


Stair B - Long Section
1:50 A700

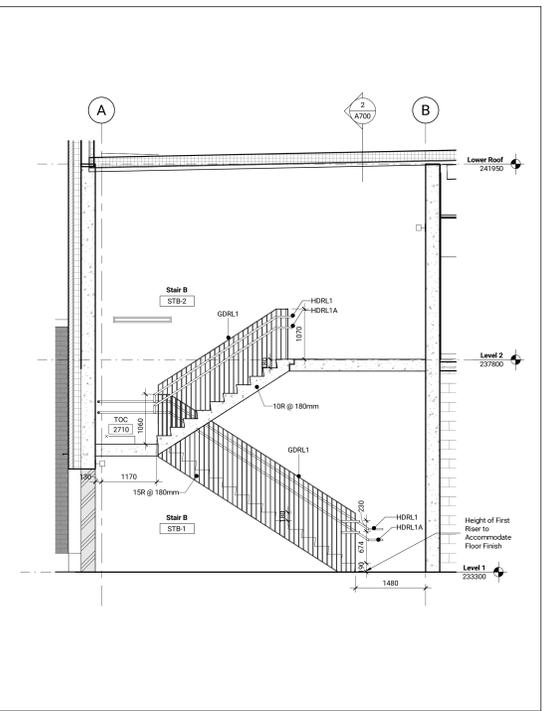


Stair B - Long Section 2
1:50 A700

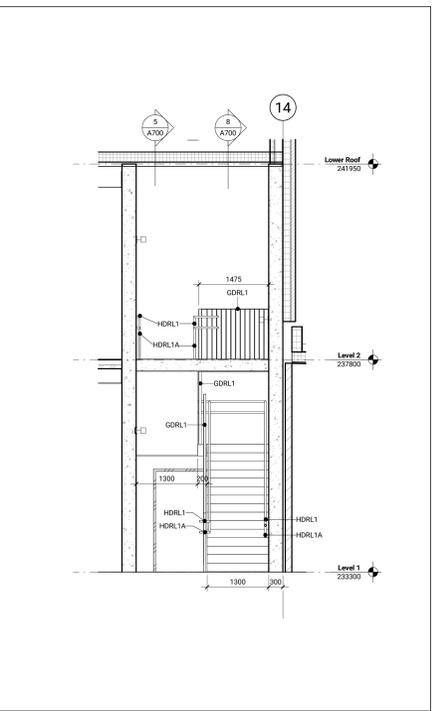


Stair B - Short Section
1:50 A700

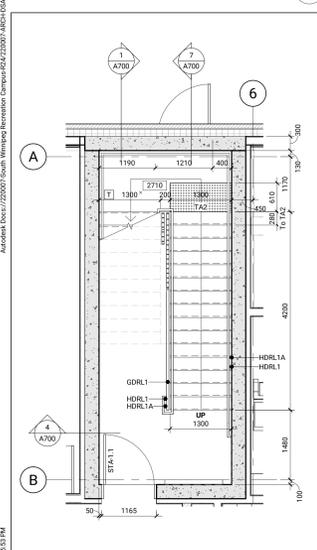


Level 1 Plan - Stair A
1:50 A700

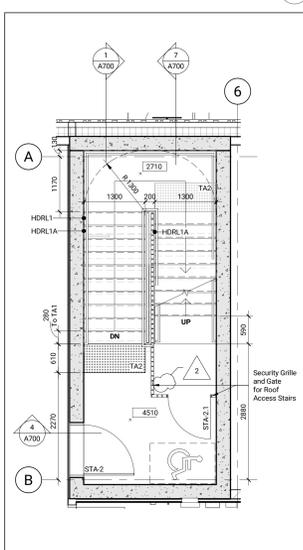


Level 2 Plan - Stair A
1:50 A700

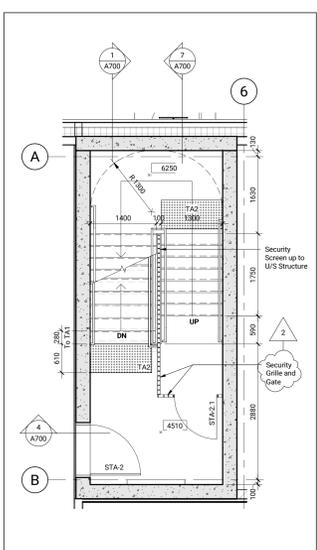


Level 2 Plan - Stair A (Roof Access)
1:50 A700

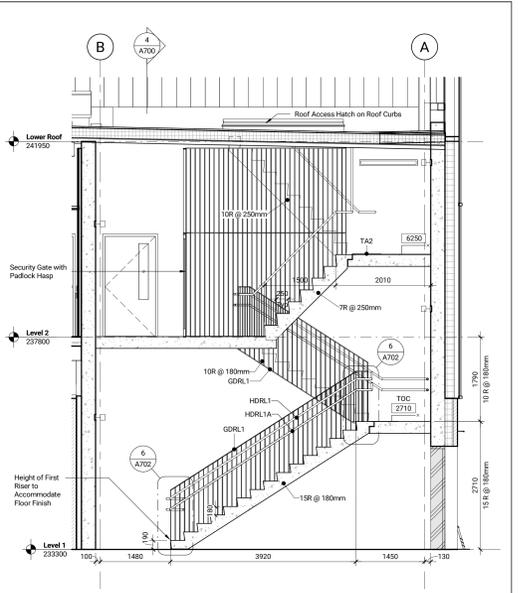

Stair A - Long Section - West
1:50 A700

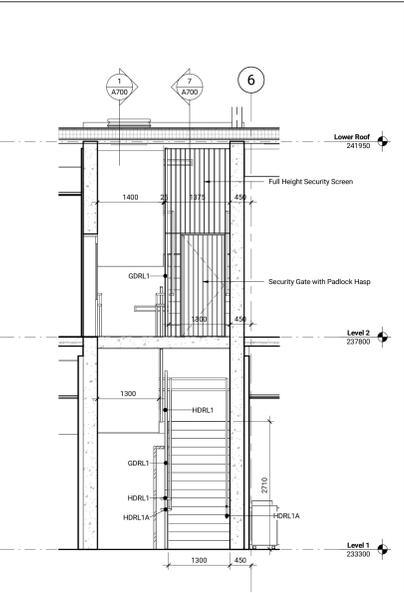

Stair A - Short Section
1:50 A700

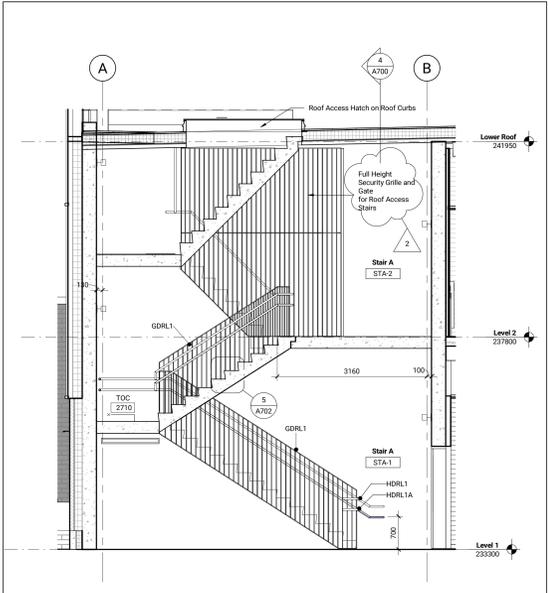

Stair A - Long Section - East
1:50 A700

No.	Date	Description
1	2025/12/11	Contract Documents
2	2025/01/15	Addendum 3

Contractor Must Check & Verify all Dimensions on the Job.
Do Not Scale Drawings.
All Drawings, Specifications and Related Documents are the Copyright Property of the Architect and shall be returned upon Request. Reproduction or Circulation, Distribution and Release of these Documents or Parts in Whole or in Part without the Written Permission of the Architect.
This Drawing is Not to be Used for Construction Until Signed by the Architect.

South Winnipeg Recreation
Campus Phase 1
Address: 15 Ruth Crossing & 25 Ruth Crossing
Winnipeg, MB
Consultant Project No: 220007
City of Winnipeg Project No: 2020/127
City of Winnipeg Tender No: 63-2022B