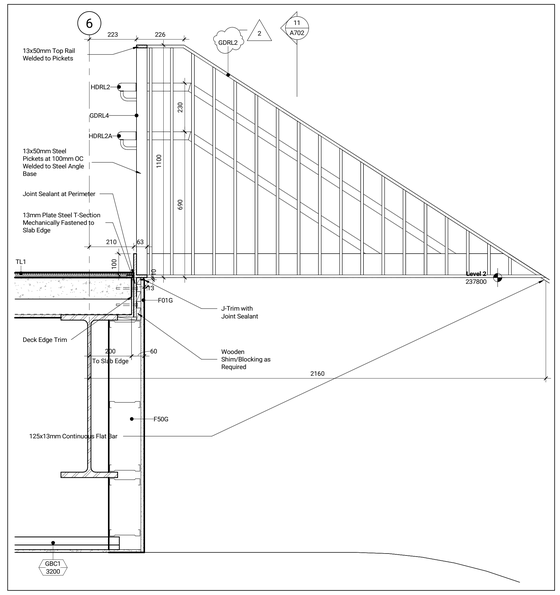

Stair E - Elevation Copy 1
1 : 10 (14 / A702)

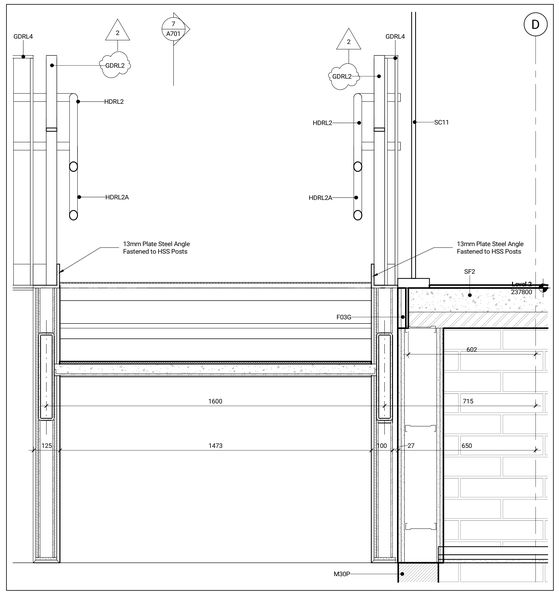

Stair E - Short Section1
1 : 10 (11 / A702)

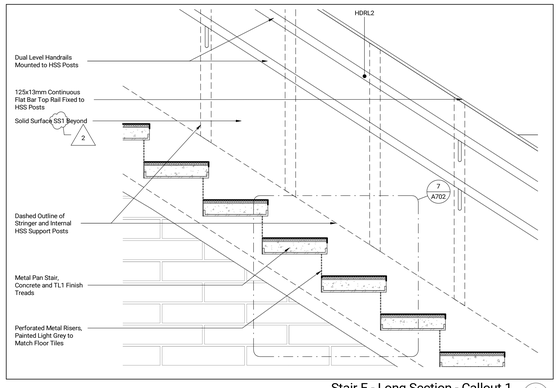

Stair E - Long Section - Callout 1
1 : 10 (8 / A702)

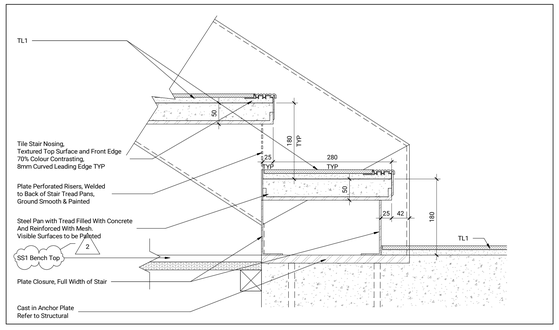

Stair E - Section - Stair Pan Lower Connection
1 : 5 (4 / A702)

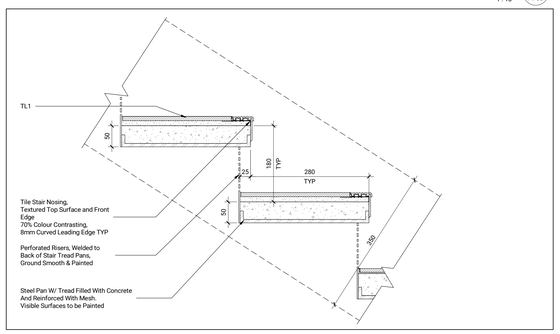

Stair E - Section - Typical Metal Pan Treads & Risers
1 : 5 (7 / A702)

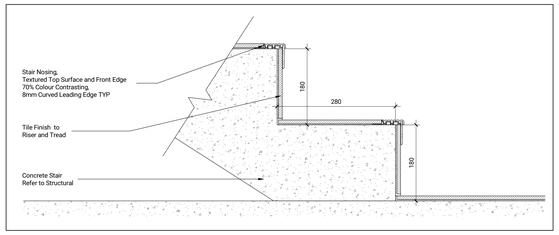

Stair E - Section - Concrete Stair Lower Connection
1 : 5 (3 / A702)

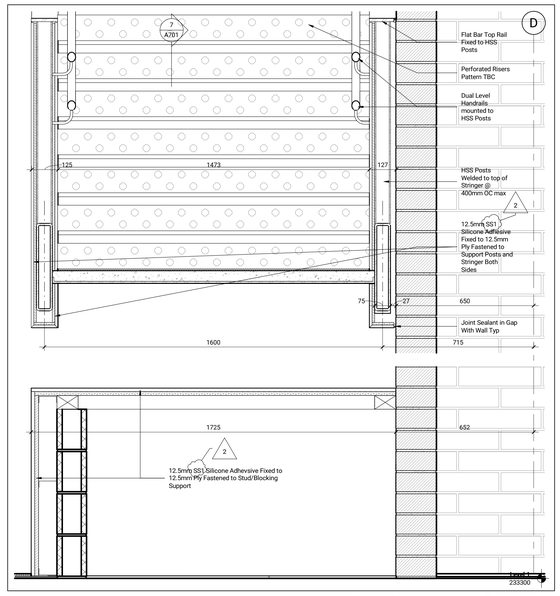

Stair E - Short Section - Callout 1
1 : 10 (13 / A702)

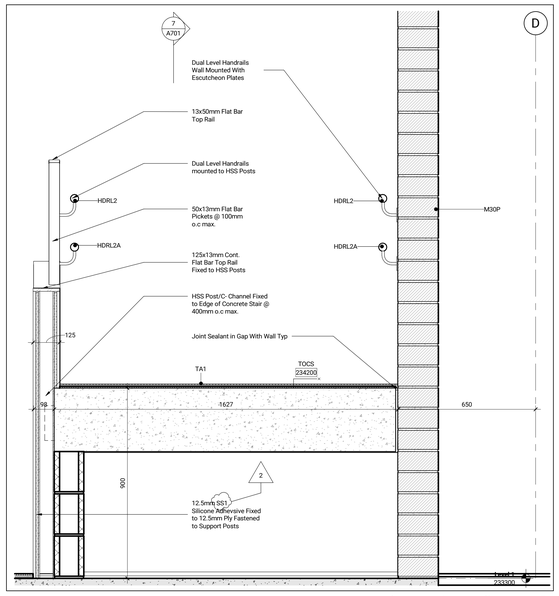

Stair E - Short Section - Callout 2
1 : 10 (10 / A702)

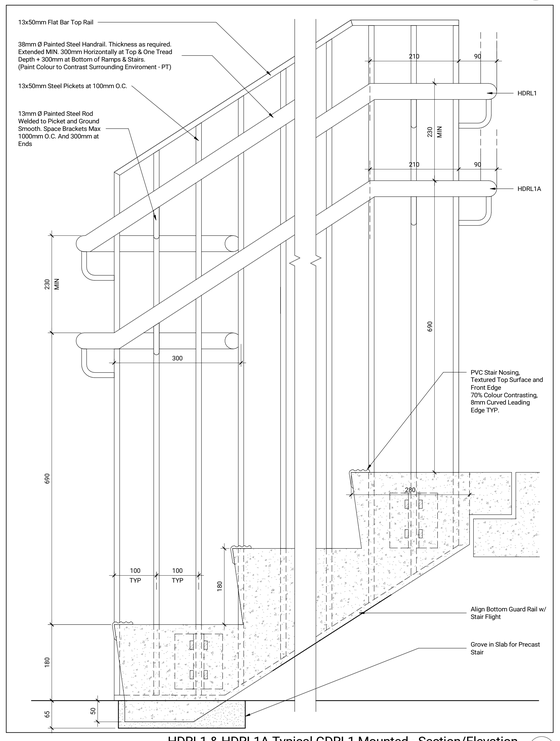

HDRL1 & HDRL1A Typical GDRL1 Mounted - Section/Elevation
1 : 5 (6 / A702)

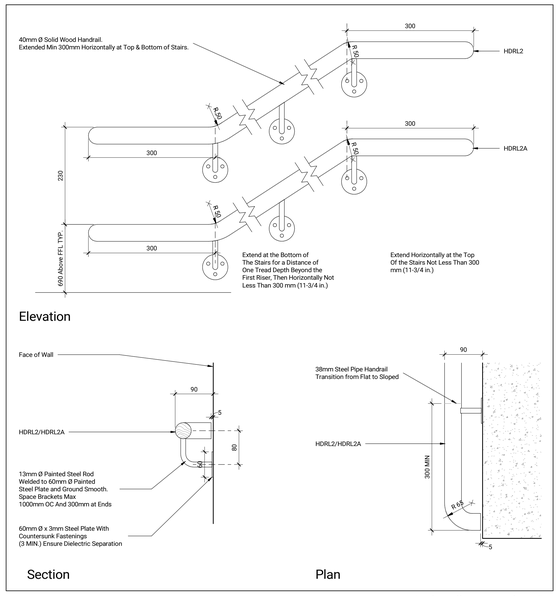

HDRL2 & HDRL2A Typical Wall Mounted
1 : 5 (2 / A702)

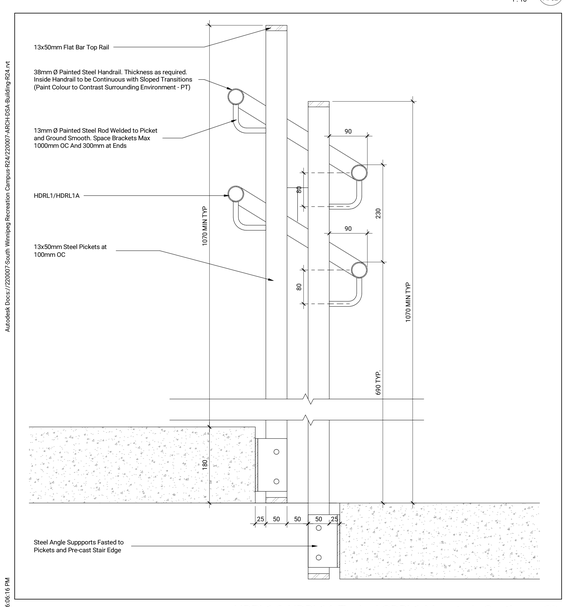

HDRL1 & HDRL1A Typical GDRL1 Mounted - Section
1 : 5 (12 / A702)

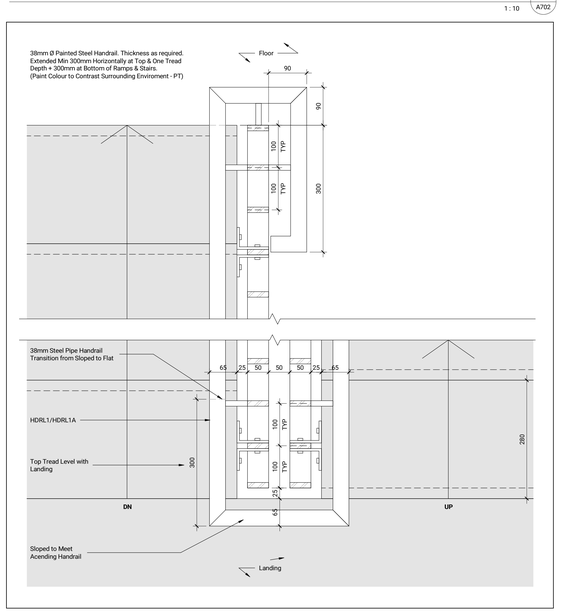

HDRL1 & HDRL1A Typical GDRL1 Mounted - Plan
1 : 5 (9 / A702)

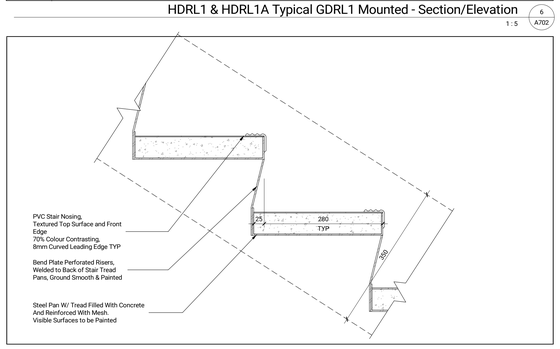

Stair C Nosing - Section
1 : 5 (5 / A702)

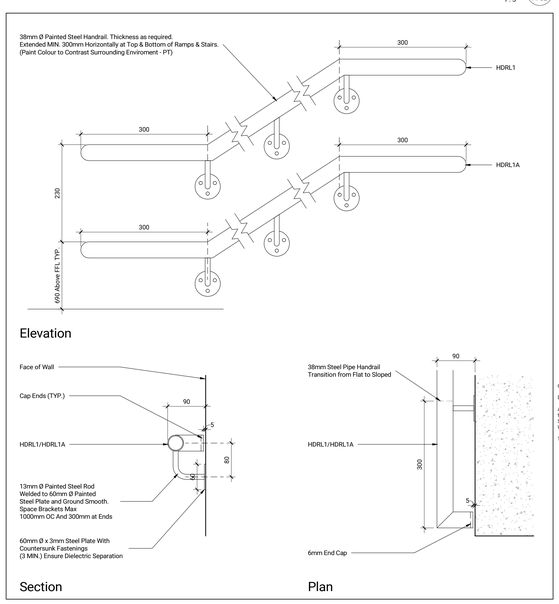

HDRL1 & HDRL1A Typical Wall Mounted
1 : 5 (1 / A702)

diamond schmitt
BrookMcIlroy/

Winnipeg
THE CITY OF WINNIPEG
ASSETS & PROJECT MANAGEMENT DEPARTMENT
MUNICIPAL ACCOMMODATIONS DIVISION
3-65 GARRY STREET, R3C 4K4

Manitoba
Manitoba Public Service Delivery
200 - 400 Ellice Avenue,
Winnipeg, Manitoba
R3B 3M3

Issued

No.	Date	Description
1	2025/12/11	Contract Documents
2	2026/01/15	Addendum 3

Contractor Must Check & Verify all Dimensions on the Job.

Do Not Scale Drawings.

All Drawings, Specifications and Related Documents are the Copyright Property of the Architect and Must be Returned Upon Request. Reproduction of Drawings, Specifications and Related Documents in Part or in Whole is Forbidden Without the Written permission of the Architect.

This Drawing is Not to be Used for Construction Until Signed by the Architect.

South Winnipeg Recreation Campus Phase 1
Address: 15 Ruth Crossing & 25 Ruth Crossing
Winnipeg, MB
Consultant Project No: 220007
City of Winnipeg Project No: 2020-127
City of Winnipeg Tender No: 63-20258

Guardrails & Stair Details
As indicated
A702

Autodesk Docs://220007 South Winnipeg Recreation Campus R24/220007-MCH-DSA-Building-R24.rvt

2026-01-15 5:06:16 PM