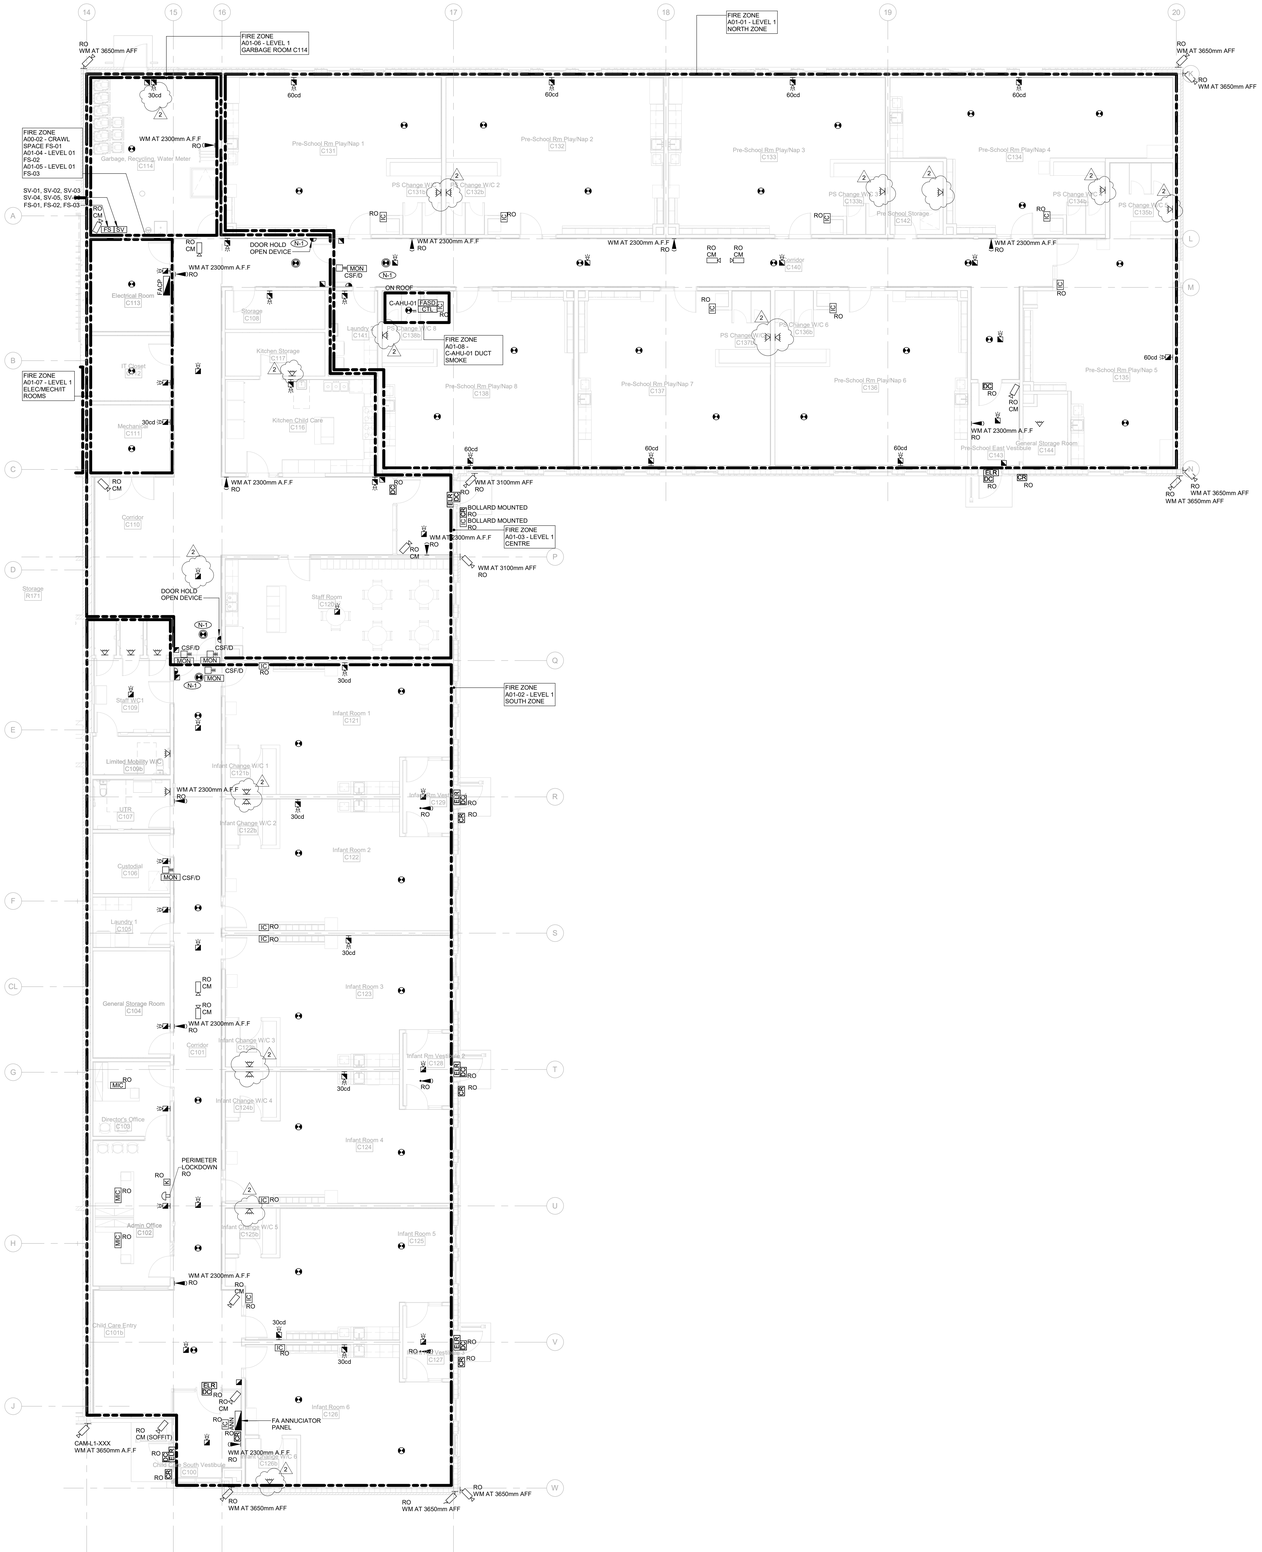

GENERAL NOTES:

1. IN ADDITION TO THE FIRE ALARM DEVICES INDICATED ON DRAWINGS, BASE BID PRICE SHALL INCLUDE FOR PROVISION (SUPPLY AND INSTALL) OF AN ADDITIONAL THREE (3) FIRE ALARM HORN/STROBE FOR THIS FLOOR COMPLETE WITH 100'-0" CONDUIT AND WIRING (PER DEVICE), PROGRAMMING, TESTING AND CERTIFICATION. LABELING AND 100% REPEAT VERIFICATION FOR EACH DEVICE POST CITY FIRE DEPARTMENT INSPECTION.
2. FIRE ALARM SUBCONTRACTOR/VENDOR/MANUFACTURER IS RESPONSIBLE TO ENSURE THAT ALL COMPONENTS (MATERIAL, SOFTWARE, INCLUDING ANY LABOUR TO INSTALL FIRE ALARM DEVICES) ARE INCLUDED FOR BASED ON THE ISSUED DRAWINGS. ELECTRICAL SUBCONTRACTOR TO ALLOW FOR ALL ASSOCIATED COSTS. PROVIDE NEW FIRE ALARM BOOSTER AS REQUIRED. ALLOW FOR ALL ASSOCIATED COSTS INCLUDING BUT NOT LIMITED TO, ASSOCIATED EQUIPMENT, DEVICES, PROGRAMMING, TESTING AND VERIFICATION TO MAKE THE SYSTEM OPERATIONAL AND CODE COMPLIANT. ALL FIRE ALARM VERIFICATION SHALL CONFORM TO CAN/ULC-S537 LATEST EDITION. FIRE ALARM SYSTEM SHALL BE INSTALLED IN CONFORMANCE WITH CAN/ULC-S524 LATEST EDITION. FIRE ALARM AUDIBILITY TEST SHALL BE PERFORMED WITH BOTH THE DOORS OPEN AND DOORS CLOSED.

DRAWING NOTES:

N-1 PROVIDE DUAL-CONTACT DETECTOR ON EITHER SIDE OF DOOR FOR DOOR HOLD HARDWARE. IN EVENT OF FIRE ALARM ACTIVATION SIGNAL FROM BASE BUILDING OR LOCAL SMOKE DETECTION, DOOR HOLD HARDWARE TO RELEASE AND CLOSE DOOR. DOOR HOLD HARDWARE SUPPLIED AND INSTALLED BY OTHERS. PROVIDE POWER TO DOOR HOLD CONTROLLER FROM AUTOMATIC DOOR OPENER CIRCUIT INDICATED ON E311. COORDINATE LOCATION ON SITE.

diamond schmitt
BrookMcIlroy/

APEGM
Certificate of Authorization
Smith + Andersen
No. 5990 Date: 2026/01/15

PROVINCE OF MANITOBA
2026/01/15
EXPIRES
PROFESSIONAL ENGINEER
ISSUED
22522.000.E.001

Smith + Andersen
700 - 161 Portage Avenue East, Winnipeg MB, R3B 0Y4
t 204 985 6968 smithandandersen.com

Winnipeg
THE CITY OF WINNIPEG
ASSETS & PROJECT MANAGEMENT DEPARTMENT
MUNICIPAL ACCOMMODATIONS DIVISION
3-65 GARRY STREET, R3C 4K4

Manitoba
Manitoba Public Service Delivery
200 - 400 Ellice Avenue,
Winnipeg, Manitoba
R3B 3M3

Issued

No.	Date	Description
1	2025-12-11	CONTRACT DOCUMENTS
2	2026-01-15	ADDENDUM 3

Contractor Must Check & Verify all Dimensions on the Job.

Do Not Scale Drawings.

All Drawings, Specifications and Related Documents are the Copyright Property of the Engineer and Must be Returned Upon Request. Reproduction of Drawings, Specifications and Related Documents in Part or in Whole is Forbidden Without the Written permission of the Engineer.

This Drawing is Not to be Used for Construction Until Signed by the Engineer.

South Winnipeg Recreation Campus Phase 1
Address: 15 Ruth Crossing & 25 Ruth Crossing
Winnipeg, MB

Consultant Project No: 220007
City of Winnipeg Project No: 2020-127
City of Winnipeg Tender No: 63-2025B

CC - FLOOR PLAN - LEVEL 1 - FIRE ALARM AND SECURITY
1 : 100

E511

Autodesk Docs://22522.000_SWRC_R2026/22522-E-ELEC-A-M24.rvt

2026-01-15 10:30:30 AM