
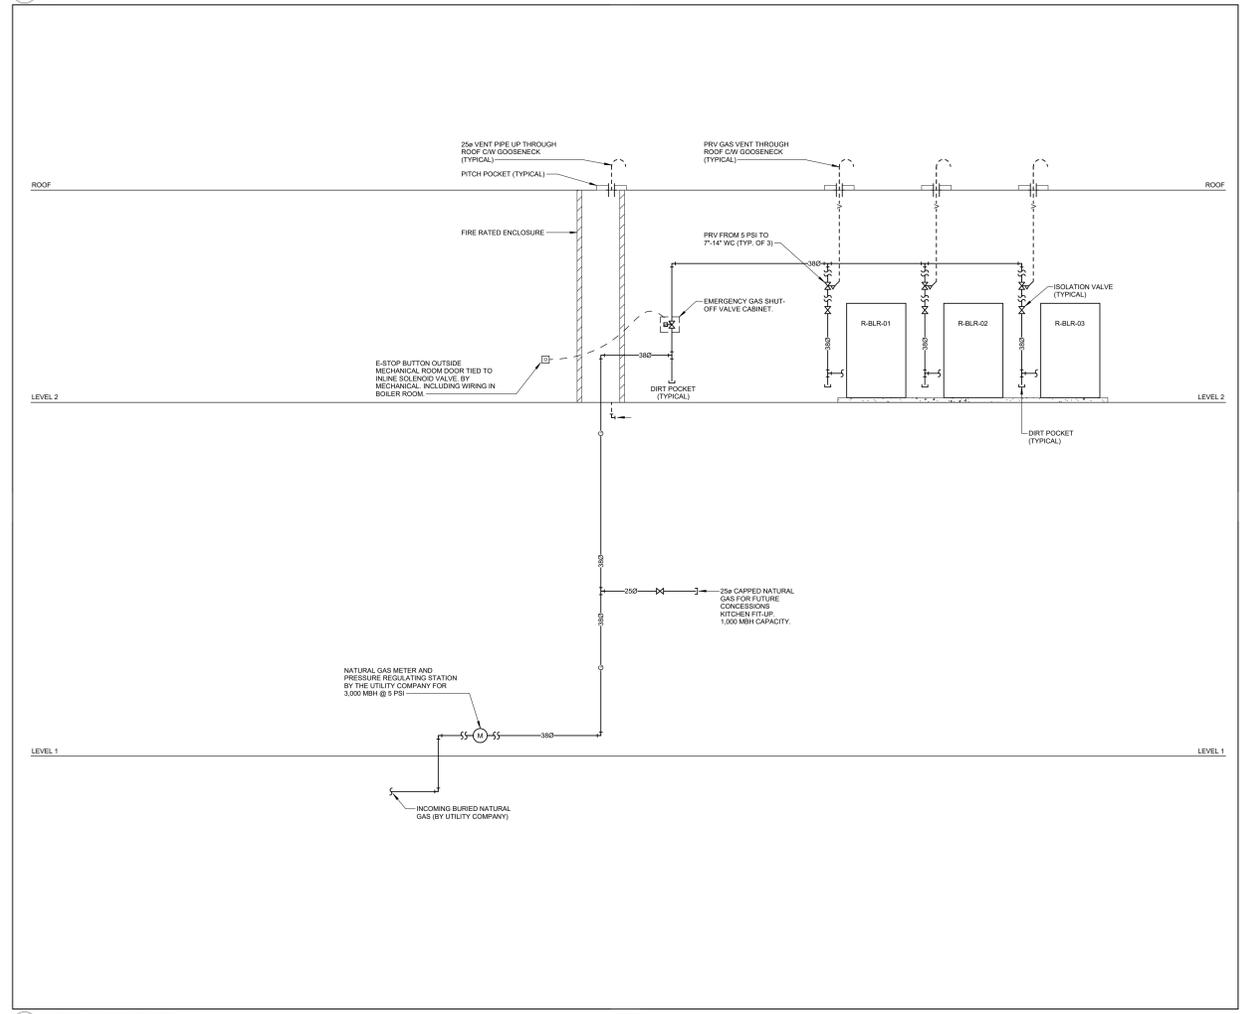
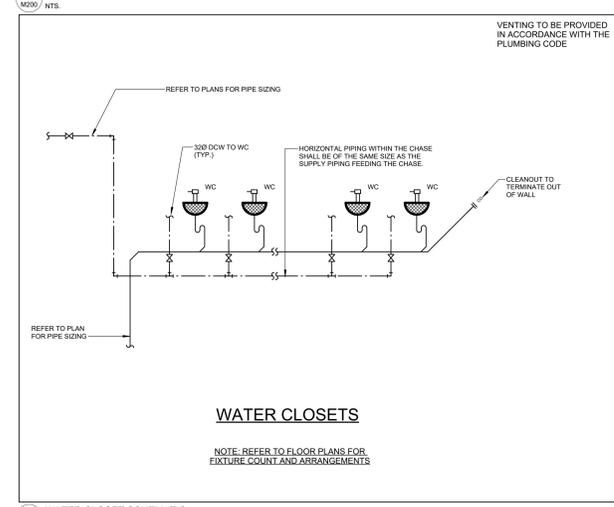
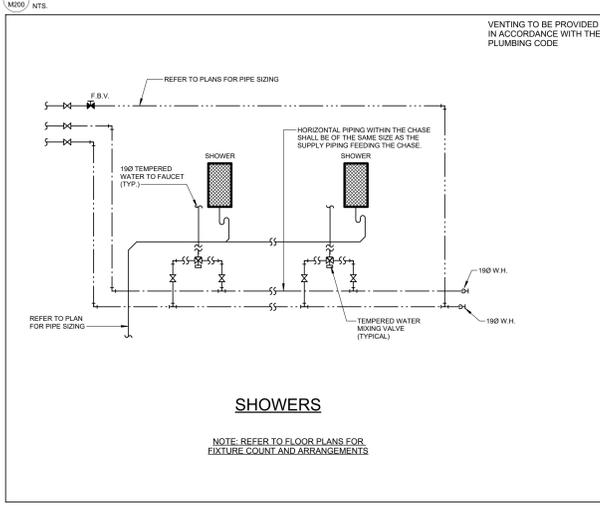
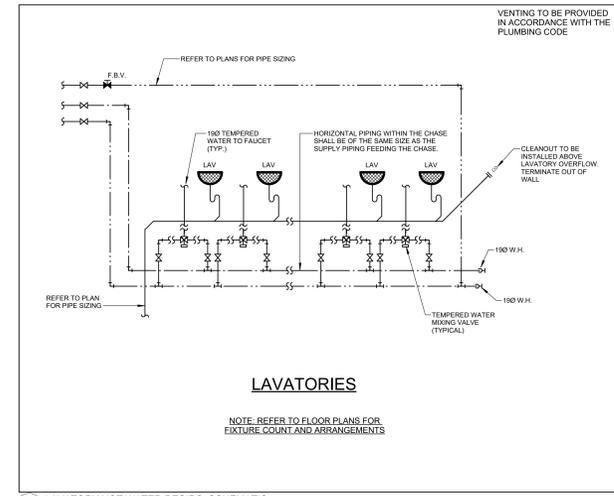
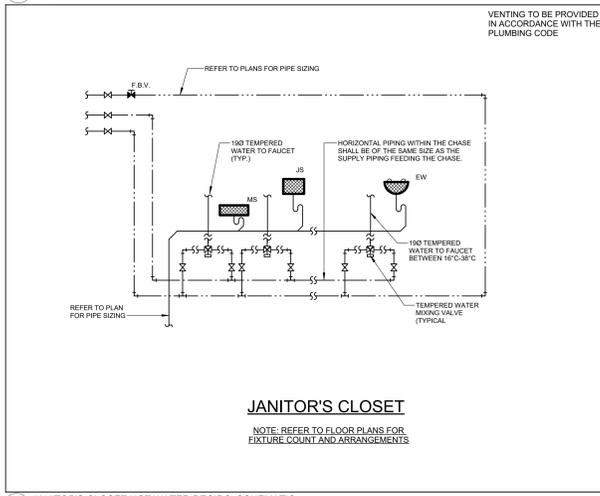
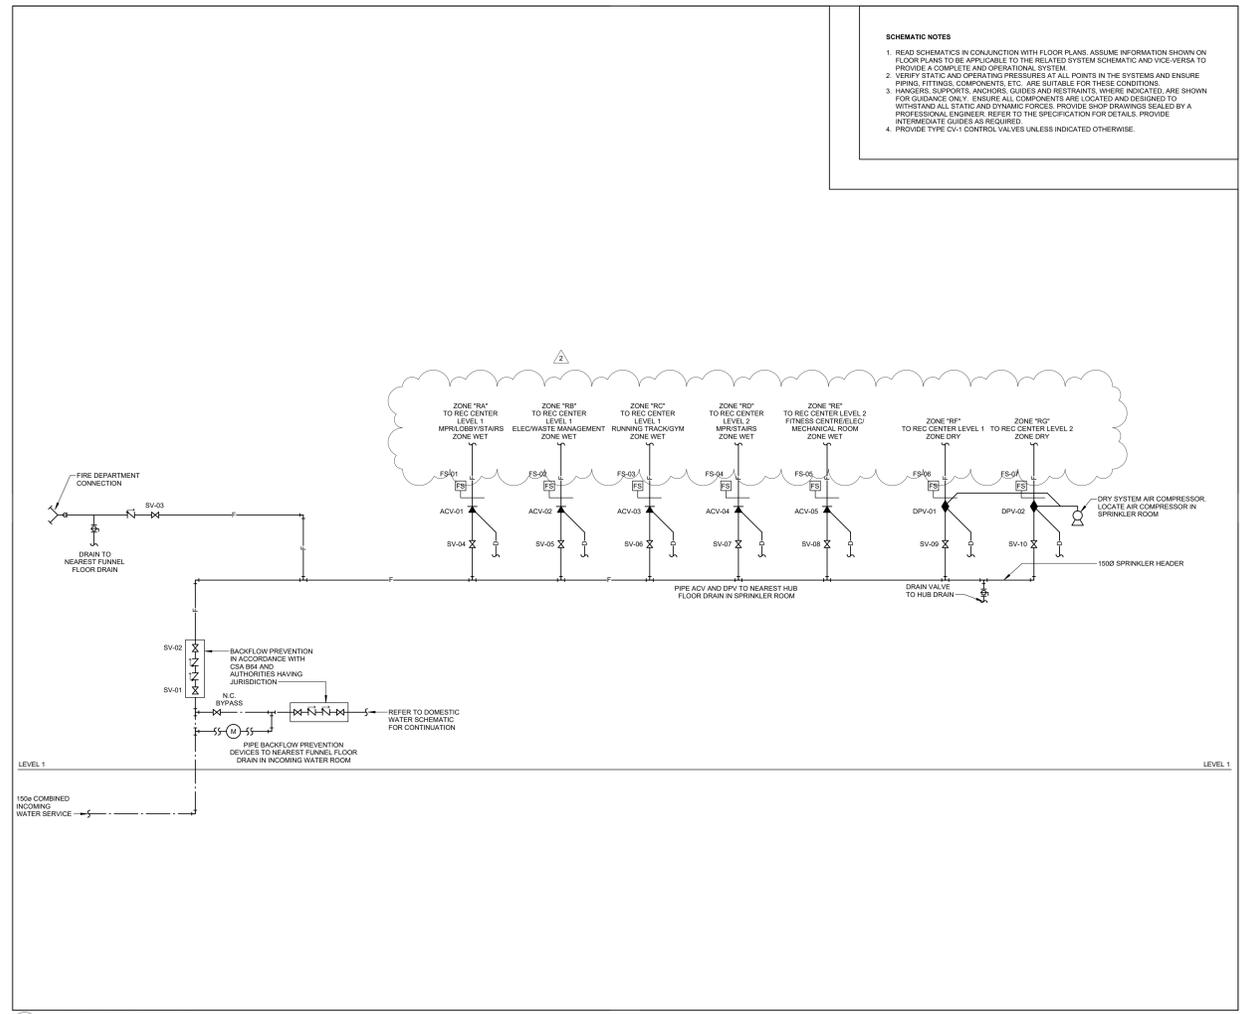


Issued

No.	Date	Description
1	2025.12.11	Contract Documents
2	2025.01.15	Appendix 3

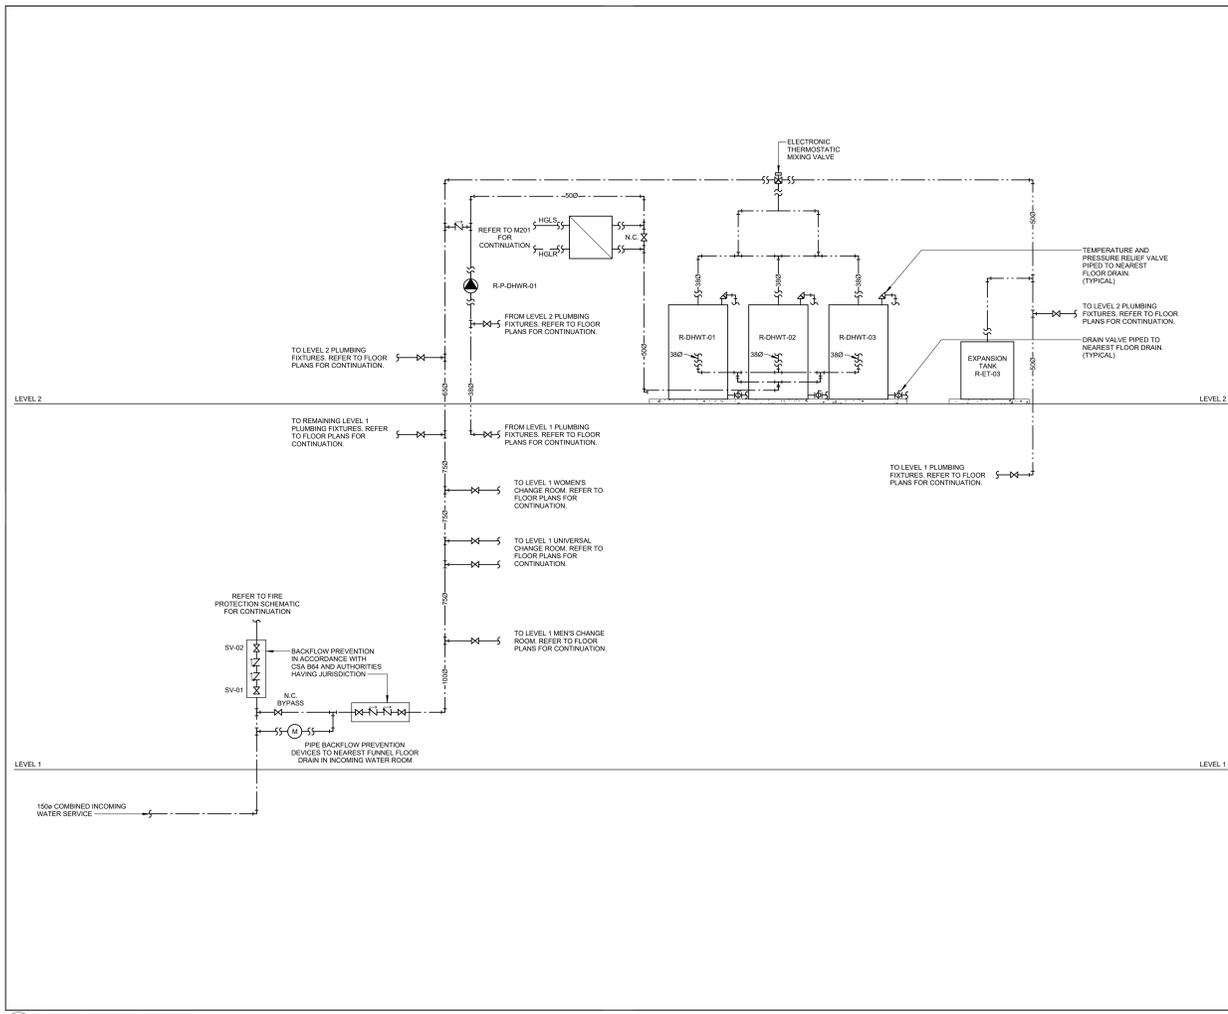

Contractor Must Check & Verify all Dimensions on the Job.
Do Not Scale Drawings.
All Drawings, Specifications and Related Documents are the Copyright Property of the Engineer and shall be Retained Upon Request. Reproduction of Drawings, Specifications and Related Documents in Part or in Whole is Forbidden Without the Written Permission of the Engineer.
This Drawing is Not to be Used for Construction Until Signed by the Engineer.

South Winnipeg Recreation Campus Phase 1
Address: 15 Ruth Crossing & 25 Ruth Crossing
Winnipeg, MB
Consultant Project No: 25007
City of Winnipeg Project No: 2005-127
City of Winnipeg Tender No: 83-2025B