
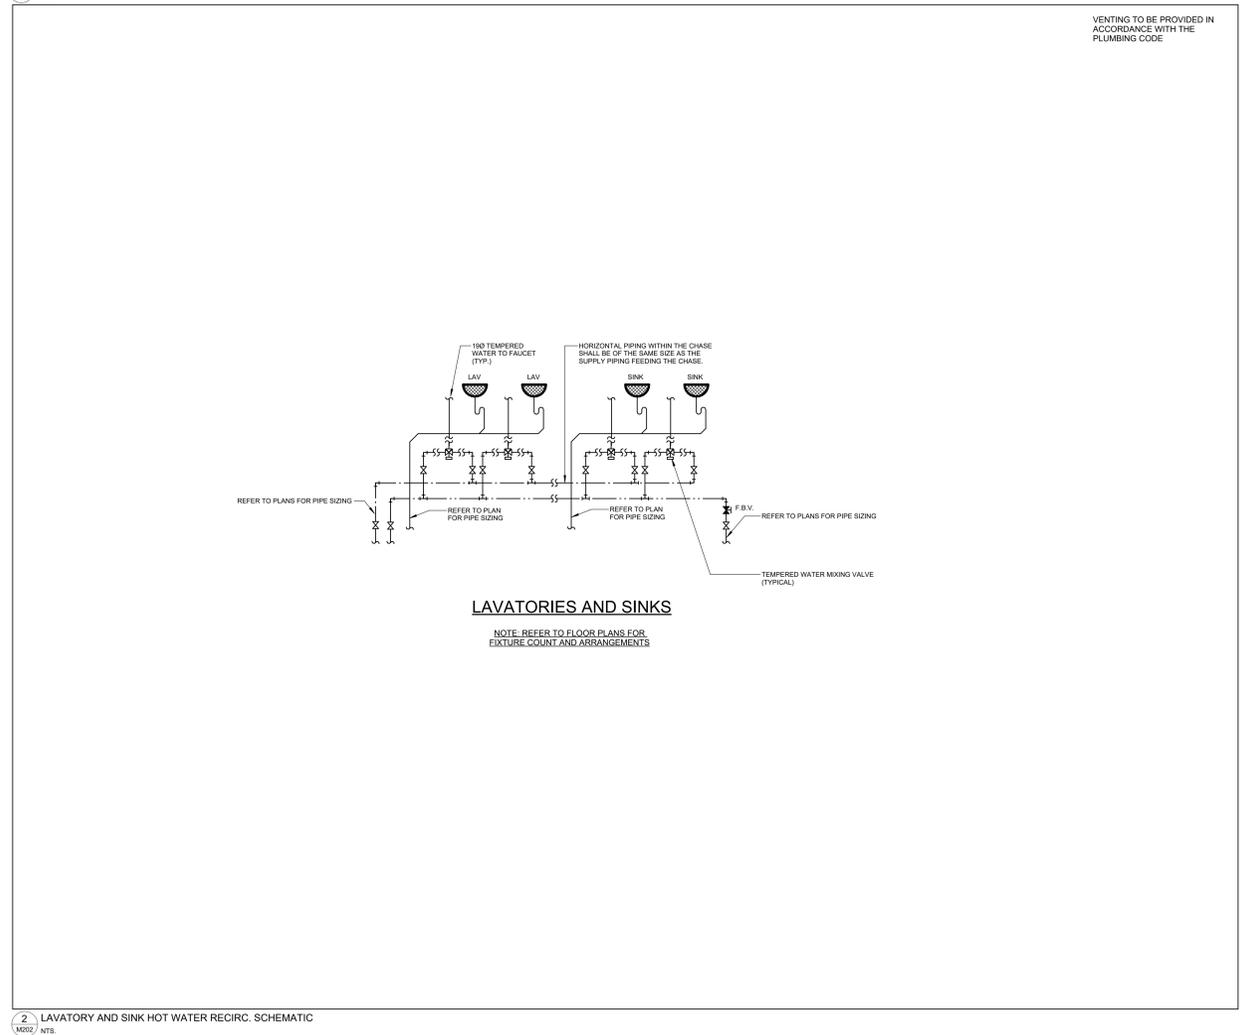


Issued

No.	Date	Description
1	2025.12.11	Contract Documents
2	2025.01.15	Appendix 3

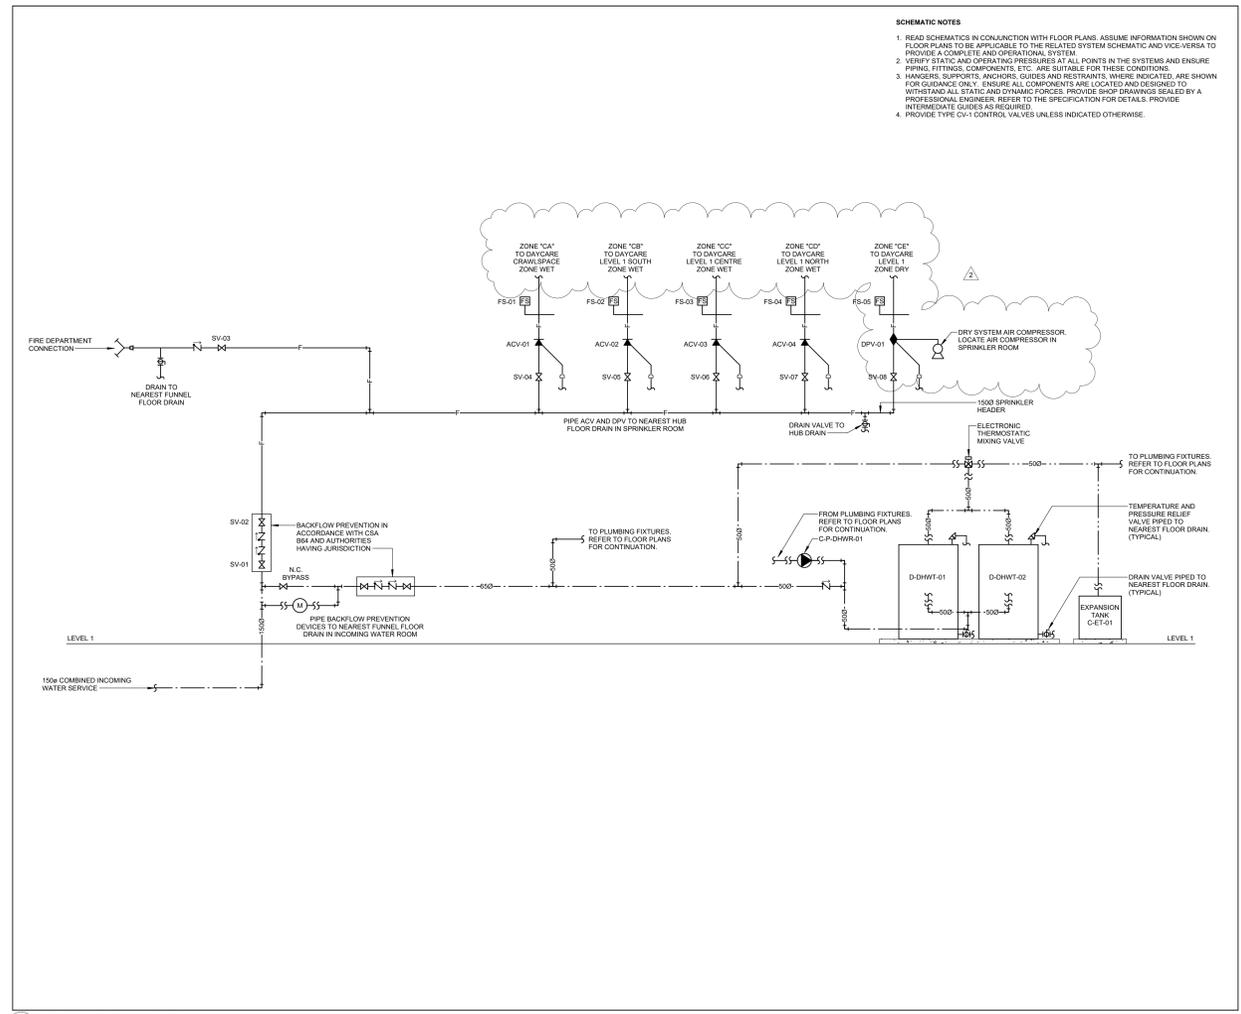

Contractor Must Check & Verify all Dimensions on the Job.  
Do Not Scale Drawings.  
All Drawings, Specifications, and Related Documents are the Copyright Property of the Engineer and shall be treated as such. Reproduction or Distribution of any part of these documents without the written permission of the Engineer is prohibited.  
This Drawing is Not to be Used for Construction Until Signed by the Engineer.

**South Winnipeg Recreation Campus Phase 1**  
Address: 15 Ruth Crossing & 25 Ruth Crossing  
Winnipeg, MB  
Consultant Project No: 25007  
City of Winnipeg Project No: 2020-127  
City of Winnipeg Tender No: 63-2025B

2025-01-15 10:43:30 AM A:\work\Draw\2025\002\_002\_SPHRC\_M202\020202\M202-BA-FR.rvt