



Smith + Andersen
703 - 181 Postage Avenue East, Winnipeg MB, R0B 0Y4
1.204.955.6568 smithandersen.com

Winnipeg
THE CITY OF WINNIPEG
ASSETS & PROJECT MANAGEMENT
DEPARTMENT
MUNICIPAL ACCOMMODATIONS DIVISION
3-65 GARRY STREET, R3C 4K4


Manitoba
Manitoba Public Service
Delivery
200 - 460 Ellice Avenue,
Winnipeg, Manitoba
R3B 3K2

Issued

No.	Date	Description
1	2025.12.11	Contract Documents
2	2025.01.15	Appendix 3

- GENERAL NOTES**
- DO NOT SCALE DRAWINGS. THE LOCATIONS OF ALL ITEMS SHOWN ON THE DRAWINGS OR SPECIFIED THAT ARE NOT DEFINED BY FIXED DIMENSIONS ARE APPROXIMATE. DETERMINE THE EXACT LOCATIONS NECESSARY TO SECURE THE BEST CONDITIONS AND RESULTS BASED ON SITE CONDITIONS. REVIEW ALL REVISIONS WITH THE CONSULTANT.
 - READ FLOOR PLANS IN CONJUNCTION WITH SCHEMATICS. ASSUME INFORMATION SHOWN ON FLOOR PLANS TO BE APPLICABLE TO THE RELATED SYSTEM SCHEMATIC AND VICE-VERSA TO PROVIDE A COMPLETE AND OPERATIONAL SYSTEM.
 - VERIFY STRUCTURAL INTEGRITY OF ALL TEMPORARY AND PERMANENT OPENINGS. PROVIDE ADDITIONAL FRAMING TO ENSURE STRUCTURAL INTEGRITY AS REQUIRED.
 - REFER TO THE STANDARD DETAILS AND DETAIL SHEETS FOR ADDITIONAL INFORMATION.

- SPRINKLER NOTES**
- SPRINKLER HEADS ARE NOT SHOWN ON THE DRAWINGS. REVIEW THE ARCHITECTURAL AND/OR INTERIOR DESIGN DRAWINGS, INCLUDING ALL CEILING DETAILS, SECTIONS, ETC. AND PROVIDE FULL COVERAGE AS REQUIRED. CONCEAL ALL SPRINKLER PIPES IN THE BULKHEADS AND CEILING AREAS INDICATED ON THE DRAWINGS UNLESS INDICATED OTHERWISE. ADDITIONAL BULKHEADS ARE NOT PERMITTED TO REDUCE THE LENGTH OF THE SPRINKLER BRANCHES.
 - PROVIDE SPRINKLER DRAWINGS AND HYDRAULIC CALCULATIONS SEALED BY A PROFESSIONAL ENGINEER. INDICATE ZONING AND DENSITY. PROVIDE A SPRINKLER LAYOUT, INCLUDING MAINS AND SPRINKLER HEADS TO SUIT ARCHITECTURAL CEILING PLANS. PROVIDE SHOP DRAWINGS IDENTIFYING PROPOSED LAYOUT FOR REVIEW PRIOR TO INSTALLATION.
 - PROVIDE EXACT NUMBER OF HEADS TO SUIT DENSITY REQUIREMENTS AS SPECIFIED OR SHOWN. CONFORM TO ARCHITECTURAL REFLECTED CEILING PLAN LOCATIONS WHERE INDICATED AND MEET THE MINIMUM REQUIREMENTS OF THE ENFORCED NFPA 13 STANDARD.
 - PROVIDE EXTENDED COVERAGE SPRINKLER HEADS AS REQUIRED TO ACHIEVE COVERAGE AND CONCEAL SPRINKLER PIPES WITHIN THE BULKHEAD AREAS INDICATED ON THE DRAWINGS.
 - PROVIDE HIGH TEMPERATURE SPRINKLER HEADS IN ALL ELECTRICAL AND COMMUNICATIONS ROOMS.
 - PROVIDE ADEQUATE SPRINKLER COVERAGE IN MECHANICAL ROOMS IN ACCORDANCE WITH THE ENFORCED NFPA 13 STANDARD. PROVIDE SPRINKLER HEADS ABOVE AND BELOW DUCTS AND EQUIPMENT AS REQUIRED.
 - FLOW INDICATOR AND PRESERVE SWITCHES ARE SHOWN FOR CLARITY ONLY AND ARE CONSIDERED PART OF A COMPLETE LISTED ALARM CHECK VALVE ASSEMBLY.
 - PROVIDE A SEALED LETTER BY THE PROFESSIONAL ENGINEER OF RECORD CONFIRMING THE INSTALLATION COMPLIES WITH THE SHOP DRAWINGS AND THE ENFORCED NFPA 13 STANDARD.
 - COORDINATE FIRE PROTECTION SERVICES WITH ALL OTHER TRADES PRIOR TO INSTALLATION. VERIFY, AT OWNERS EXPENSE, ALL CONFLICTS RESULTING FROM UNCOORDINATED FIRE PROTECTION SYSTEMS INSTALLED IN ADVANCE OF THE REQUIRED INTERFERENCE PROCESS.

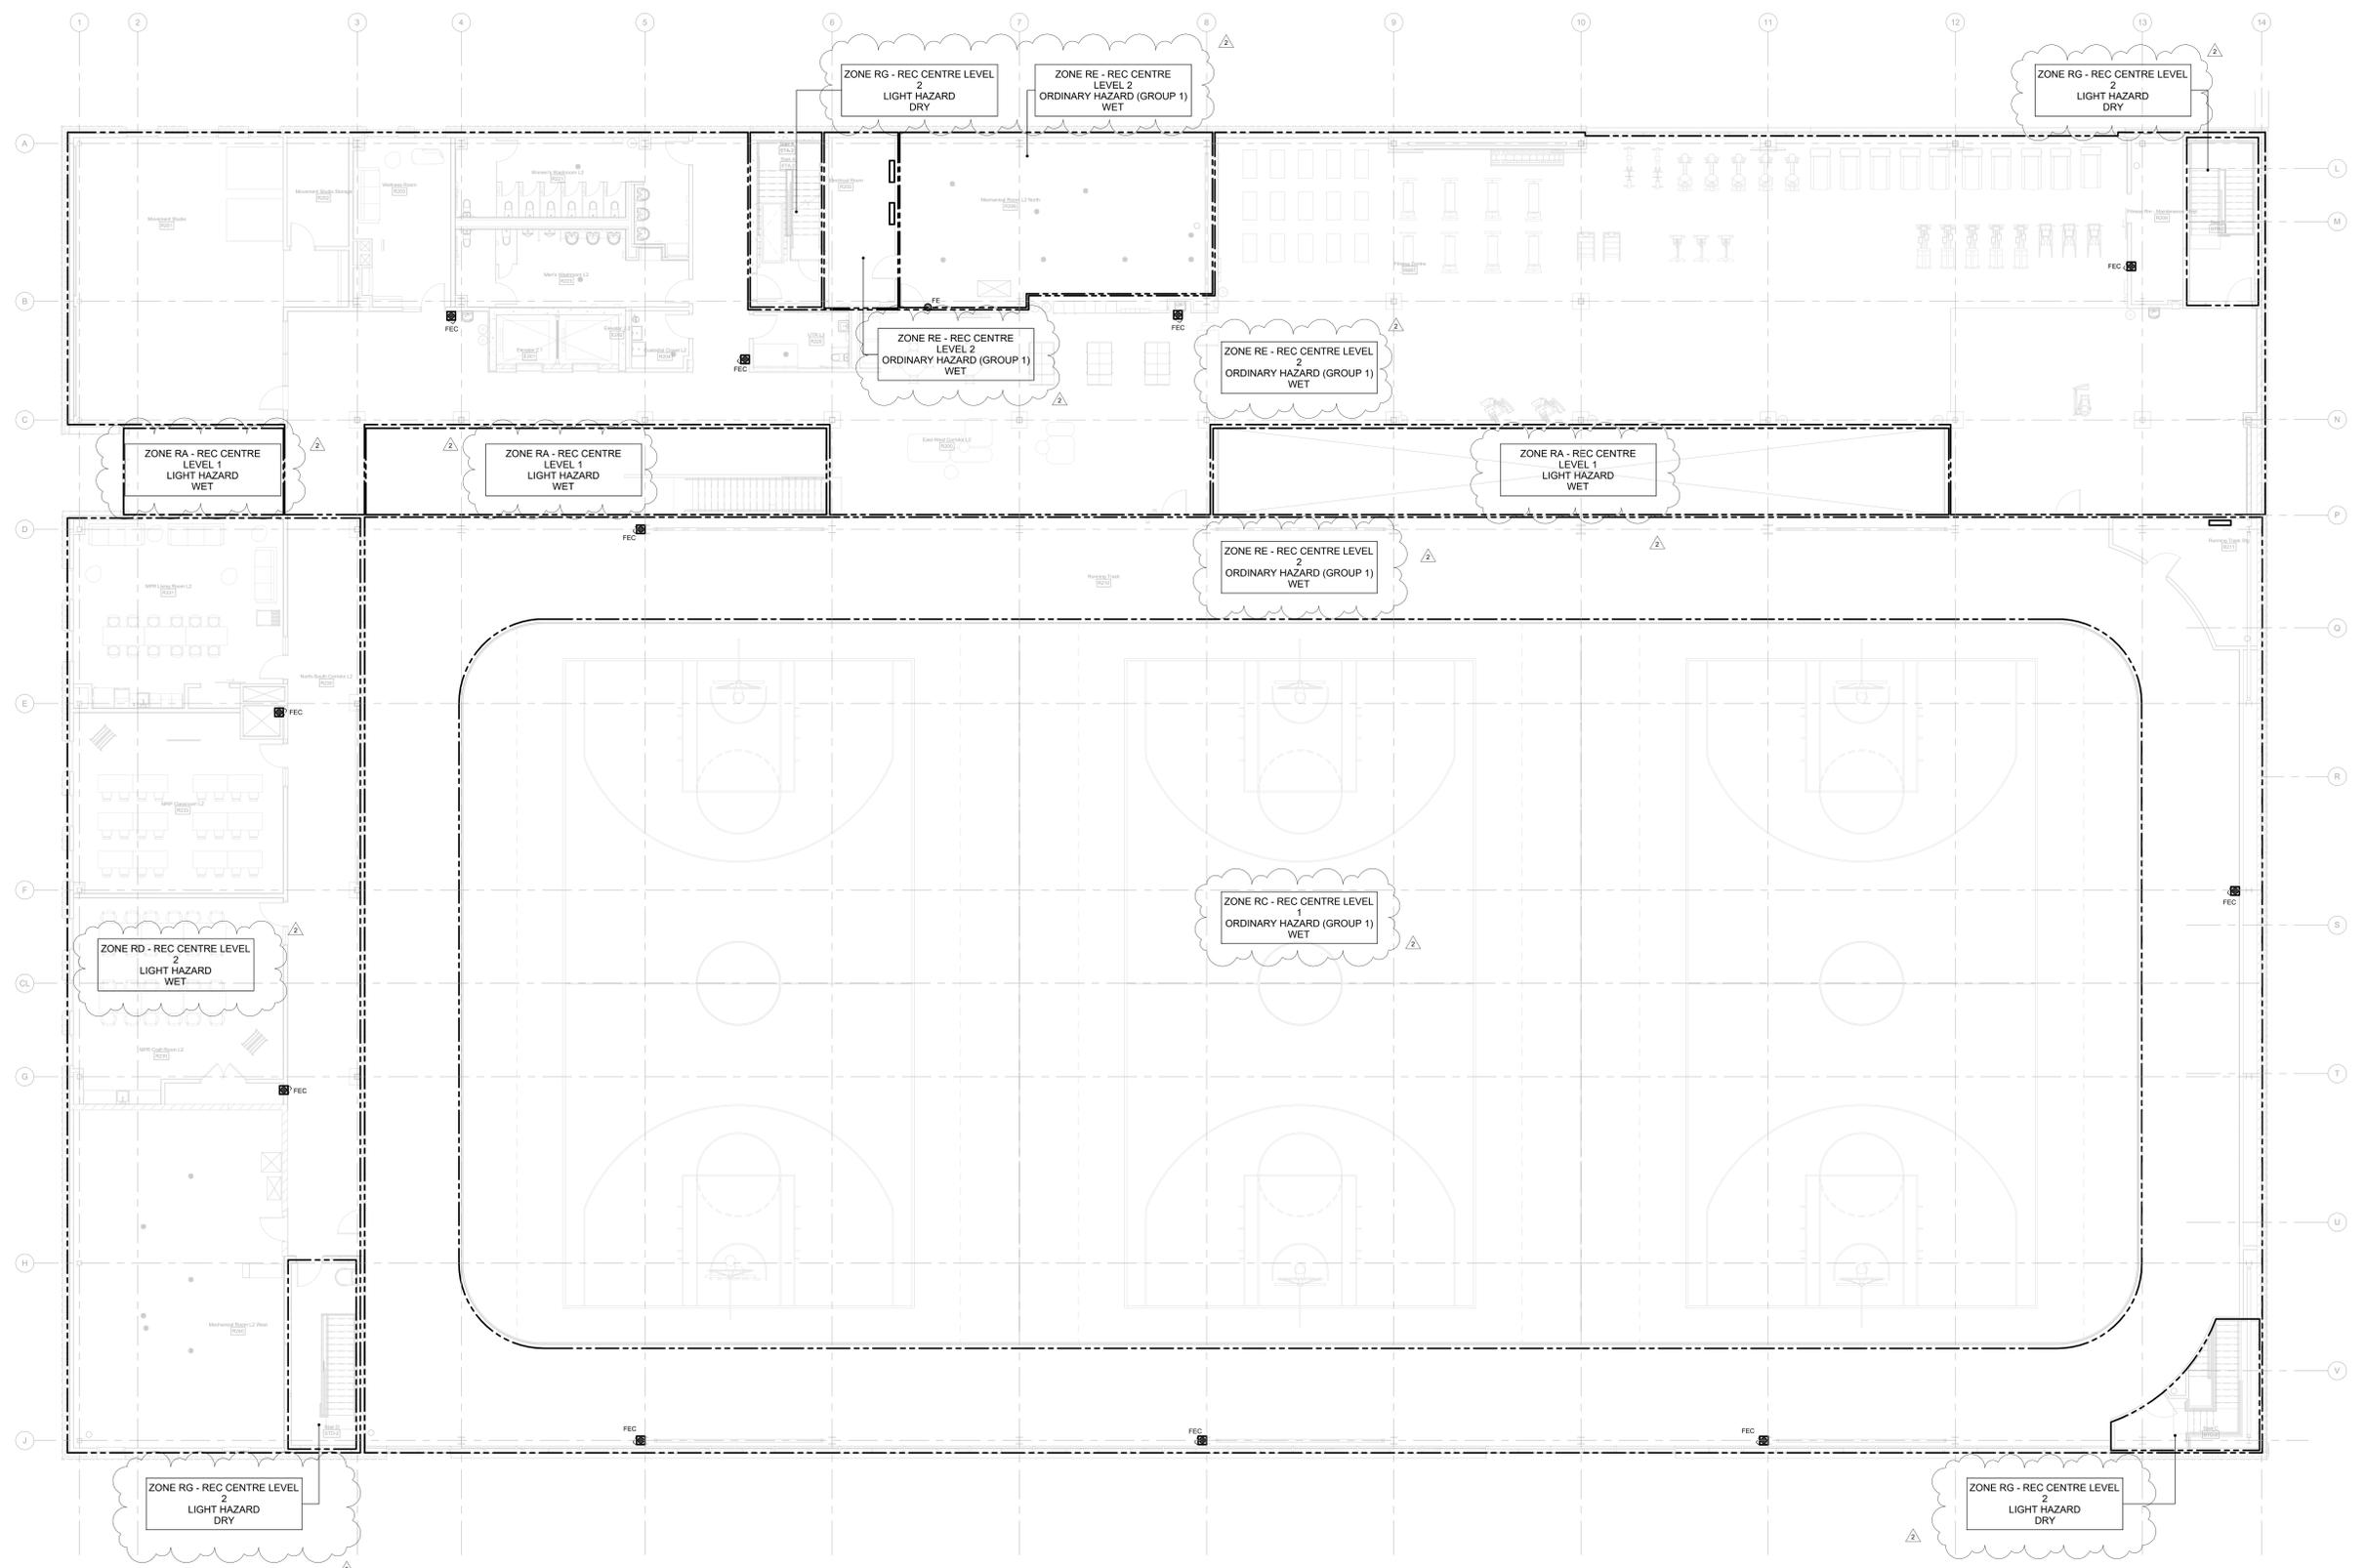

Contractor Must Check & Verify all Dimensions on the Job.
Do Not Scale Drawings.
All Drawings, Specifications and Related Documents are the Copyright Property of the Engineer and shall be retained upon request. Reproduction of Drawings, Specifications and Related Documents in Part or in Whole is Forbidden Without the Written Permission of the Engineer.
This Drawing is Not to be Used for Construction Until Signed by the Engineer.

**South Winnipeg Recreation
Campus Phase 1**
Address: 15 Ruth Crossing & 25 Ruth Crossing
Winnipeg, MB
Consultant Project No: 25007
City of Winnipeg Project No: 2020-127
City of Winnipeg Tender No: 83-2025B

REC FLOOR PLAN - LEVEL 2 - FIRE PROTECTION

2025/01/15 10:42:28 AM Autodesk Docs://25007_000_SF/REC_2025/102502A.MECH-BA-428.rvt