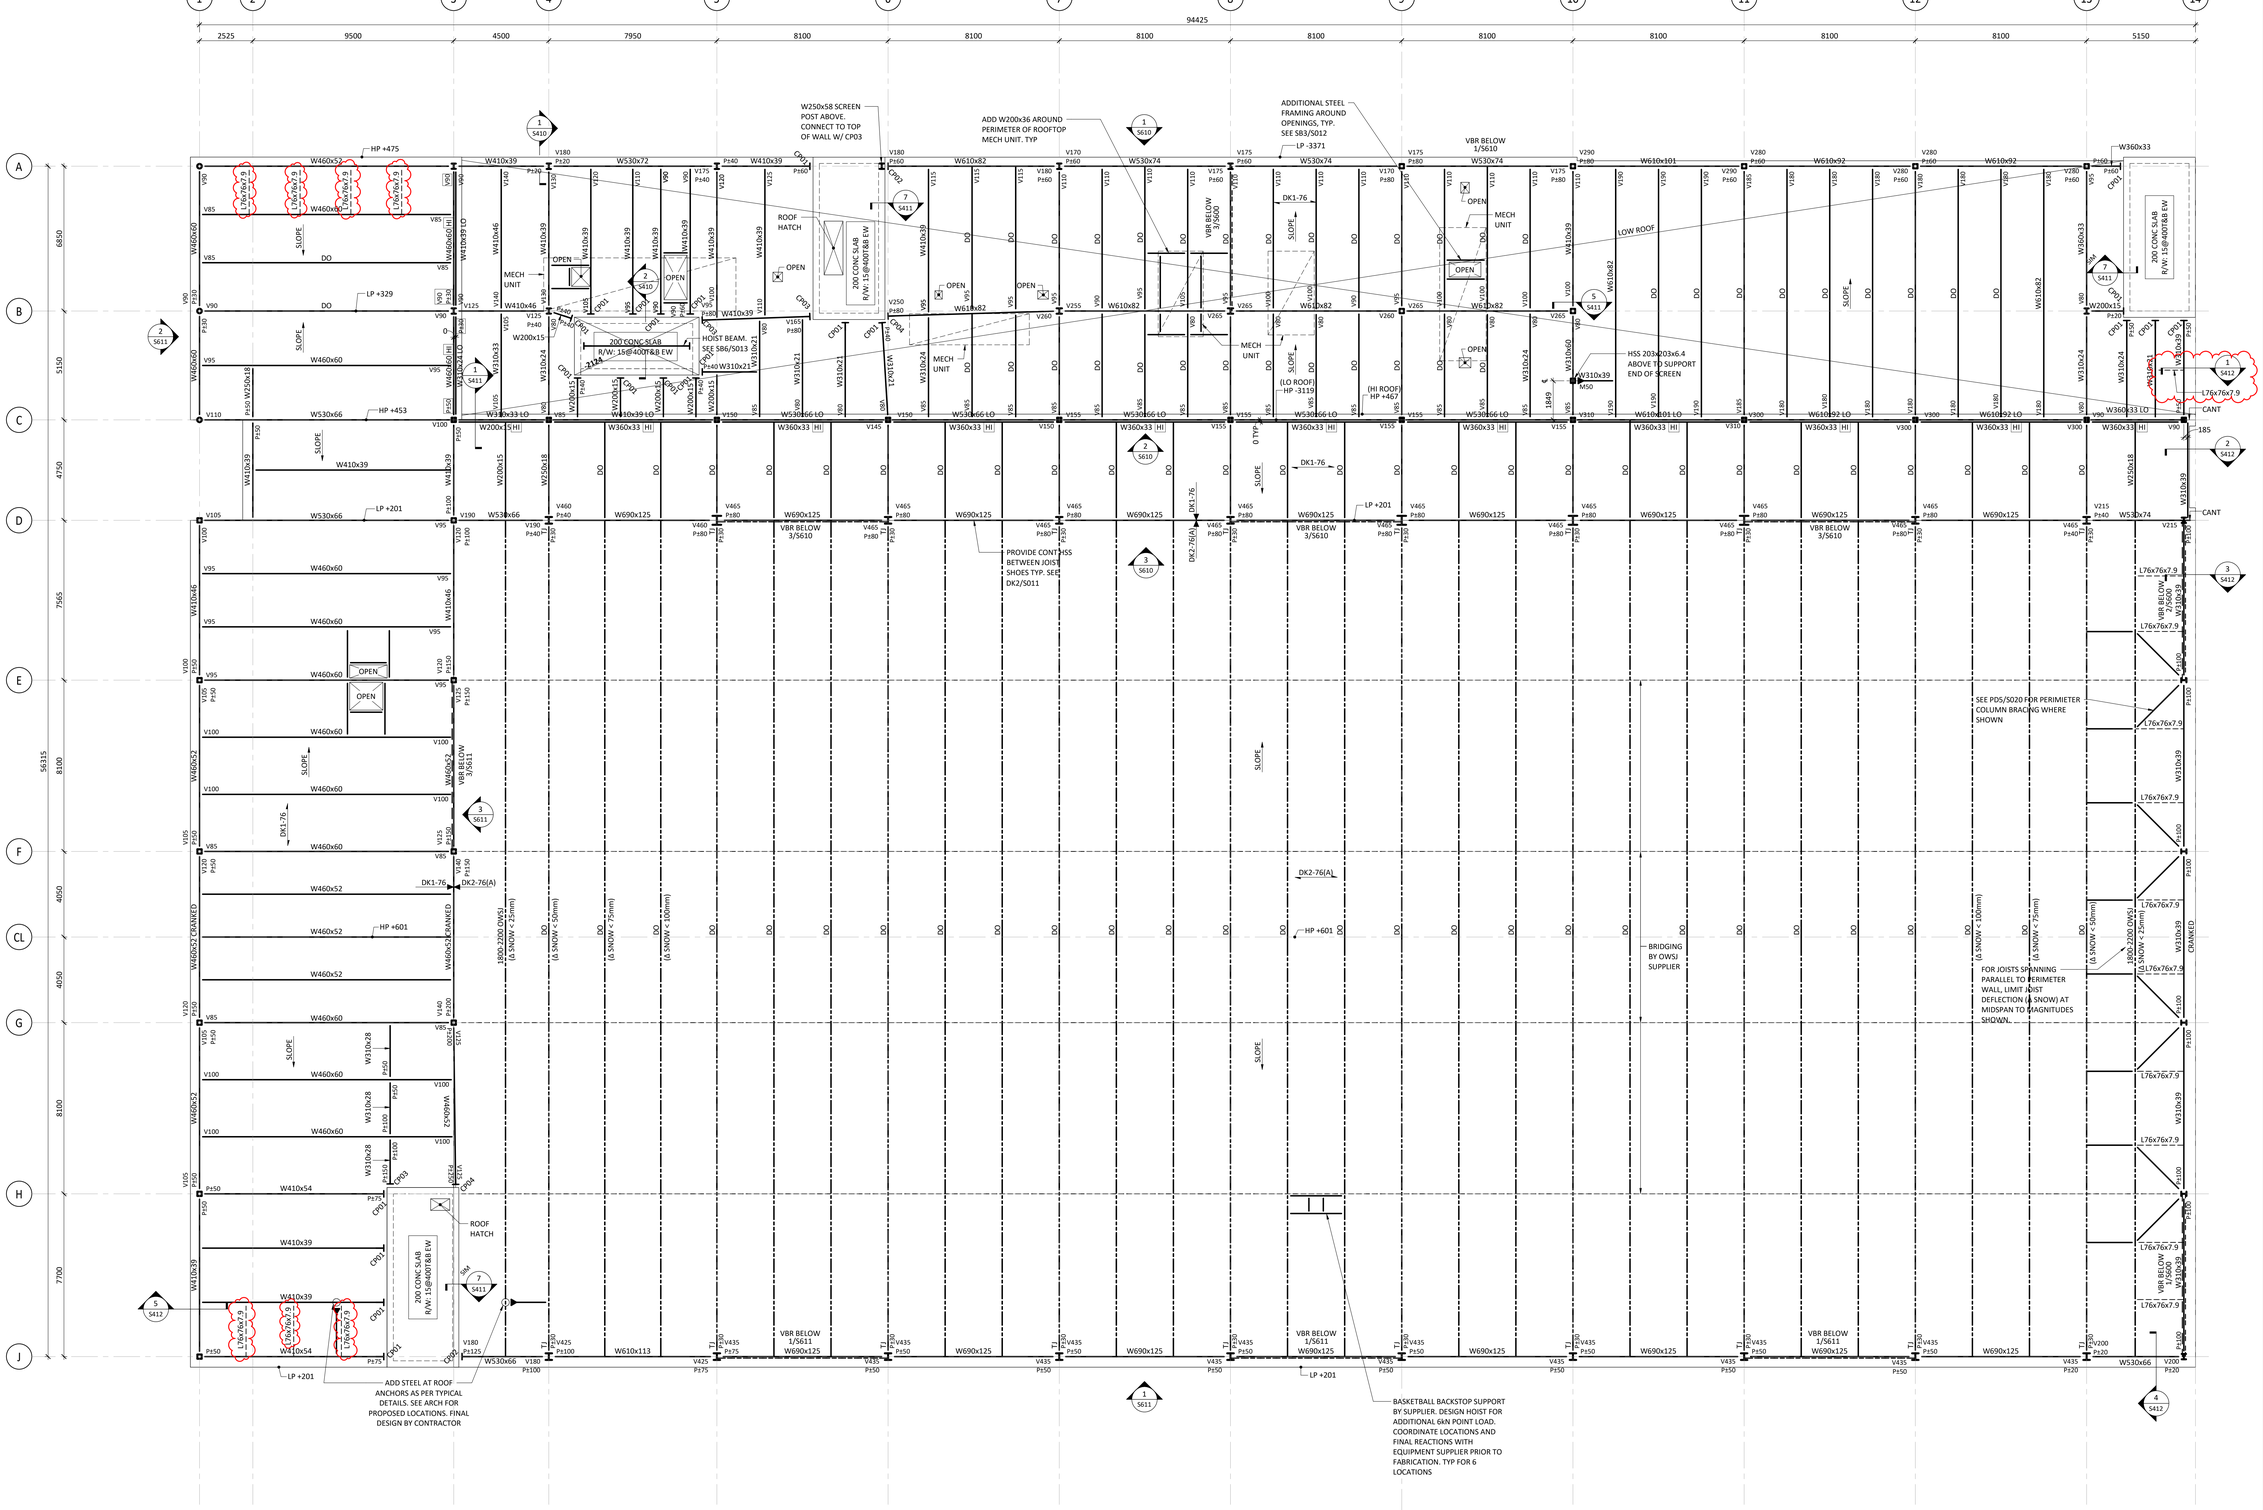

1 FRAMING PLAN - ROOF (REC CENTRE)

S223

1 : 100

1. PLAN DATUM (FINISHED FLOOR ELEVATION) IS GEODETIC ELEVATION **245.225m**.
2. TOP OF ROOF DECK IS +0.76 FROM PLAN DATUM EXCEPT AS CROSSED AND NOTED.
3. ELEVATIONS FOR AREAS CROSSED AND NOTED ARE TO BE READ FROM THE PLAN DATUM.
4. FOR SLOPING ROOFS HIGH AND LOW POINTS ARE NOTED AND ARE TO BE READ FROM PLAN DATUM.
5. TOPS OF STEEL BEAMS AND JOISTS ARE AT UNDERSIDE OF STEEL DECK EXCEPT AS NOTED THUS (±XX) ELEVATIONS FOR TOPS OF NOTED STEEL BEAMS ARE TO BE READ FROM PLAN DATUM.
6. THE ASSUMED JOIST SHOE DEPTH ARE AS FOLLOWS:

JOIST SPAN	SHOE DEPTH
<15,200mm	100mm
15,200 - 27,400mm	125mm
>27,400mm	190mm

7. TOPS OF ALL STEEL BEAMS SUPPORTING JOISTS ARE THE ASSUMED JOIST SHOE DEPTH BELOW THE UNDERSIDE OF THE STEEL DECK EXCEPT AS NOTED THUS (±XX) ELEVATIONS FOR TOPS OF NOTED STEEL BEAMS ARE TO BE READ FROM PLAN DATUM.
8. REFER TO LOADING DRAWINGS FOR DESIGN LOADS.
9. REFER TO SHEAR WALL DRAWINGS FOR CORE PLANS.
10. PROVIDE UPWARD CAMBERS TO STRUCTURAL MEMBERS AS SHOWN THUS ON PLAN c=20.
11. ALL STEEL ELEMENTS INCLUDING THEIR CONNECTIONS, OUTSIDE OF BUILDING VAPOUR BARRIER ARE TO BE GALVANIZED.
12. SEE ARCH FOR AESS REQUIREMENTS.

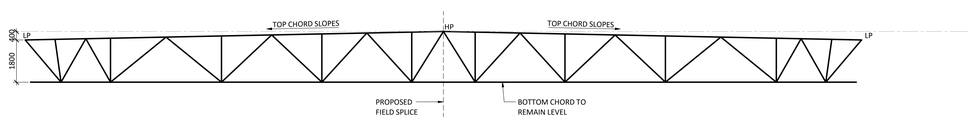

1800-2200 OWSJ

1 : 100

diamond schmitt BrookMcIlroy/

ENTUITIVE
120 Bremner Blvd, 4th Floor
Toronto, ON M5J 0A8 Canada
+1 416 477 5832

Winnipeg
THE CITY OF WINNIPEG
ASSETS & PROJECT MANAGEMENT DEPARTMENT
MUNICIPAL ACCOMMODATIONS DIVISION
3-65 GARRY STREET, R3C 4K4

Manitoba
Manitoba Public Service Delivery
200 -400 Ellice Avenue,
Winnipeg, Manitoba
R3B 3M3

Issued

No.	Date	Description
1	2025/12/11	CONTRACT DOCUMENTS
2	2026/01/15	ADDENDUM 3

©2025 ENTUITIVE CORPORATION. MUST BE RETURNED UPON REQUEST. REPRODUCTION OF THESE DRAWINGS, SPECIFICATIONS, RELATED DOCUMENTS AND DESIGNS IN WHOLE OR IN PART IS STRICTLY FORBIDDEN WITHOUT THE PRIOR WRITTEN PERMISSION OF ENTUITIVE CORPORATION. DRAWINGS SHALL ONLY BE USED FOR THE PURPOSE NOTED IN THE REVISION LIST. DRAWINGS SHALL NOT BE USED FOR CONSTRUCTION UNLESS SPECIFICALLY INDICATED.

South Winnipeg Recreation Campus Phase 1

Address: 15 Ruth Crossing & 25 Ruth Crossing
Winnipeg, MB

Consultant Project No: EN022-00907
City of Winnipeg Project No: 2020-127
City of Winnipeg Tender No: 63-2025B

FRAMING PLAN - ROOF - RECREATION CENTRE

1 : 100

S223

Autodesk Docs://2200007-South Winnipeg Recreation Campus-R24/2200007-STRU-ENT-Building-R24.rvt
2026-01-14 3:40:36 PM